
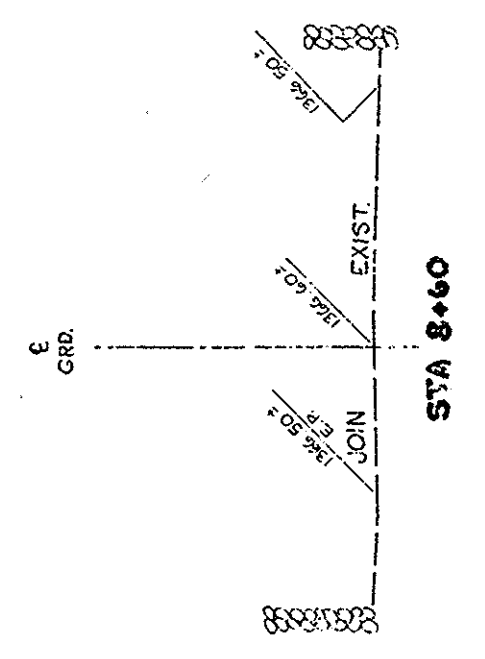
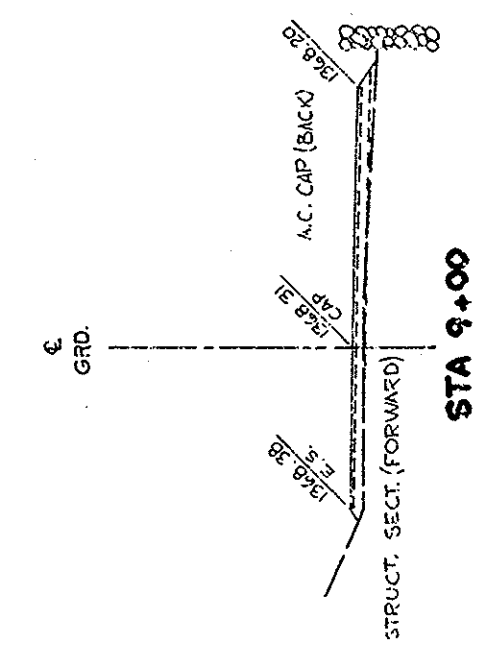
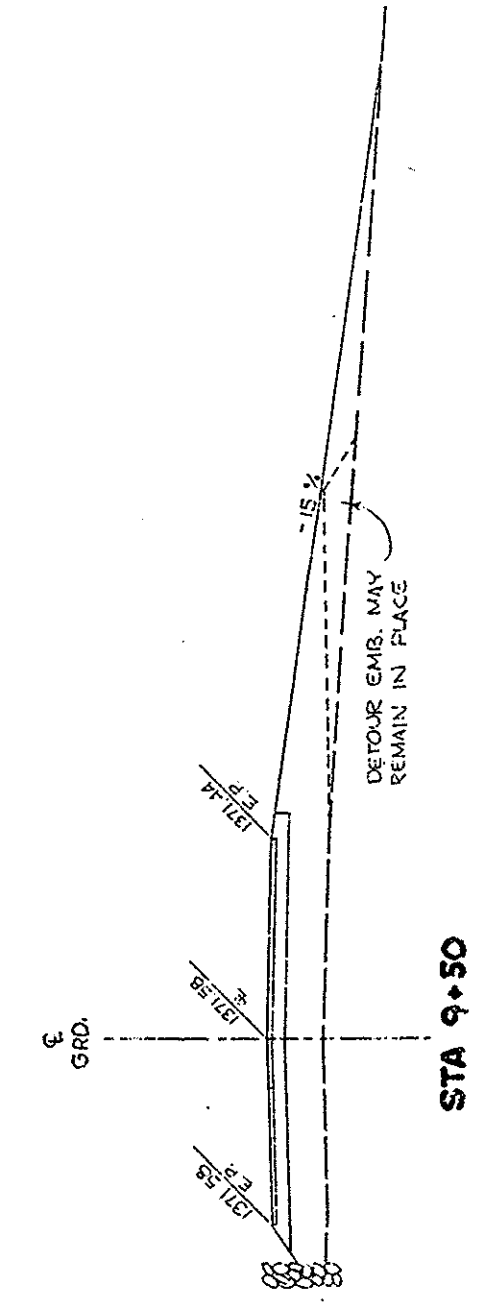
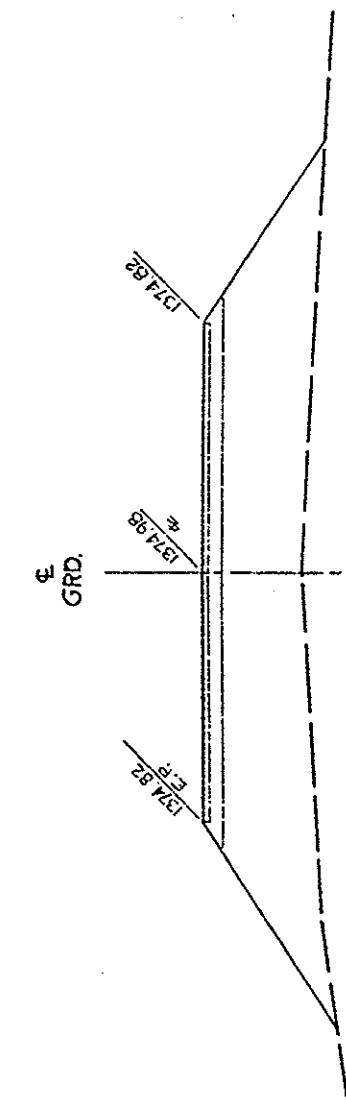
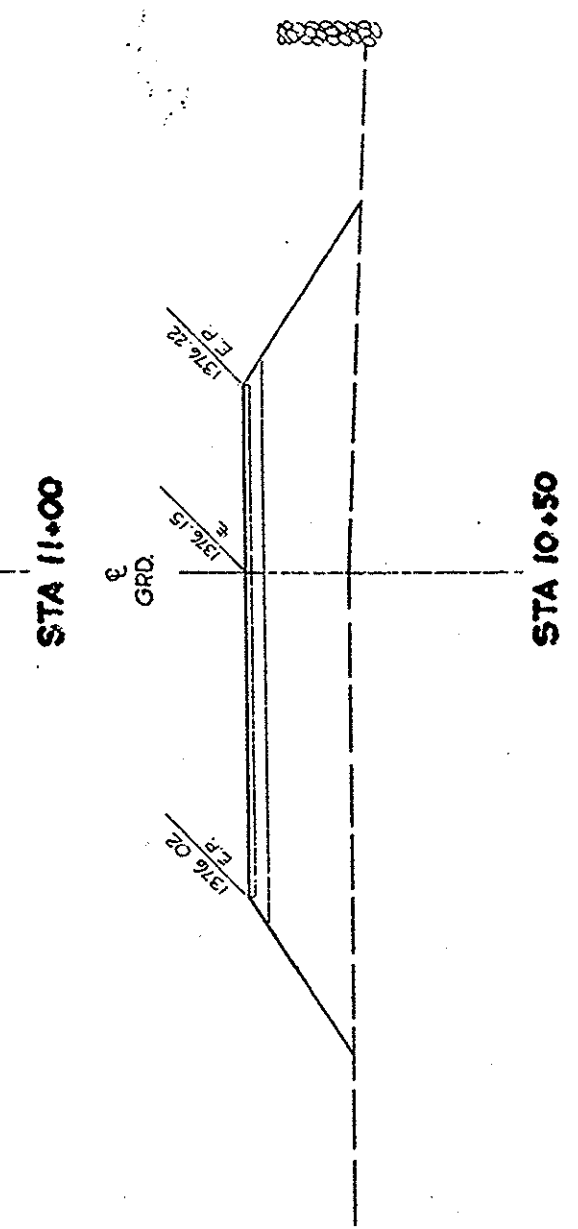
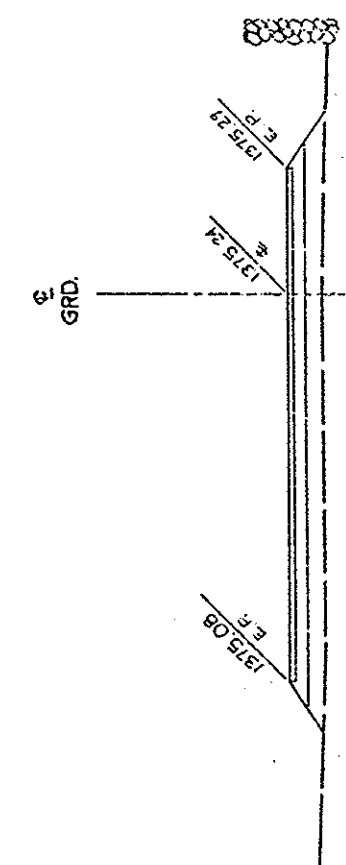
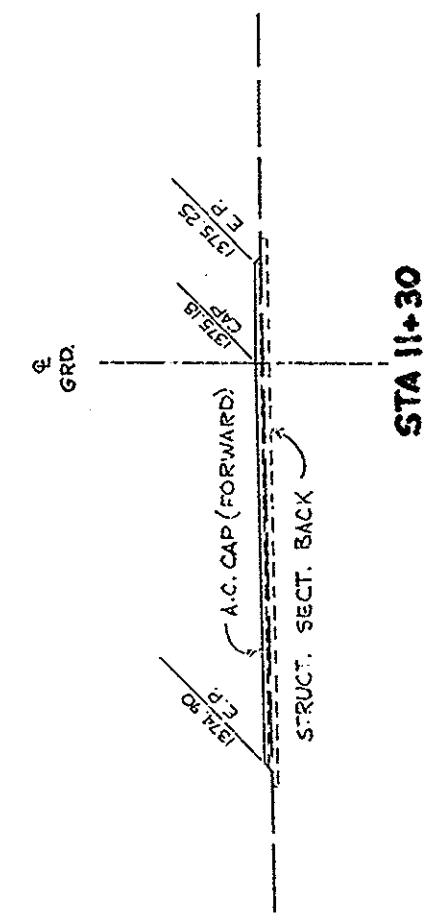


SILVERADO CYN. RD BRIDGE, SV-14  
HOR & VERT 1" = 5' 0"

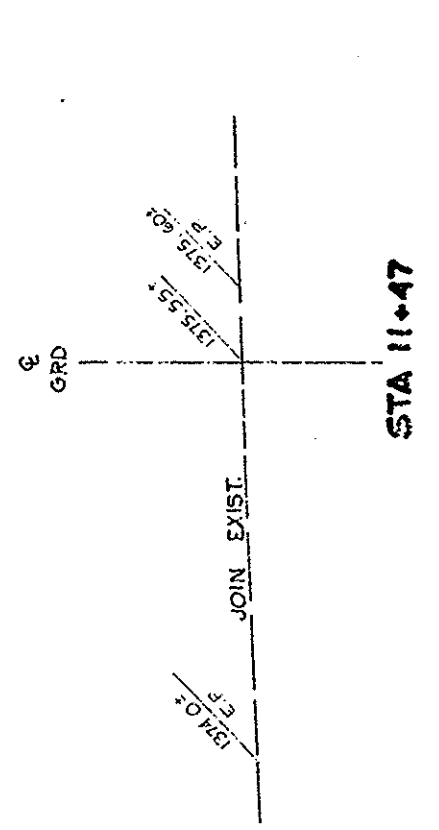

A.C. CAP  
CUT 0.00 SQ. IN.  
FILL 0.00 SQ. IN.

A.C. CAP (FORWARD)  
CUT 0.00 SQ. IN.  
FILL 0.00 SQ. IN.

BACK  
CUT 0.24 SQ. IN.  
FILL 0.00 SQ. IN.

CUT 0.00 SQ. IN.  
FILL 0.69 SQ. IN.

CUT 0.00 SQ. IN.  
FILL 4.02 SQ. IN.

CUT 0.00 SQ. IN.  
FILL 4.20 SQ. IN.

CUT 0.00 SQ. IN.  
FILL 2.18 SQ. IN.

FORWARD  
CUT 0.00 SQ. IN.  
FILL 0.03 SQ. IN.  
A.C. CAP (BACK)  
CUT 0.00 SQ. IN.  
FILL 0.41 SQ. IN.

CUT 0.00 SQ. IN.  
FILL 0.00 SQ. IN.

AS BUILT

CONSTRUCTION PLANS  
Silverado Canyon Road Bridge  
Sheet 12 of 19  
Red. 22.5:1 Scale: as shown  
Vellum

35 30 25 20 15 10 5 0 5 10 15 20 25 30 35