


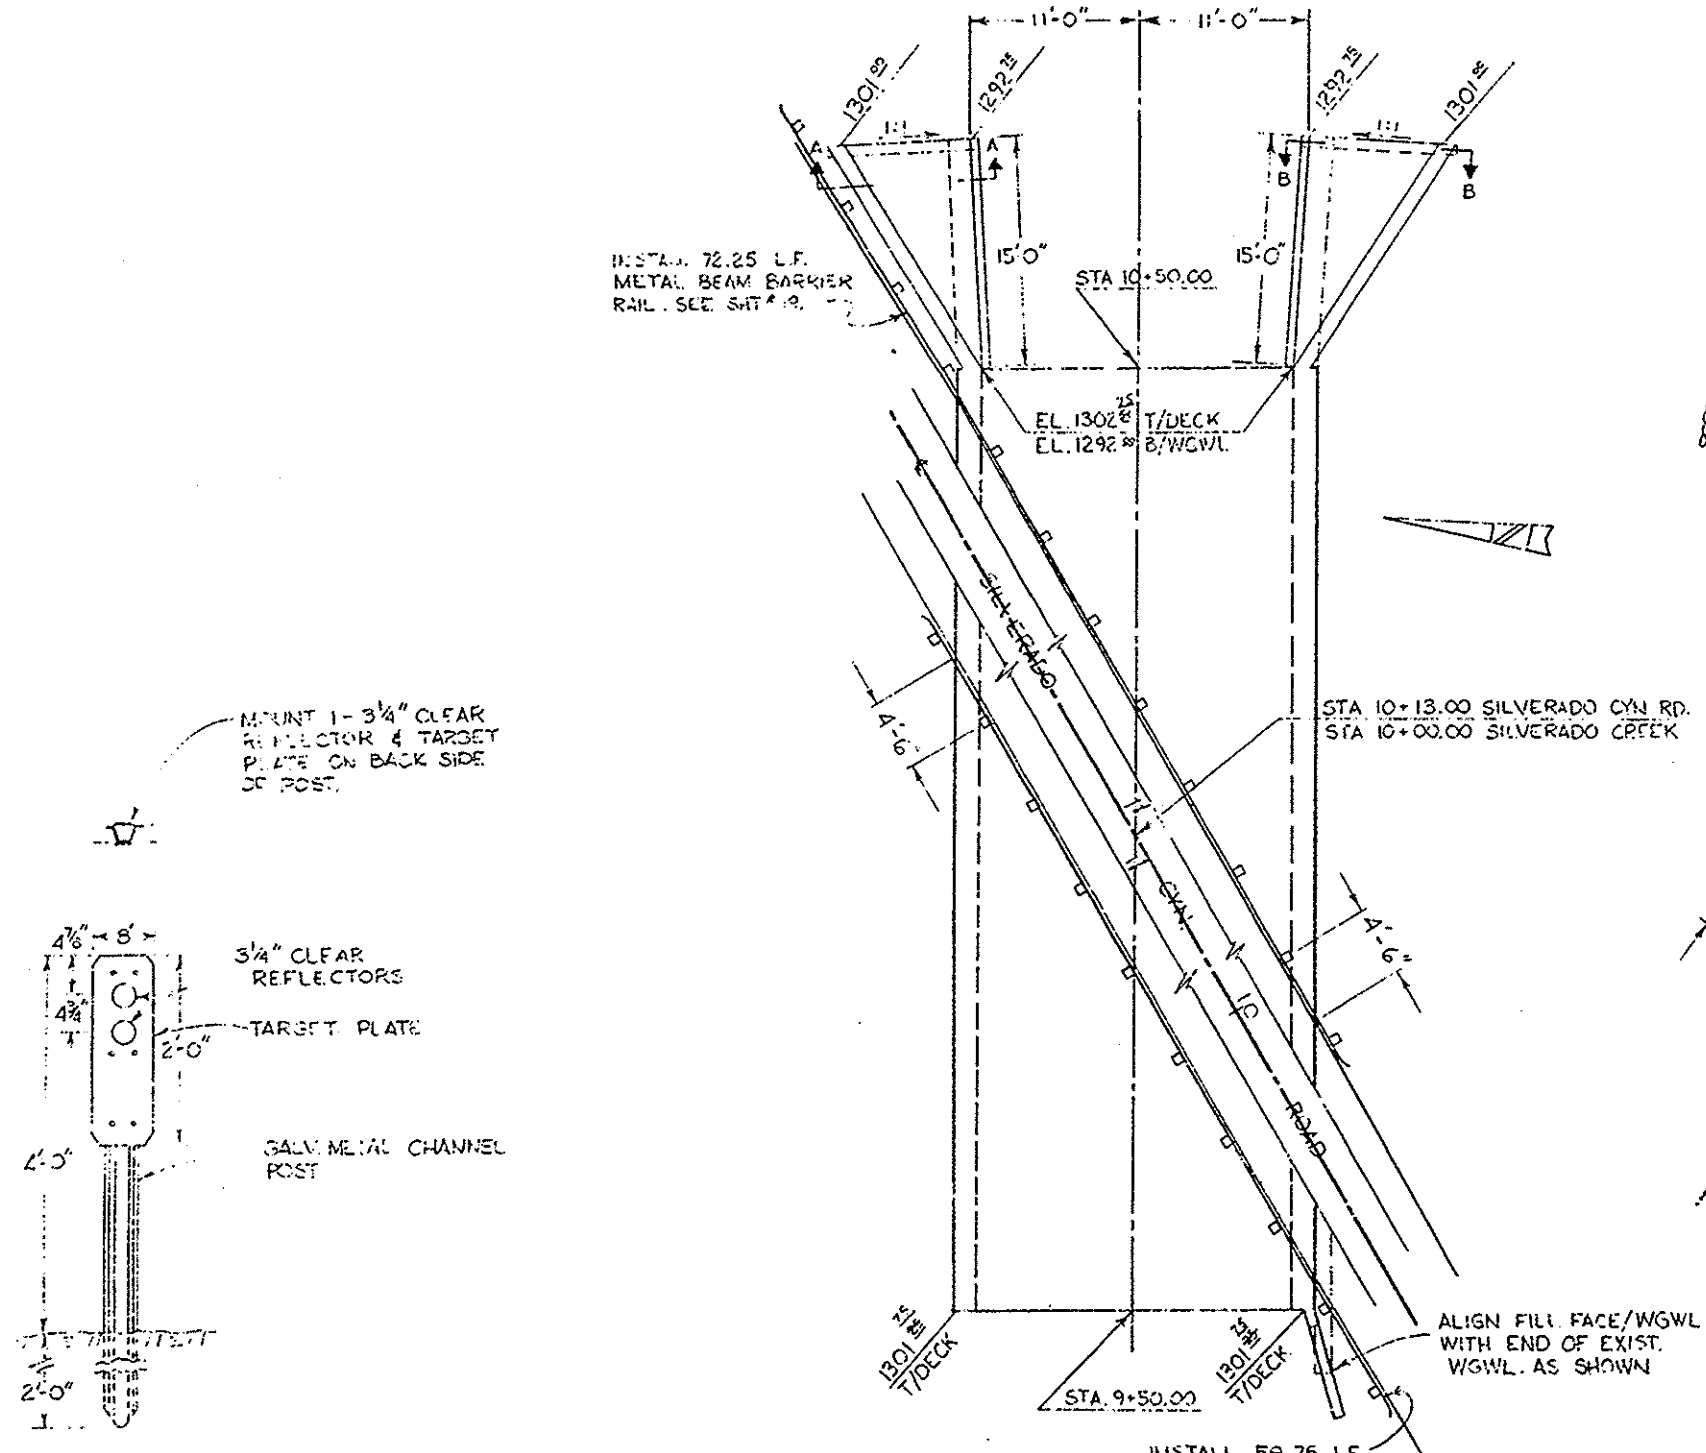


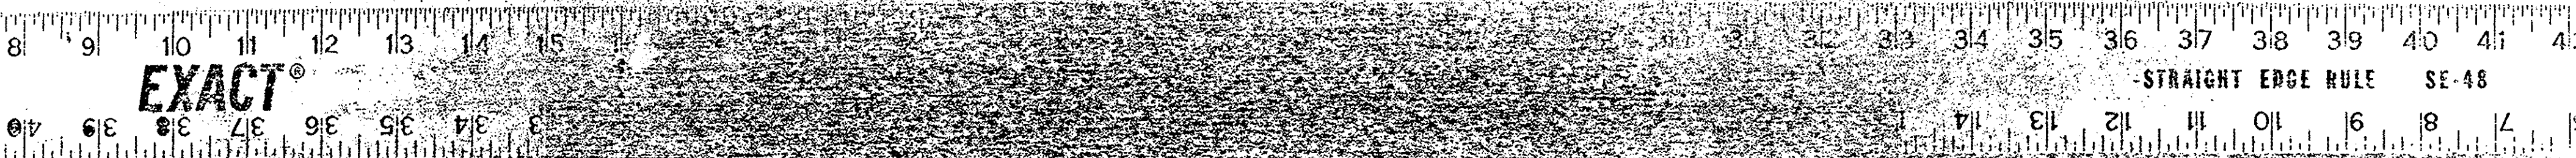


PLAN-BRIDGE SV-10
SCALE 1/8"=1'-0"

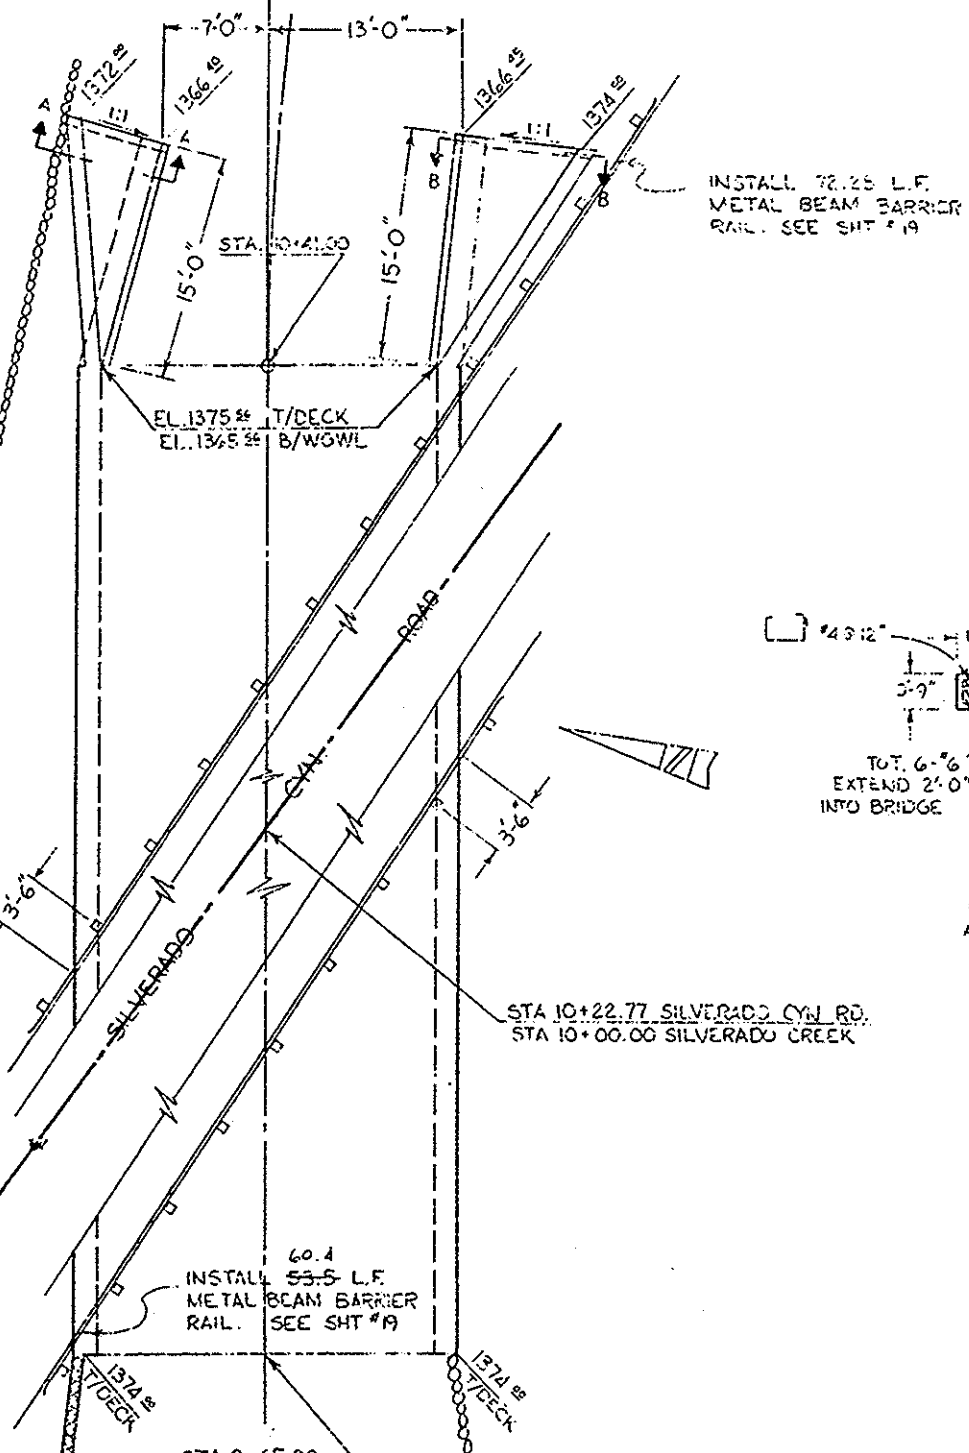

PLAN-BRIDGE SV-14
SCALE 1/8"=1'-0"

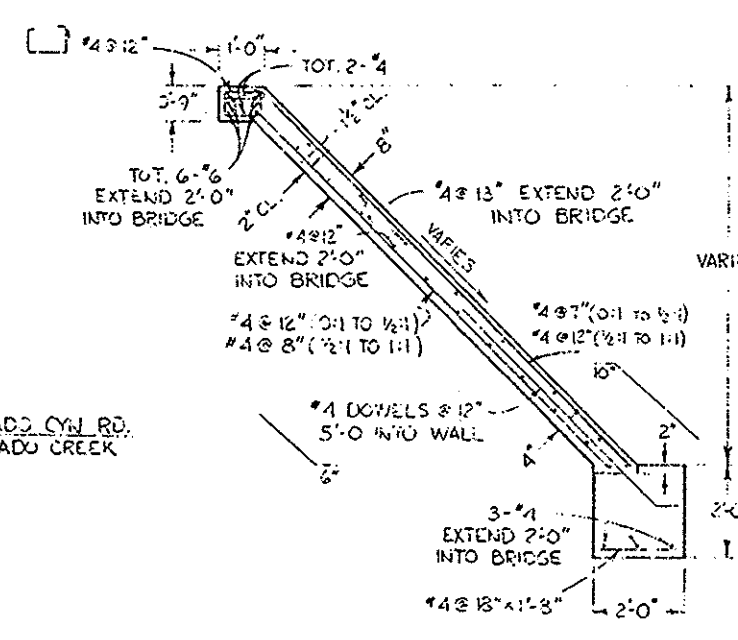

SECTION A-A
SCALE 3/8"=1'-0"


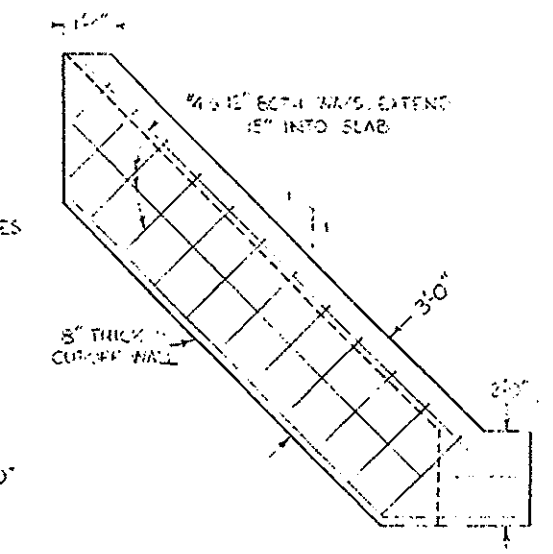


SECTION B-B
SCALE 3/8"=1'-0"

TEMPORARY GUIDE MARKER

TYPE L-2

SCALE 3/4"=1'-0"

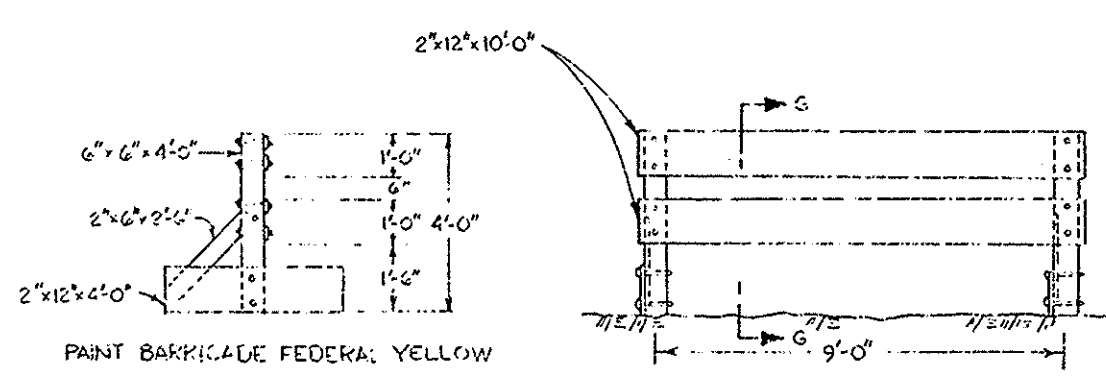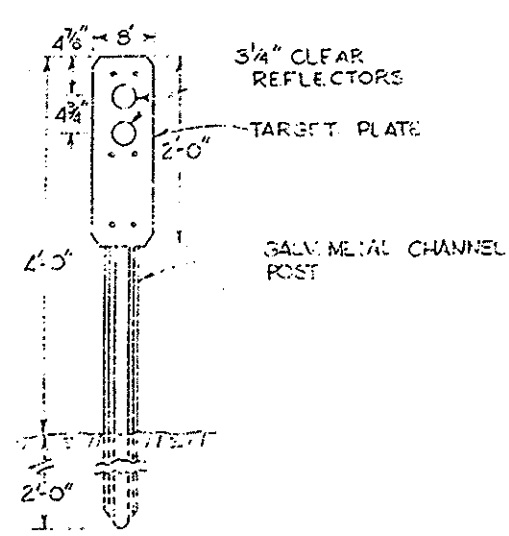


SECTION G-G
NO SCALE

TIMBER BARRICADE
10' SECTIONS

CUT OR BURN EVERY OTHER FRONT FACE FOR 7' BAR.


JOINT MAY BE FORMED WITH 1/2\"/>

DETAIL J-6
NO SCALE

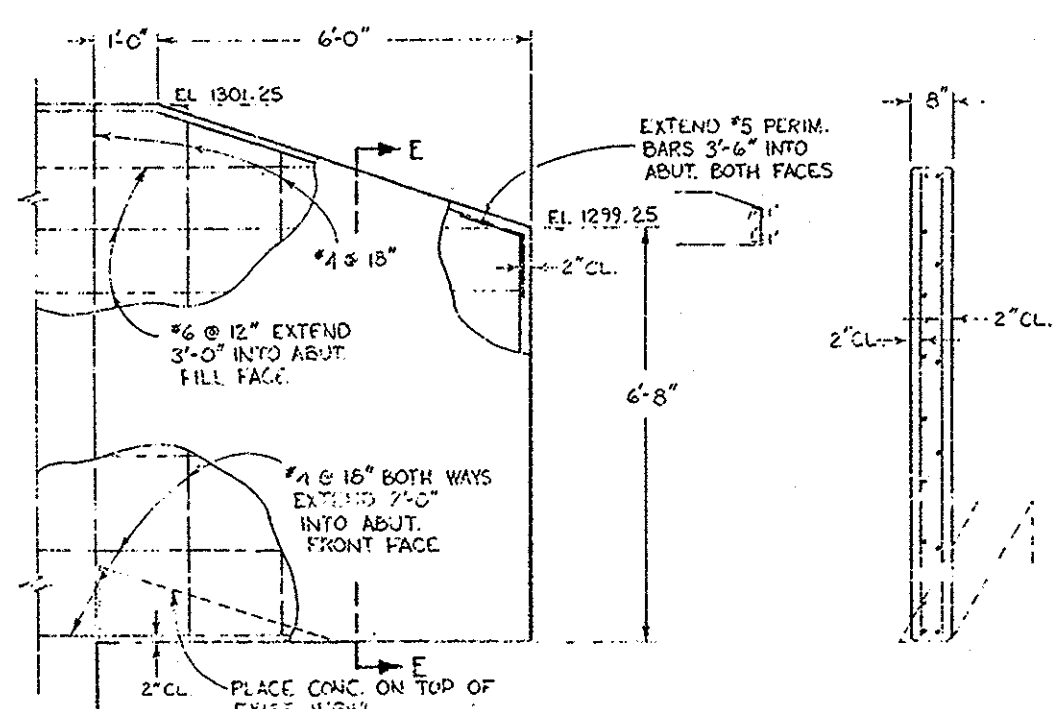

SW WINGWALL BRIDGE SV-10
SCALE 1/2"=1'-0"

SECTION E-E
SCALE 1/2"=1'-0"

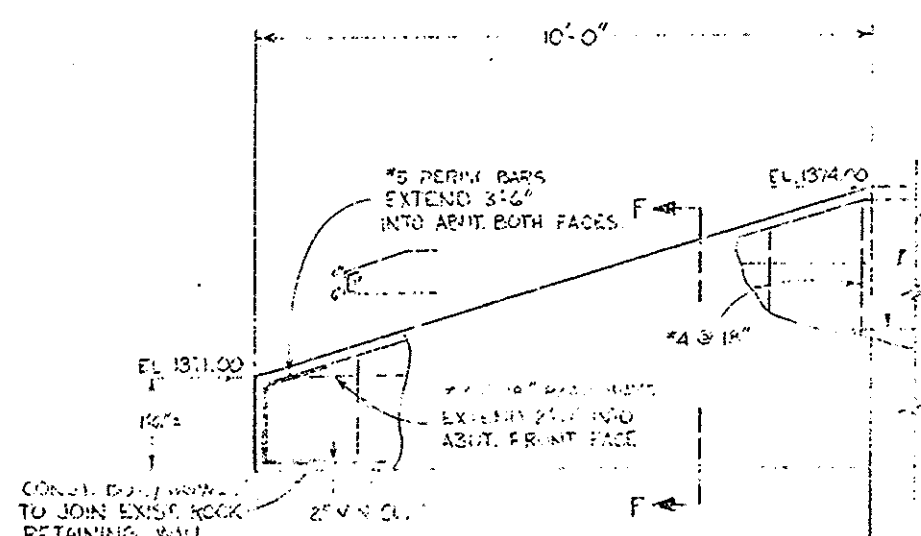

NW WINGWALL BRIDGE SV-14

AS BUILT

CONSTRUCTION PLANS
Silverado Canyon Road Bridges
Sheet 12 of 19
Red. 22.5.11
Scale: As shown
Vellum

SECTION F-F
SCALE 1/2"=1'-0"

SILVERADO CYN. ROAD
BRIDGES SV-10, SV-14
OVER
SILVERADO CREEK
GENERAL BRIDGE PLAN &
WINGWALL DETAILS