
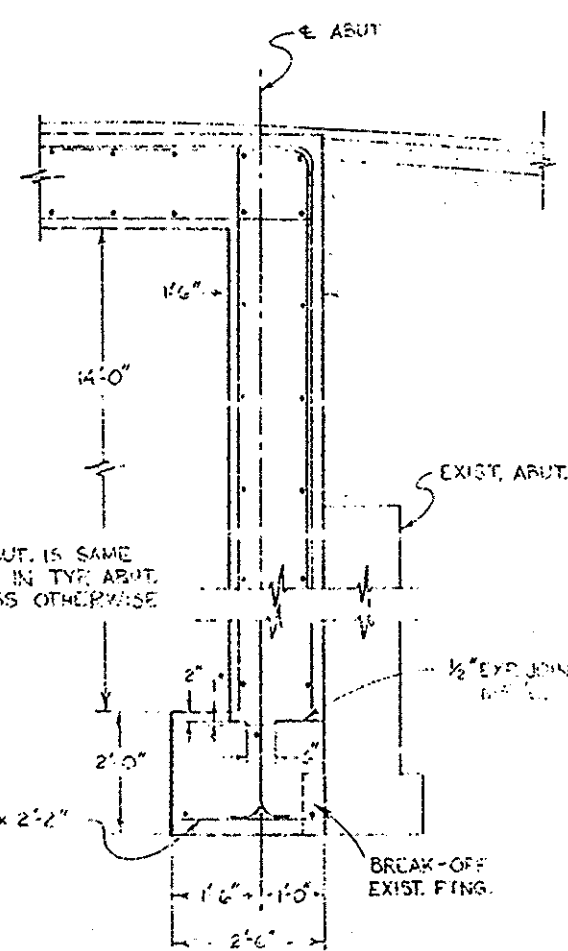
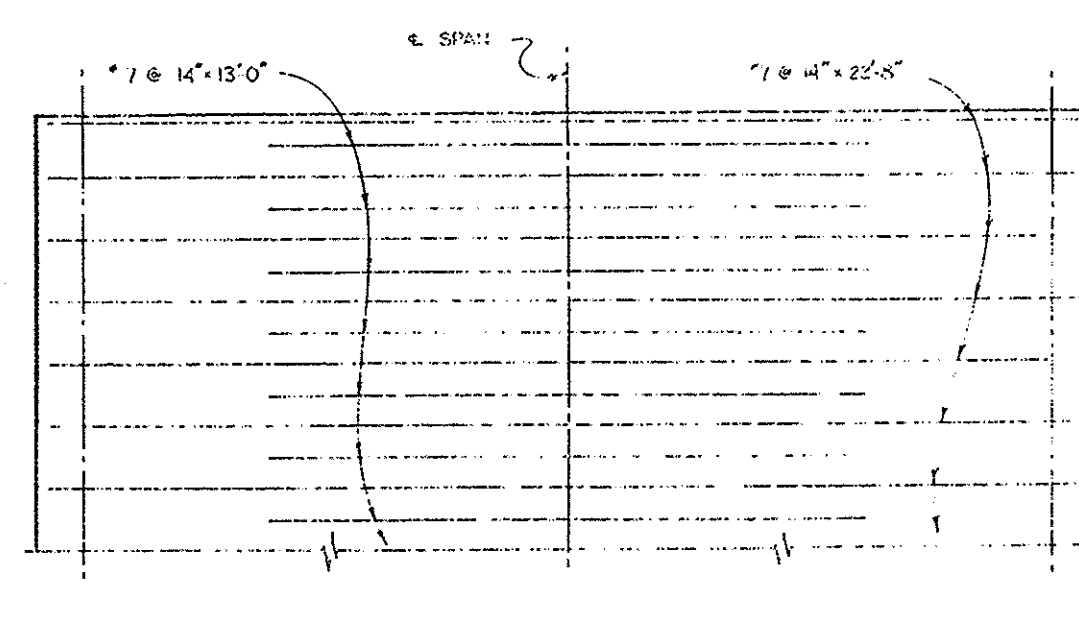
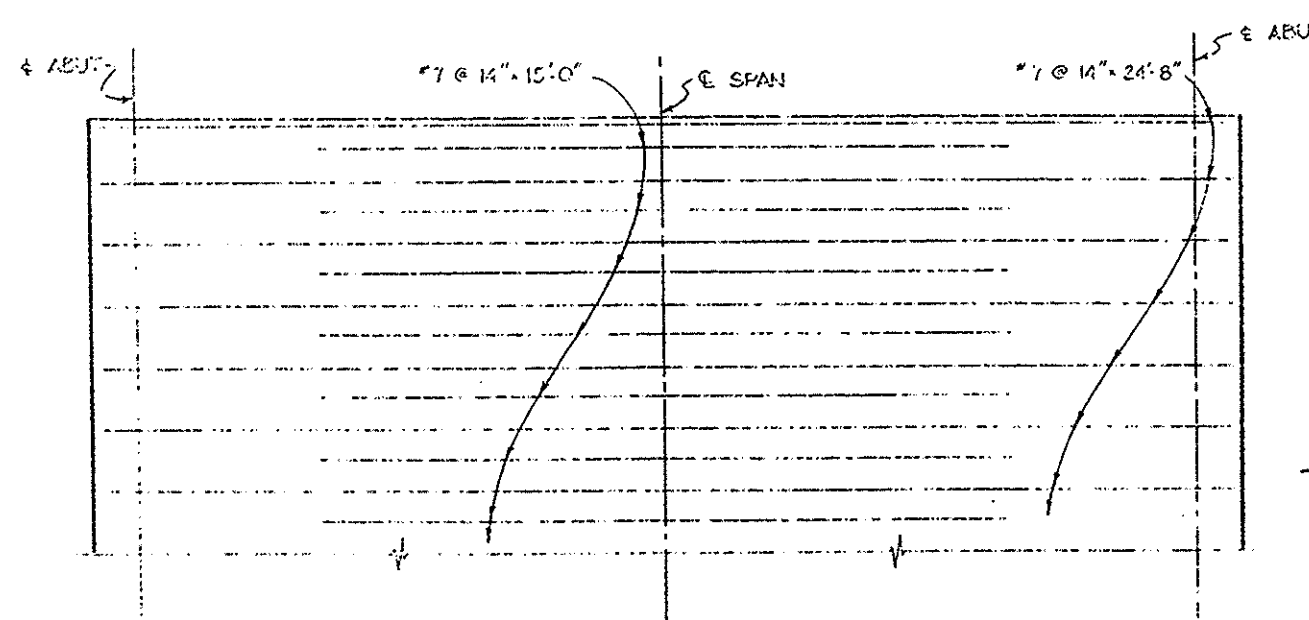
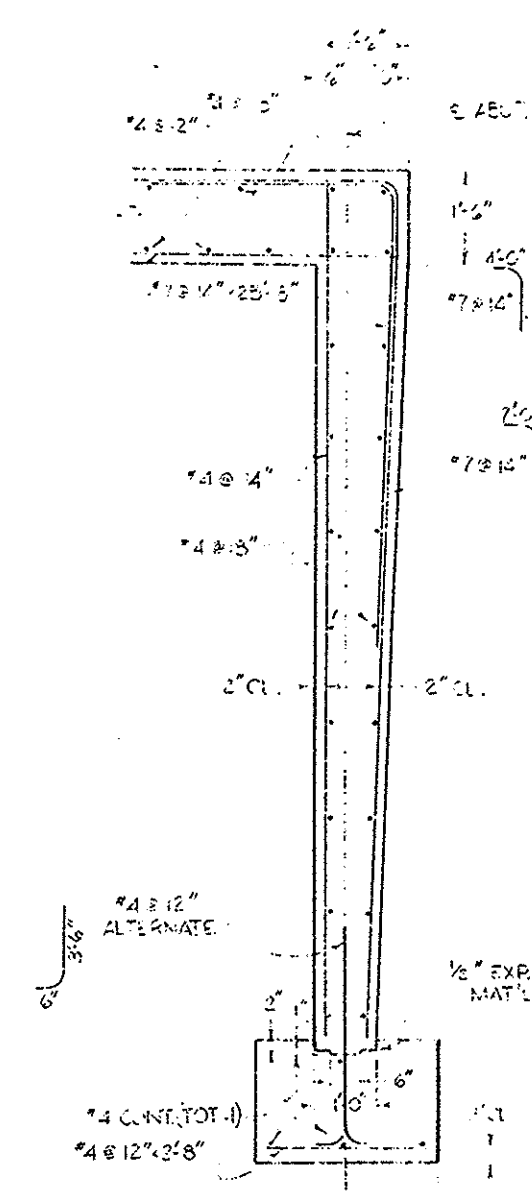
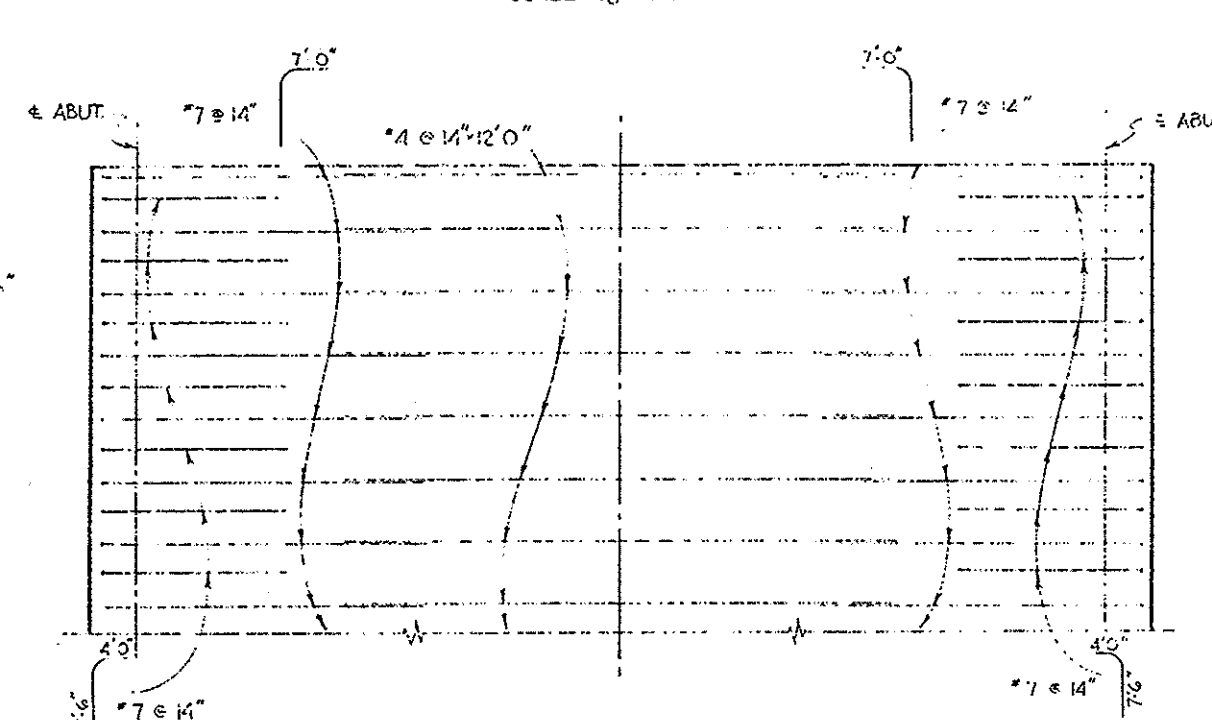
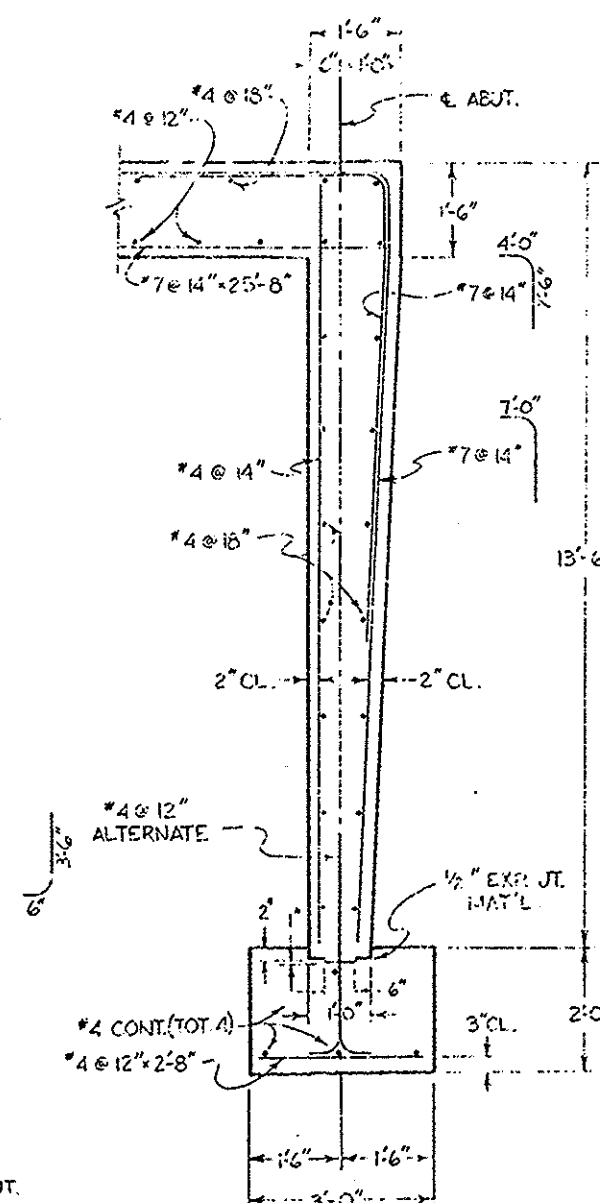
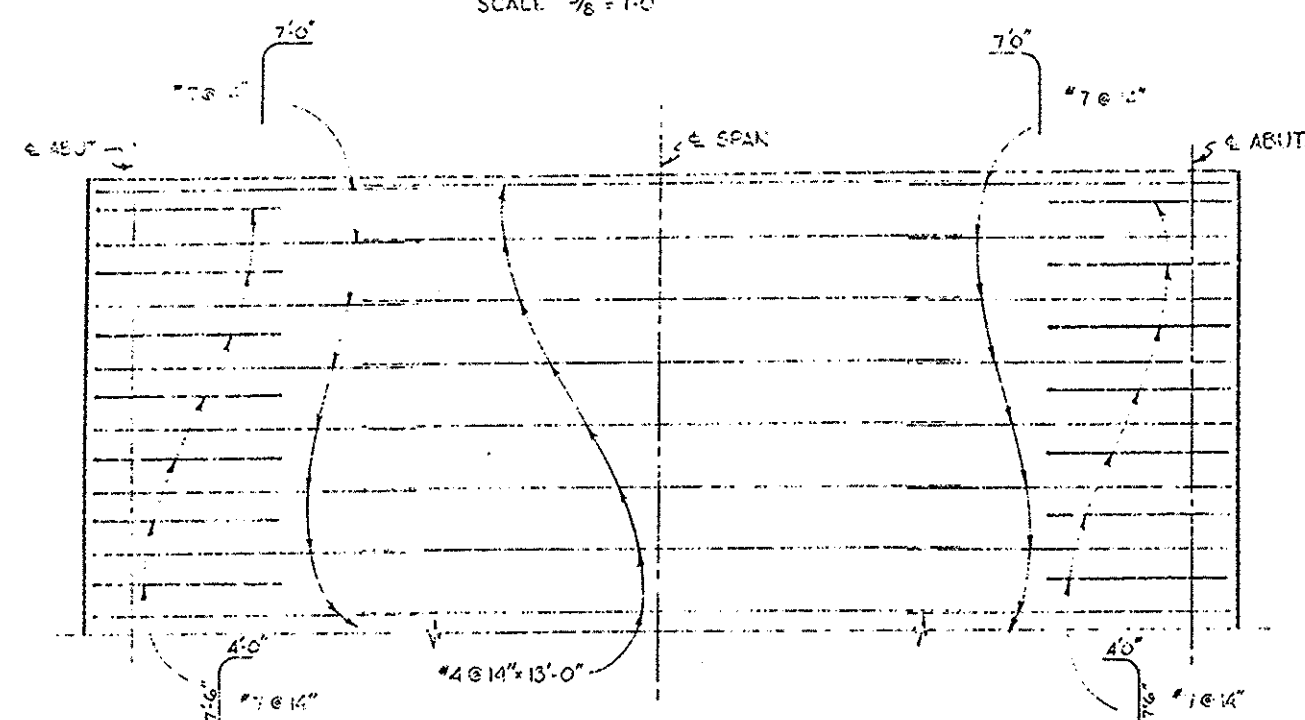
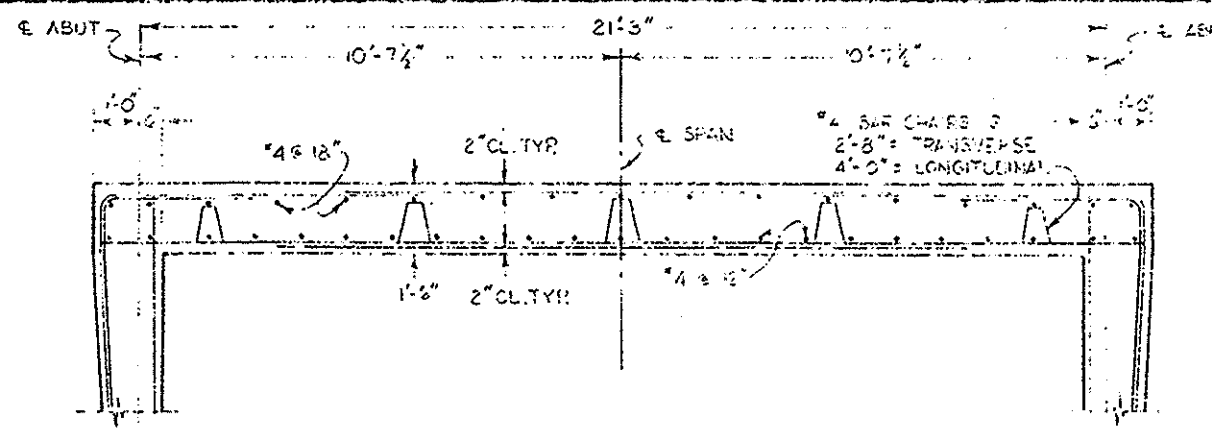



EXACT®

STRAIGHT EDGE RULE SE-43

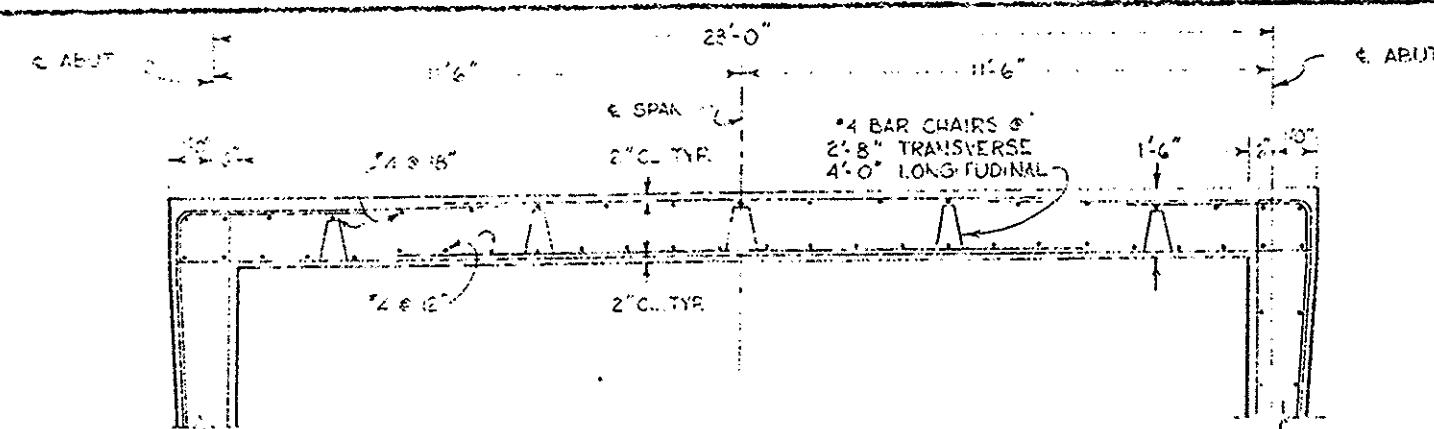

ALL STEEL IN ABUT. IS SAME AS THAT SHOWN IN TYP. ABUT. SECTION UNLESS OTHERWISE NOTED.

AS BUILT

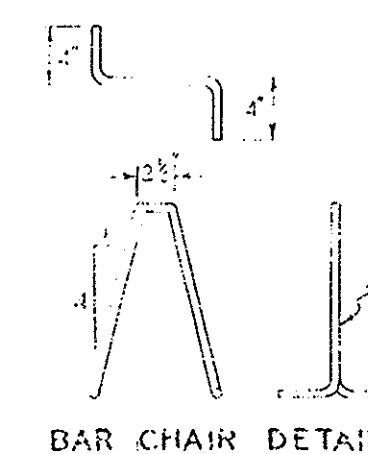

ON EXISTING PILES
SILVERADO CYN. RD. BRIDGE
SHEET 14 OF 19
REV. 22-51 SET: AS SHOWN
VELUM

SILVERADO CYN. RD.
BRIDGE SV-10, SV-14
OVER
SILVERADO CREEK
DECK REINFORCEMENT
DETAILS
AS NOTED

DR. (10-77)