




STA 11+00

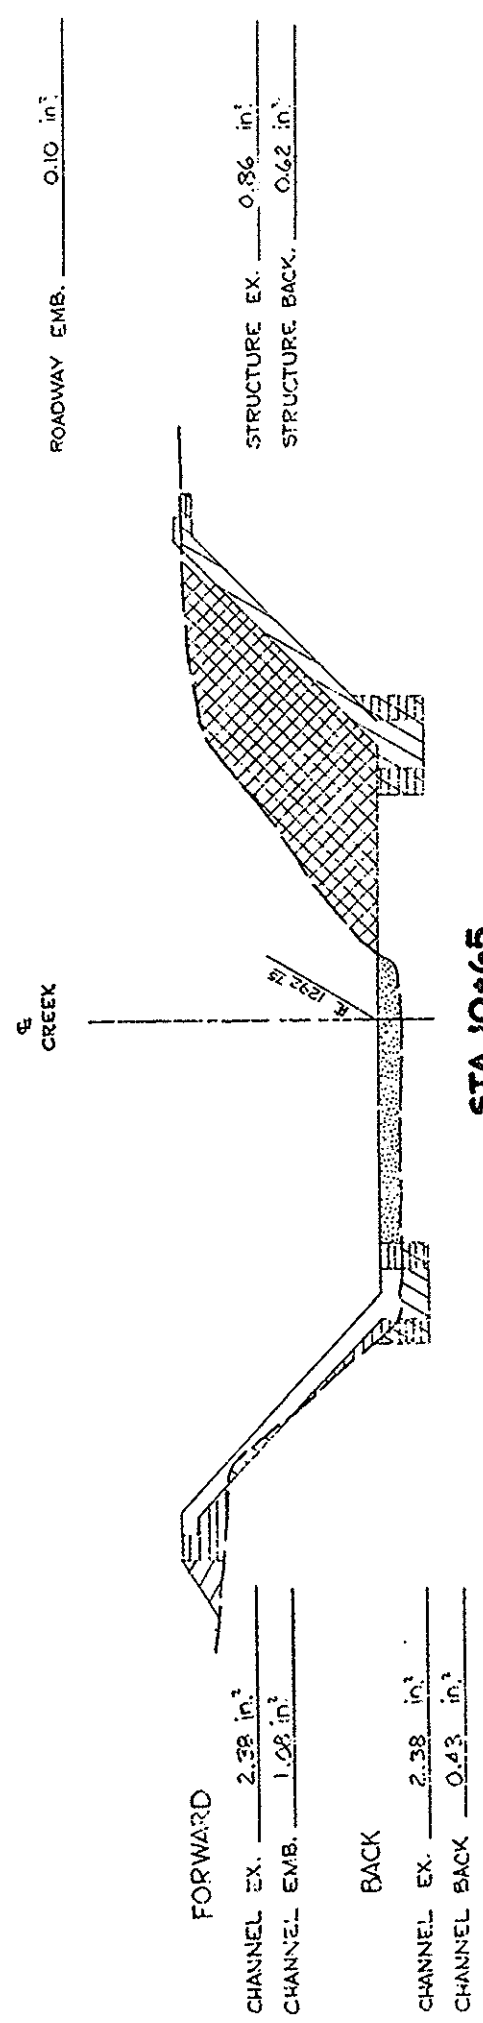

STA 10+65

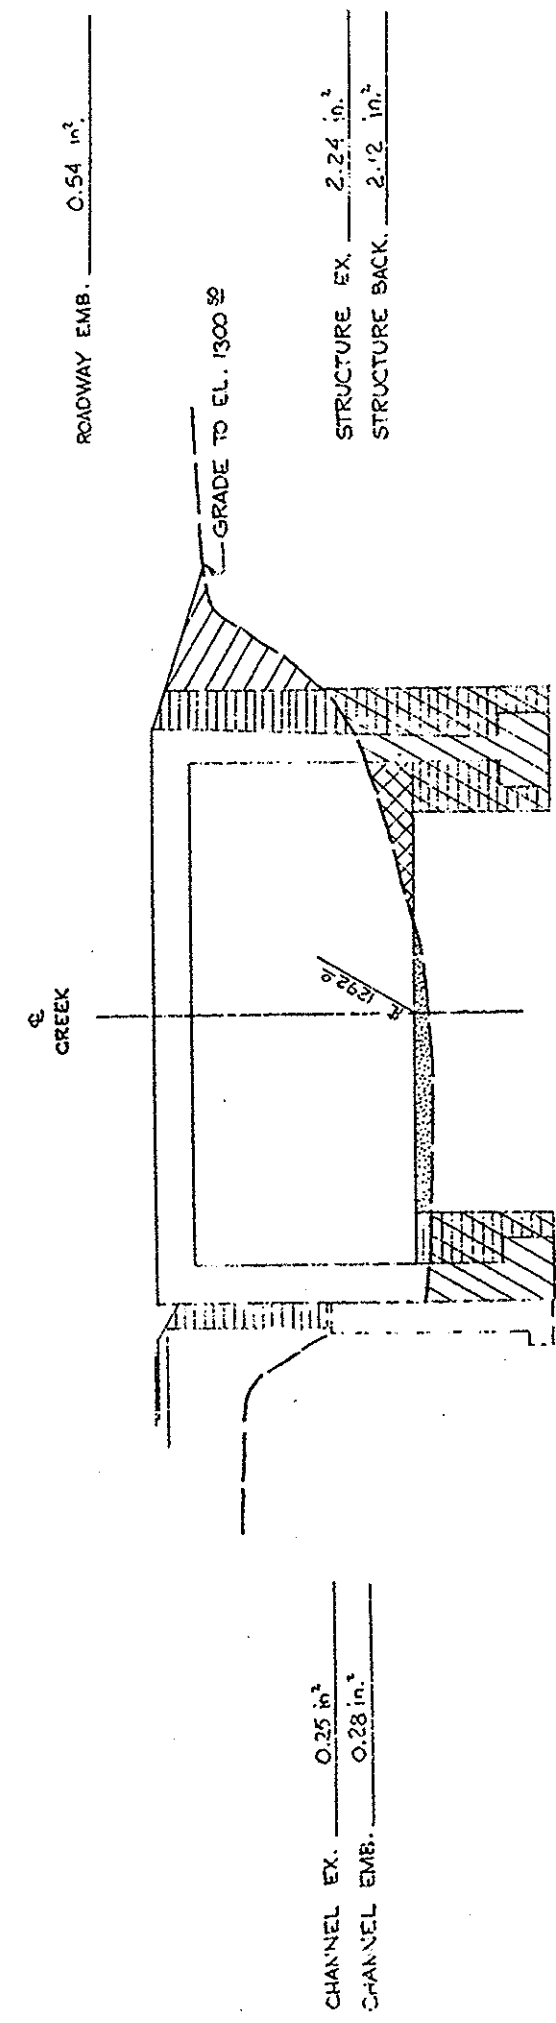


STA 10+50

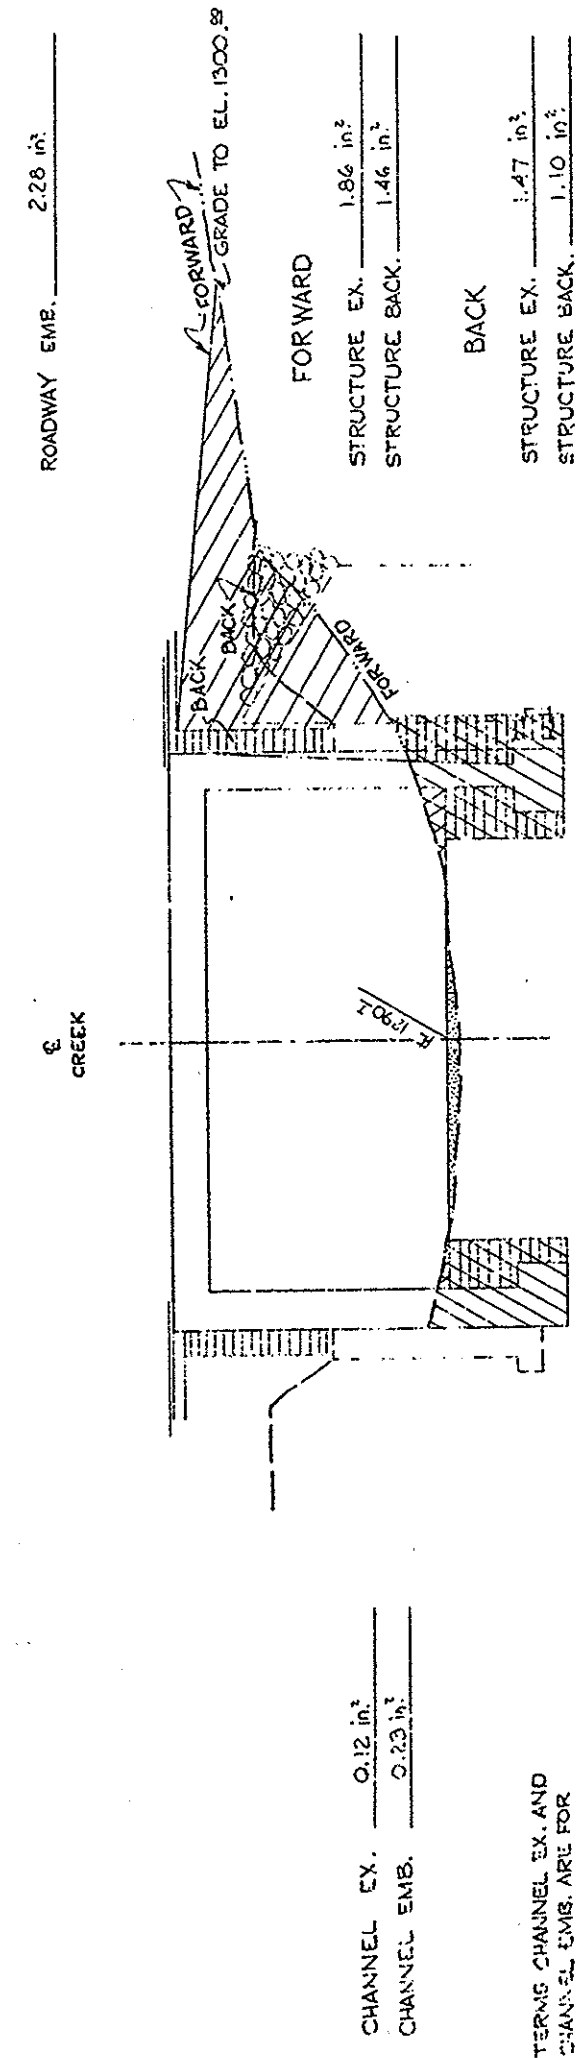


STA 10+13

NOTE: TERMS CHANNEL EX. AND CHANNEL EMB. ARE FOR CLARITY ONLY. CHANNELS ARE TO BE REVERSED AS SHOWN IN PLAN AND ROADWAY EMB.

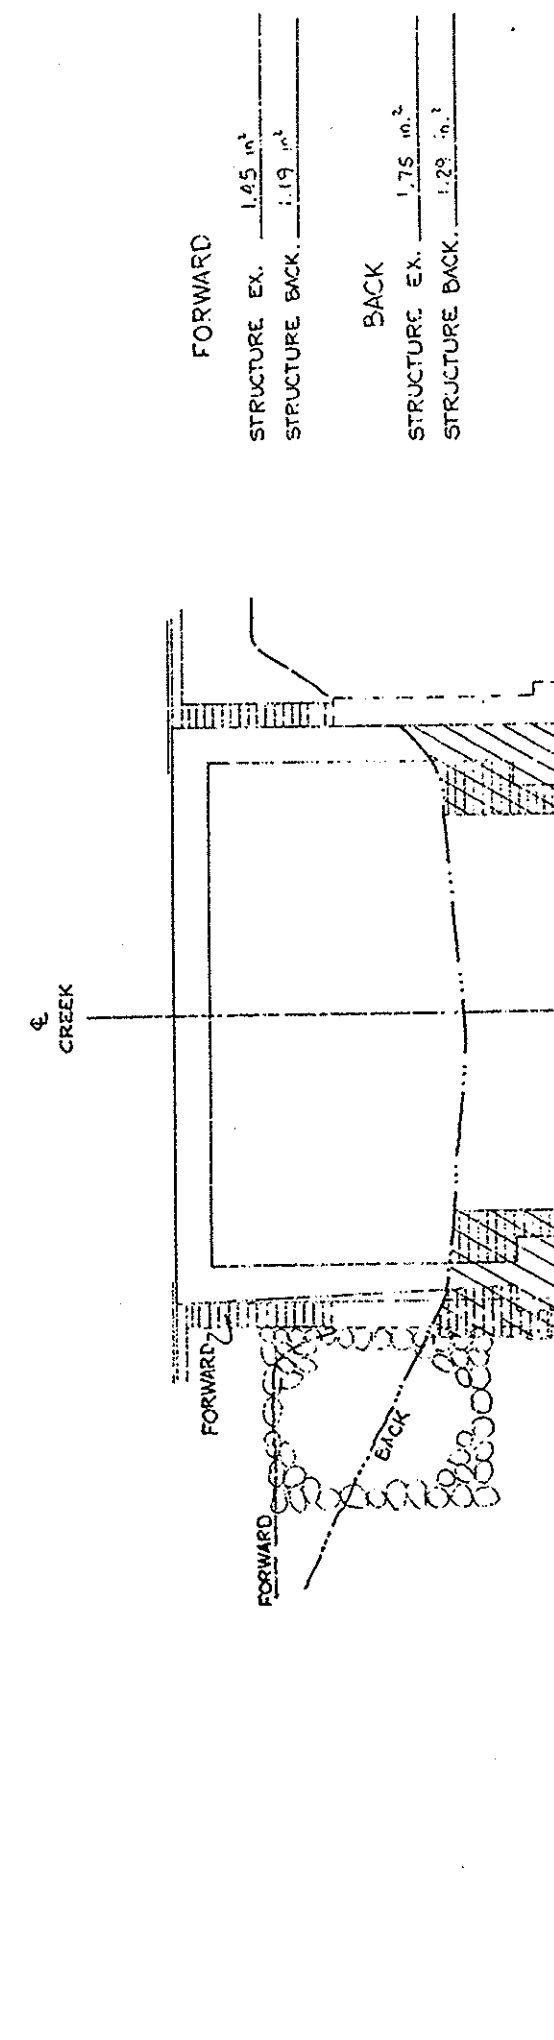

STA 10+00

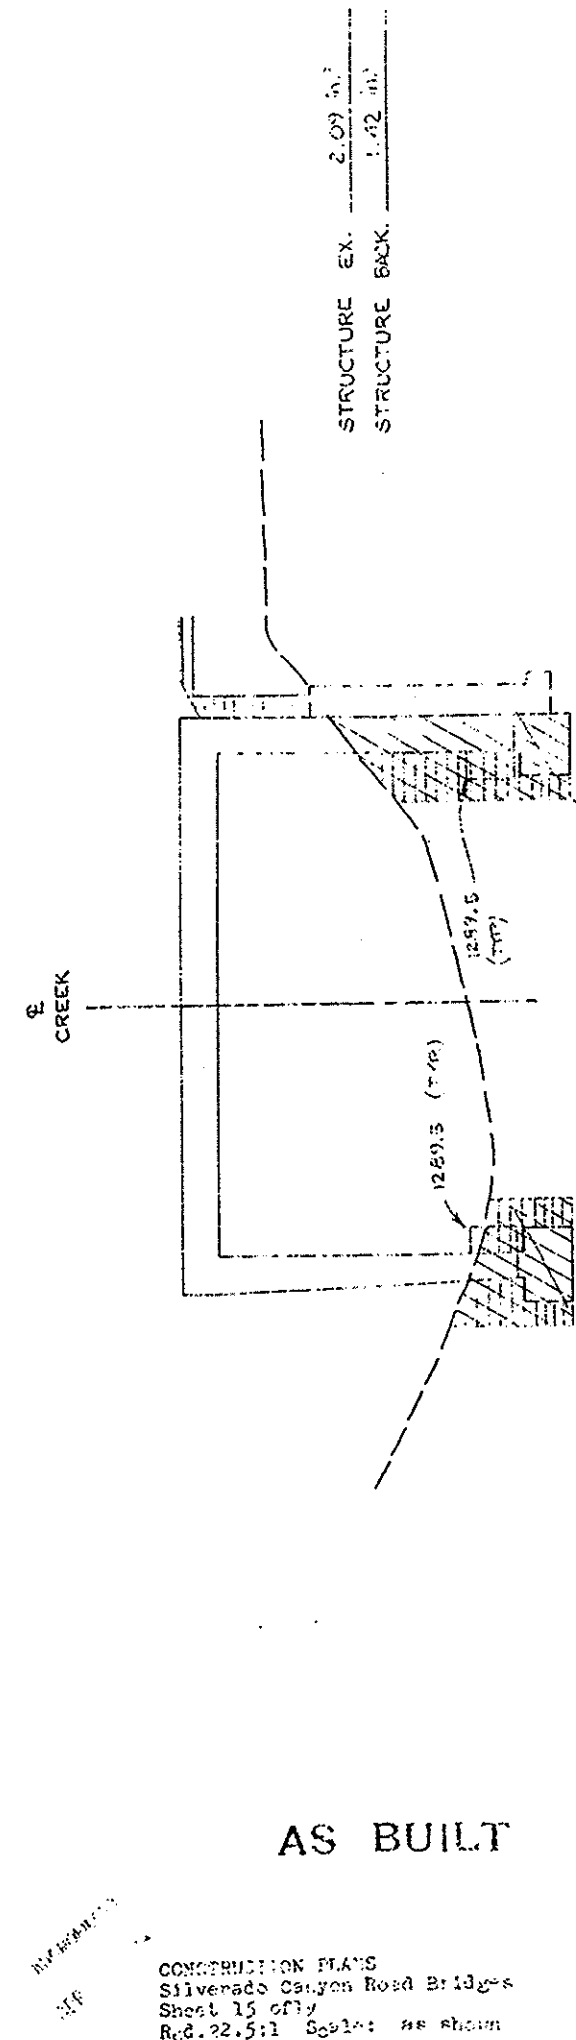

STA 9+50

AS BUILT

CONSTRUCTION PLANS
Silverado Canyon Road Bridge
Sheet 15 of 17
R.D. 22, 511 Scale: as shown
Velling

SILVERADO CANYON ROAD BRIDGE, STA 10
STRUCTURE EX. & BACKFILL
HORIZ. & VERT. 1"=5'-0"