

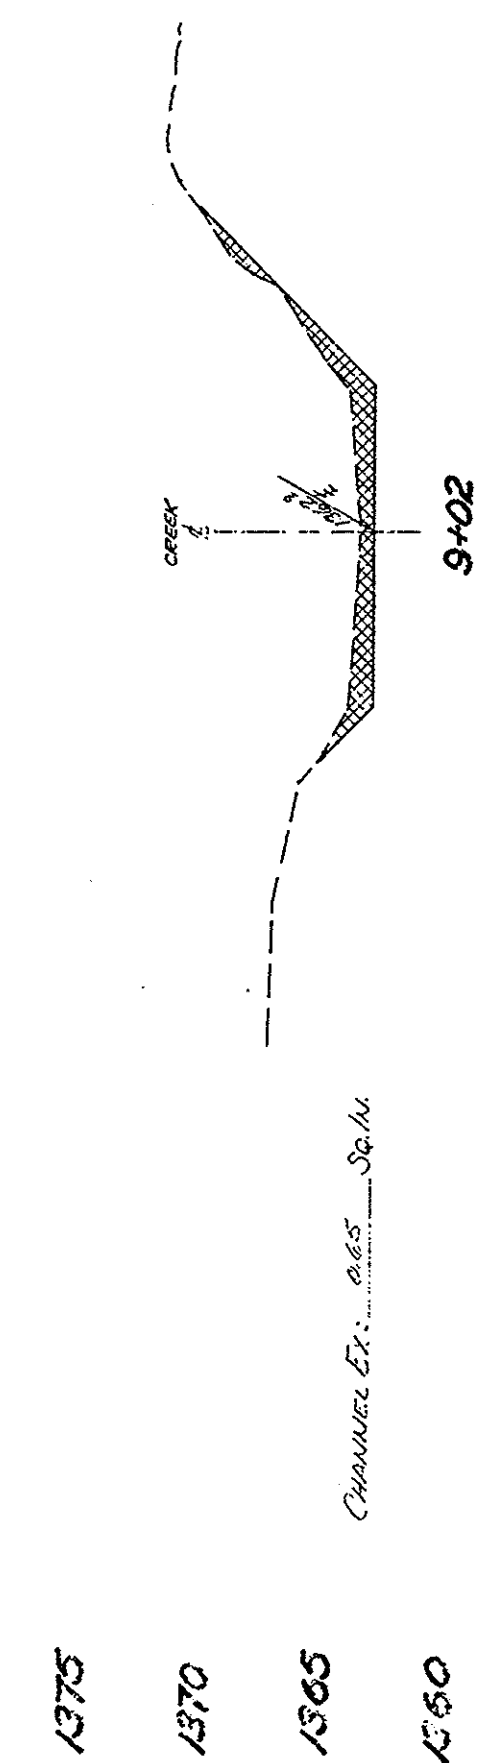
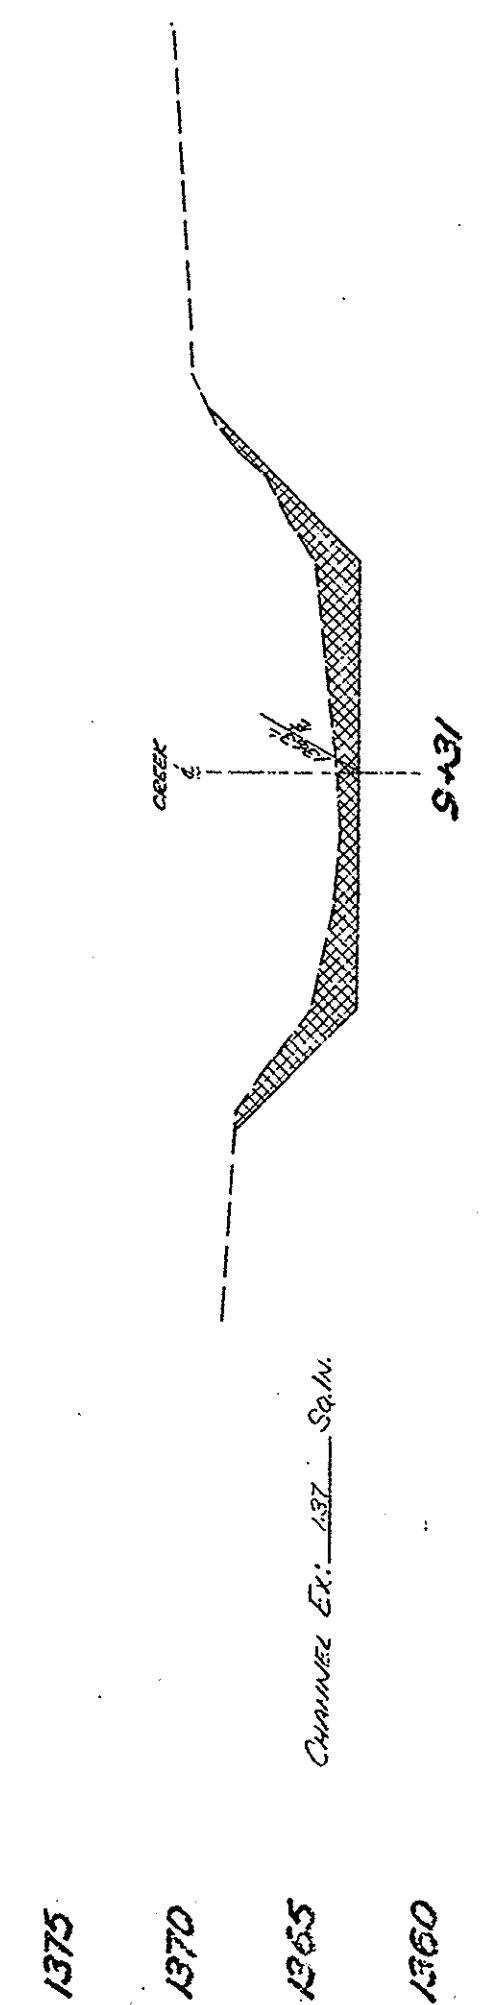
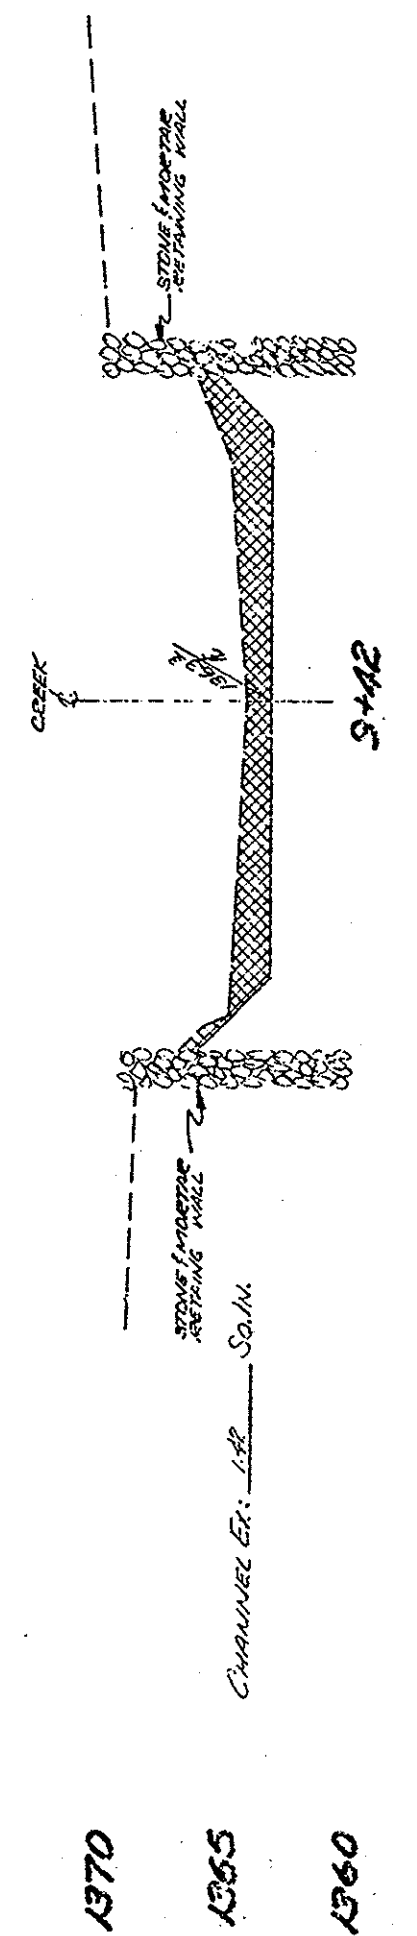
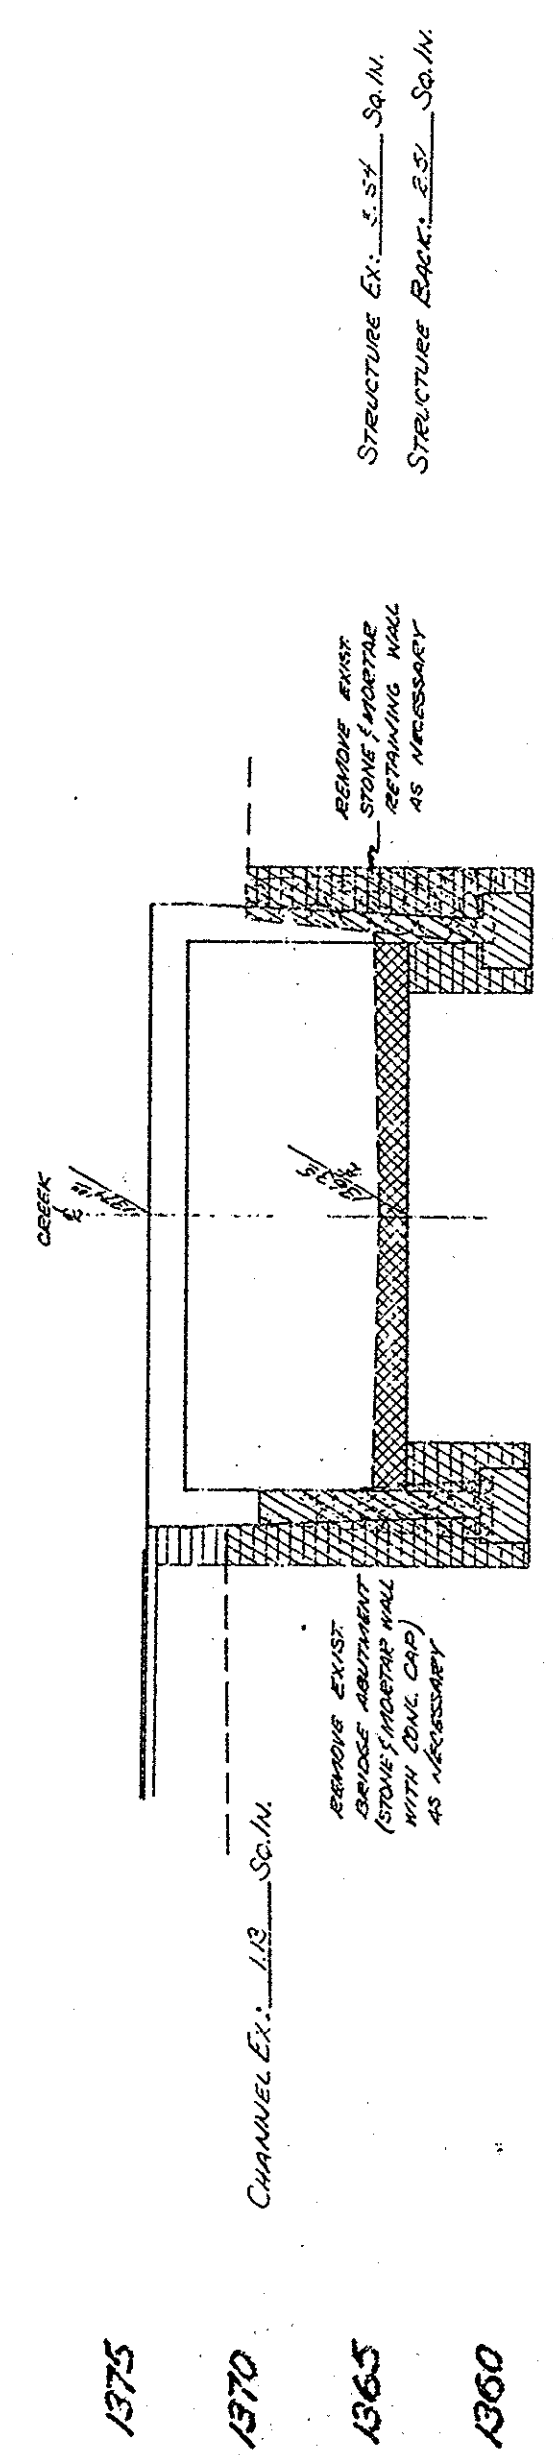
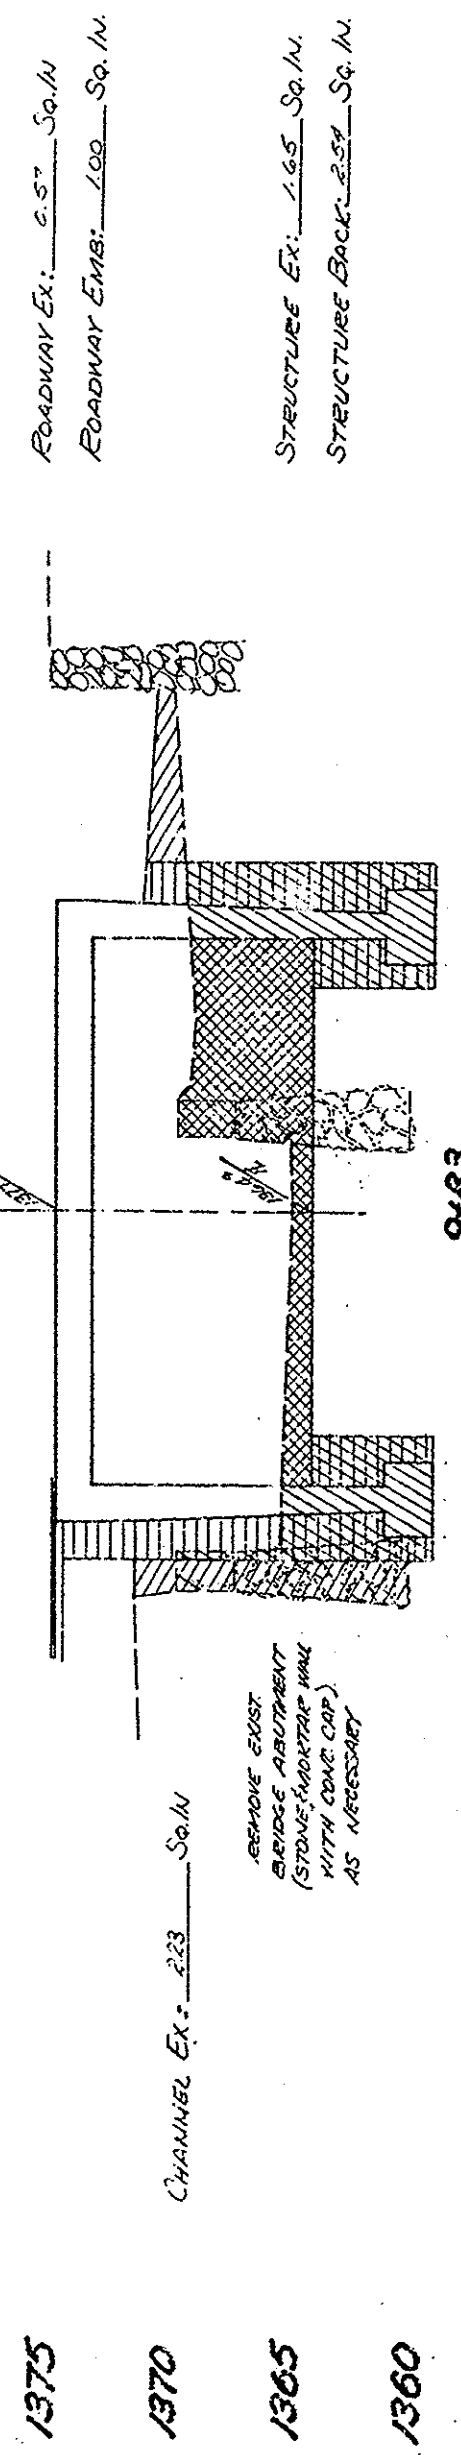


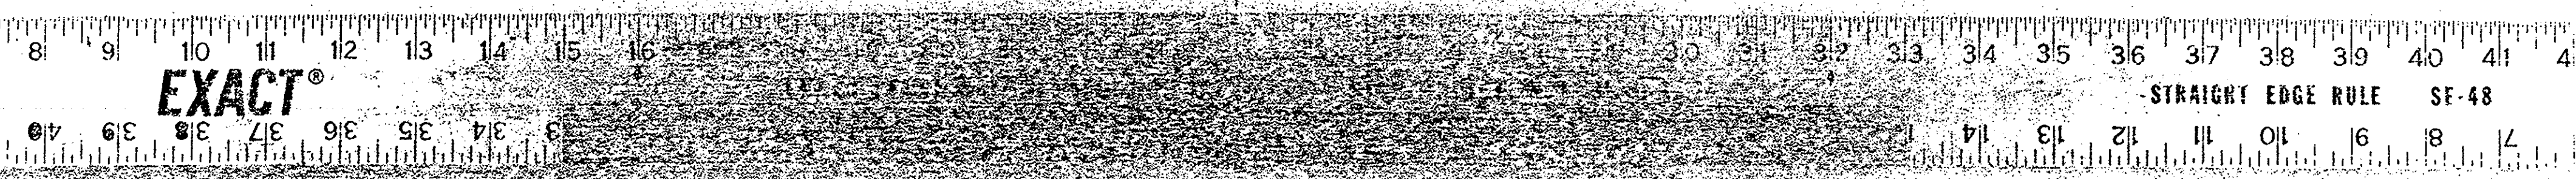

CONSTRUCTION PLANS
Silverado Canyon Road Bridges
Sheet 16 of 19
Red. 22.5:1 Scale: as shown
12-11-11

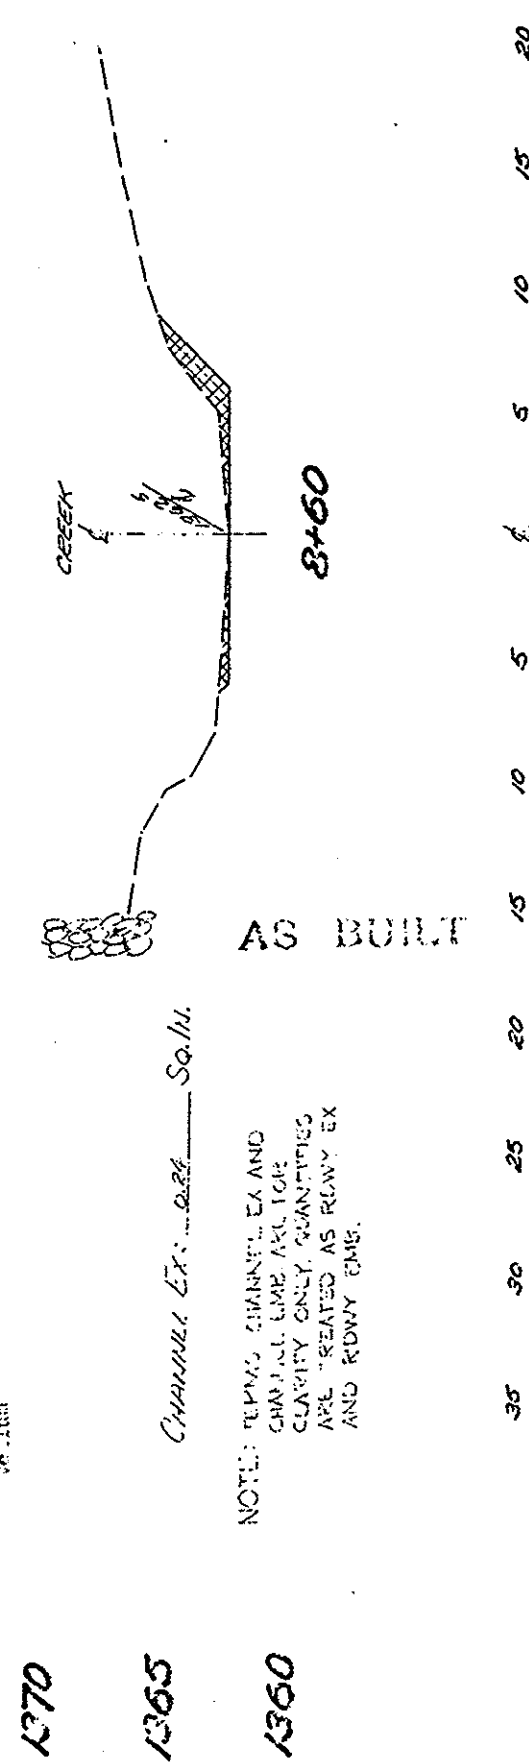

NOTE: REMOVE EXIST. BRIDGE ABUTMENT (STONE MASONRY WALL WITH CONC. CAP) AS NECESSARY. CLARIFY ONLY QUANTITIES ARE "AS BUILT" EX. AND ROADWAY EMB.

SILVERADO CANYON BRIDGE SHW
MAY 1975