
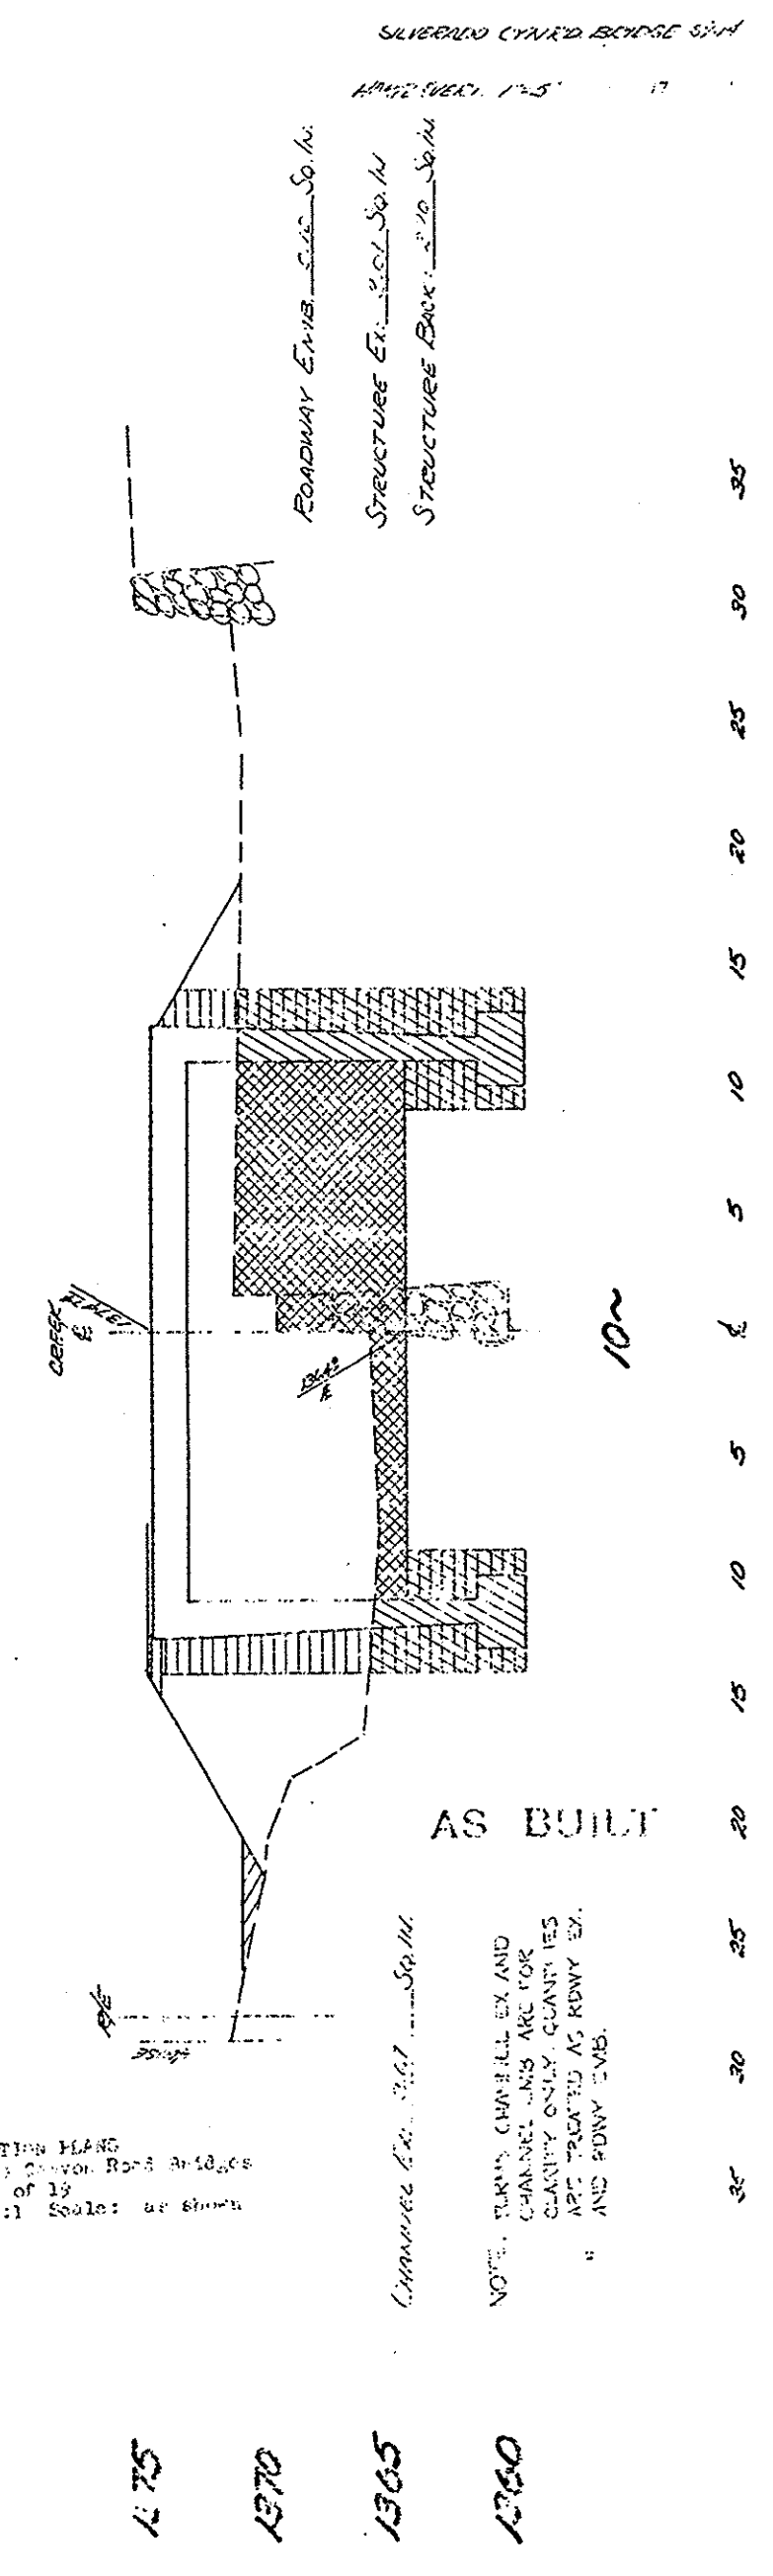
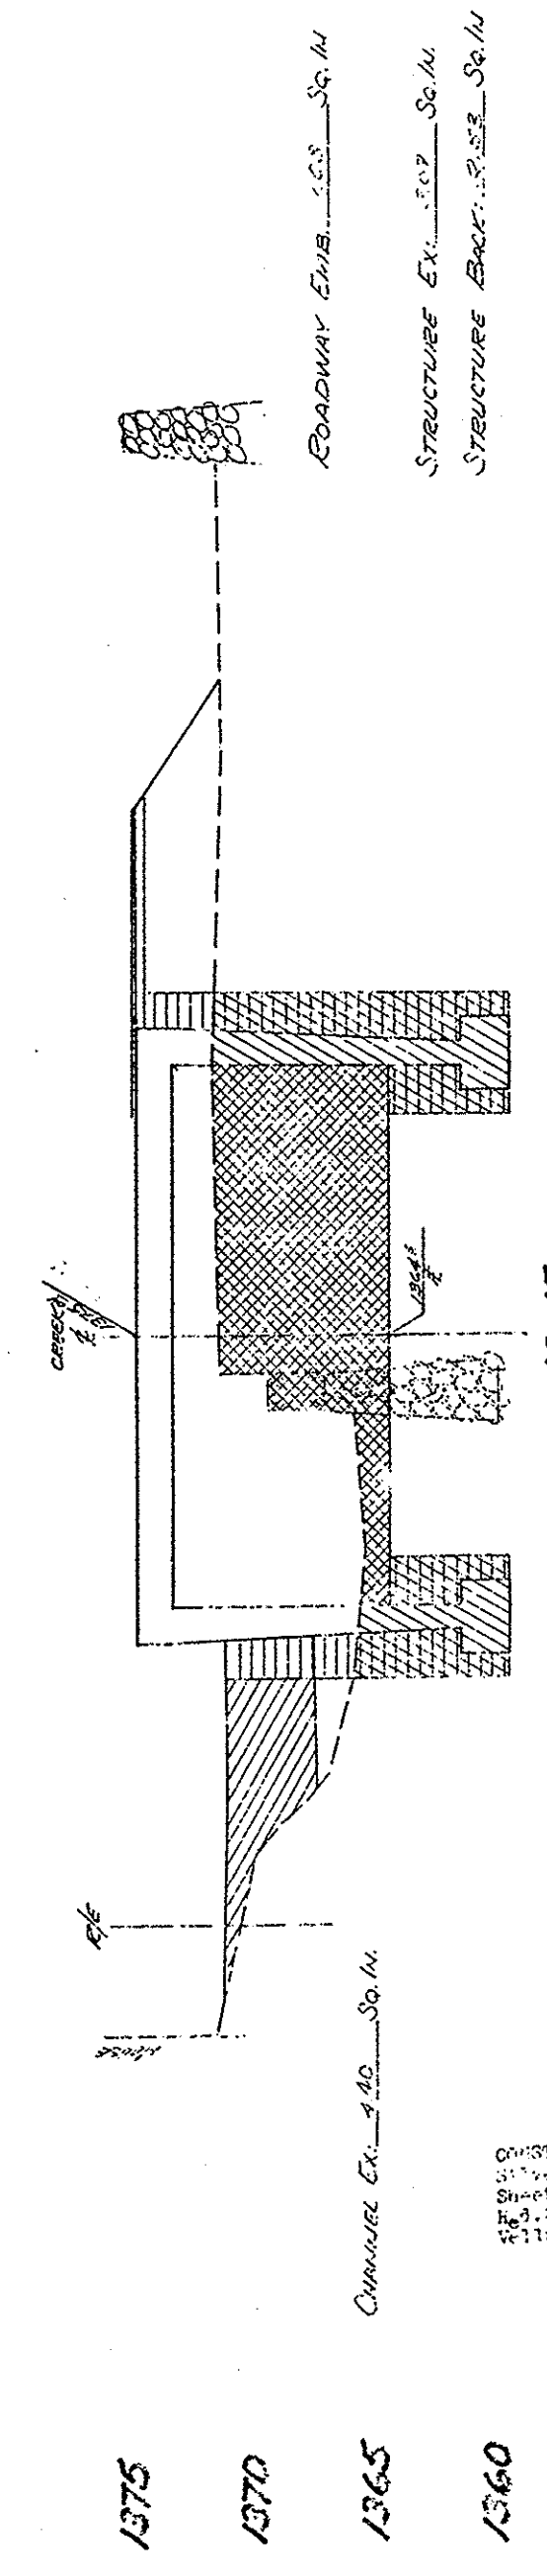
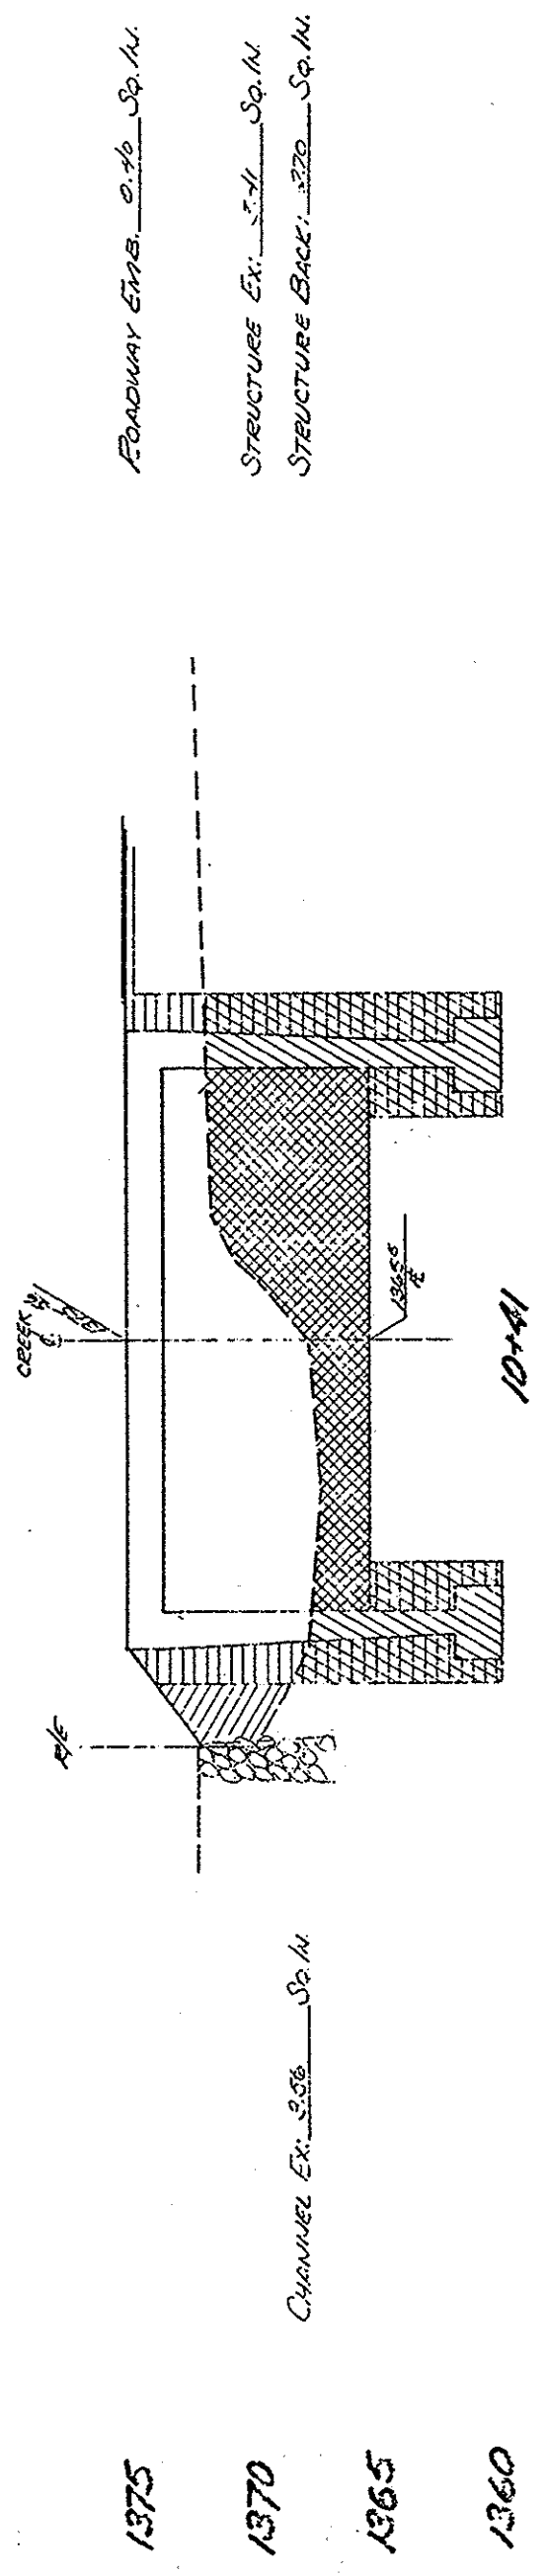
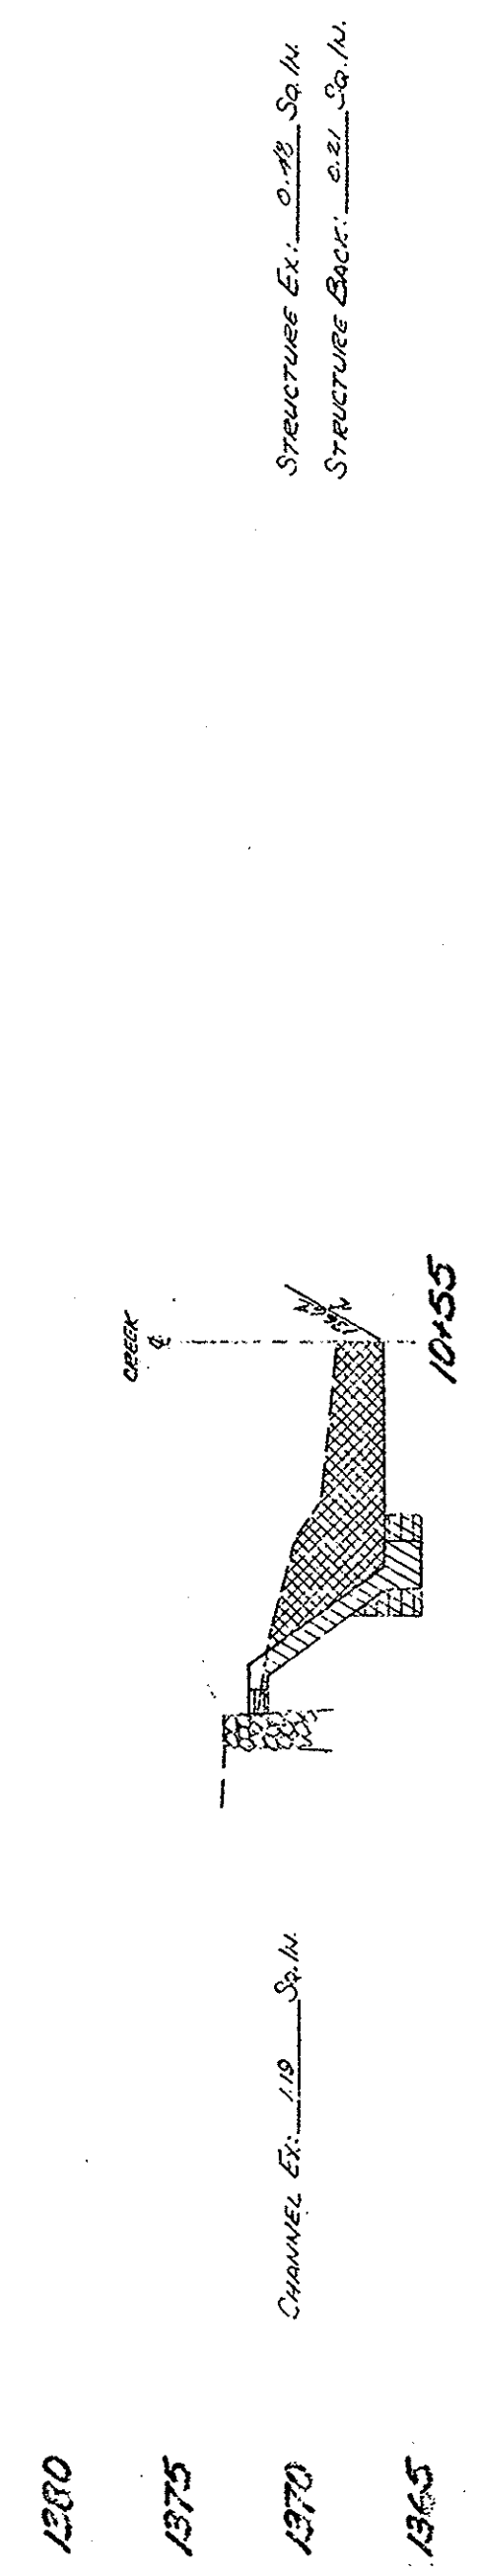
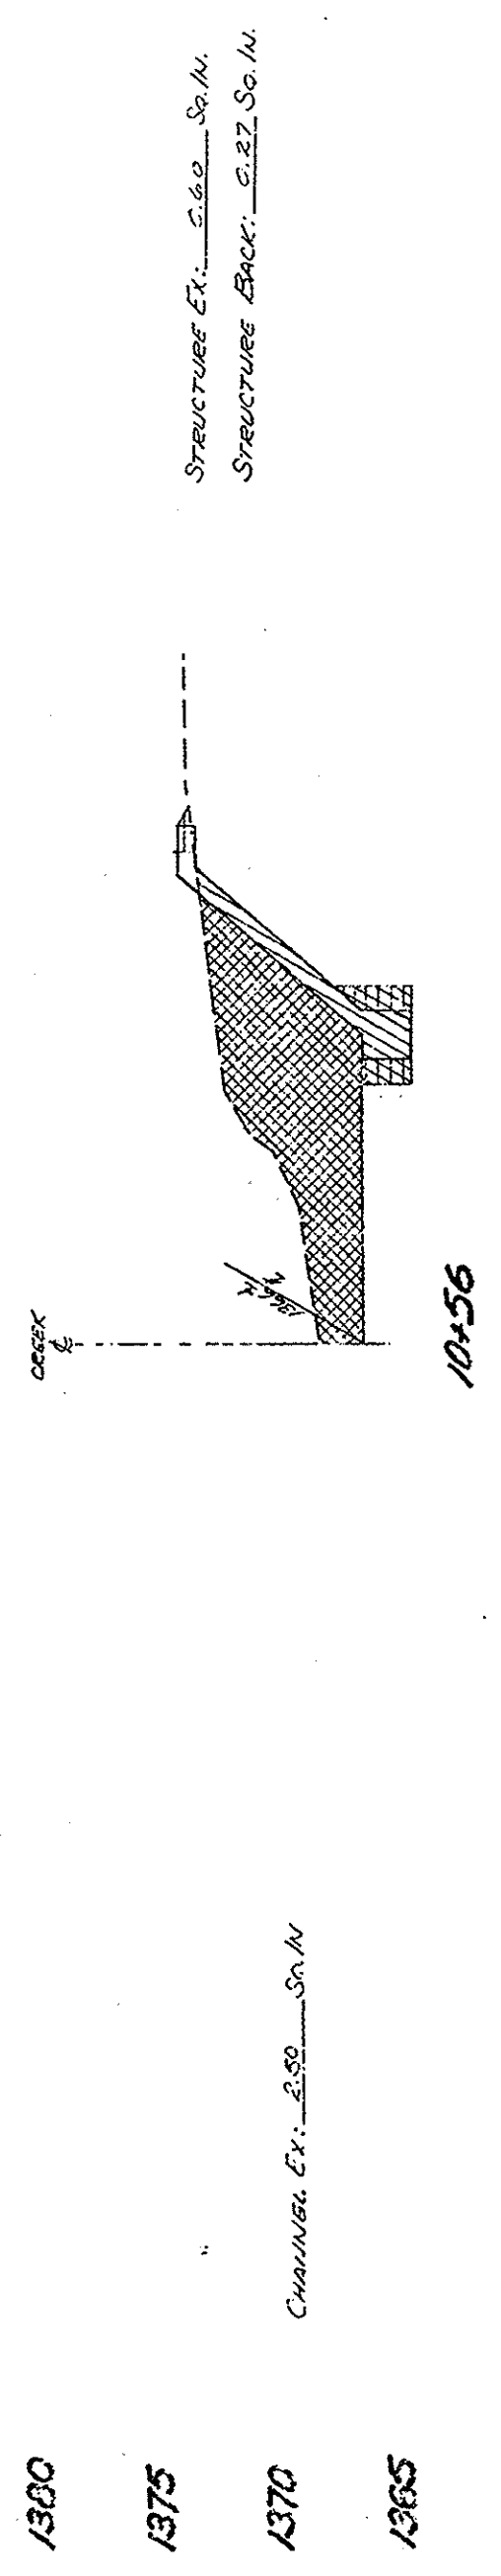
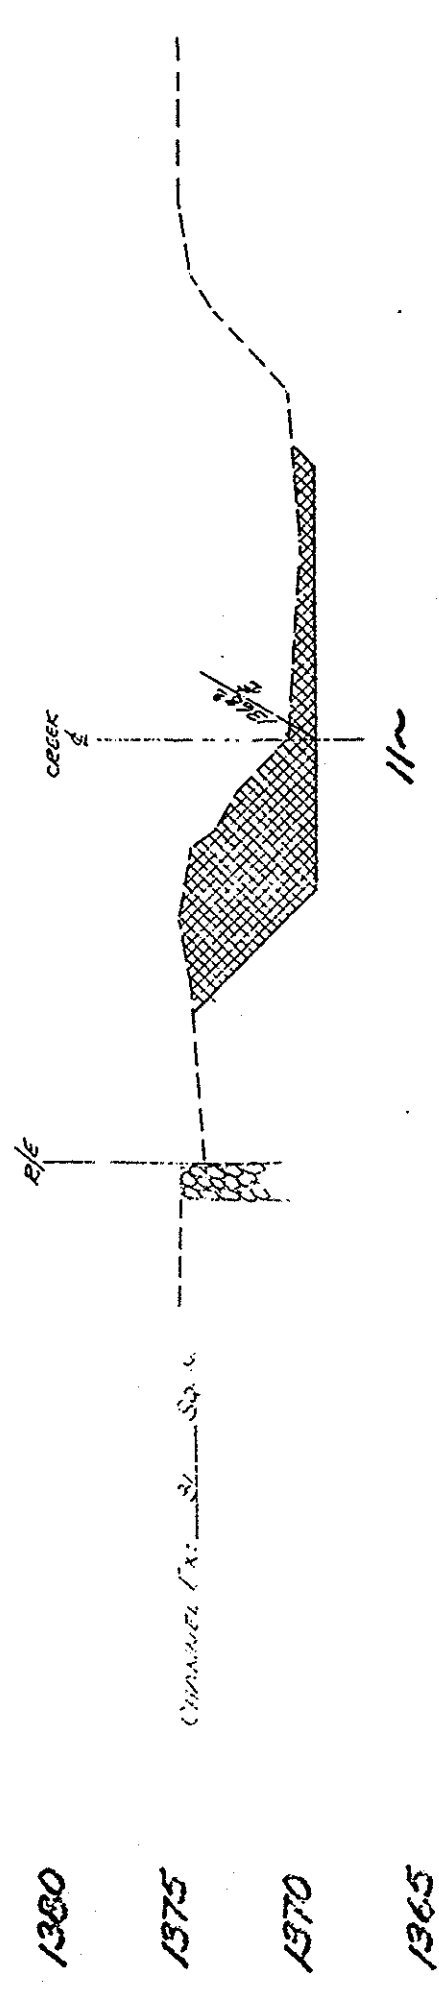


35 30 25 20 15 10 5 0 5 10 15 20 25 30 35

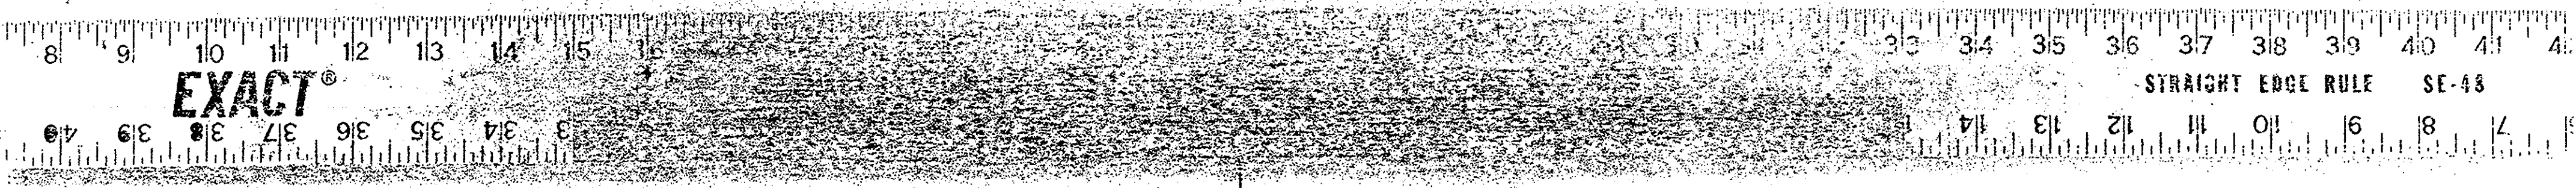

CONSTRUCTION PLANS
SHOWING CURVE RADIUS
Sheet 12 of 19
Red. 22.5:1 Scale: as shown
1971

AS BUILT

NOTE: TURN, CURVE, EX AND
CHANNEL LINES ARE FOR
CLARITY ONLY. QUANTITIES
ARE TREATED AS ROUNDED EX.
AND ROUNDED EX.

35 30 25 20 15 10 5 0 5 10 15 20 25 30 35