




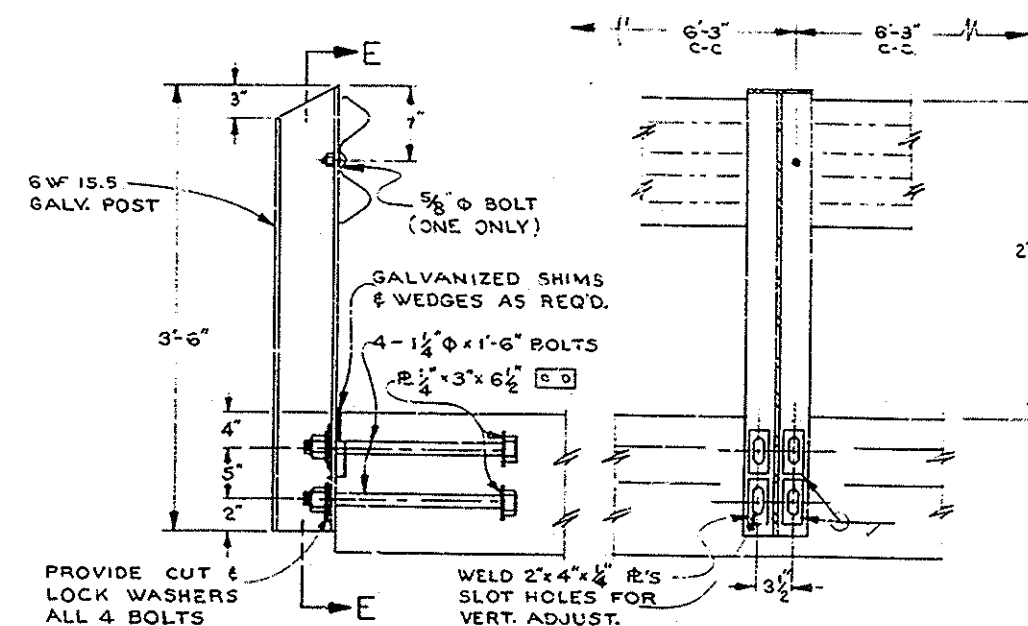


SECTION E-E

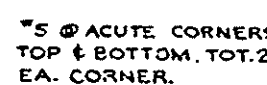


SECTION D-D
SCALE 1/4" = 1'-0"

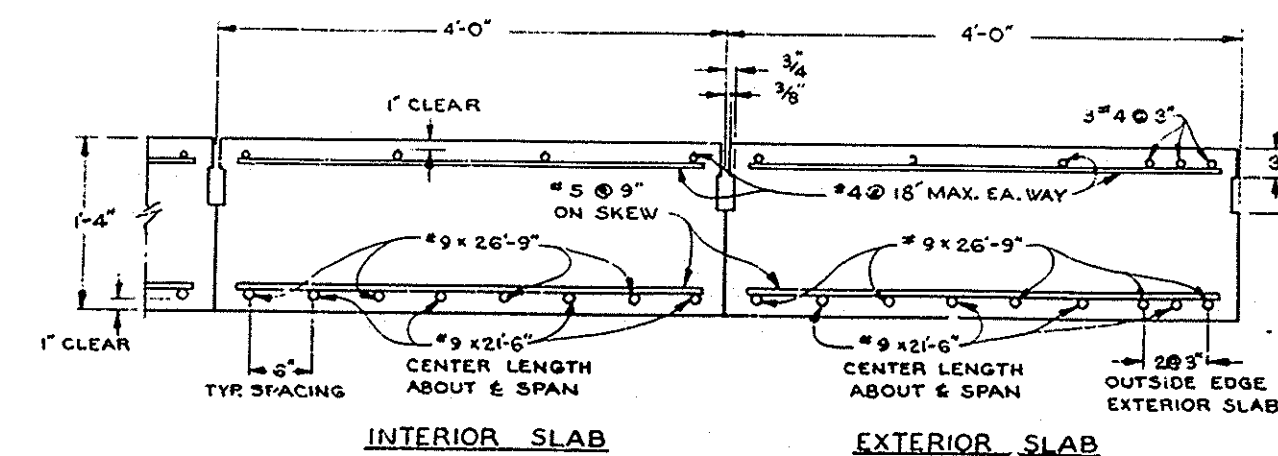

SLAB DETAILS
SCALE — 1"=1'-0"
WT./ONE UNIT. = 21.600*

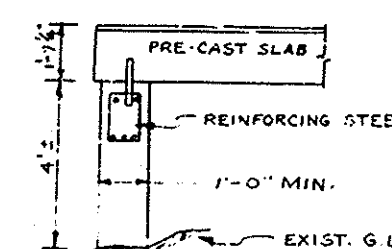


SECTION D-D
NO SCALE

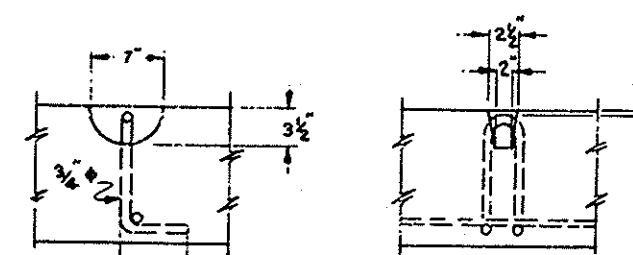

LIFTING LOOP DETAILS

LOOPS TO BE HOOKED UNDER TRANSVERSE BOTTOM STEEL. 1" ϕ 4 STRUT SPIDERS MAY BE USED IN LIEU OF THIS DETAIL. LIFTING LOOP VOIDS SHALL BE FILLED WITH GROUT AFTER PLACING SLABS NO SCALE

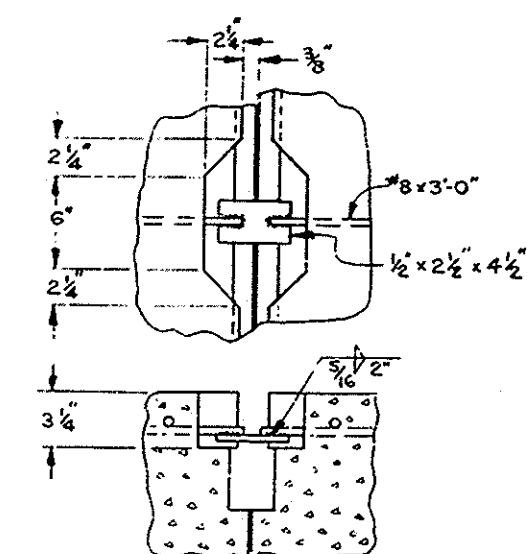

TRANSVERSE TIE DETAIL
LOW HYDROGEN ELECTRODE TO BE USED
BY CERTIFIED WELDER. DRY PACK
AFTER WELDING. NO SCALE

AS BUILT

- NOTES:

1. REMOVE NORTHERLY HALF OF EXISTING TIMBER BRIDGE, RELOCATE TIMBER GUARD RAIL (OR CONSTRUCT TEMPORARY GUARD RAIL) AND DETOUR TRAFFIC OVER REMAINING 9'.
2. CONSTRUCT STAGE ONE OF NEW BRIDGE
3. PLACE TEMPORARY TIMBER BARRICADES ALONG NEW BRIDGE & DETOUR TRAFFIC OVER STAGE ONE.
4. REMOVE REMAINING HALF OF TIMBER BRIDGE AND CONSTRUCT STAGE TWO OF NEW BRIDGE.

FOR ADDITIONAL GENERAL NOTES,
SEE SHEET #2

ORANGE COUNTY HIGHWAY DEPARTMENT

THREE SMALL
BRIDGES

SV-14 ON
SILVERADO CYN. RD

SCALE AS NOTED

Three Small Bridges
9-82, SV-14 SV-18
As Built
Sheet 3 of 4 Red 22.5:
Scale brown Series

Glenn Smith Bridges - S-72, SV-14, SV-18

322.1 3 W