




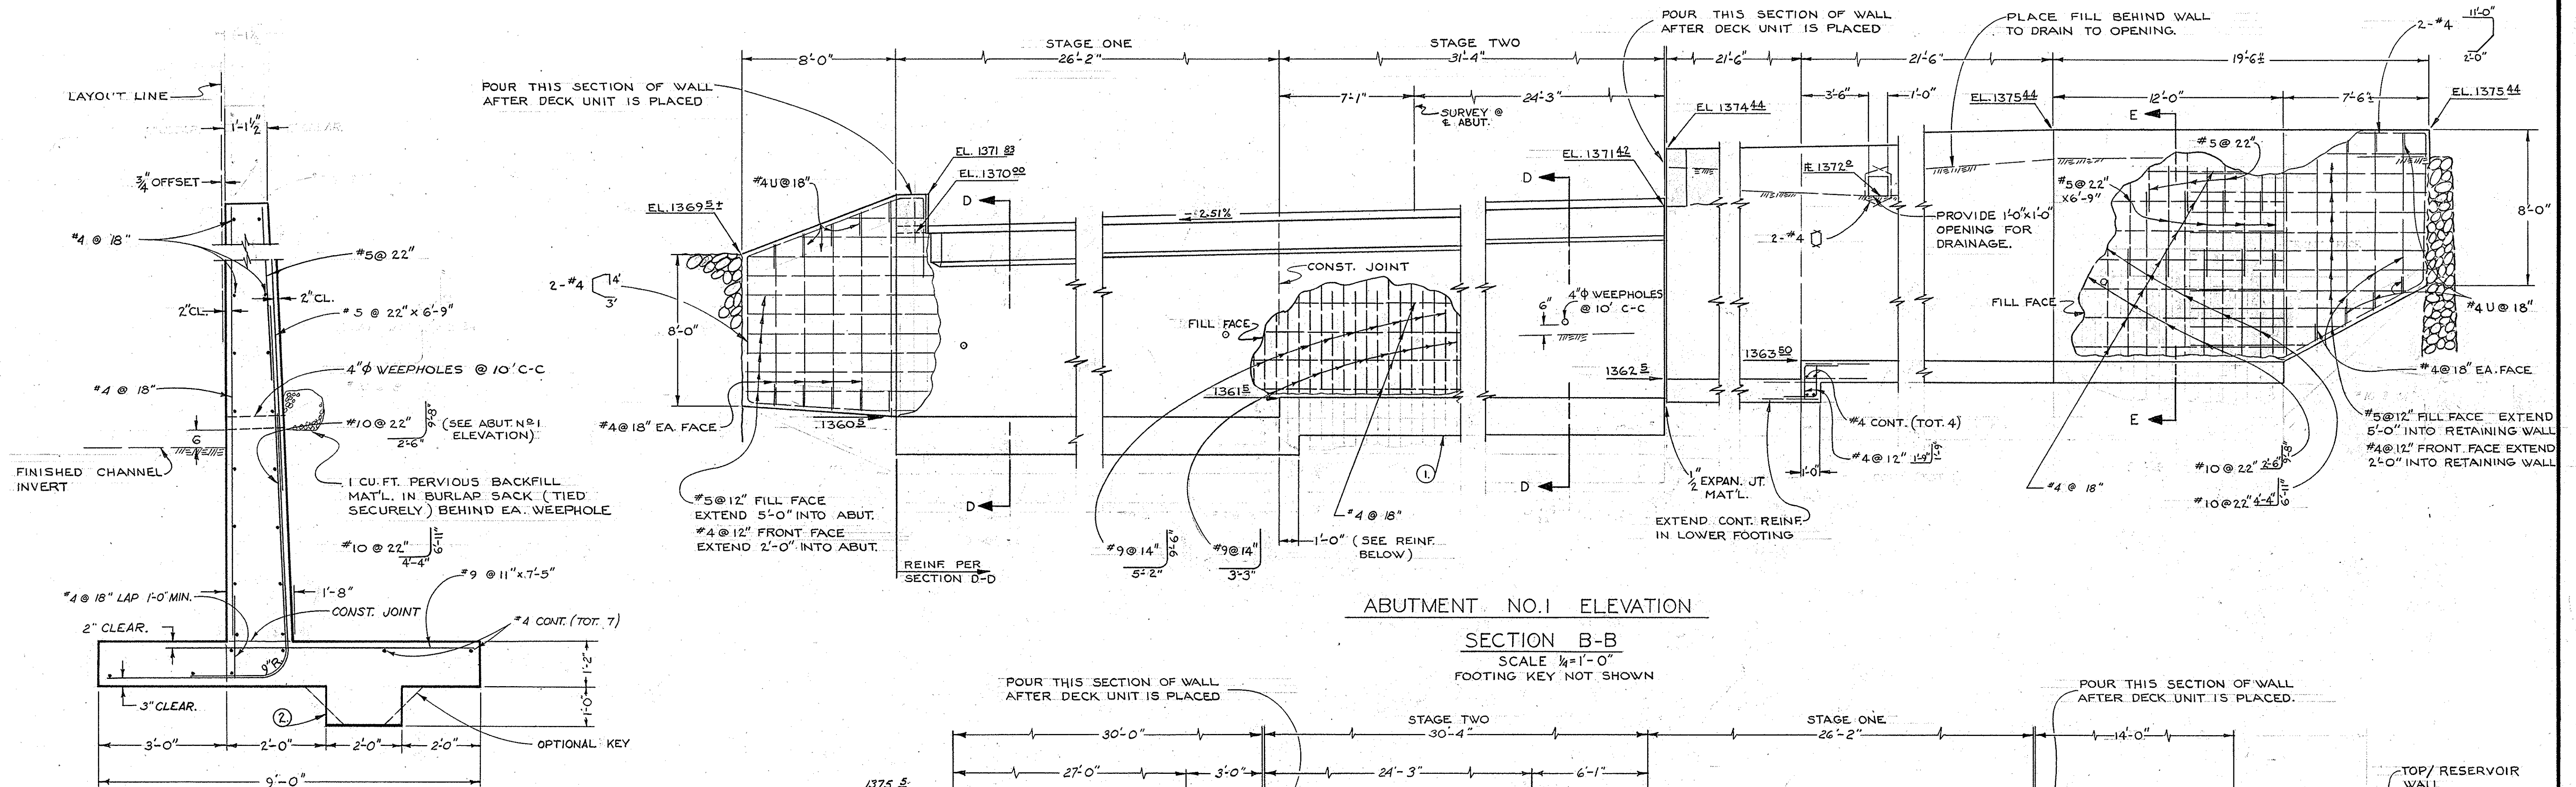

SECTION E-E
NO SCALE

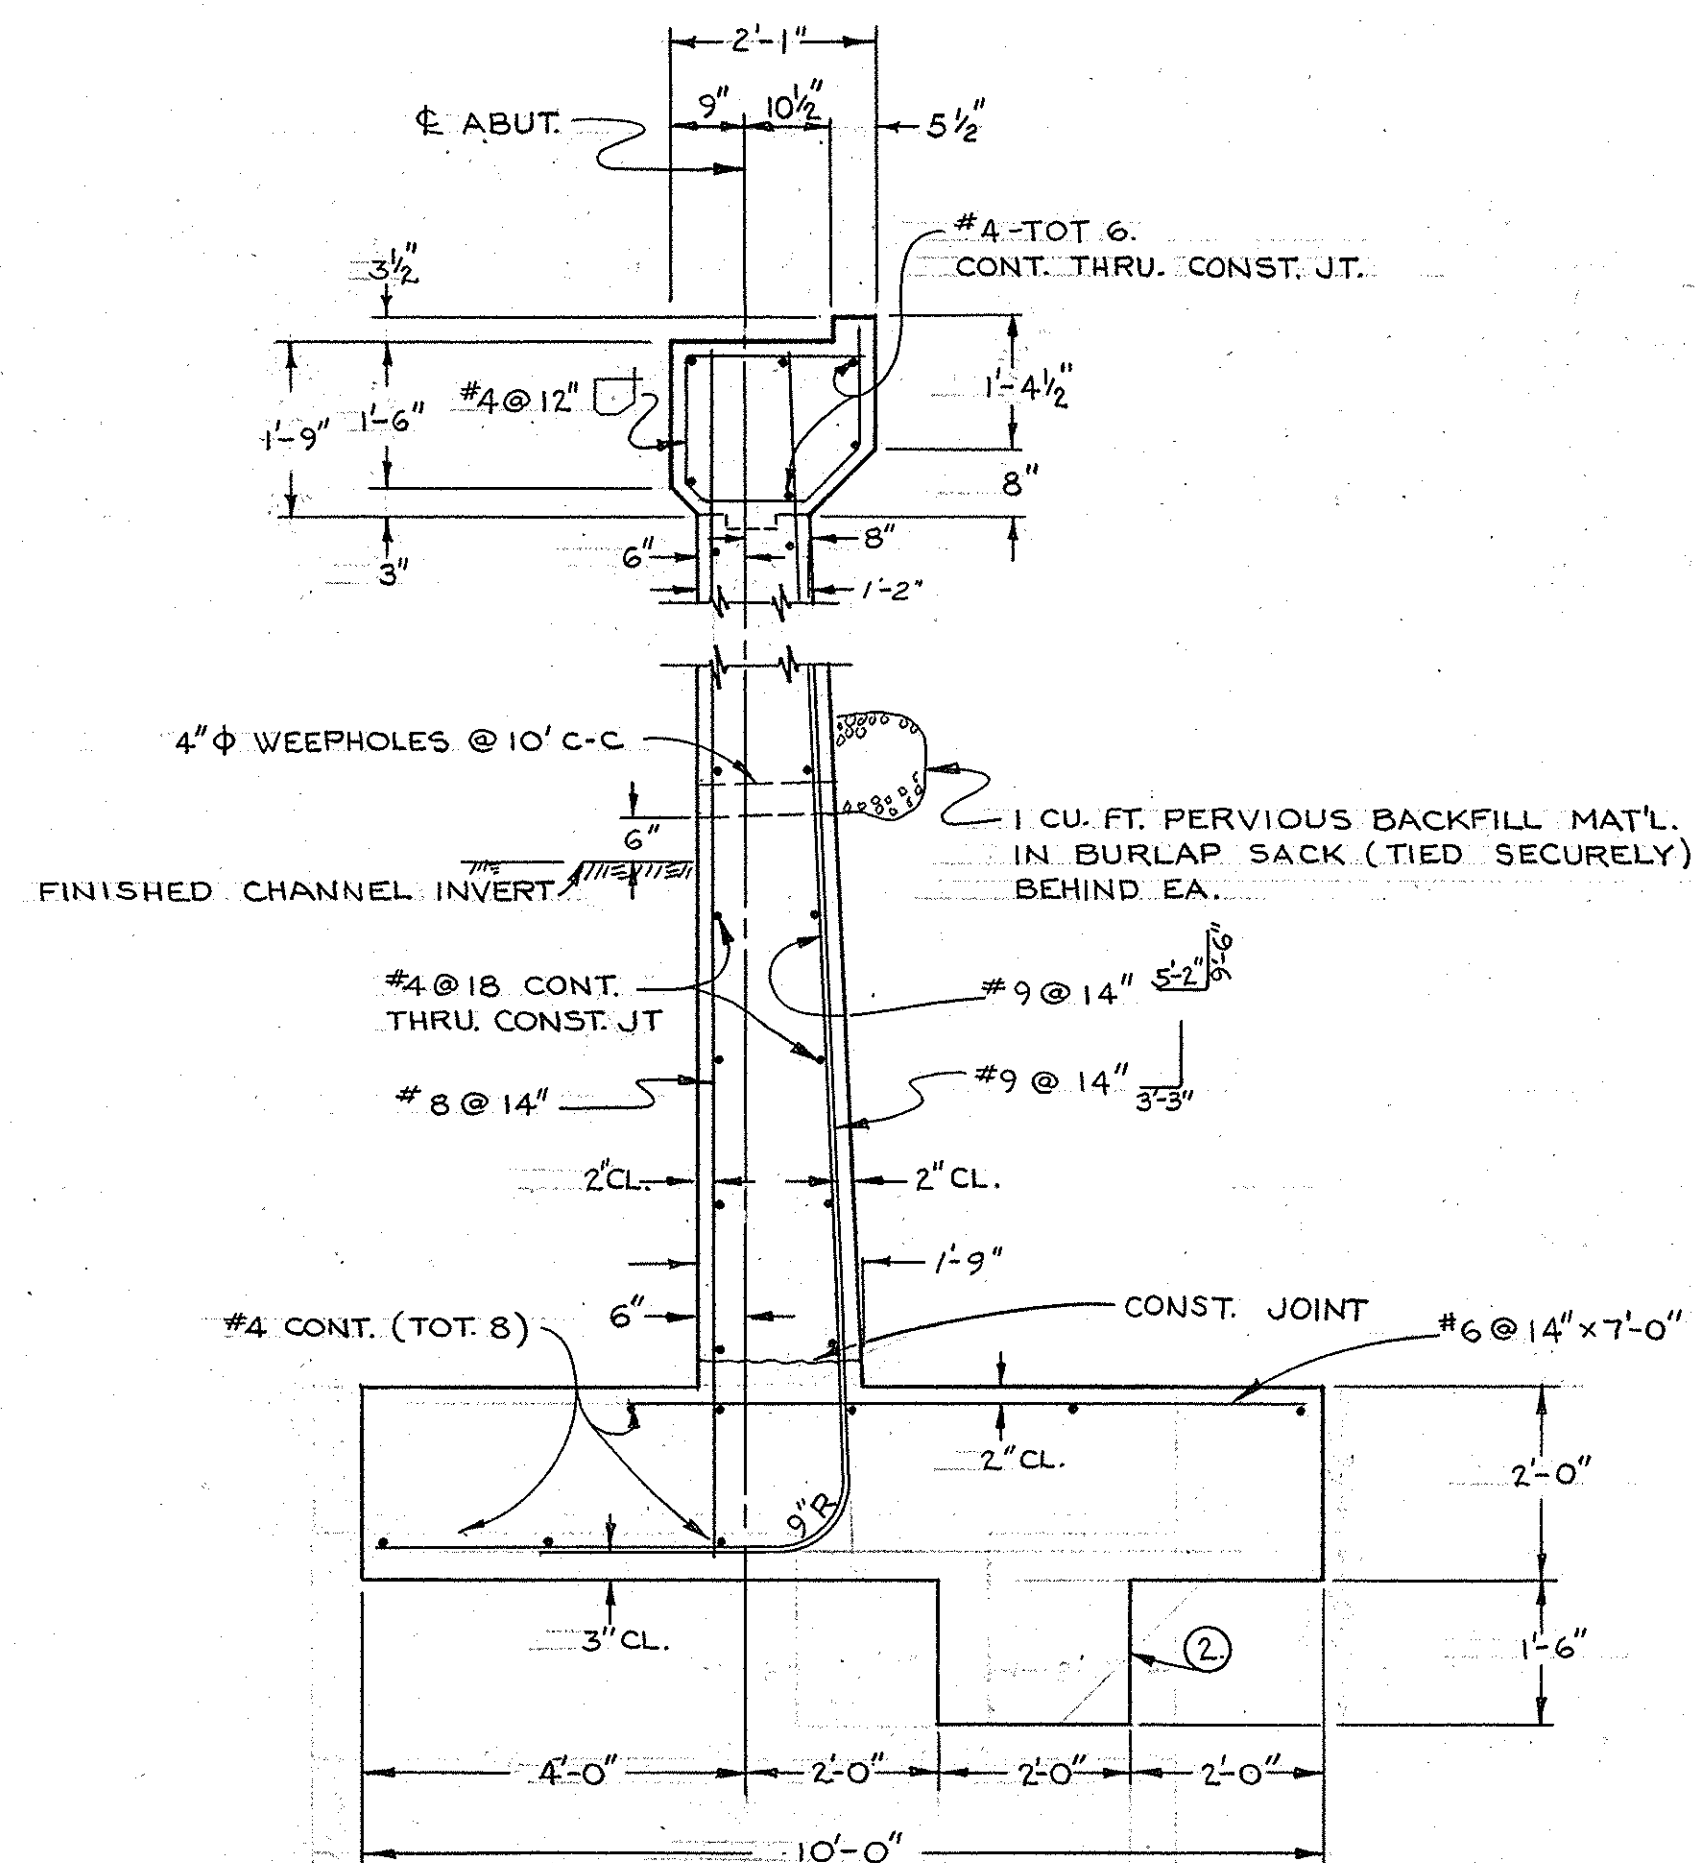

SECTION D-D
SCALE 1/2"=1'-0"

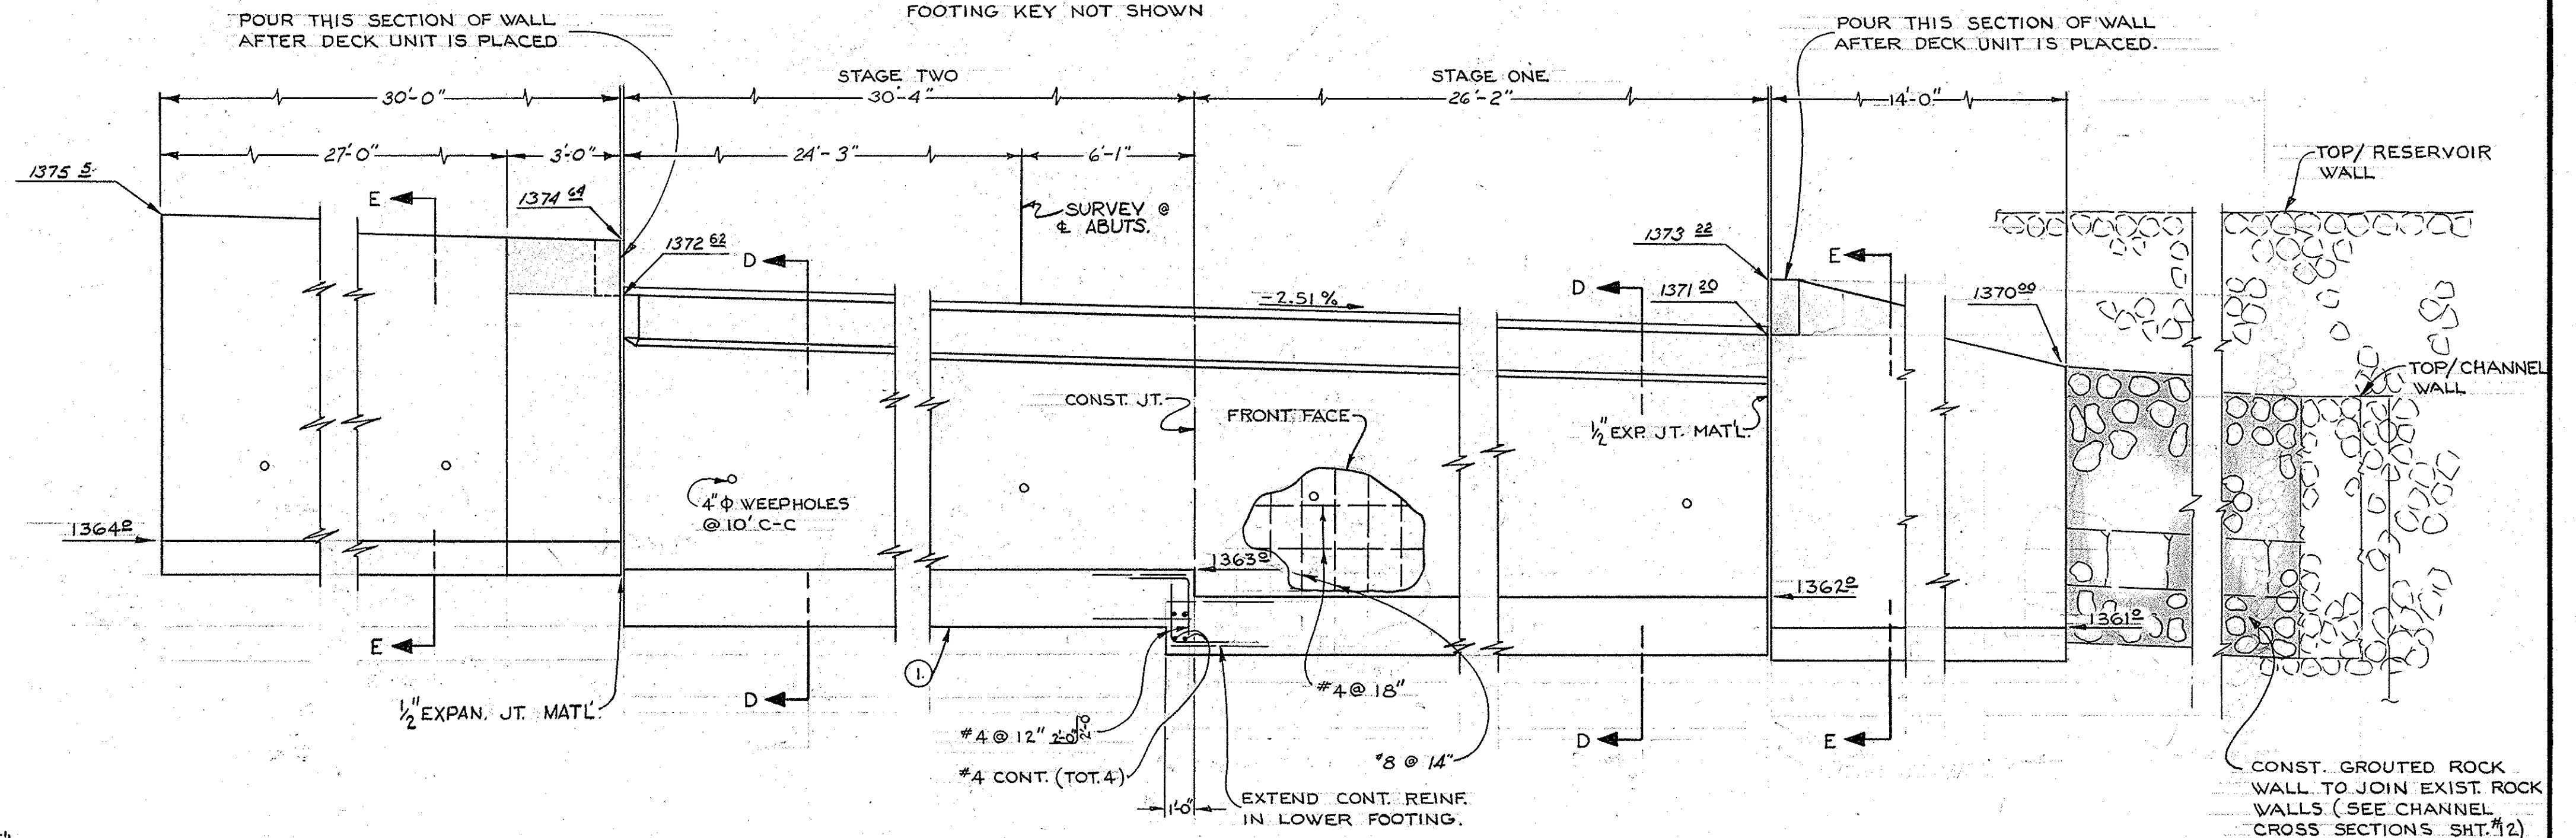

NOTES:

- ① FOOTINGS TO BE PLACED @ PLAN ELEV'S INTO BEDROCK OR @ BEDROCK ELEV. AS DIRECTED BY THE ENGINEER.
- ② KEY NOT REQUIRED ON IRREGULAR BEDROCK AS DIRECTED BY THE ENGINEER.

CONSTRUCTION PLANS - BRIDGES
Silverado Canyon Road
Sheet 10 of 12
Red. 22.5:1 Scale: as shown
Vellum

ORANGE COUNTY ROAD DEPARTMENT
SILVERADO CYN. RD.
BRIDGE SV-14
ACROSS
SILVERADO CREEK
ABUTMENT & WINGWALL
DETAILS

NOTED SHEET 10 OF 12