


ORIGINAL	DATE	BY	NO.
SURVEY	10/10/1960	W. H. H. H.	100
NOTE BOOK	10/10/1960	W. H. H. H.	100
NC	10/10/1960	W. H. H. H.	100

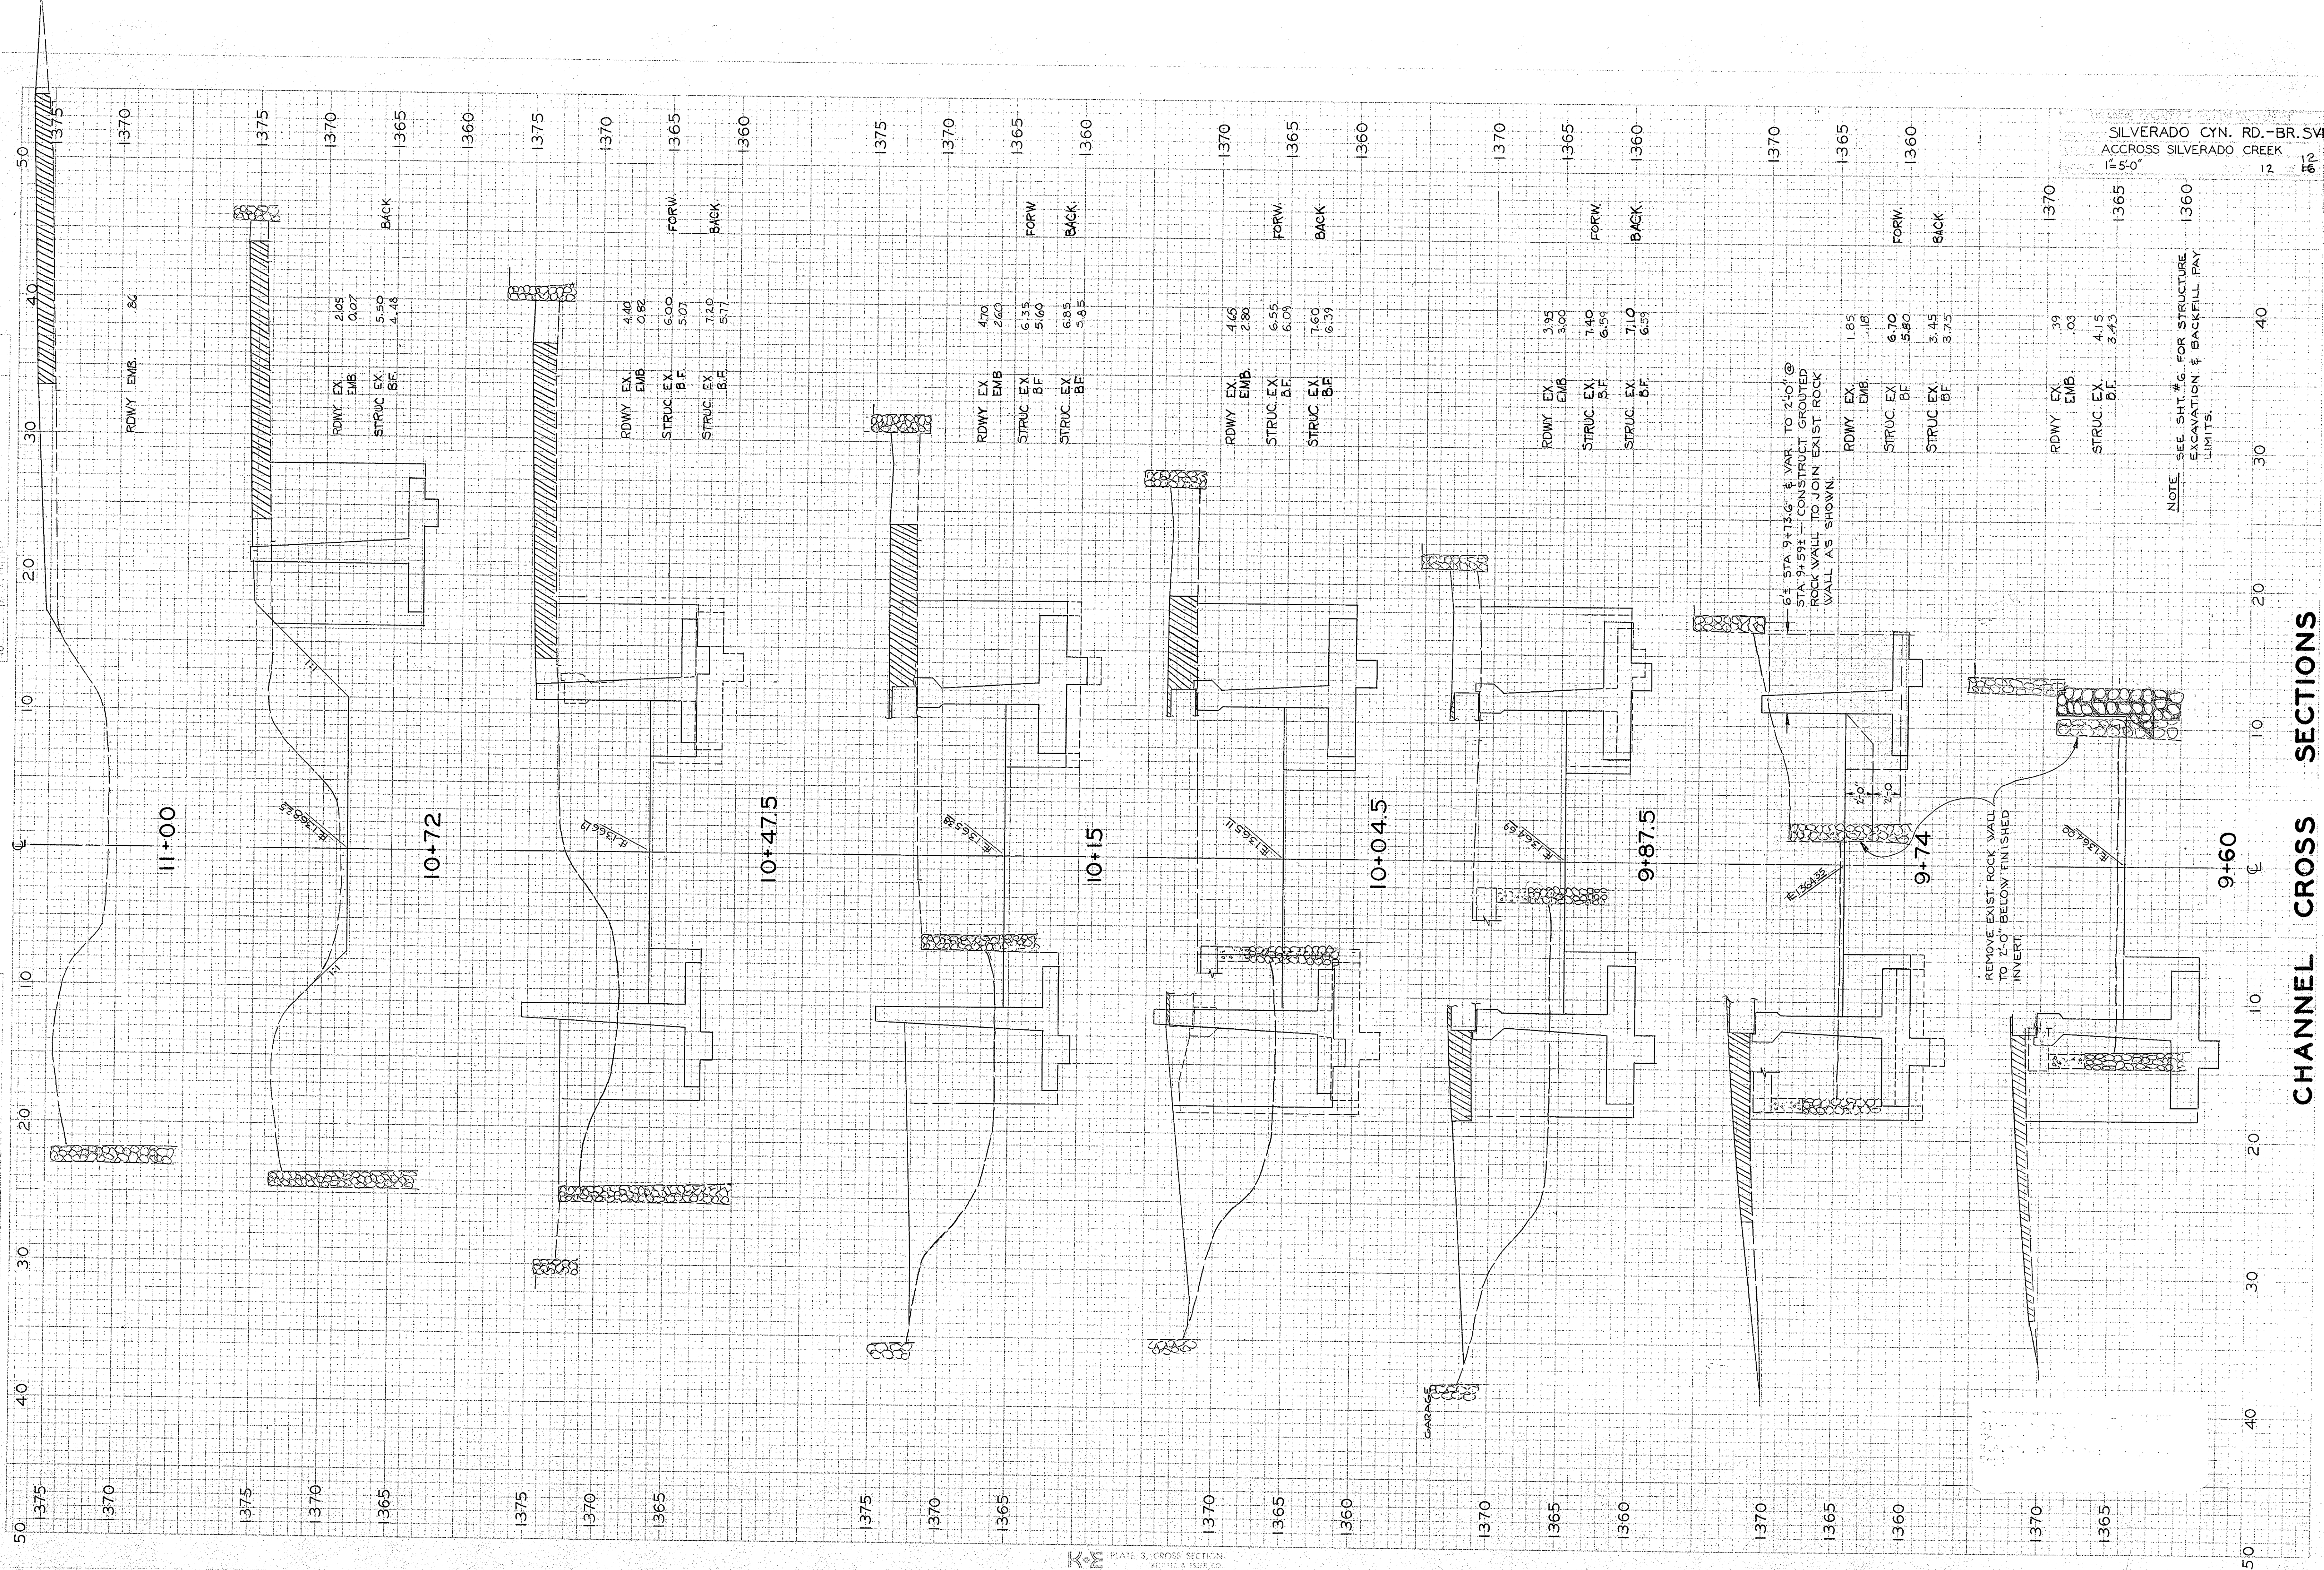

~~DR. 17 (10126)~~