
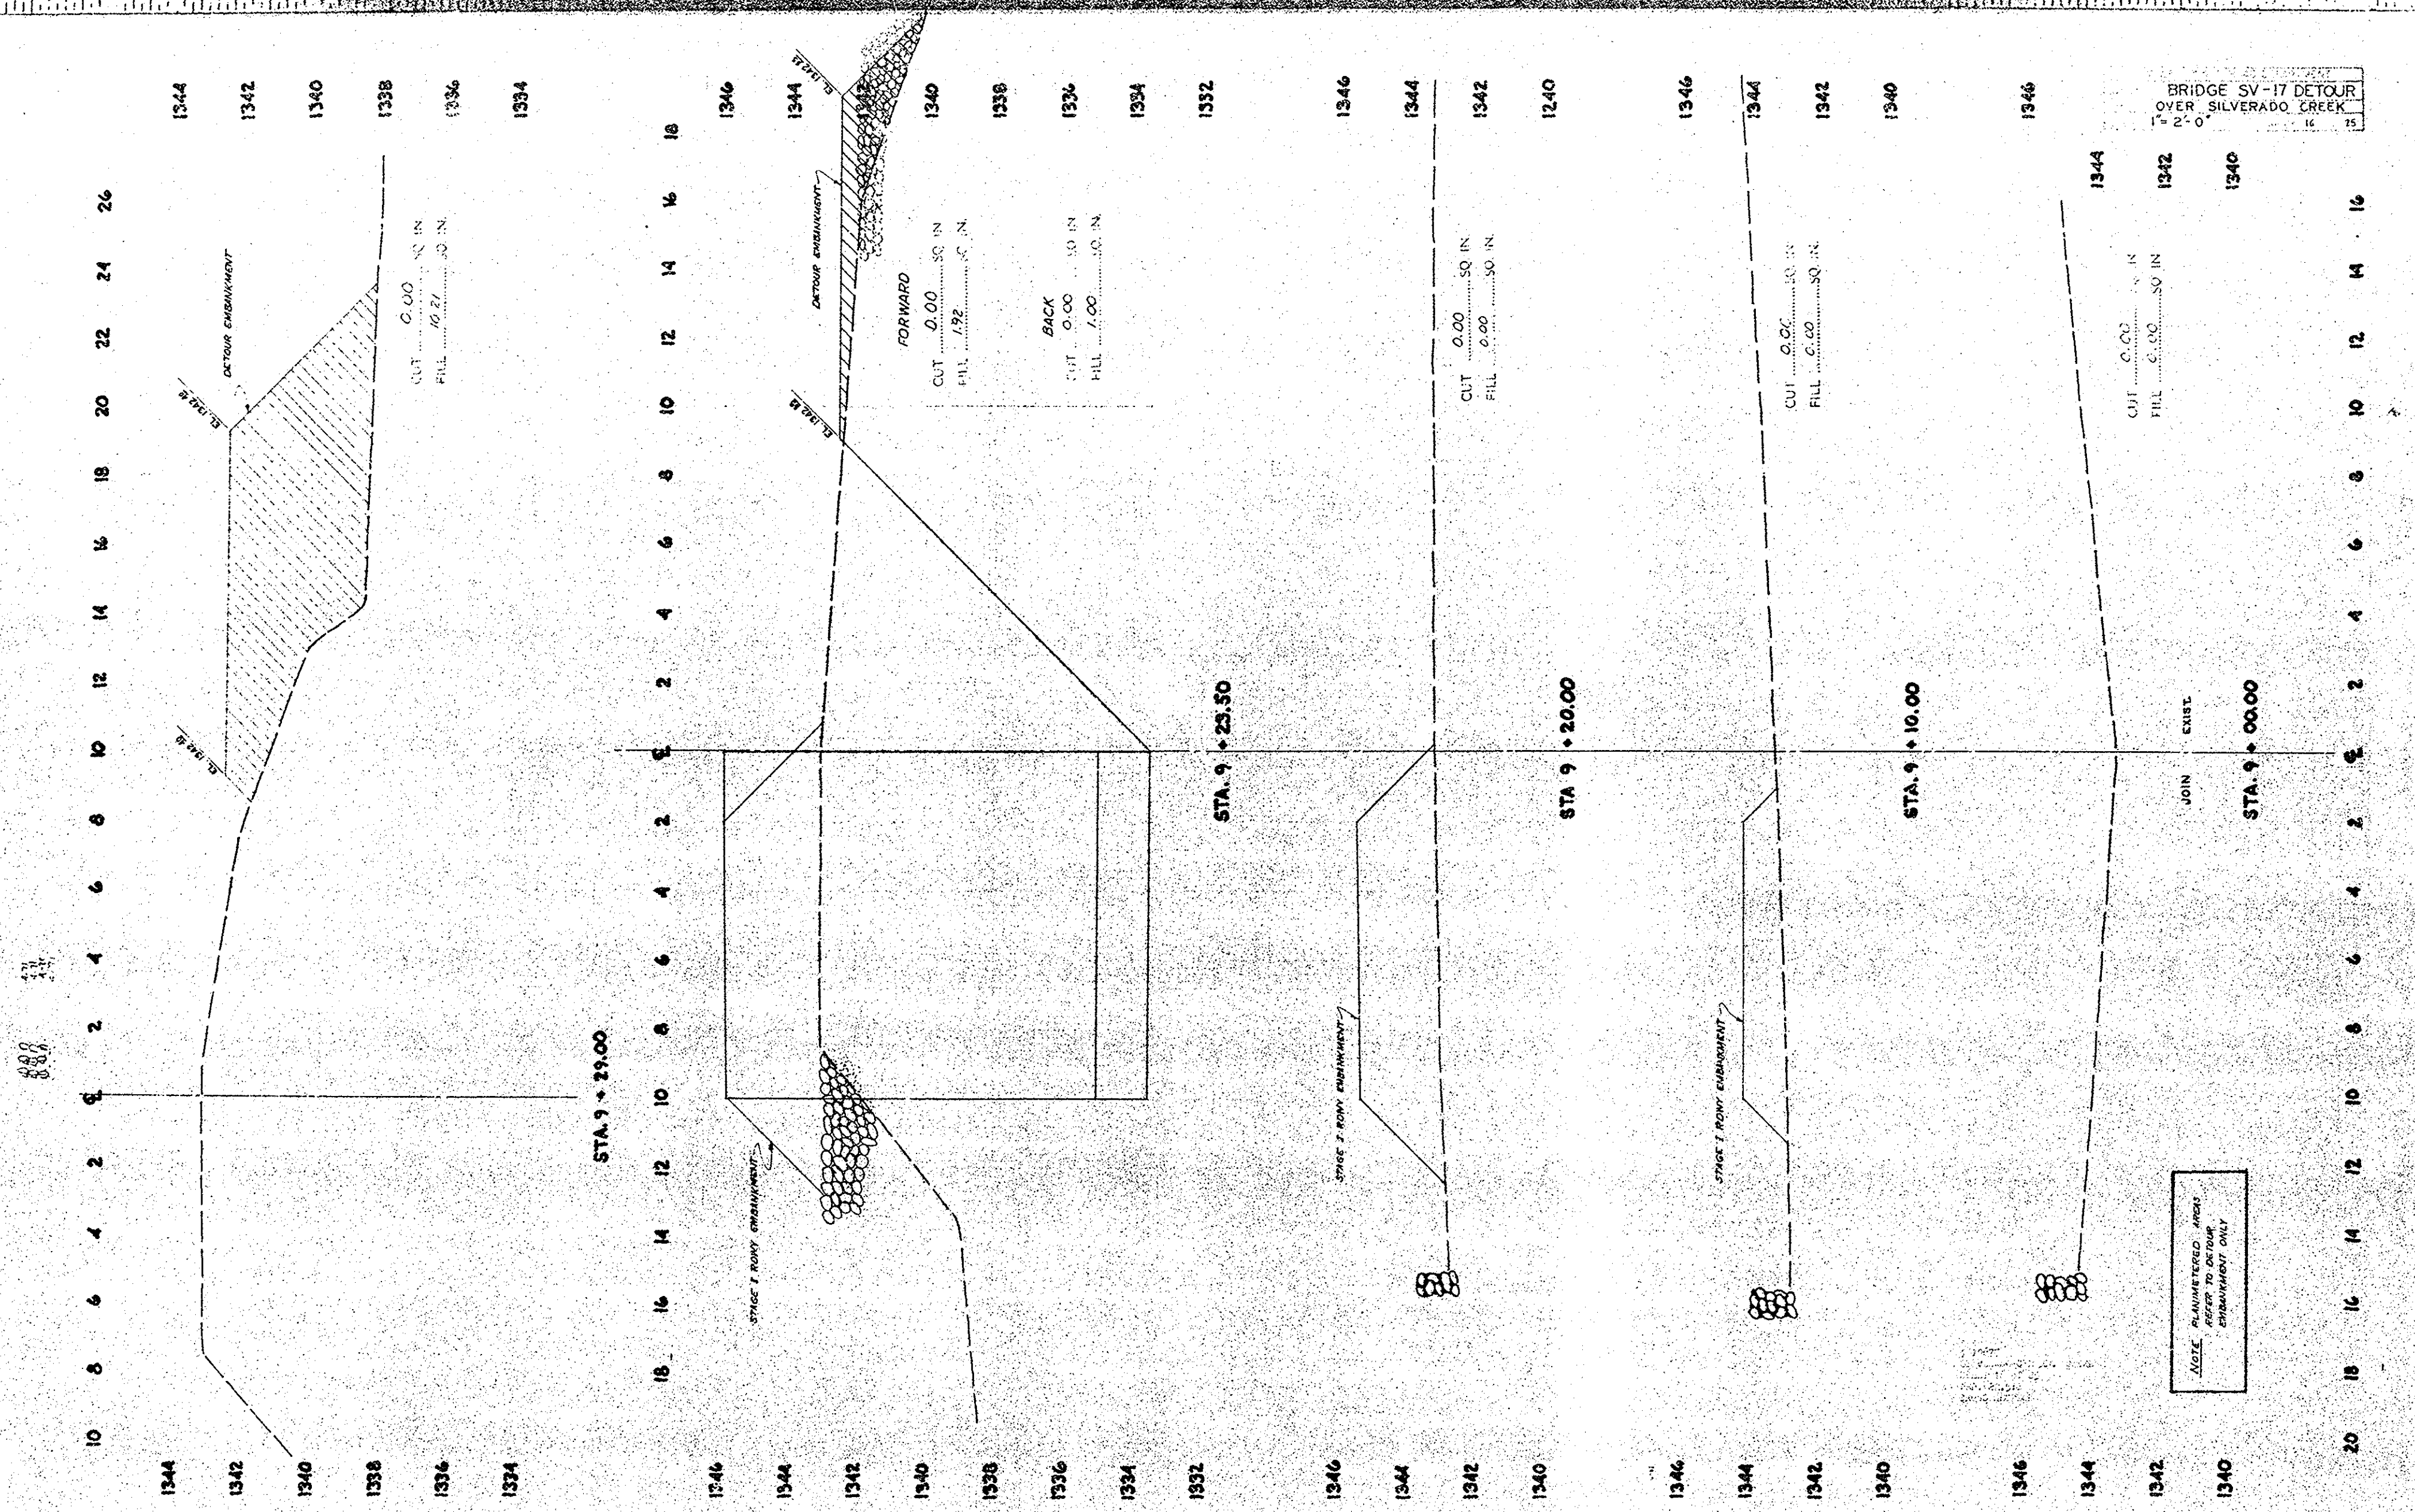


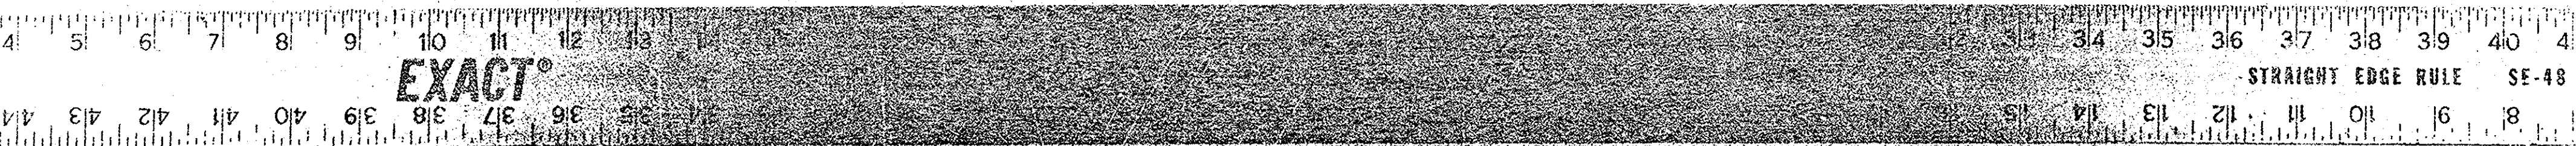

BRIDGE SV-17 DETOUR
OVER SILVERADO CREEK
1" = 2'-0"

NOTE: PLANNED EMBANKMENT
REFER TO DETOUR
EMBANKMENT ONLY

20 17 (1067)