


EXACT®

STRAIGHT EDGE RULE

SE-43

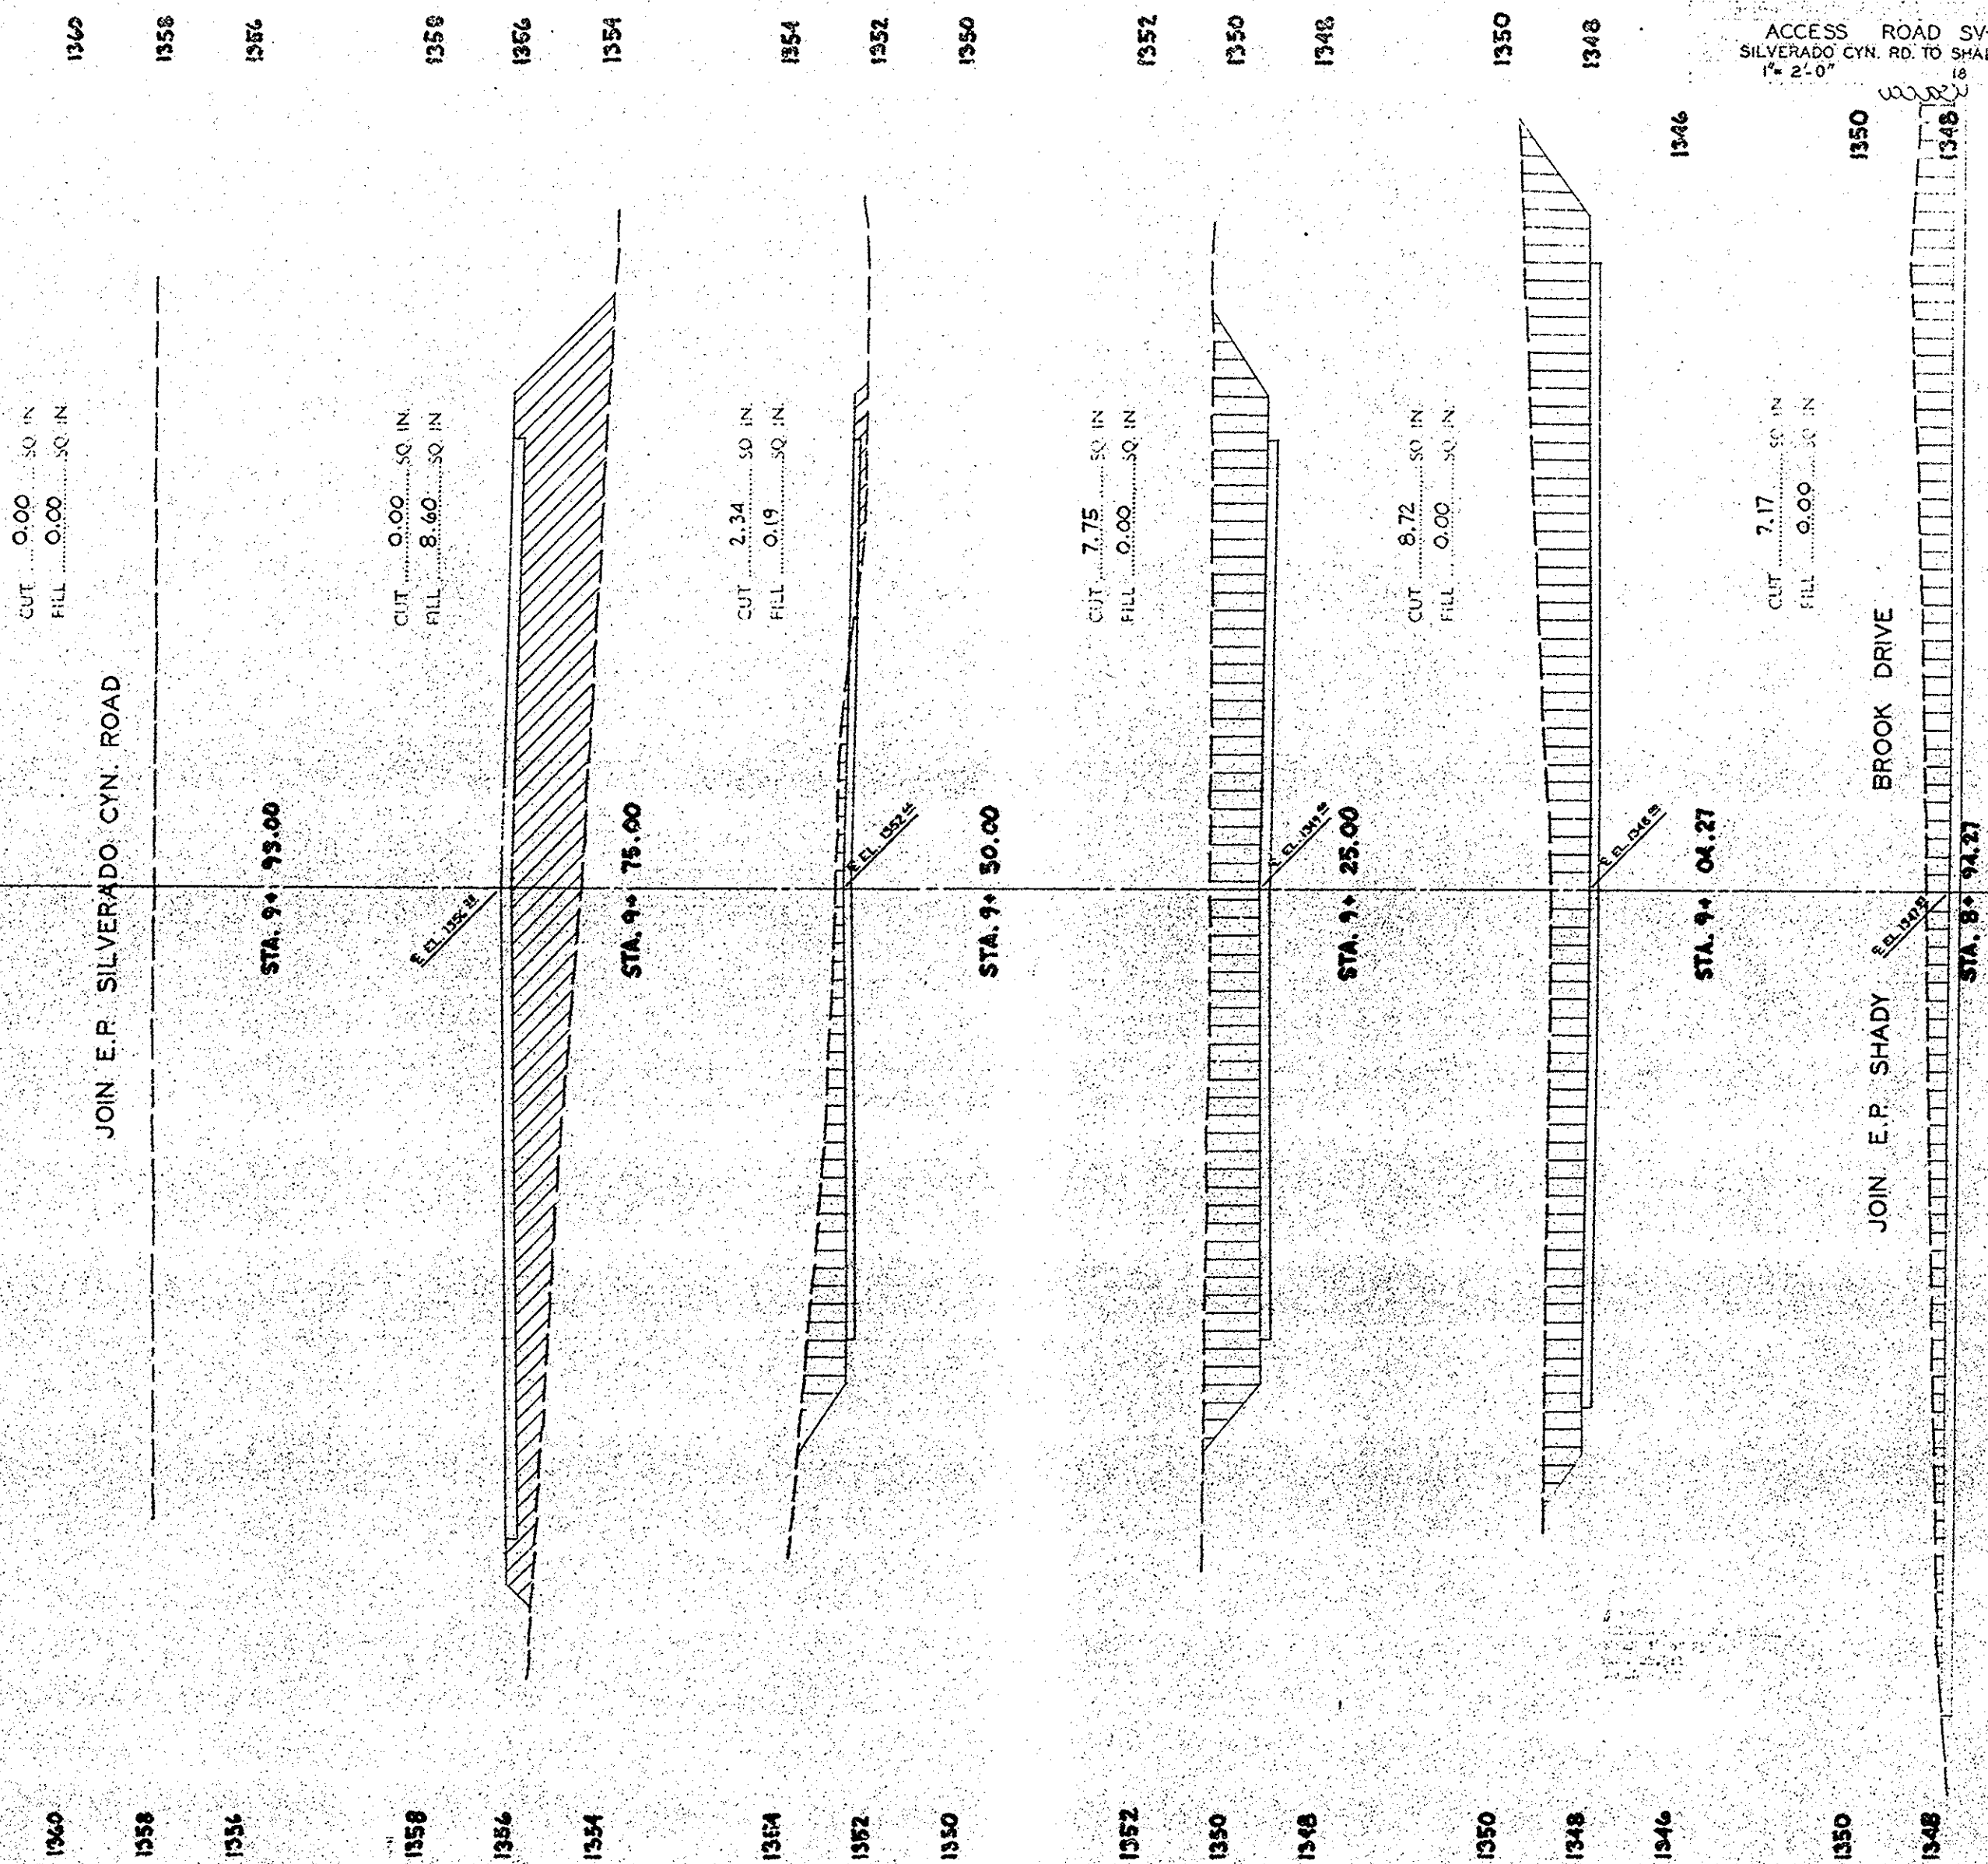

207/10672