




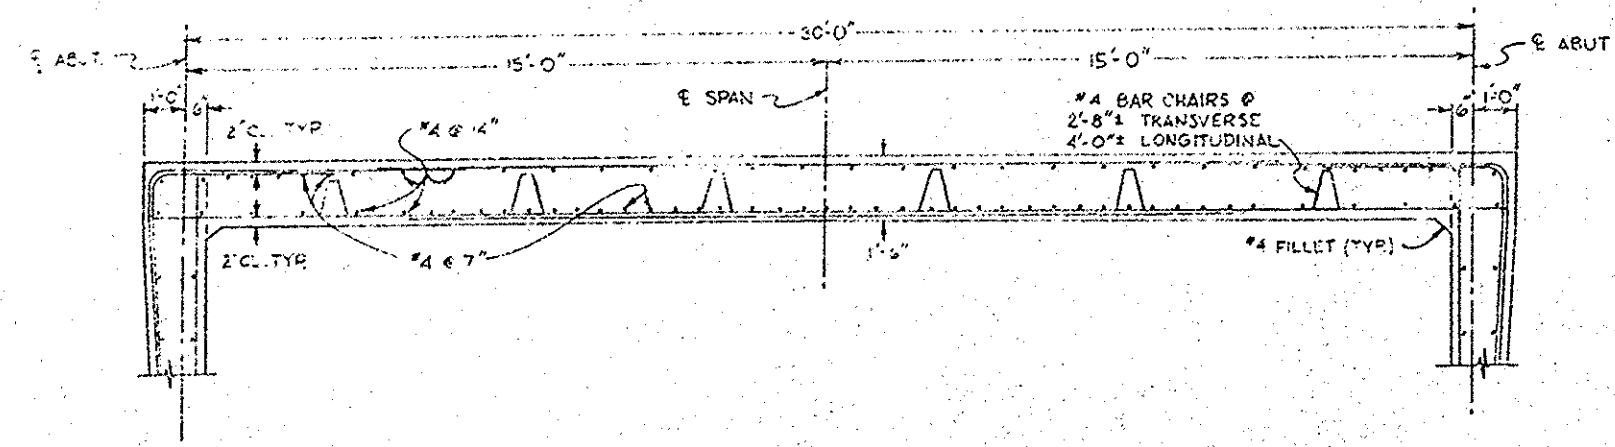


LONGITUDINAL SECTION BRIDGE SV-17
SCALE 3/8" = 1'-0"

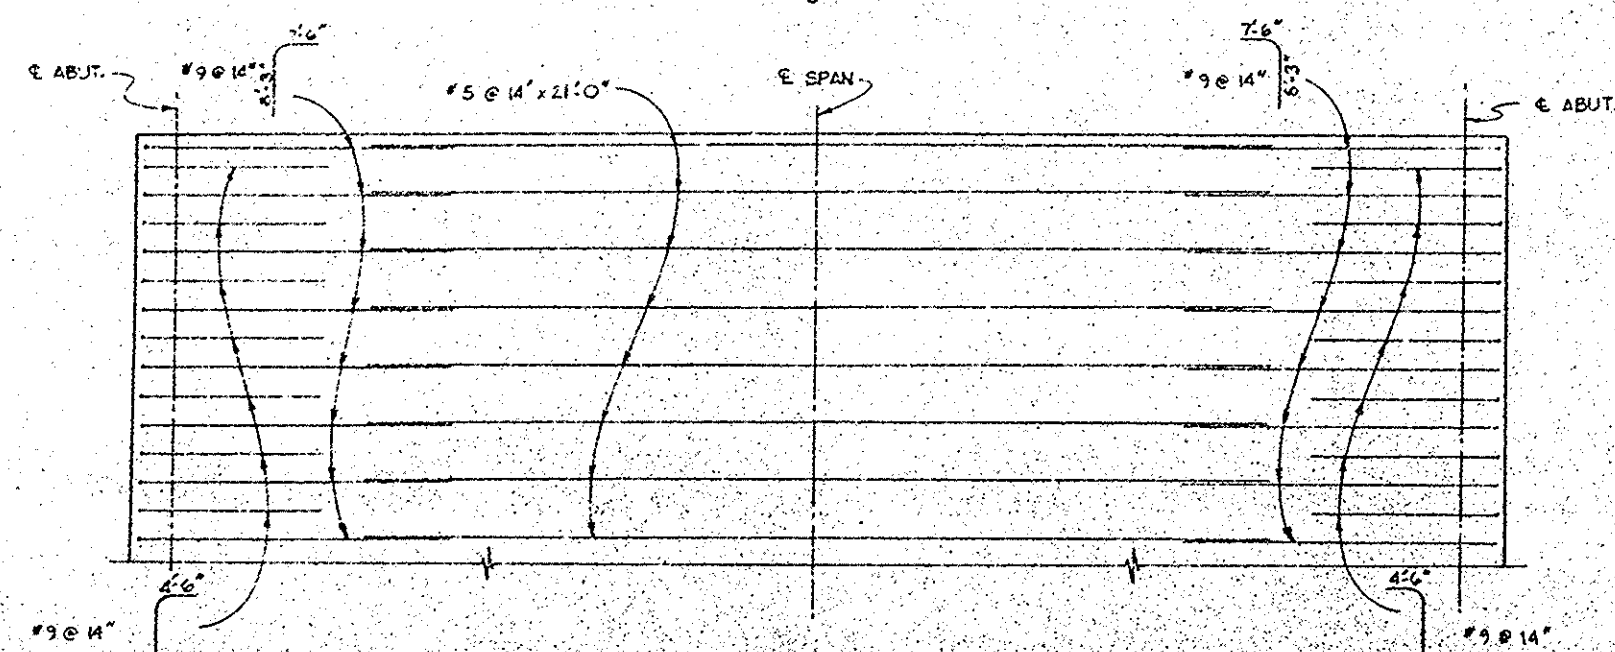


TOP OF SLAB REINFORCEMENT BRIDGE SV-17
SCALE 3/8" = 1'-0"

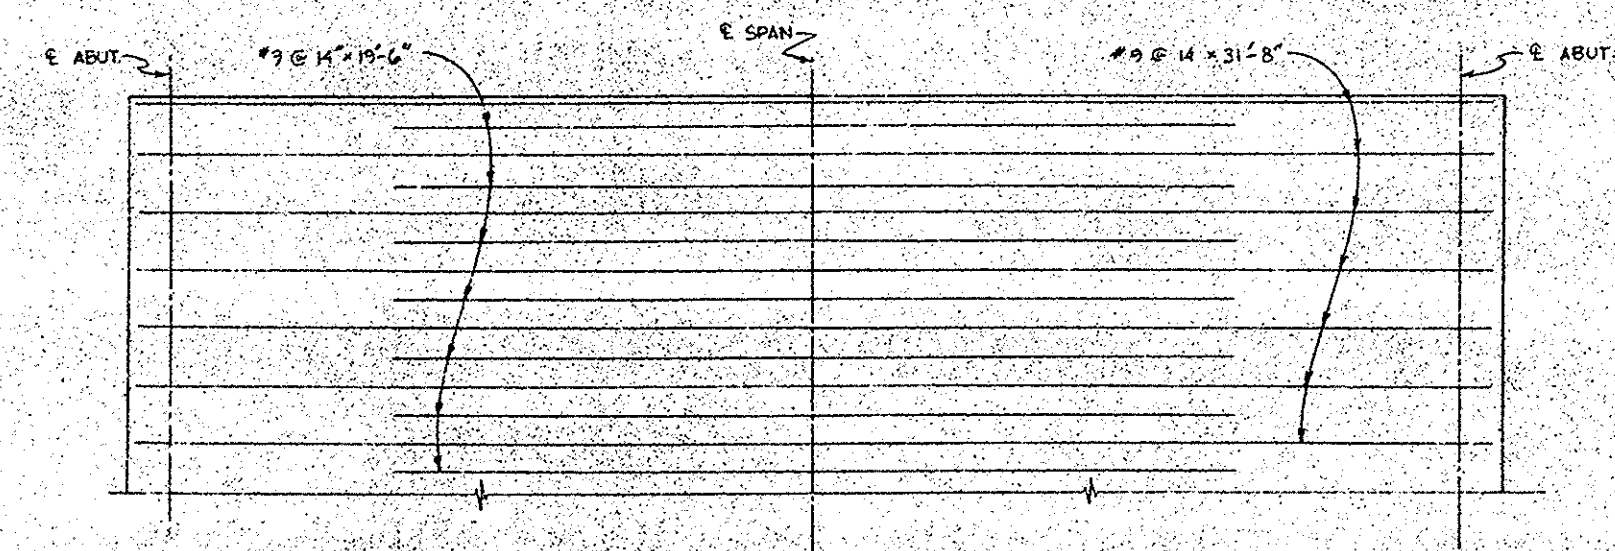


BOTTOM OF SLAB REINFORCEMENT BRIDGE SV-17
SCALE 3/8" = 1'-0"

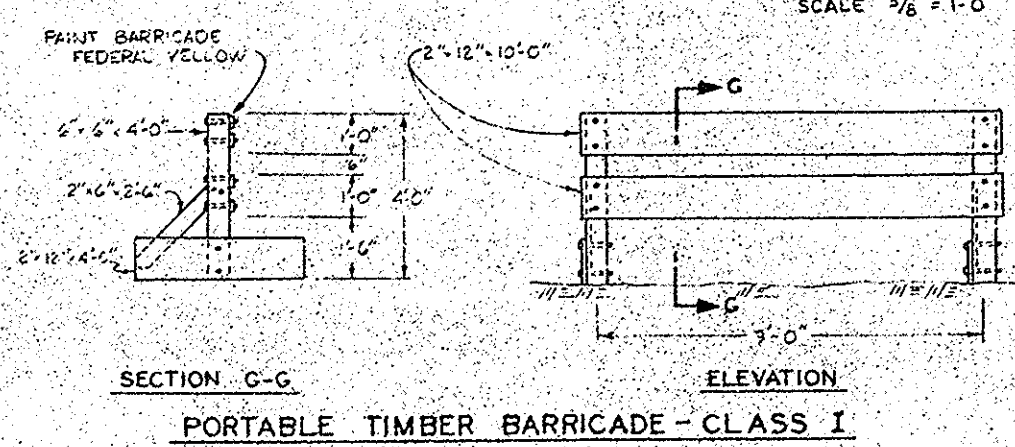

SECTION C-C
PORTABLE TIMBER BARRICADE - CLASS I

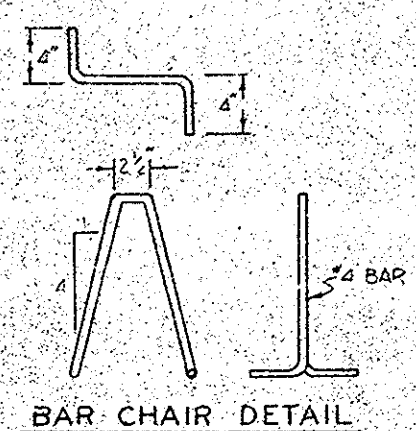


BAR CHAIR DETAIL

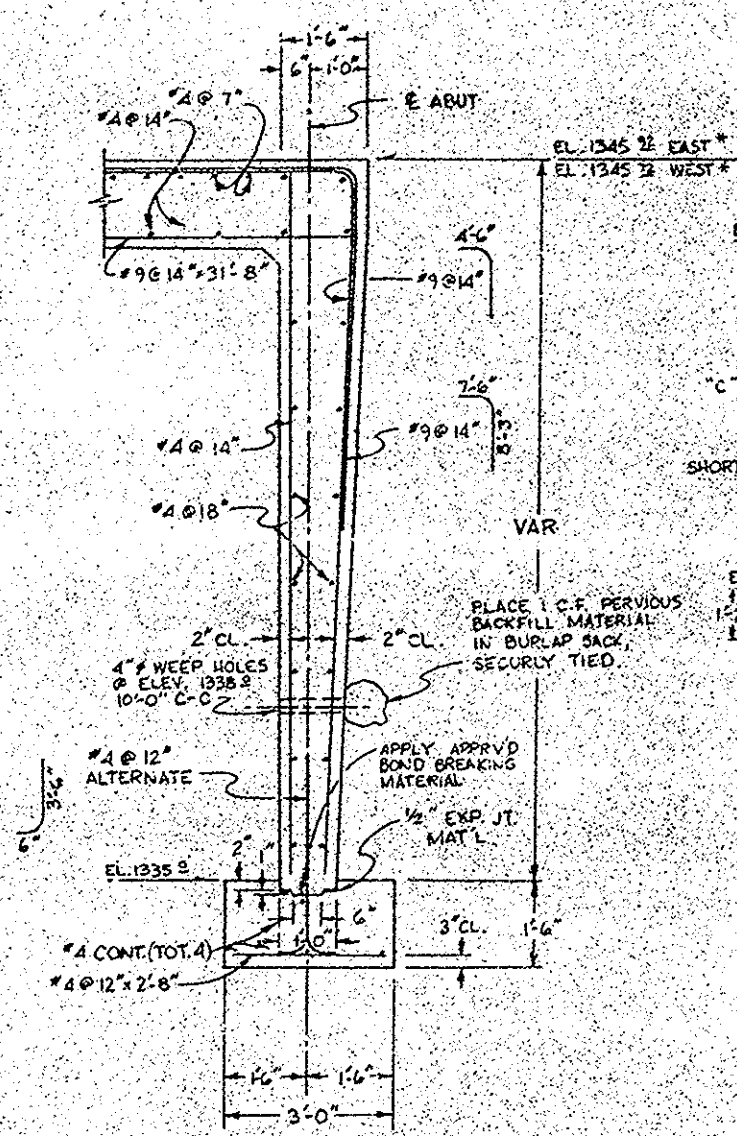


TYPICAL ABUT SECTION
BRIDGE SV-17
SCALE 1/2" = 1'-0"


* REFERS TO EAST EDGE OF DECK
AND WEST EDGE OF DECK

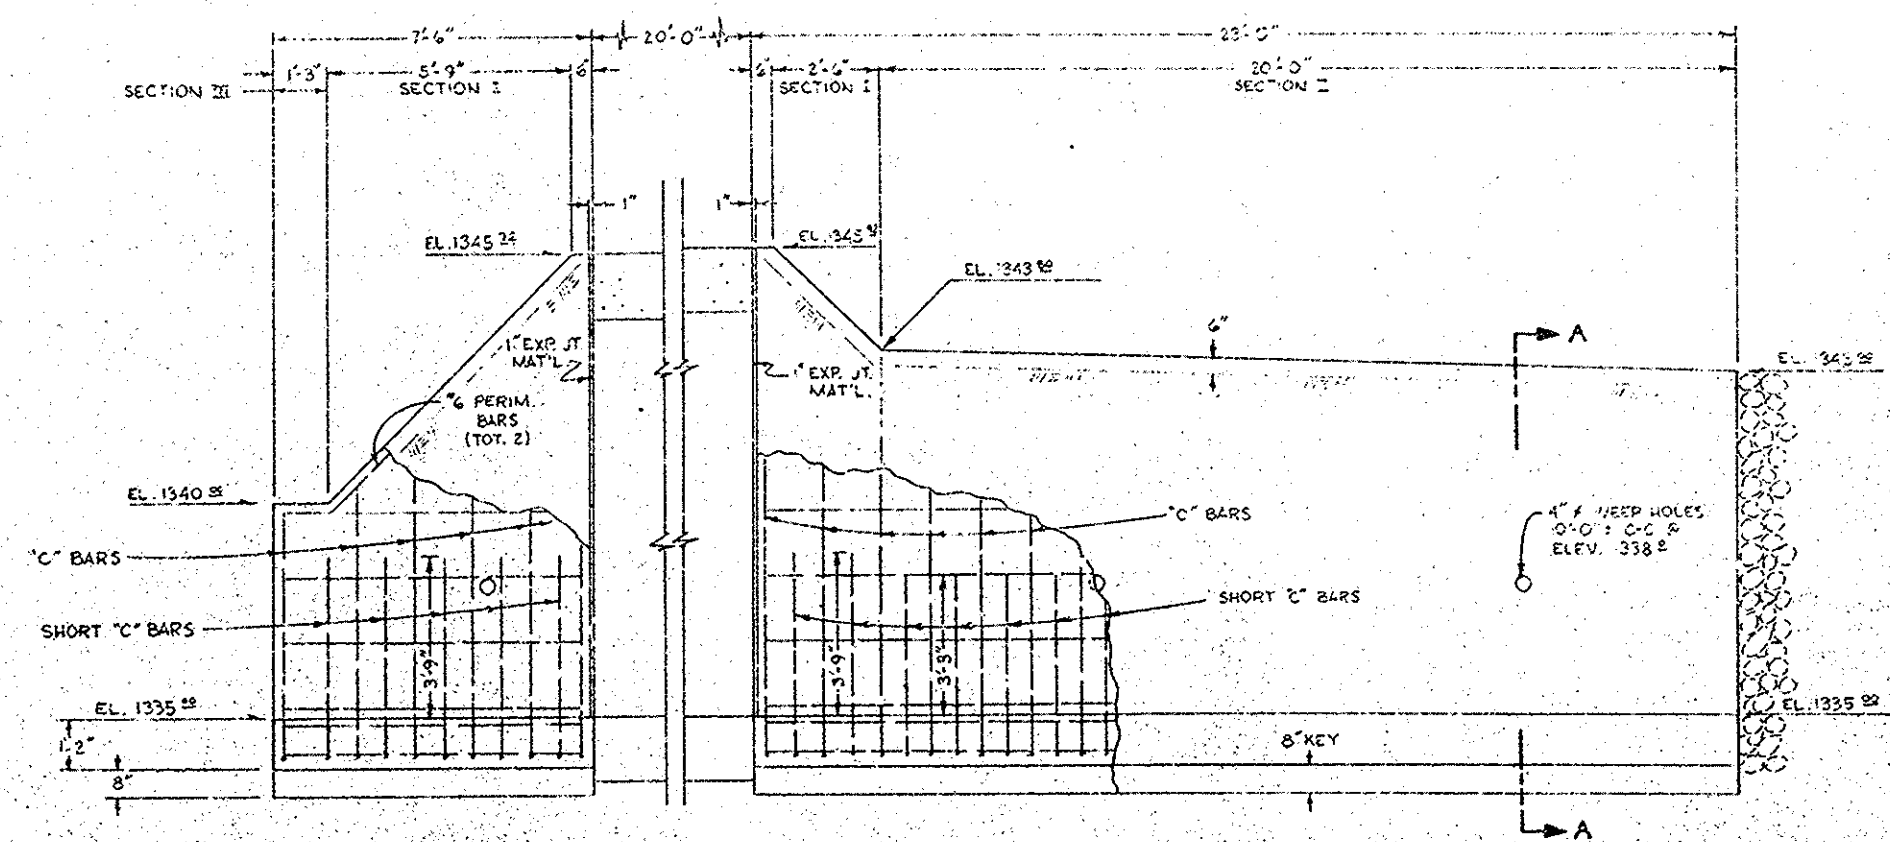

ELEVATION - NORTH WINGWALLS
SCALE 3/8" = 1'-0"

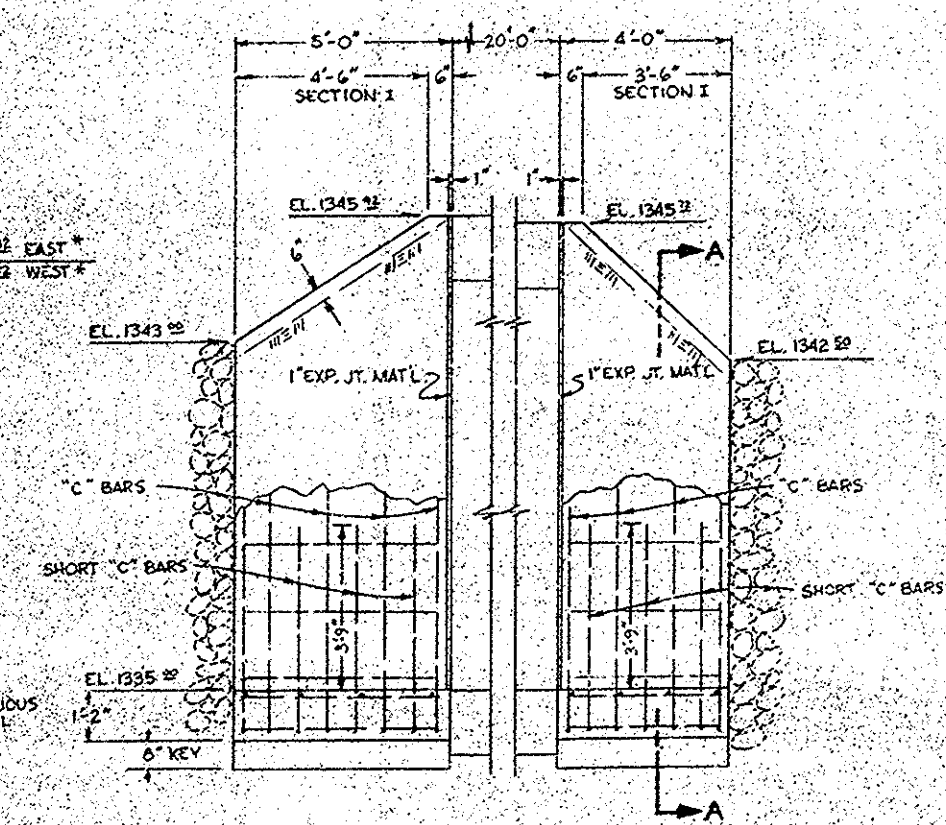

ELEVATION - SOUTH WINGWALLS
SCALE 3/8" = 1'-0"

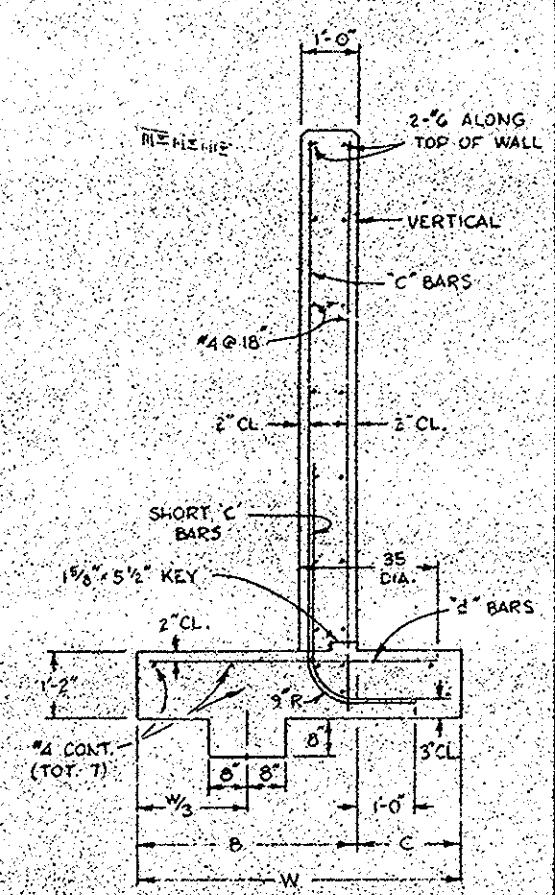

SECTION A-A
SCALE 1/2" = 1'-0"

WINGWALL DATA			
SECTION	I	II	III
W	6'-8"	5'-8"	3'-8"
B	4'-6"	3'-10"	2'-4"
C	2'-2"	1'-10"	1'-2"
C BARS	#4 @ 8"	#5 @ 1'	#4 @ 18"
C BARS	#4 @ 16"	#6 @ 18"	#4 @ 5"

10077
SLEEPY HOLLOW
BRIDGE SV-17
OVER
SILVERADO CREEK
DECK REINFORCEMENT
& WINGWALL DETAILS
AS NOTED

ORANGE COUNTY ROAD DEPARTMENT
SLEEPY HOLLOW
BRIDGE SV-17
OVER
SILVERADO CREEK
DECK REINFORCEMENT
& WINGWALL DETAILS
AS NOTED

DR 17(1067)