


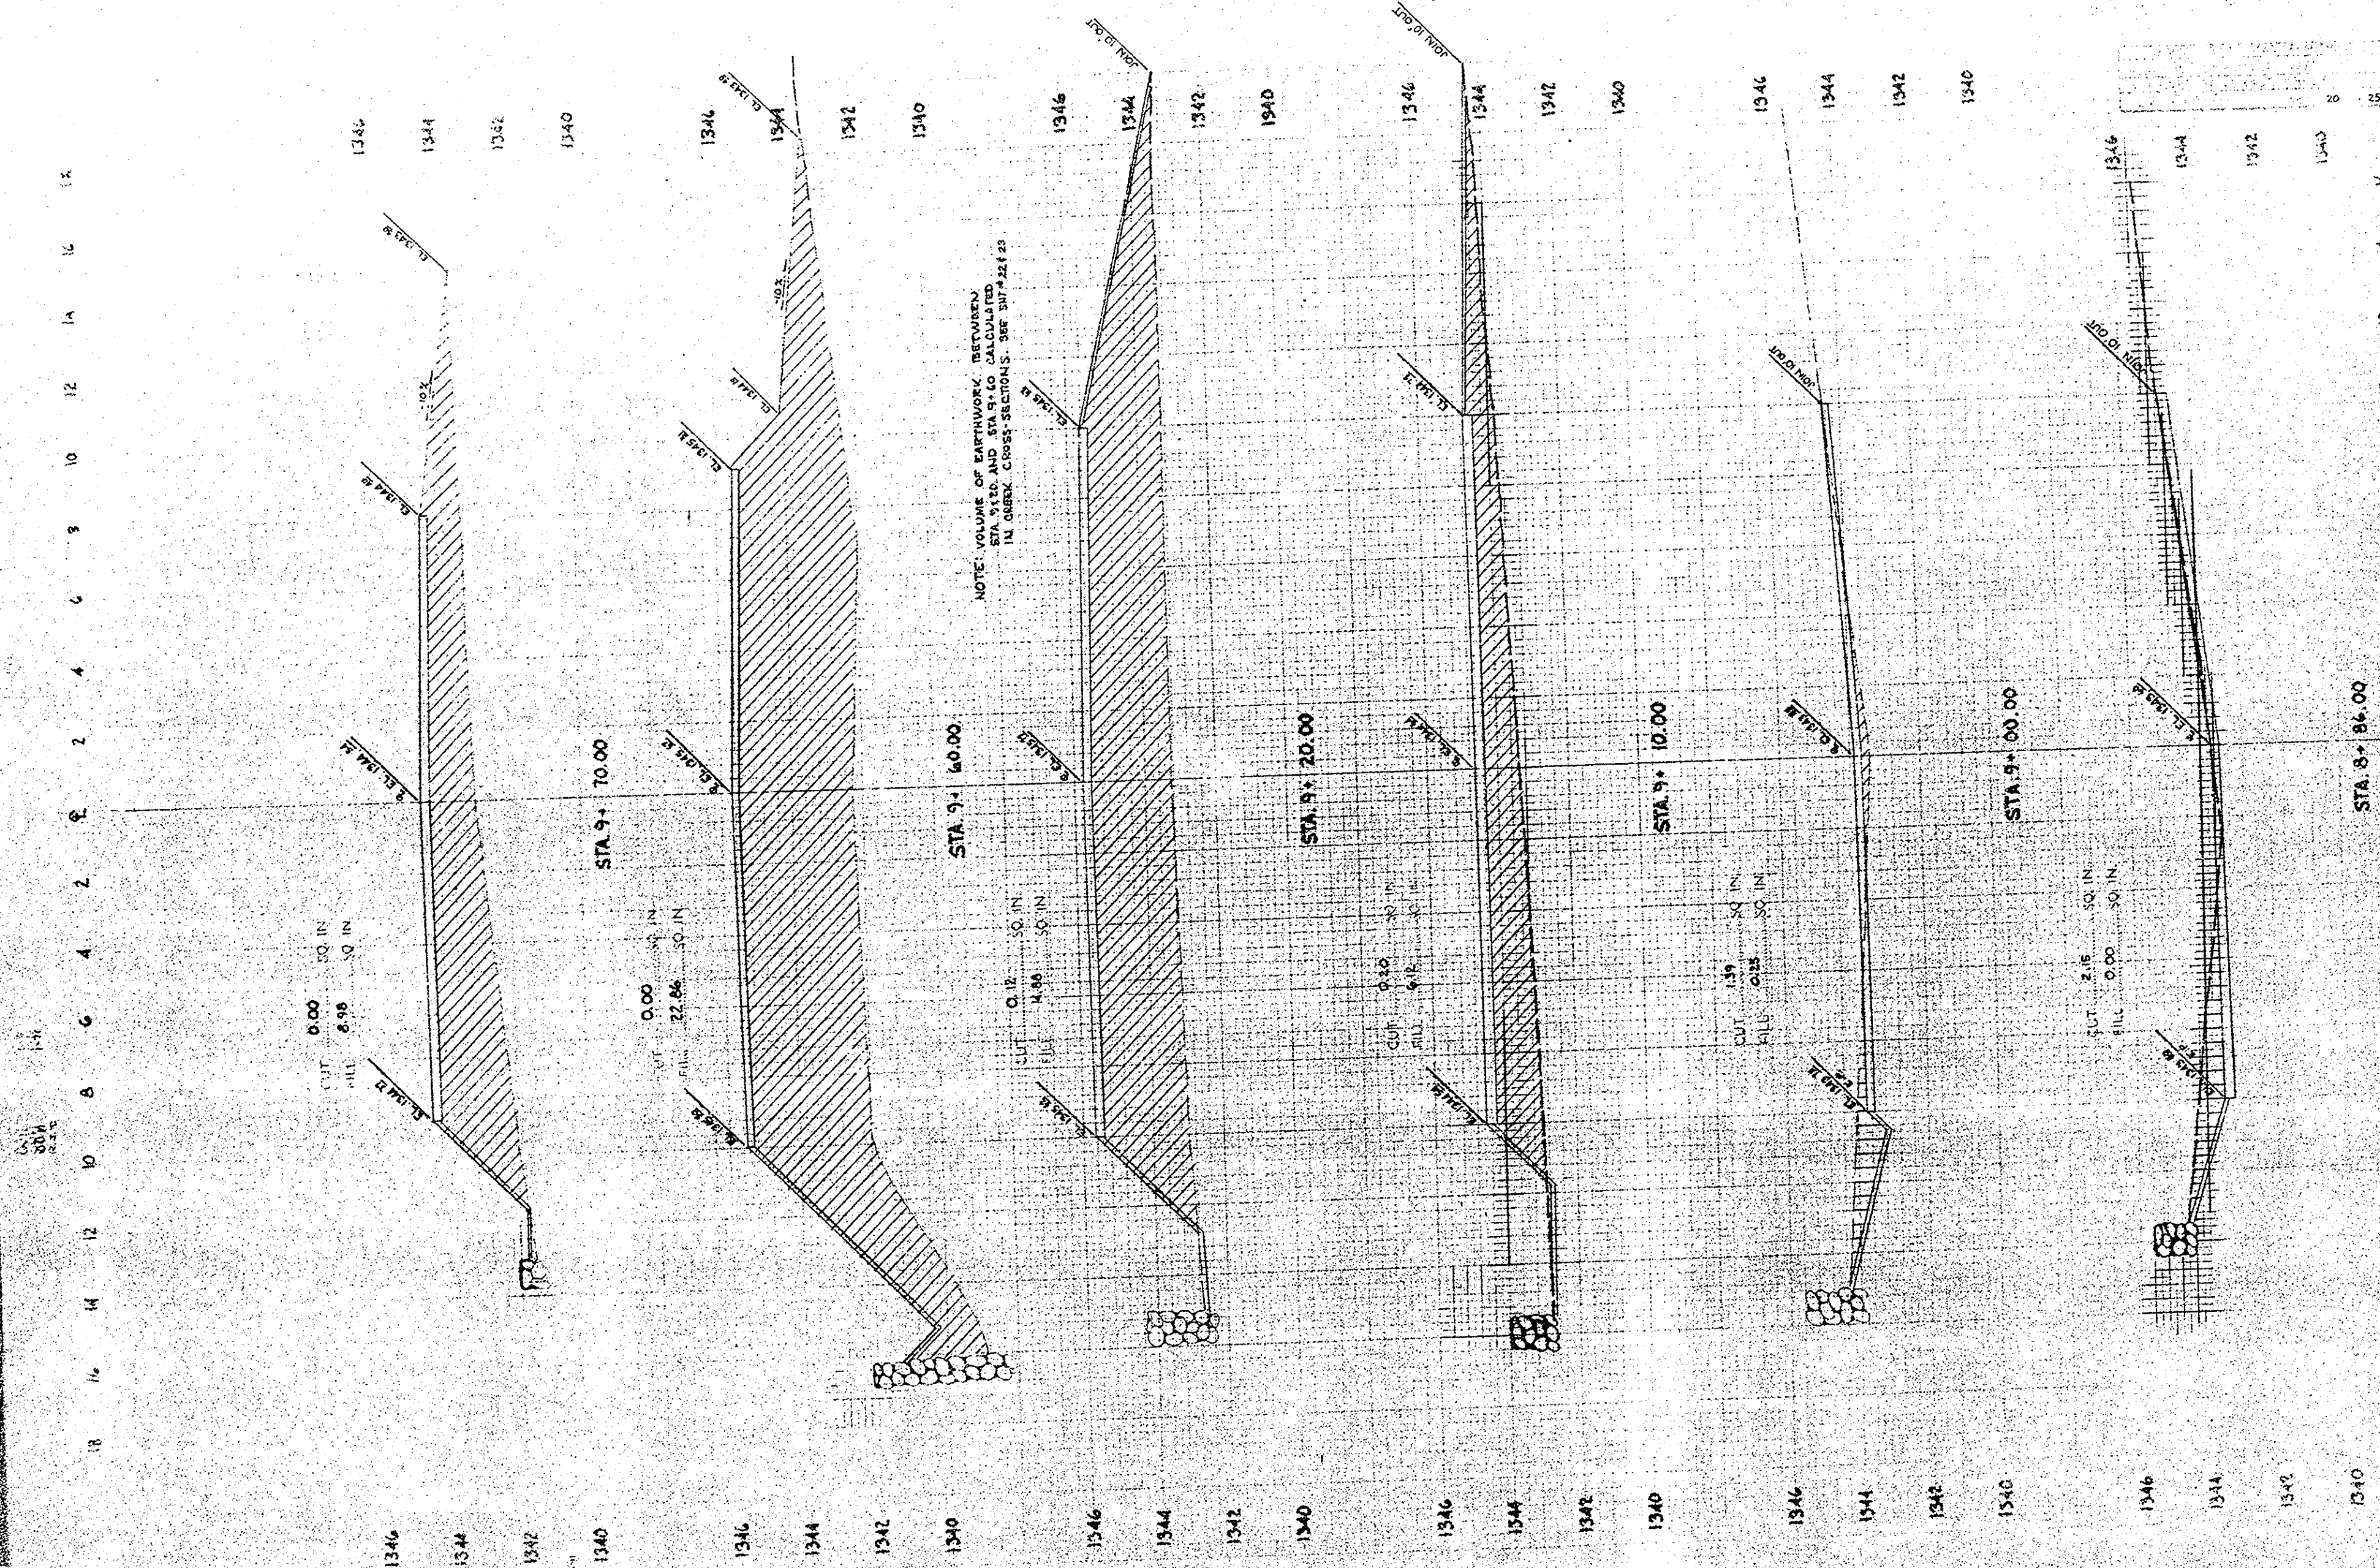

NOTE: VOLUME OF EARTHWORK BETWEEN
STATION 9+00 AND STA 9+10 CALCULATED
IN CROSS SECTIONS. SEE SHEET 22 f 23

STA 8+86.00