
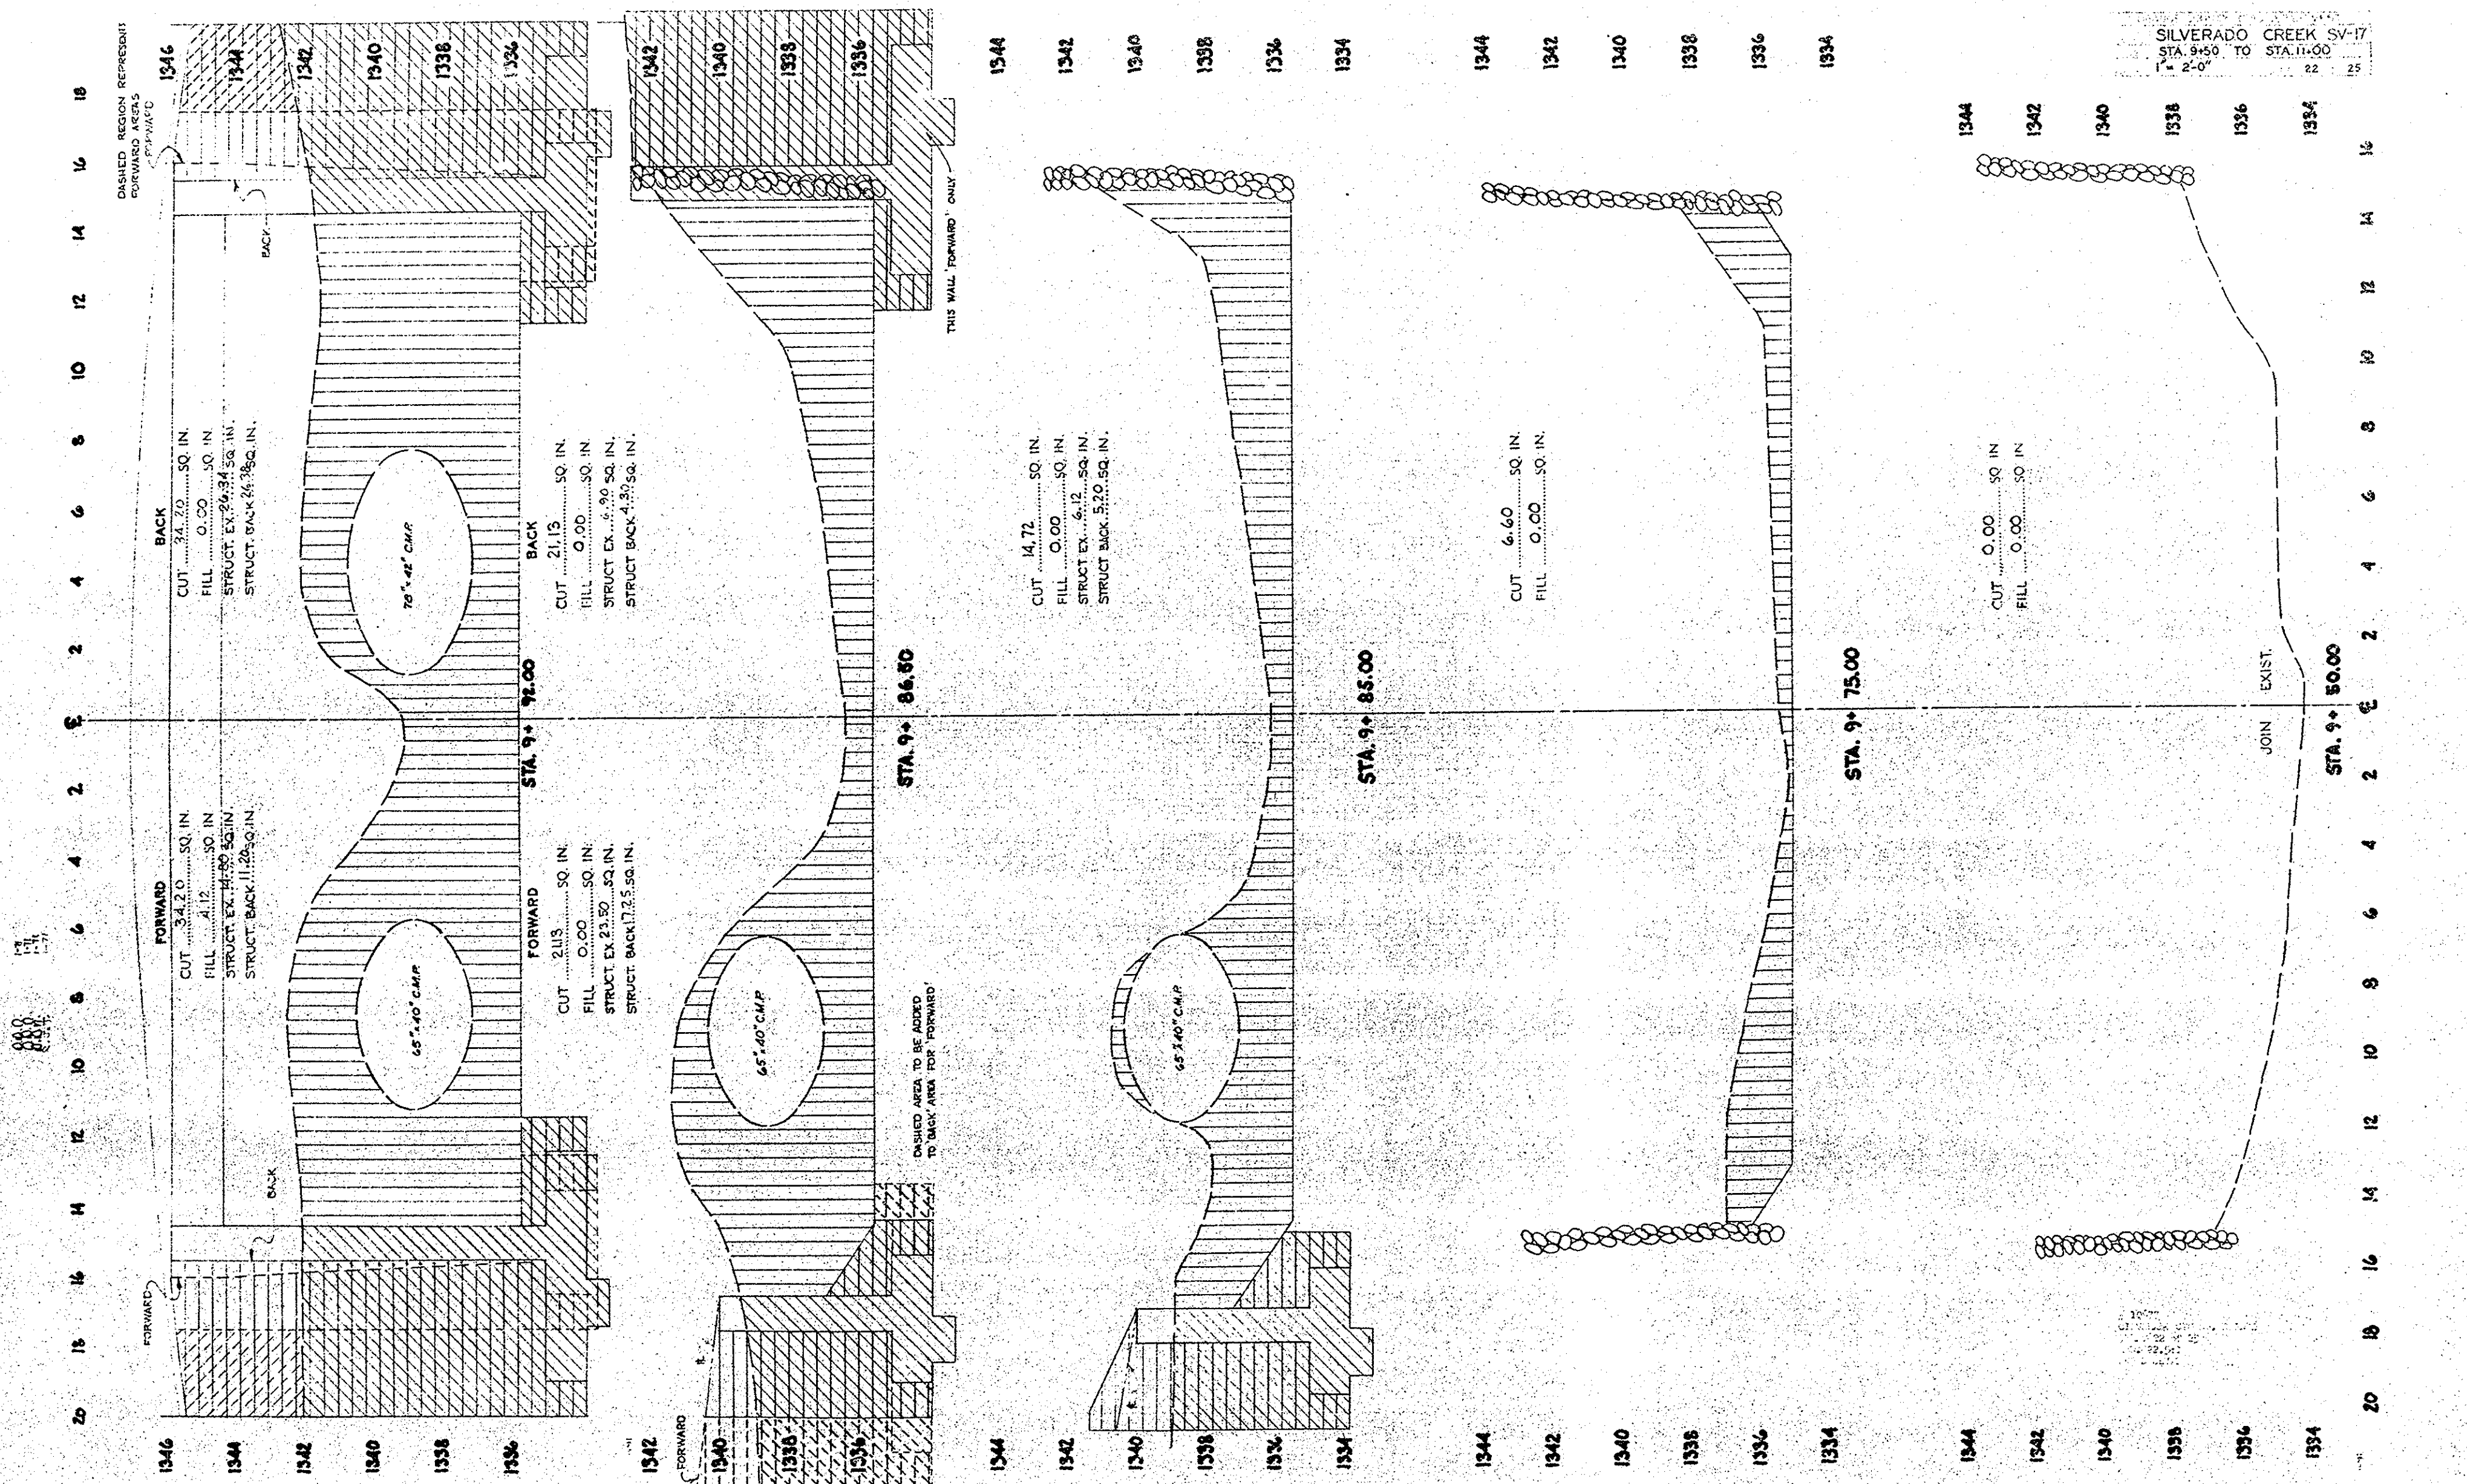


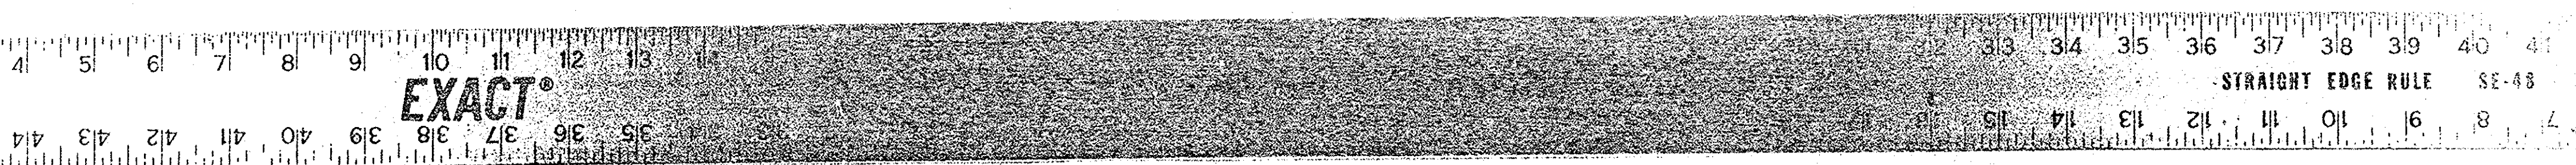

SILVERADO CREEK SV-17
STA. 9+50 TO STA. 11+00
1" = 2'-0"

20.17 (10672)