


STRAIGHT EDGE RULE SE-48

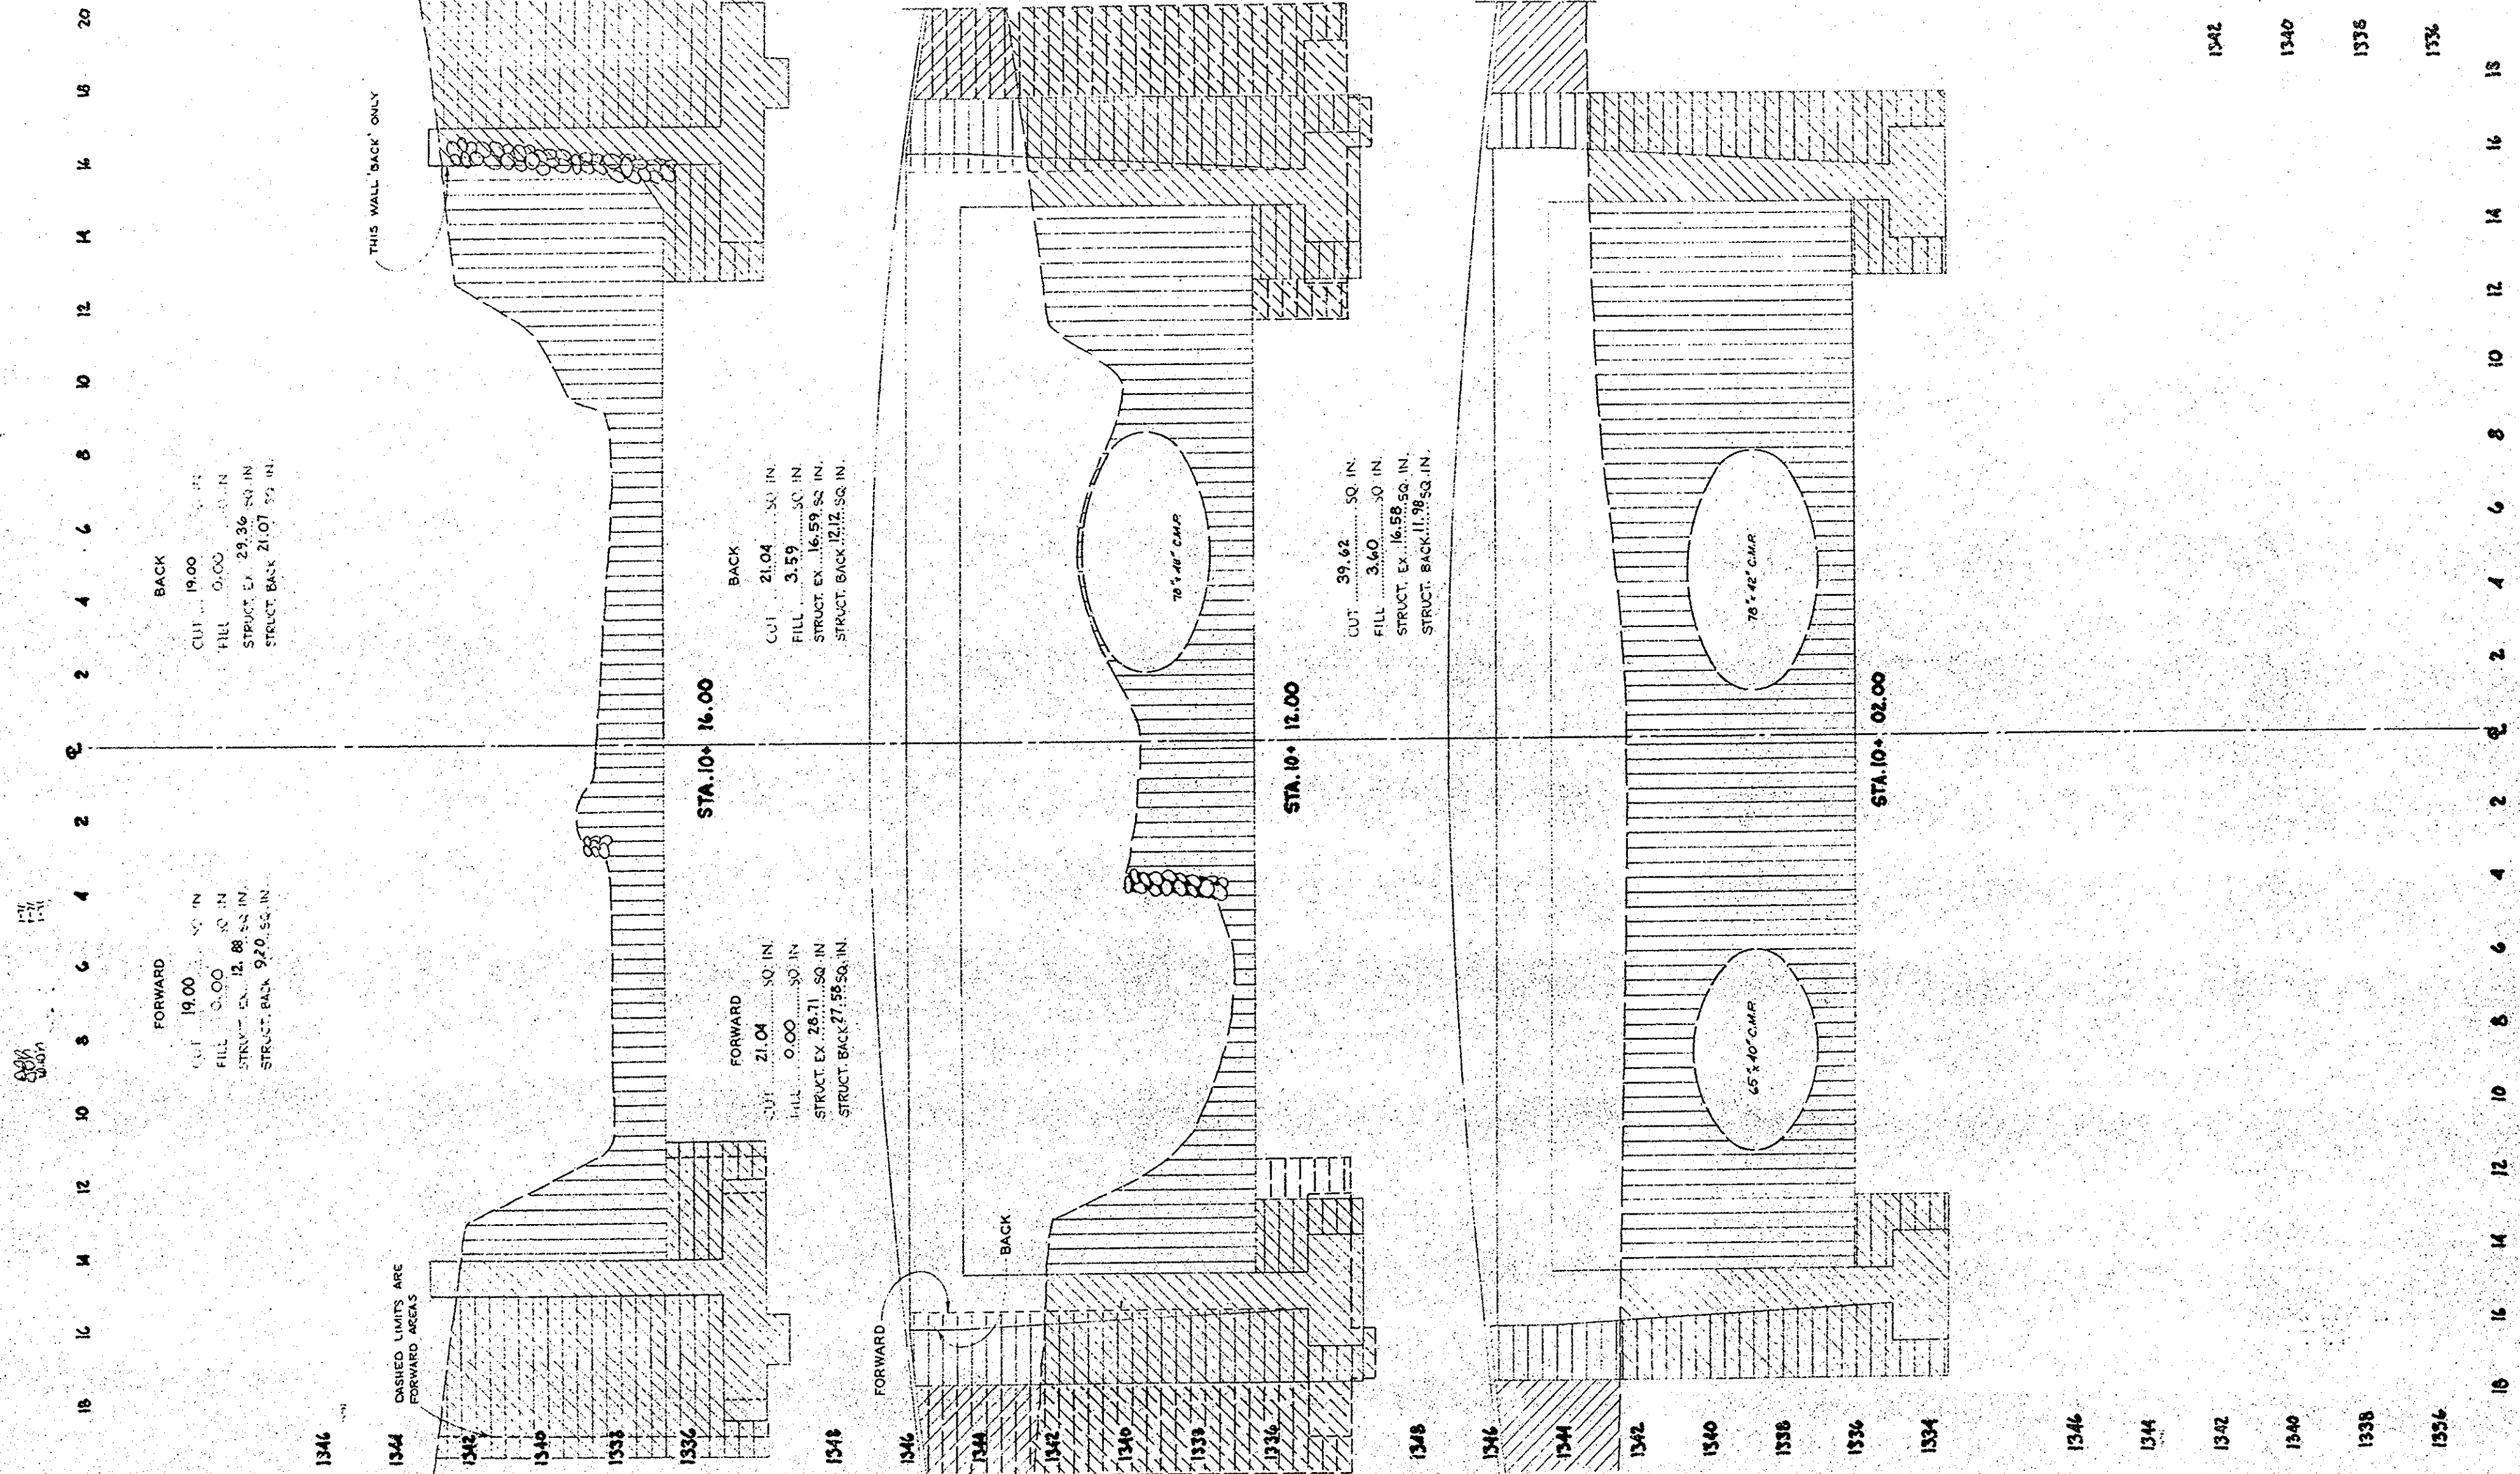

SILVERADO CREEK SV-17
STA 9+50 TO STA 11+00
1:2.0'

DR. 17 (10677)