




ORANGE COUNTY ROAD DEPT.

STATE OF CALIFORNIA

PLANS FOR CONSTRUCTION ON THISA WAY SILVERADO CANYON RD. TO 325' S'LY.

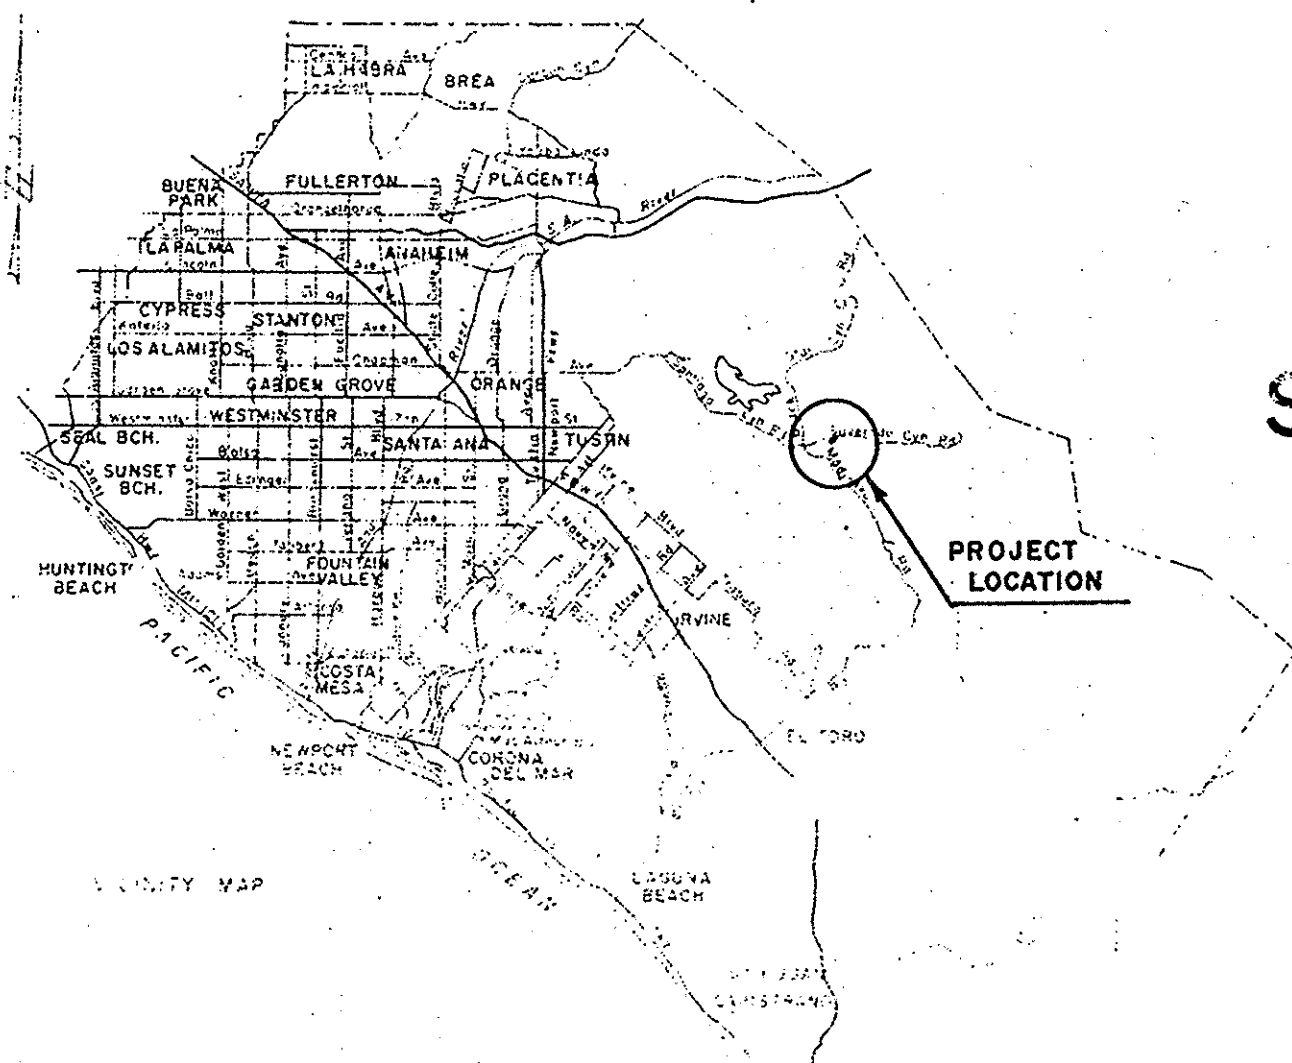


INDEX OF SHEETS

1. TITLE SHEET
2. PLAN & PROFILE
3. STRUCTURAL DETAIL
4. CROSS SECTIONS

AS BUILT

RES. ENG. PAUL RICKER 7/7/65

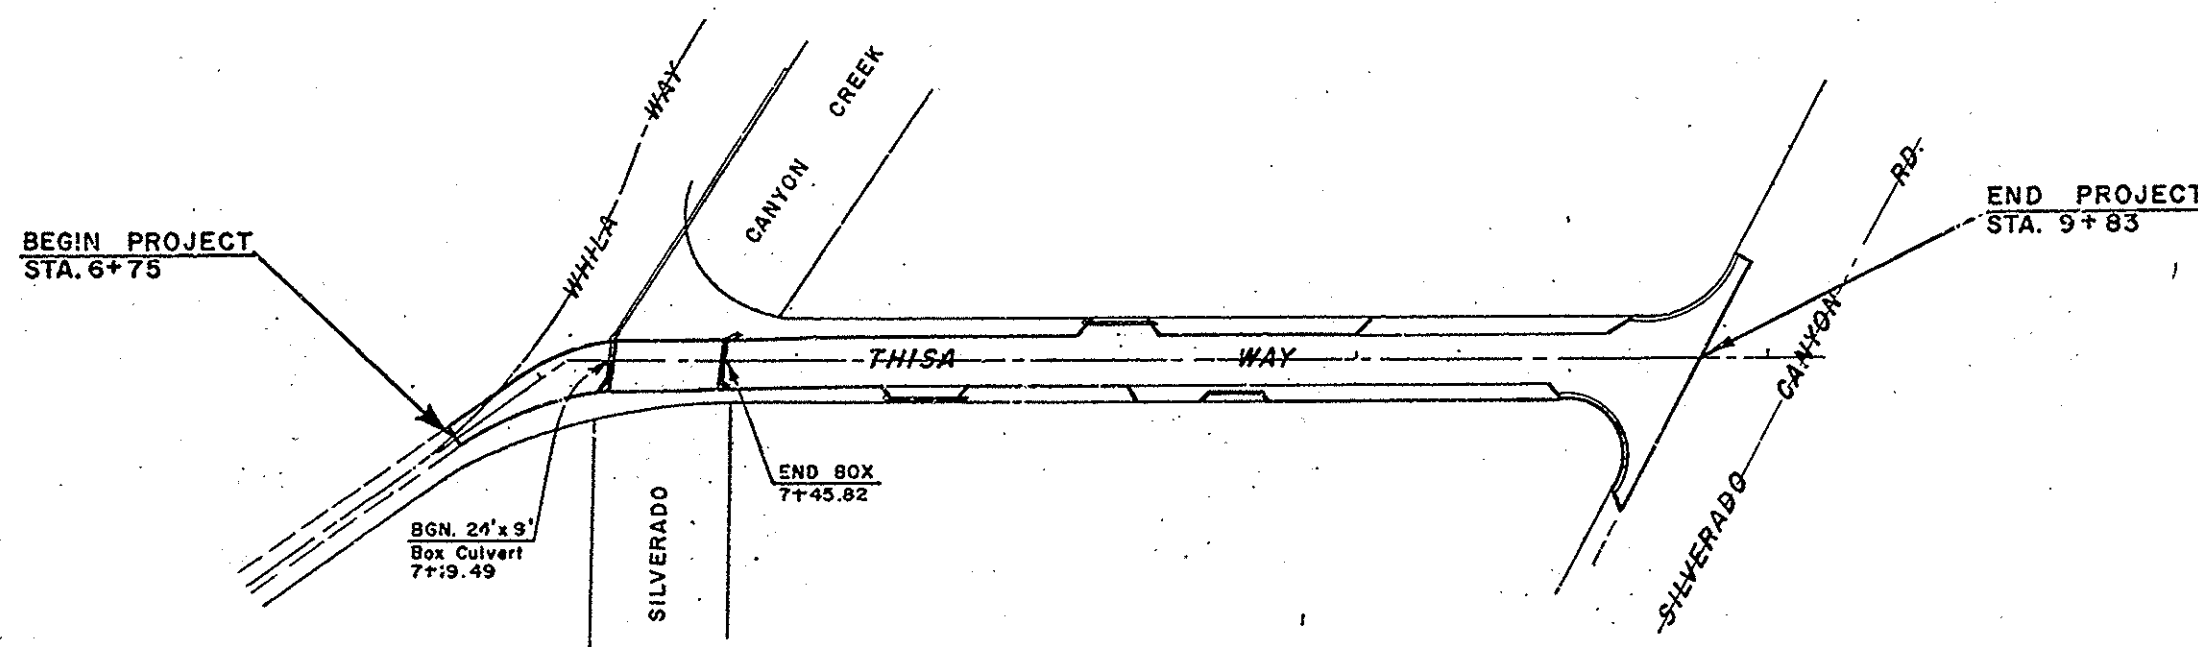

Scale 1" = 30'

CONVENTIONAL SIGNS

1. ADVANCE WARNING OF ROAD AHEAD	2. AHEAD OF ROAD
3. ROAD AHEAD	4. ROAD AHEAD
5. ROAD AHEAD	6. ROAD AHEAD
7. ROAD AHEAD	8. ROAD AHEAD
99. ROAD AHEAD	100. ROAD AHEAD

APPROVED: *William A. Brown* 4-19-65
CIVIL ENGINEER

THISA WAY @ SILVERADO CREEK
SV-19-1965
55C-188
THIS MAP: 832-E2 @ SILVERADO CREEK