

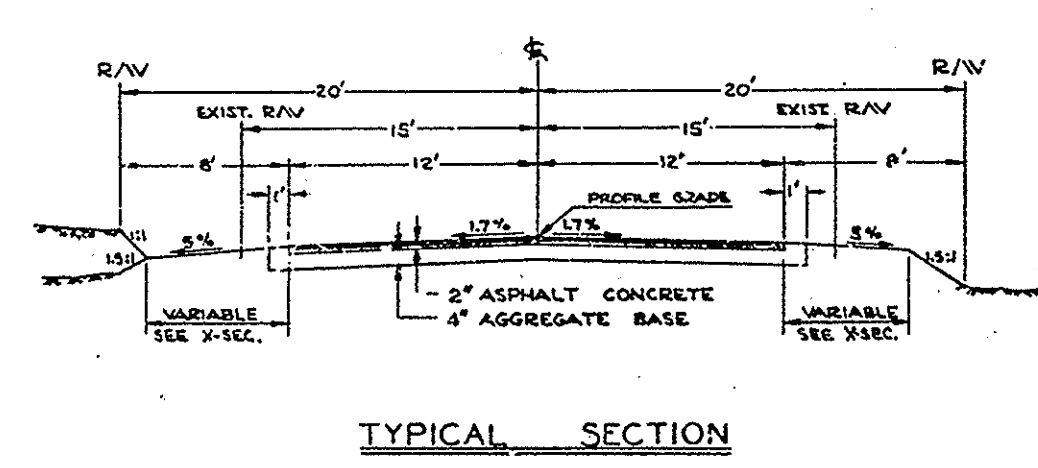


ORANGE COUNTY HIGHWAY DEPARTMENT
PROJECT THISA WAY
LIMITS SILVERADO CYN. RD. TO 325' SLY.
SCALE 1"=20' SHEET 2 OF 4

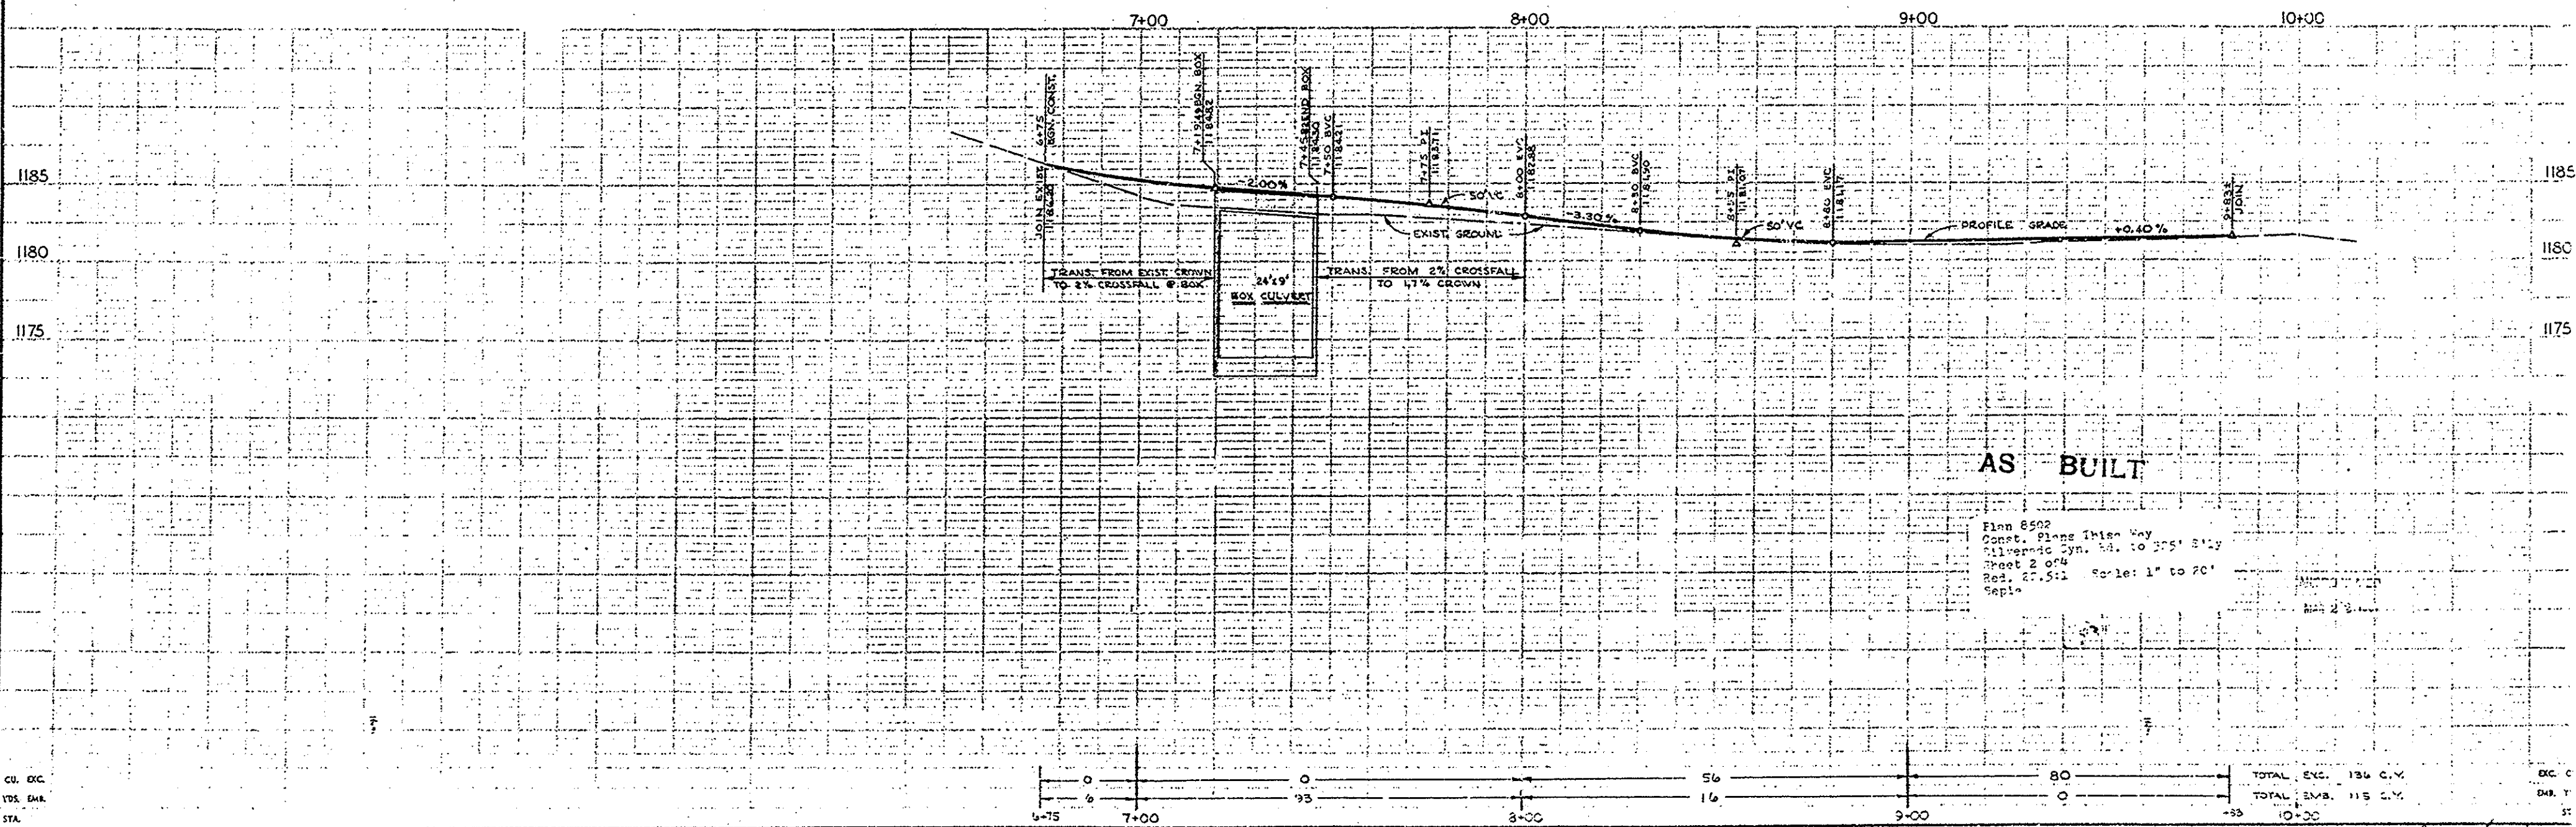

CONSTRUCTION NOTES

1. PROPANE TANK, BLOCK WALL AND ALL UTILITIES SHALL BE REMOVED OR RELOCATED BY OTHERS PRIOR TO CONTRACT.
2. 2\"/>
3. DIKE SECTION
4. STATIONING SHOWN ALONG TANGENT

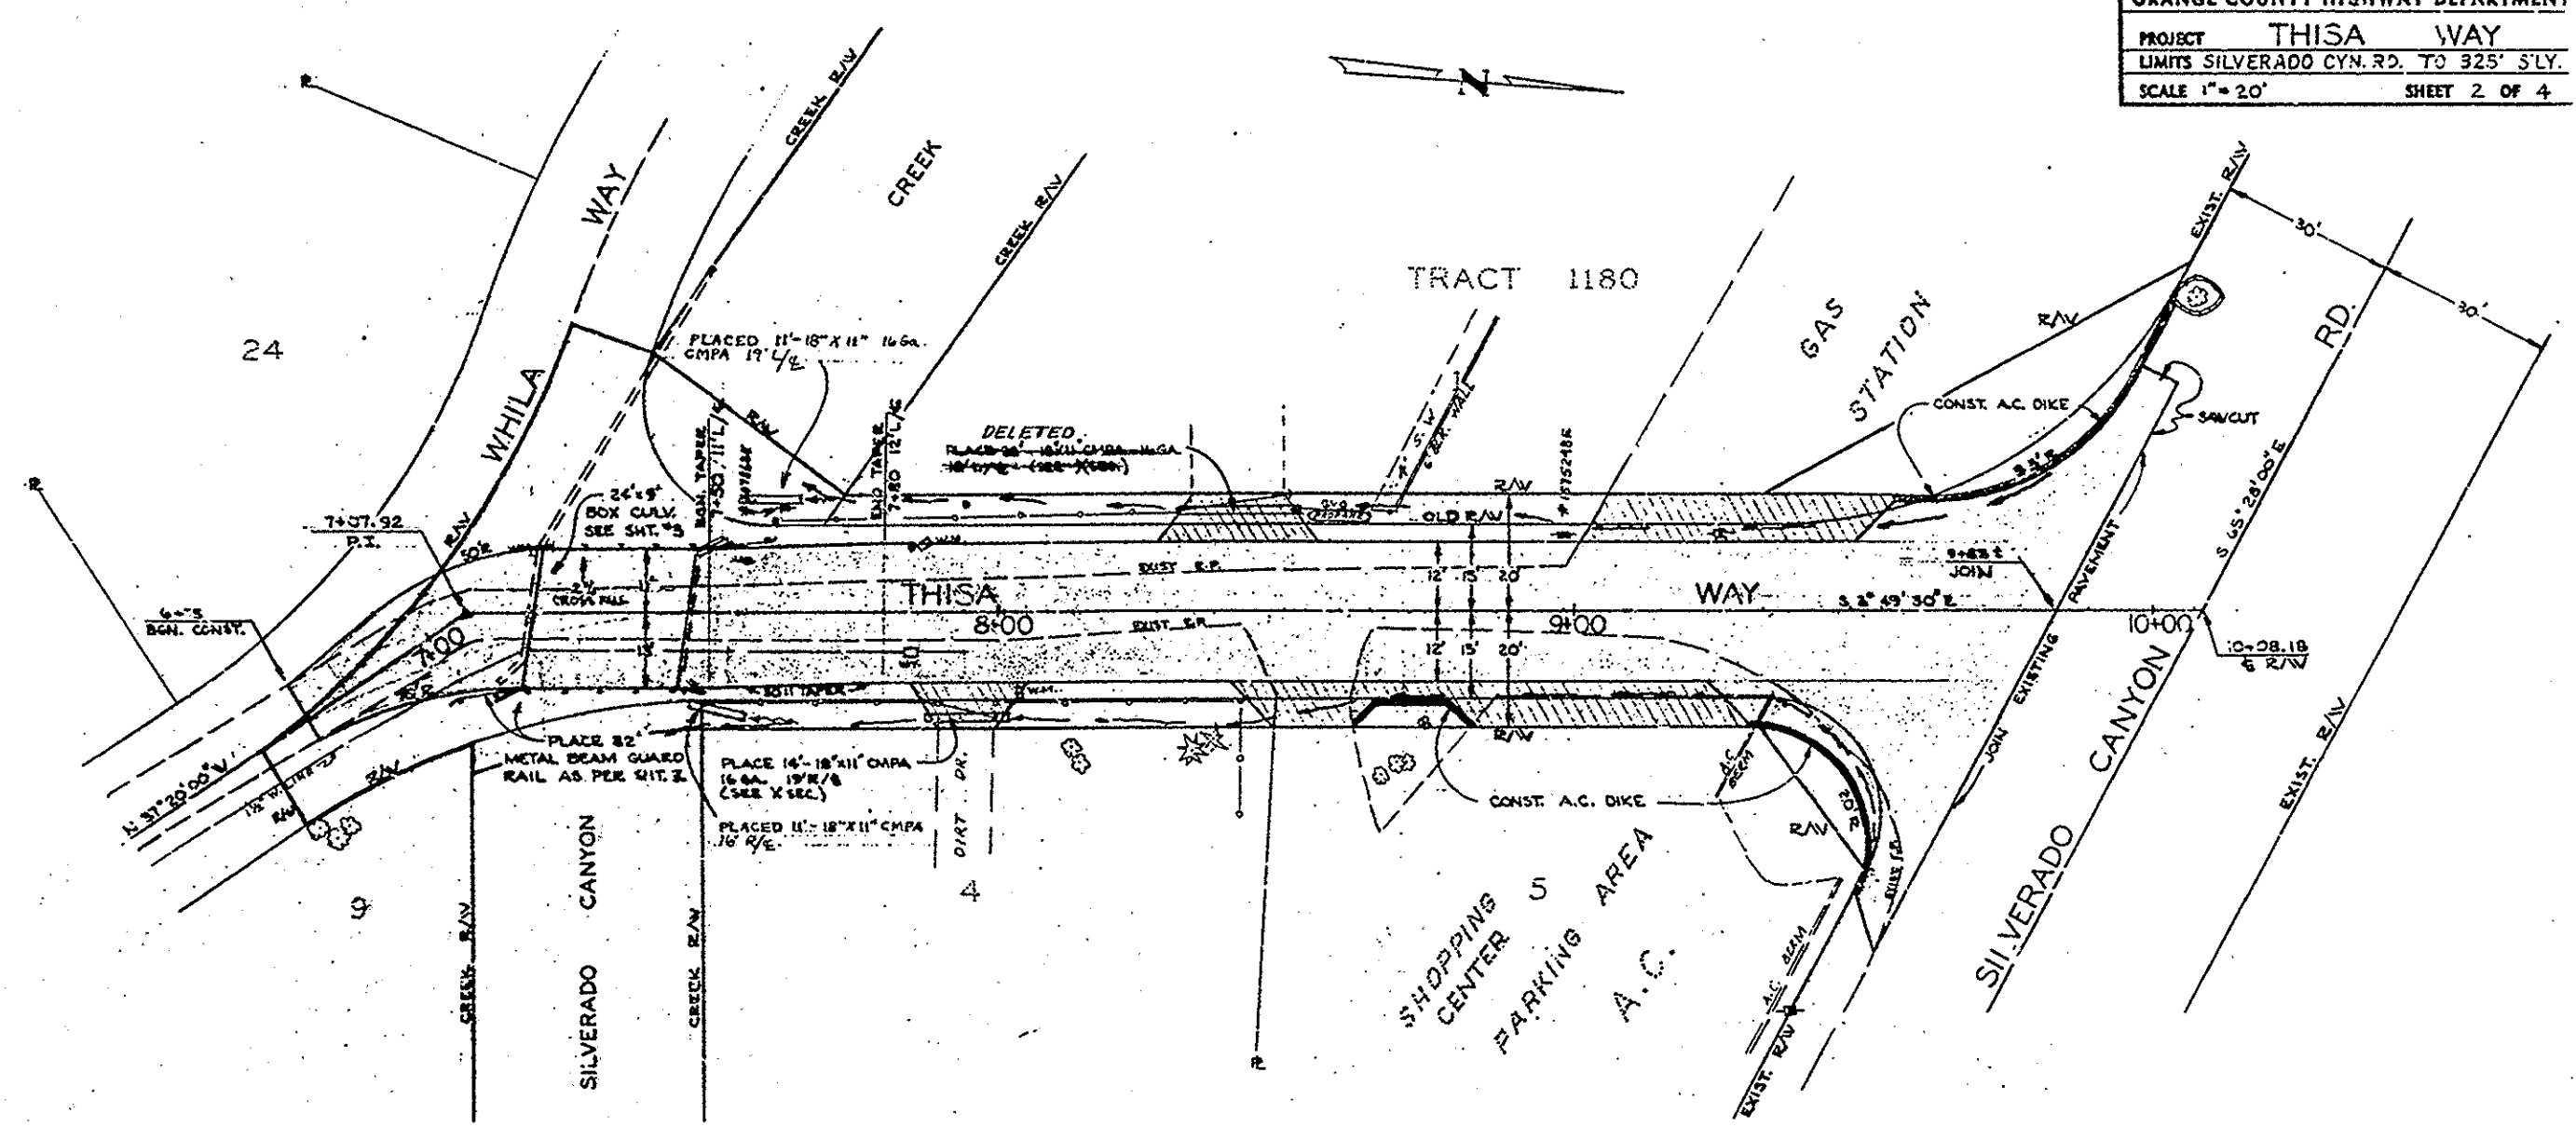

AS BUILT
Plan 8502
Const. Plans Thisa Way
Silverado Cyn. Rd. to 325' SLY.
Sheet 2 of 4
Red. 2.5.12 Scale: 1"=20'
Sept.

TOTAL EMB. 136 C.Y.
TOTAL EMB. 115 C.Y.
10+00

Ex. 17 (8502)

Thisa Way

D-17 (8502)