





EXACT LEVEL & TOOL MFG. CO.


STRAIGHT EDGE RULE SE-48

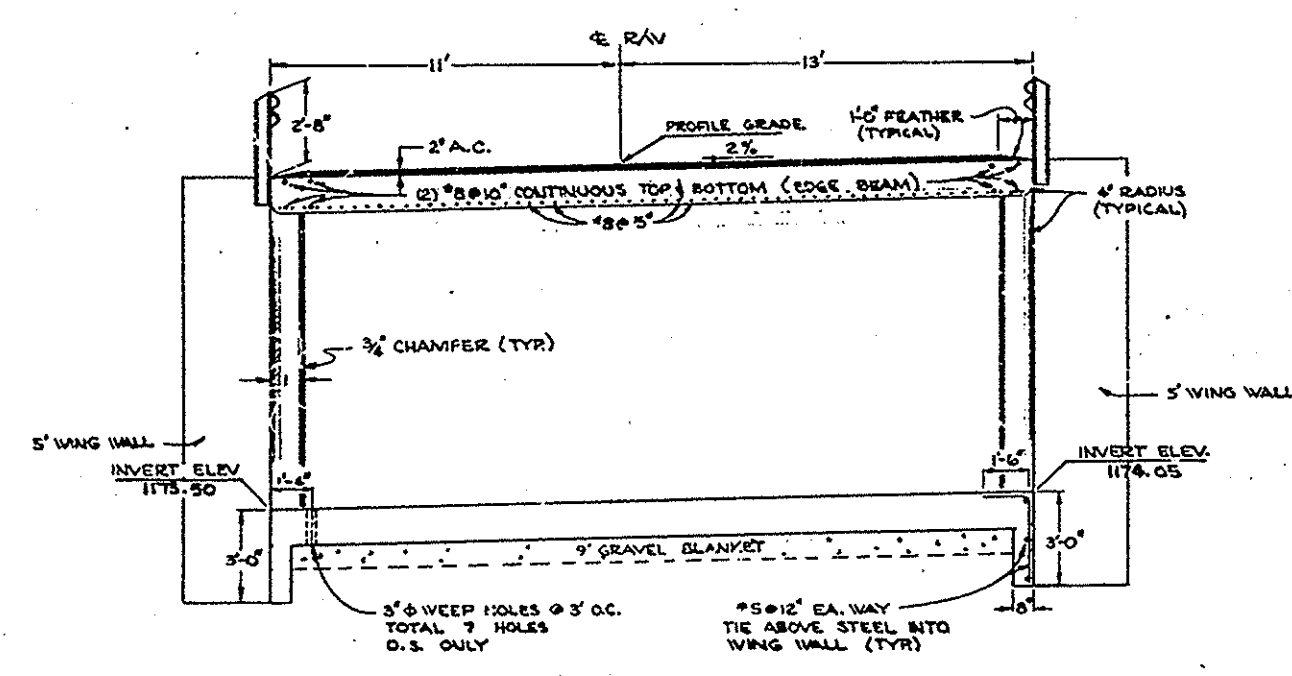


SECTION A-A
SCALE: 1\"/>

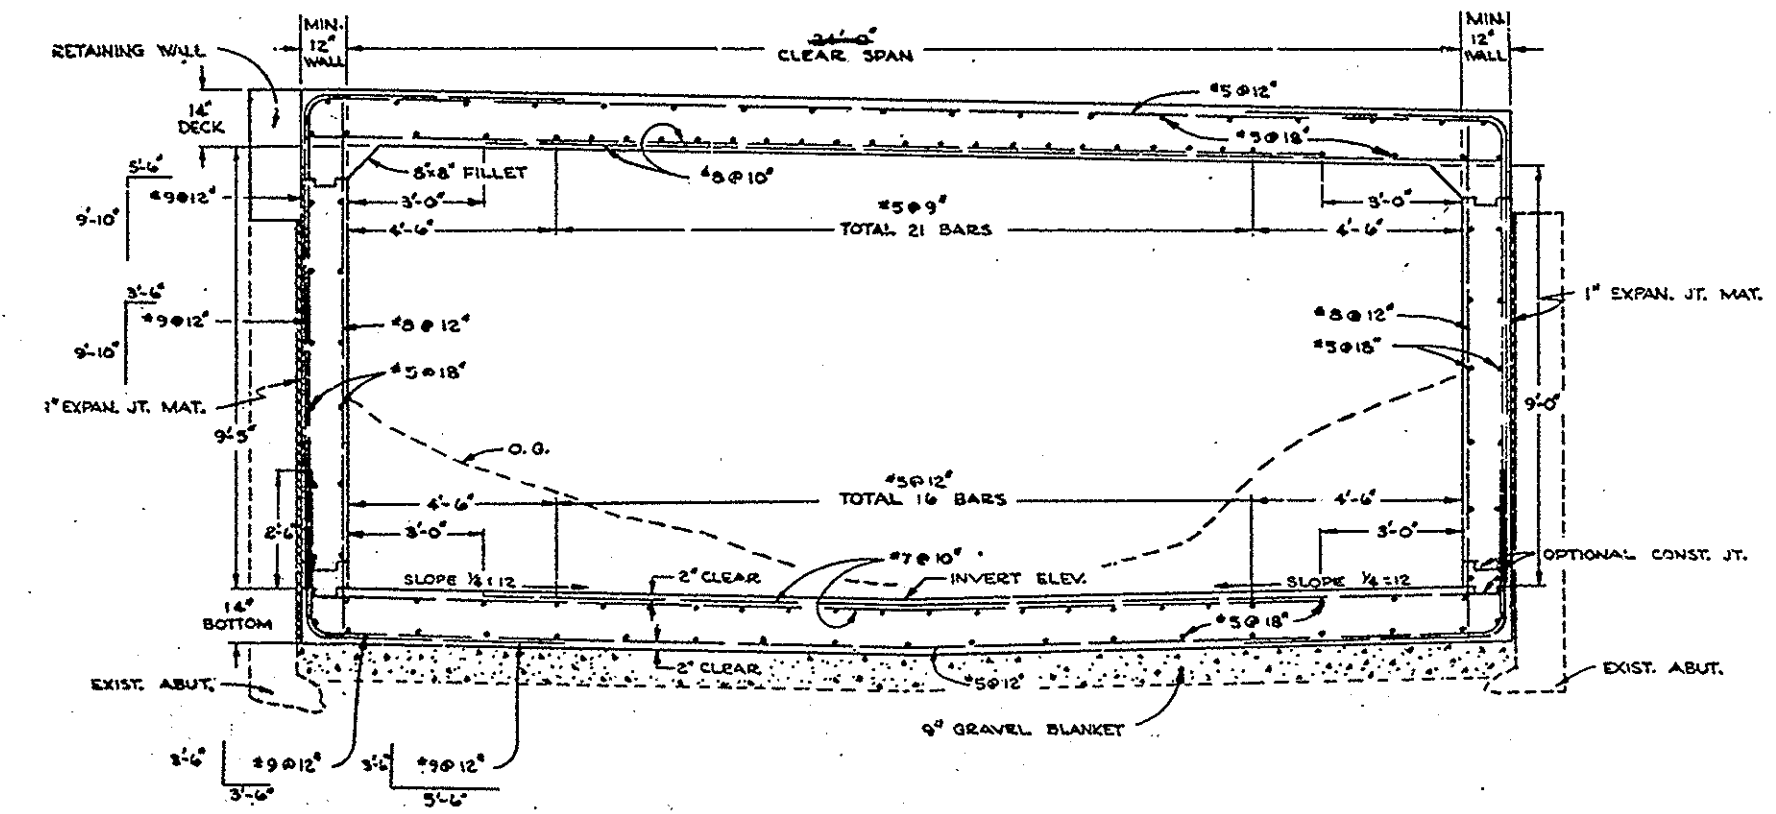


SECTION B-B
SCALE: 3/8\"/>

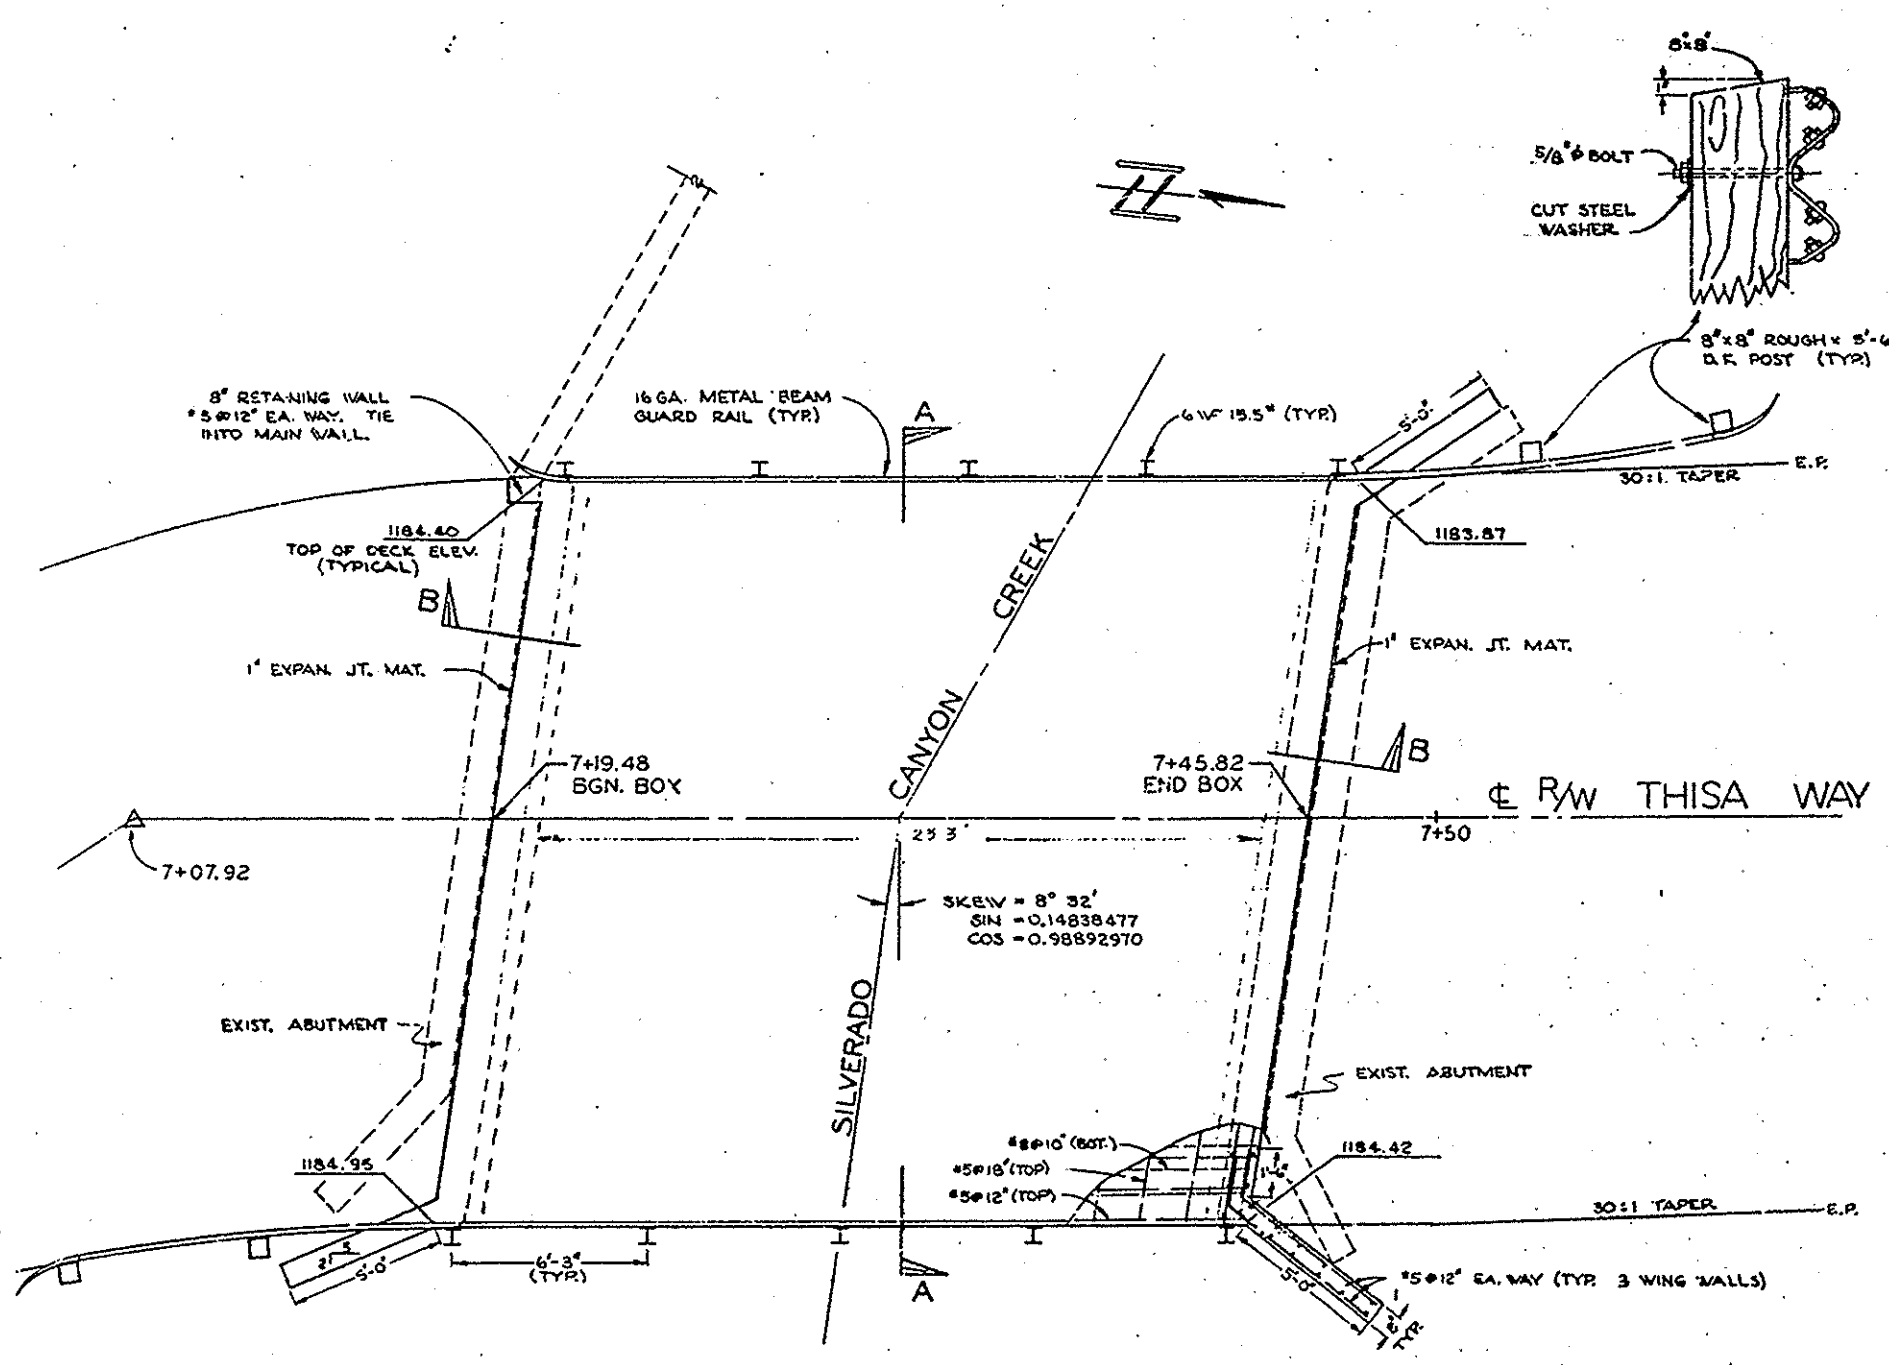


PLAN VIEW
SCALE: 1\"/>

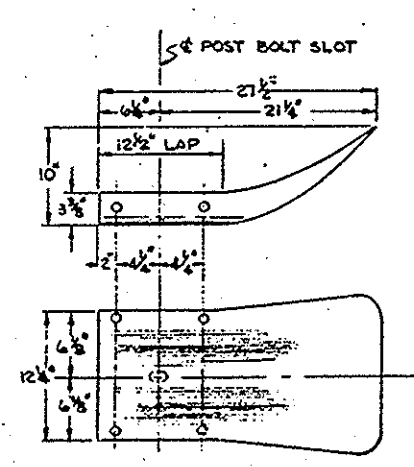

TERMINAL SECTION

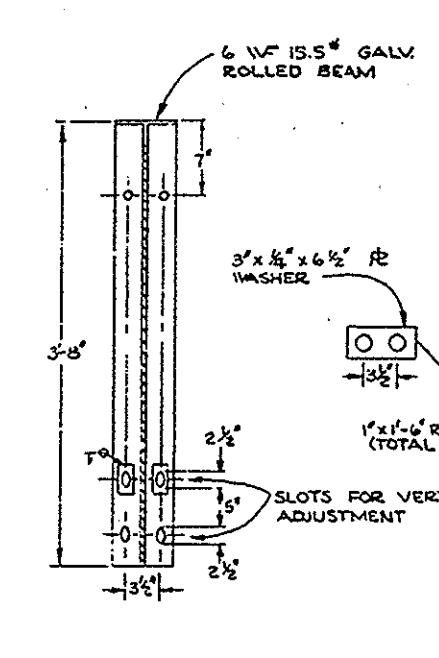

SECTION C-C

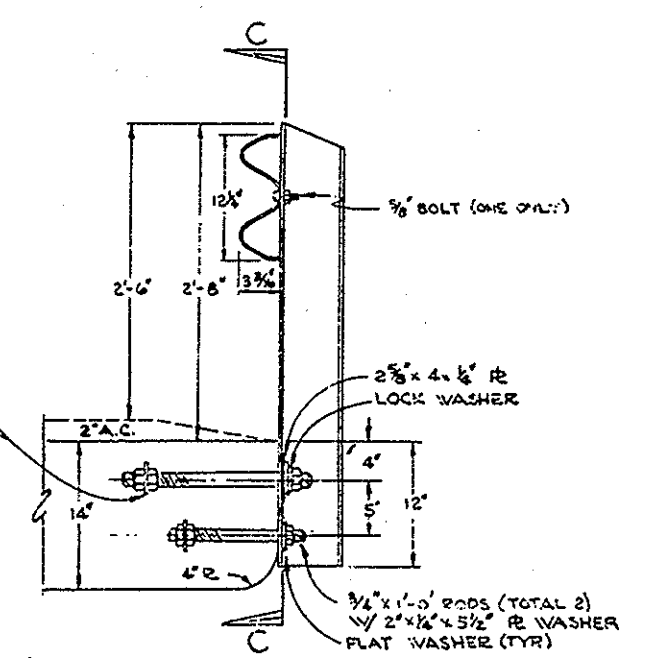

GUARDRAIL SUPPORT

CONSTRUCTION NOTES

1. PLACE 1/8\"/>
2. ALL ANCHOR RODS SHALL HAVE HEX. NUTS.
3. CONTRACTOR TO PROVIDE METAL SHIMS TO ALIGN POSTS.
4. POSTS AND ANCHORS TO BE GALVANIZED AFTER FABRICATION.
5. LAP RAIL IN DIRECTION OF TRAFFIC.
6. TERMINAL SECTIONS SHALL BE PLACED AS SHOWN (TOTAL 4).

AS BUILT

Plan 8502
Cor's B Flans Thisa Way
Silverado Cyn Rd. to 325' Wiy
Sheet 1 of 4
Sept. 1, 1951
Sept 19

ORANGE COUNTY ROAD DEPARTMENT	
THISA WAY	
STRUCTURAL DETAILS	
AS SHOWN	3-4

Dr. 17 (8502)

Thisa Way

Dr. 17 (8502)