



POINT *	STATION	TOP SLAB ELEV.	INVERT ELEV.
1	10+91.31	1814.60	1811.60
2	10+82.89	1814.34	1809.80
3	10+78.20	1814.20	1808.80
4	10+90.00	1814.20	1808.80
5	10+94.69	1814.34	1809.80
6	11+03.11	1814.60	1811.60
7	10+88.79	1814.34	1809.80

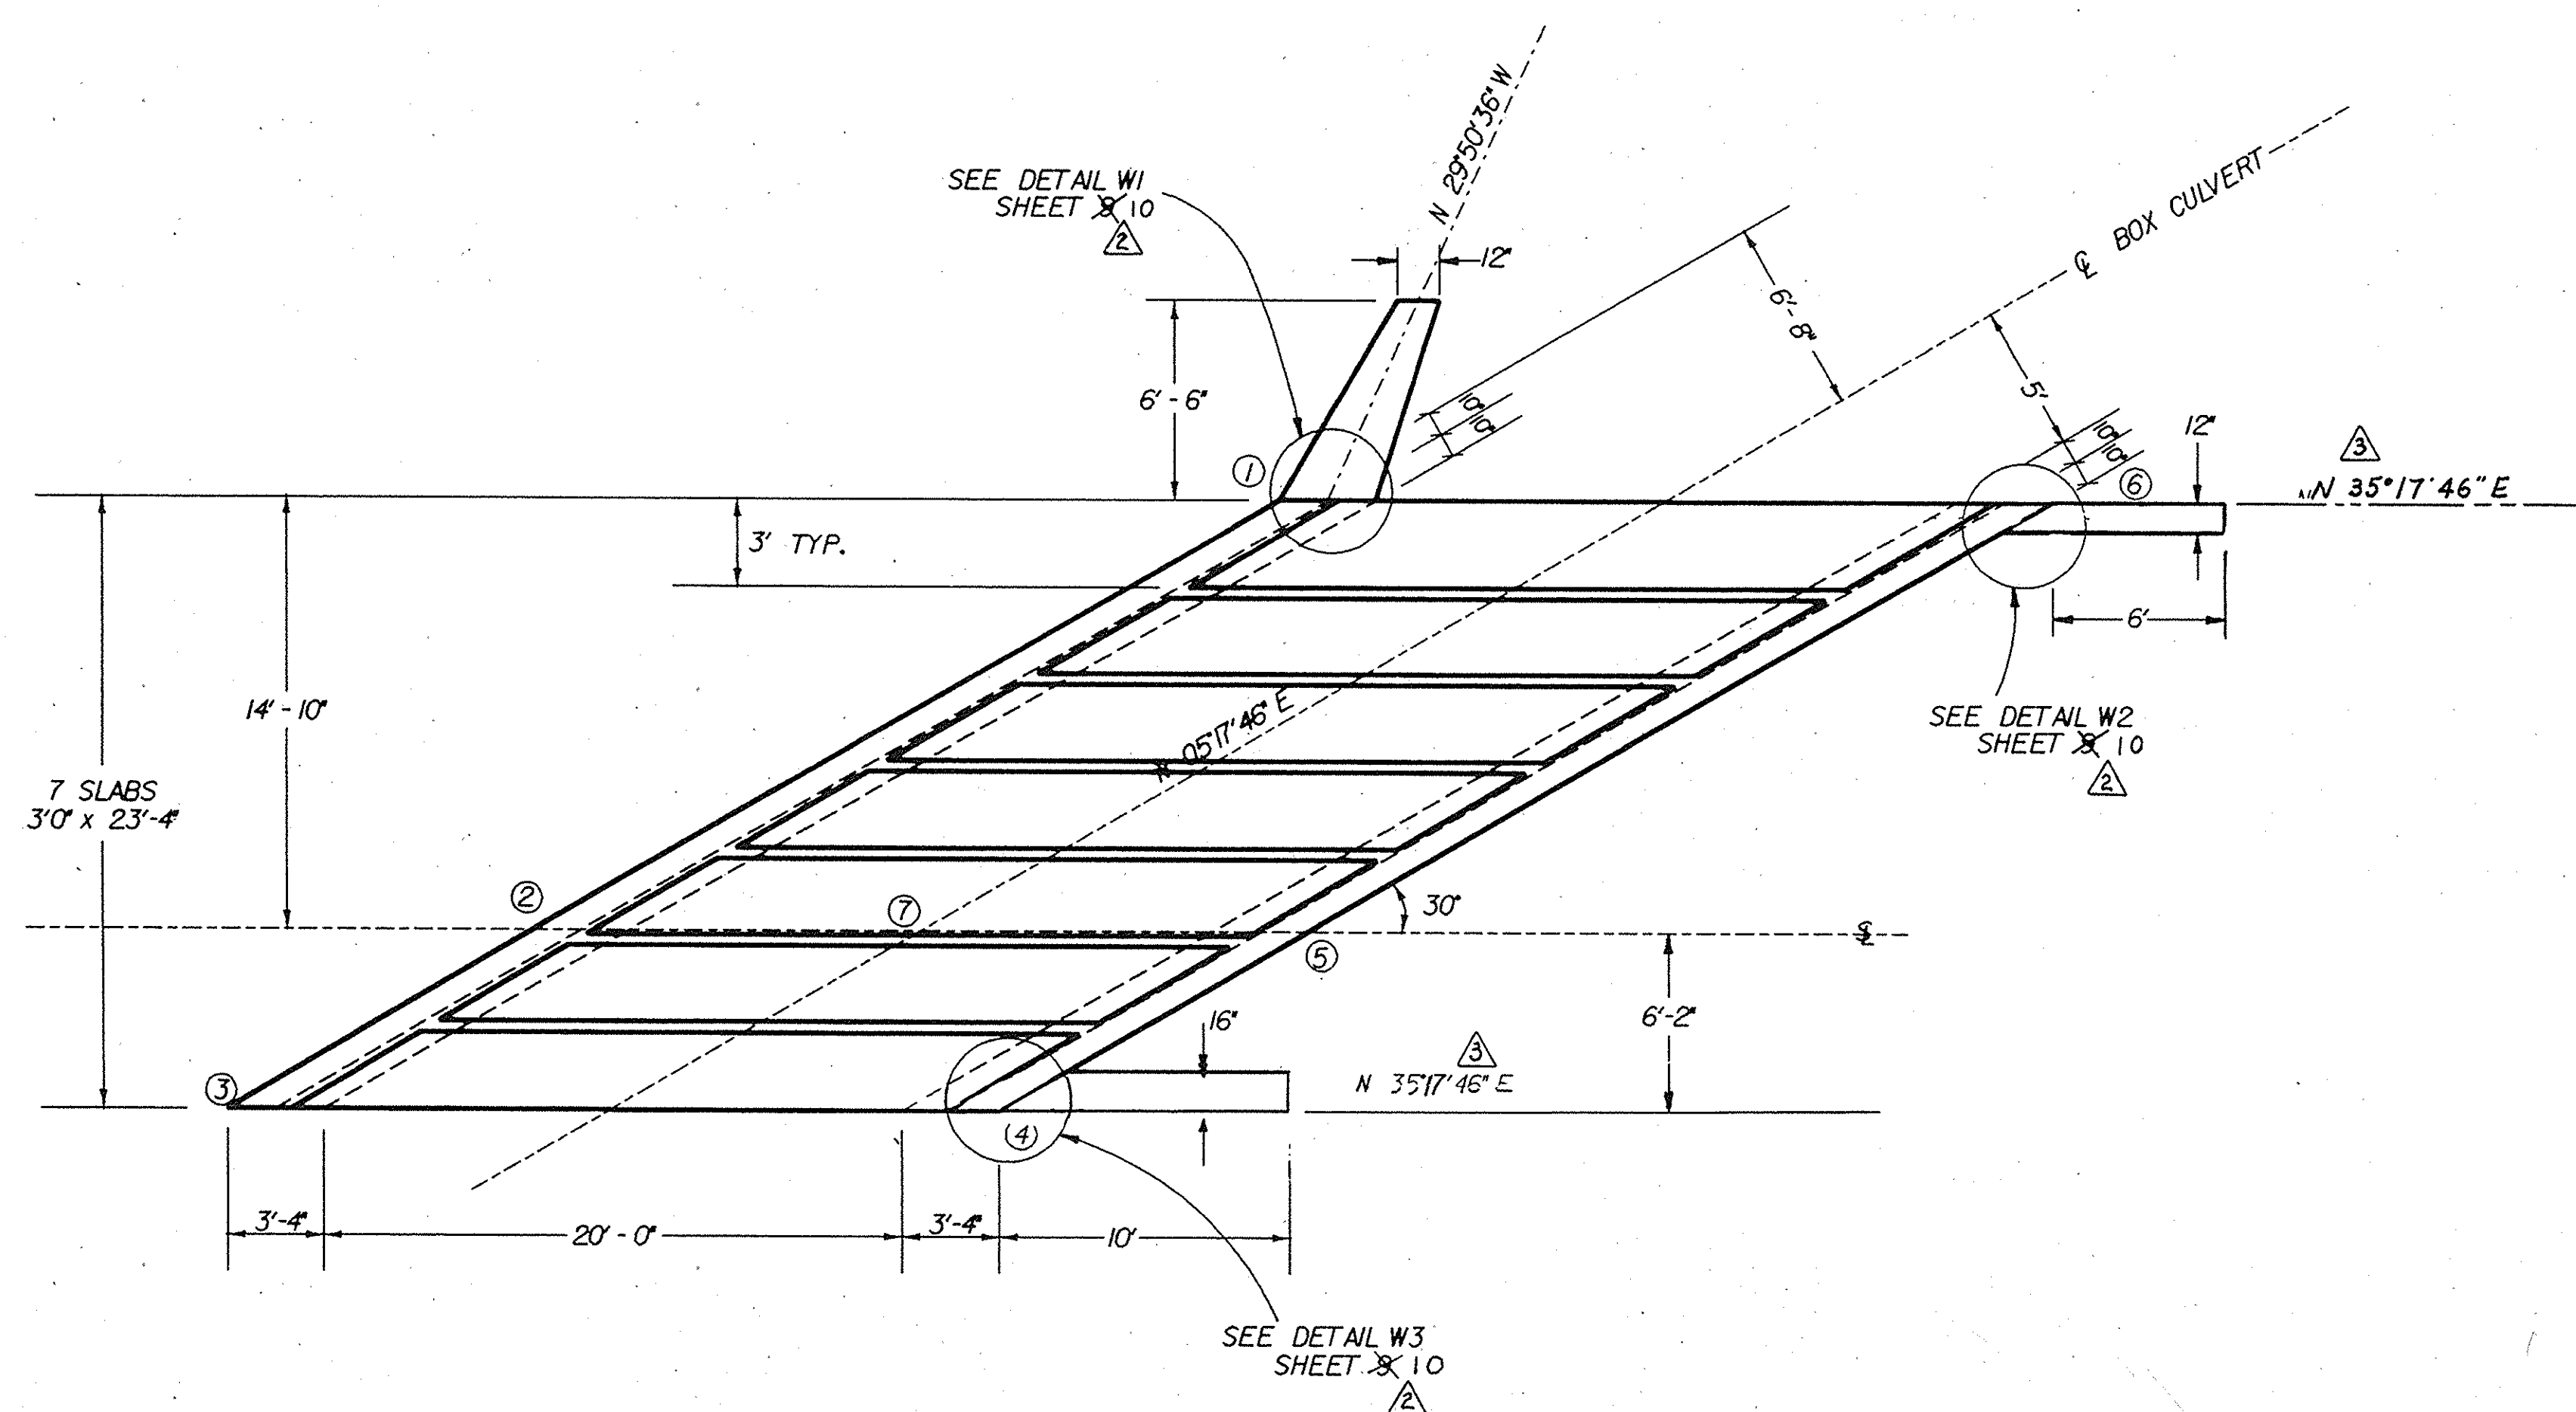

PLAN VIEW - EASTERLY BOX

SCALE 1" = 5'-0"

POINT *	STATION	TOP SLAB ELEV.	INVERT ELEV.
1	11+29.78	1814.80	1810.05
2	11+04.09	1814.38	1809.17
3	10+93.41	1814.20	1808.80
4	11+20.08	1814.90	1808.80
5	11+30.76	1815.08	1809.17
6	11+56.45	1815.50	1810.05
7	11+17.42	1814.73	1809.17

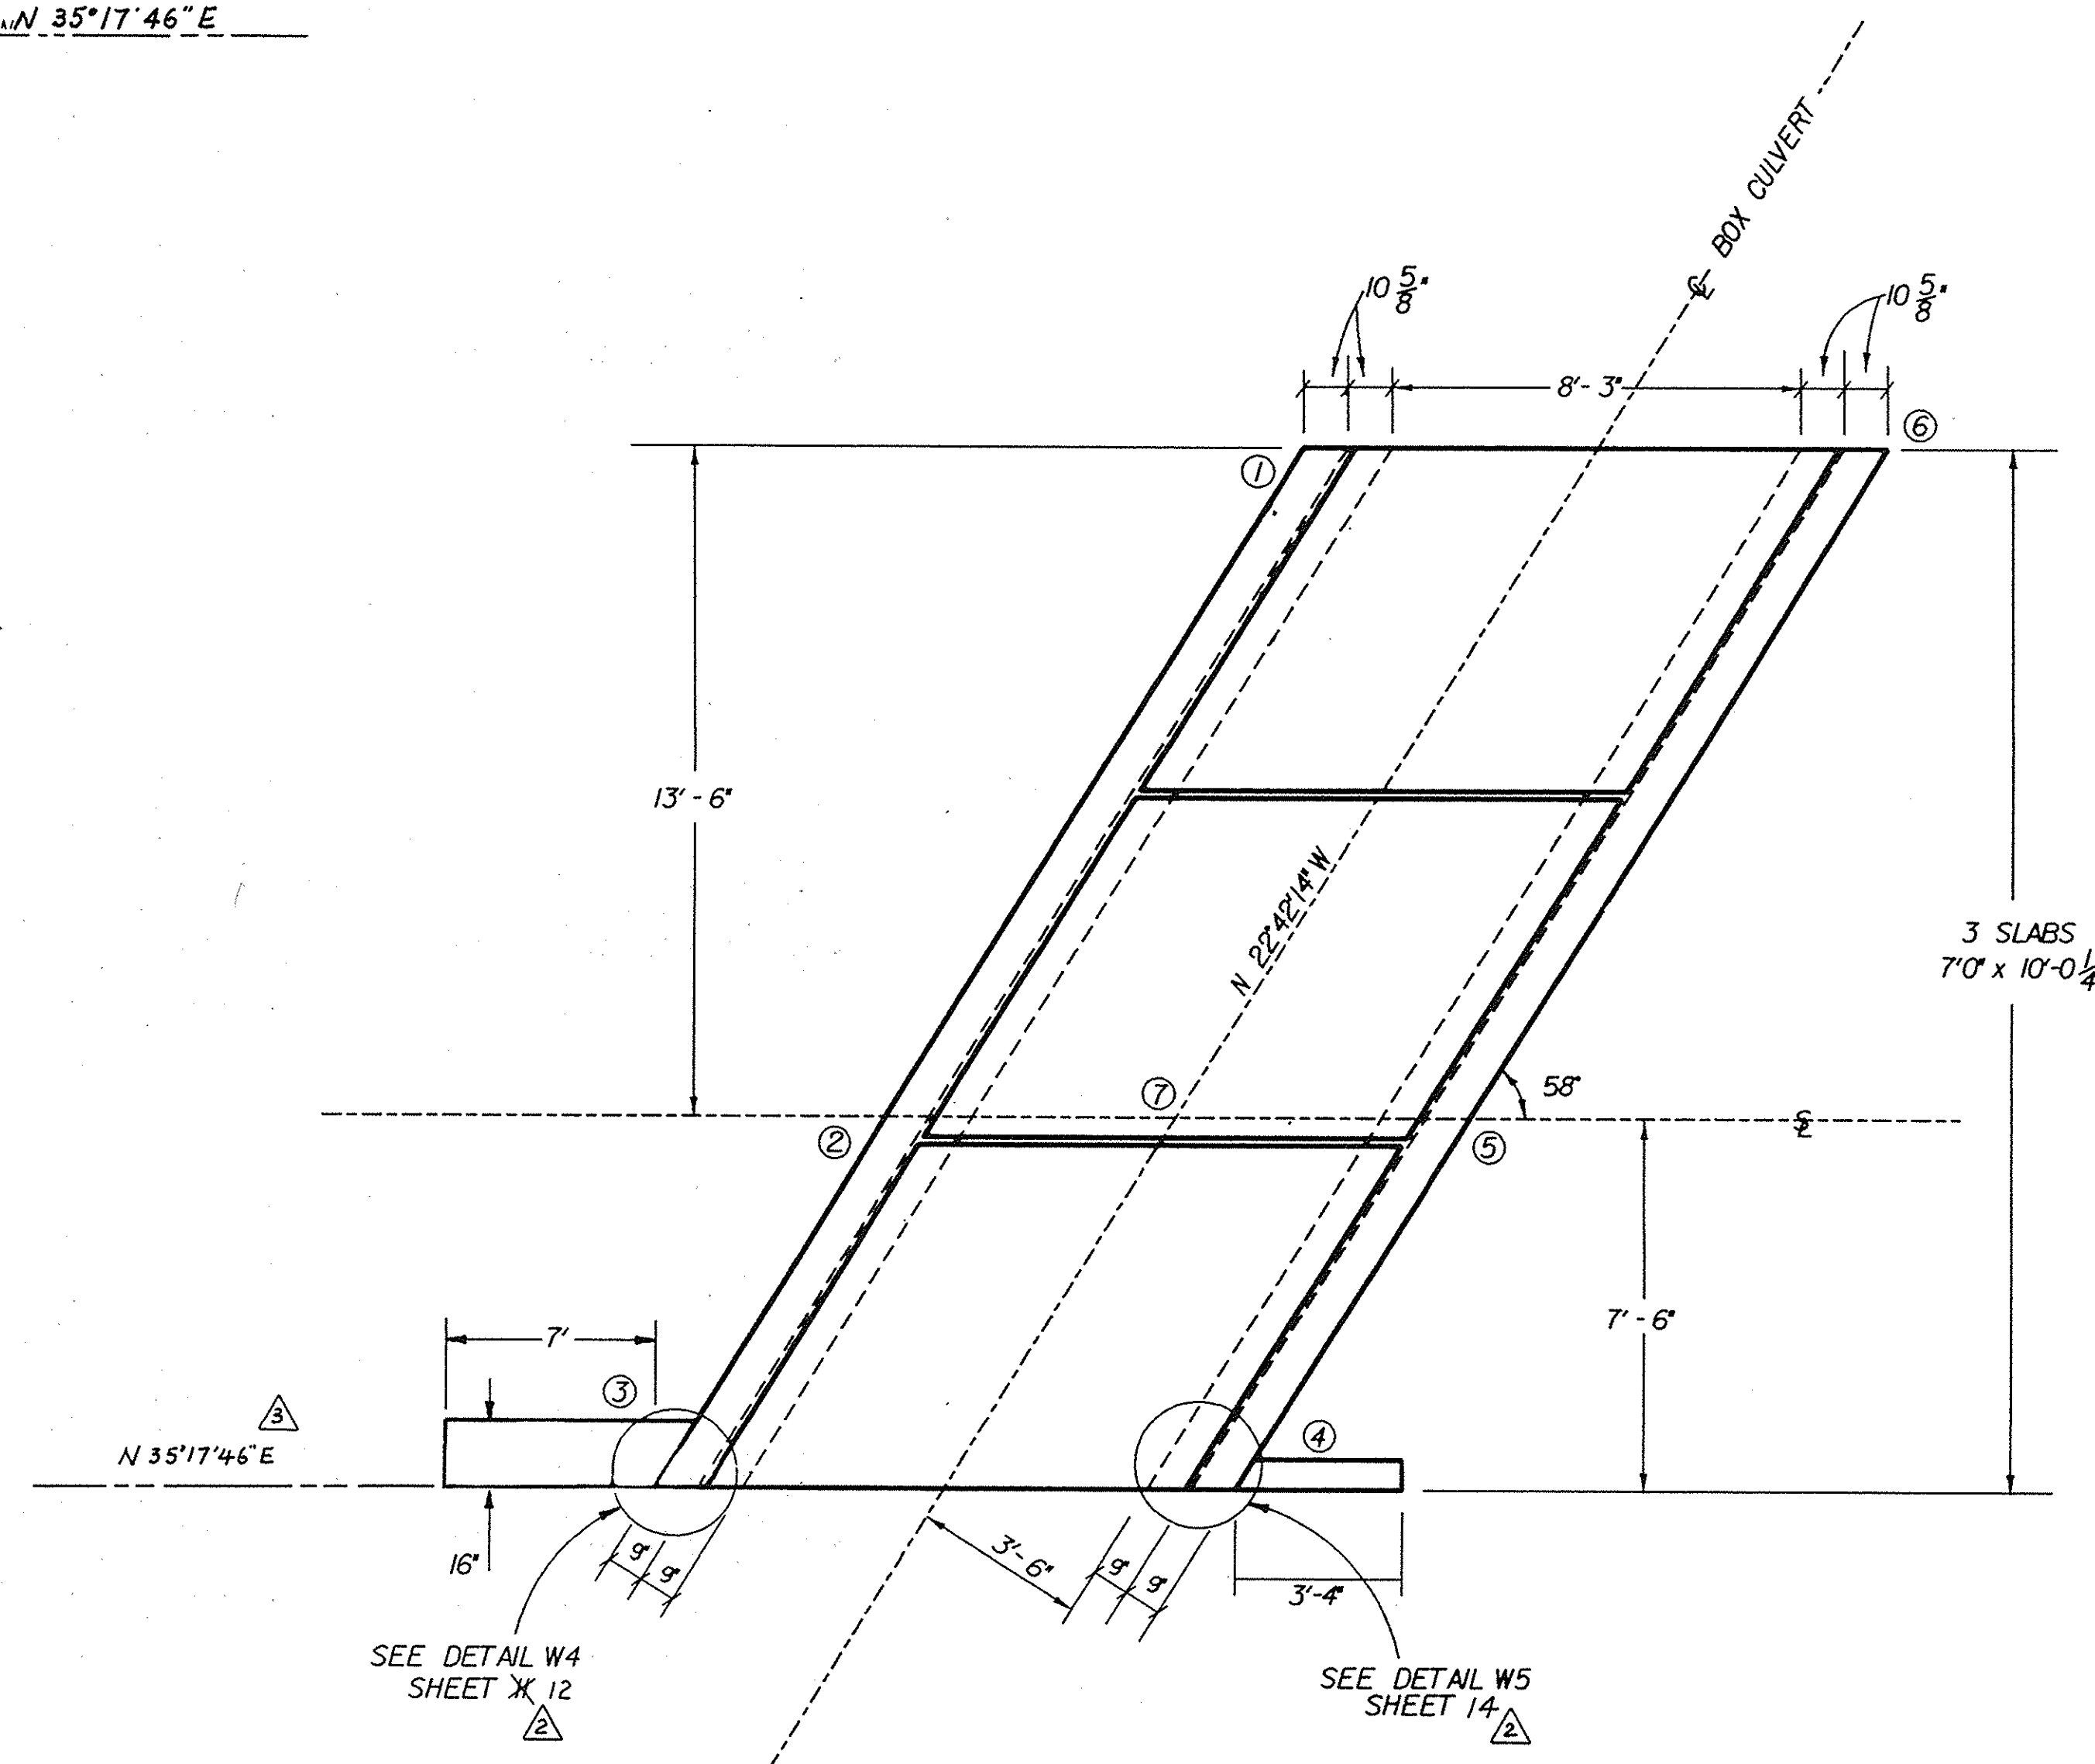

PLAN VIEW - WESTERLY BOX

SCALE 1" = 3'-0"

ORANGE COUNTY ENVIRONMENTAL MANAGEMENT AGENCY	
SILVERADO CANYON ROAD	
GENERAL LAYOUT	
3/19/11 Revised Dimensions Shown 3/19/11 Revised Reference Sht. # REVISION PREPARED UNDER SUPERVISION REGISTERED PROFESSIONAL ENGINEER ASHUTOSH MEHTA 23553 Exp. 12-31-13 CIVIL STATE OF CALIFORNIA	DESIGNED B. MCKINNEY CHECKED B. MCKINNEY SCALE AS SHOWN DATE DRAWING NO. SHEET 6 OF 15