

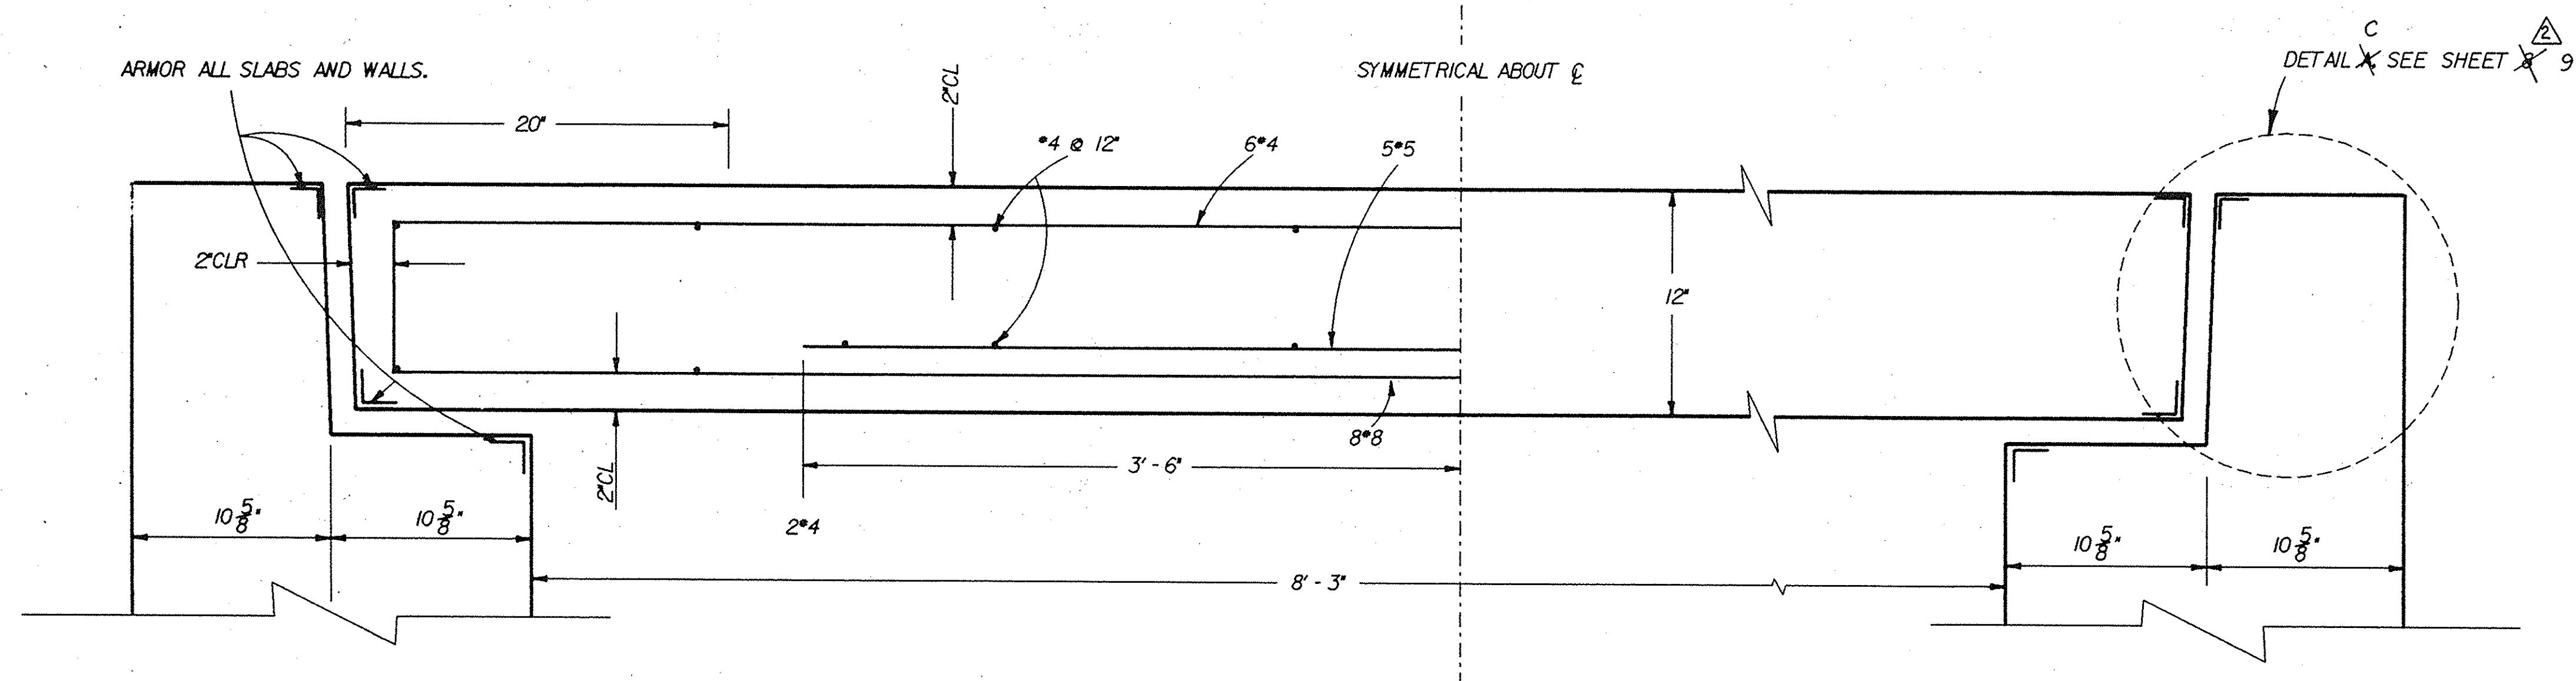


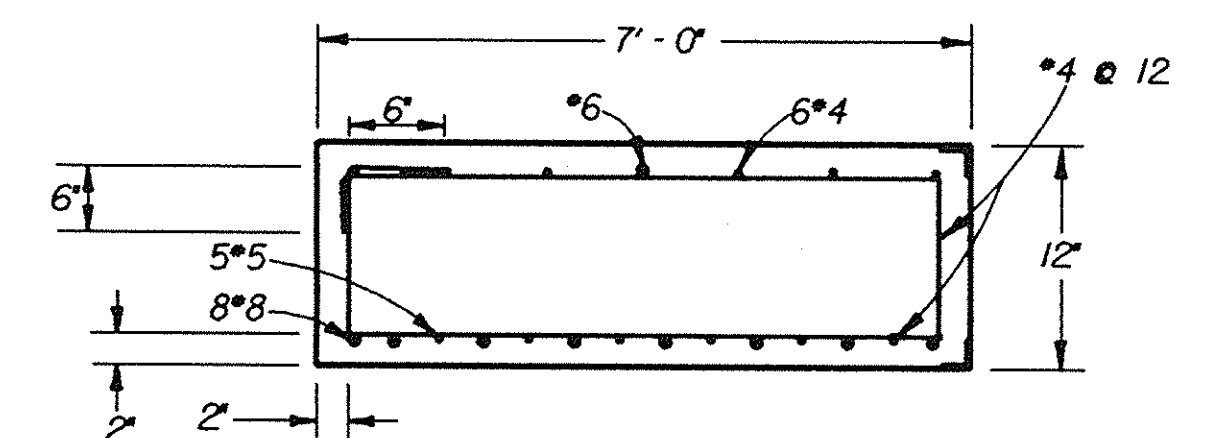


TYPICAL TOP SLAB REINFORCEMENT & DETAILS
SCALE 2" = 1' (SKEWED = 58°)

TYPICAL TOP REINFORCEMENT & DIMENSIONS
SCALE HOR. 1"=2' ; VER. 1"=1'

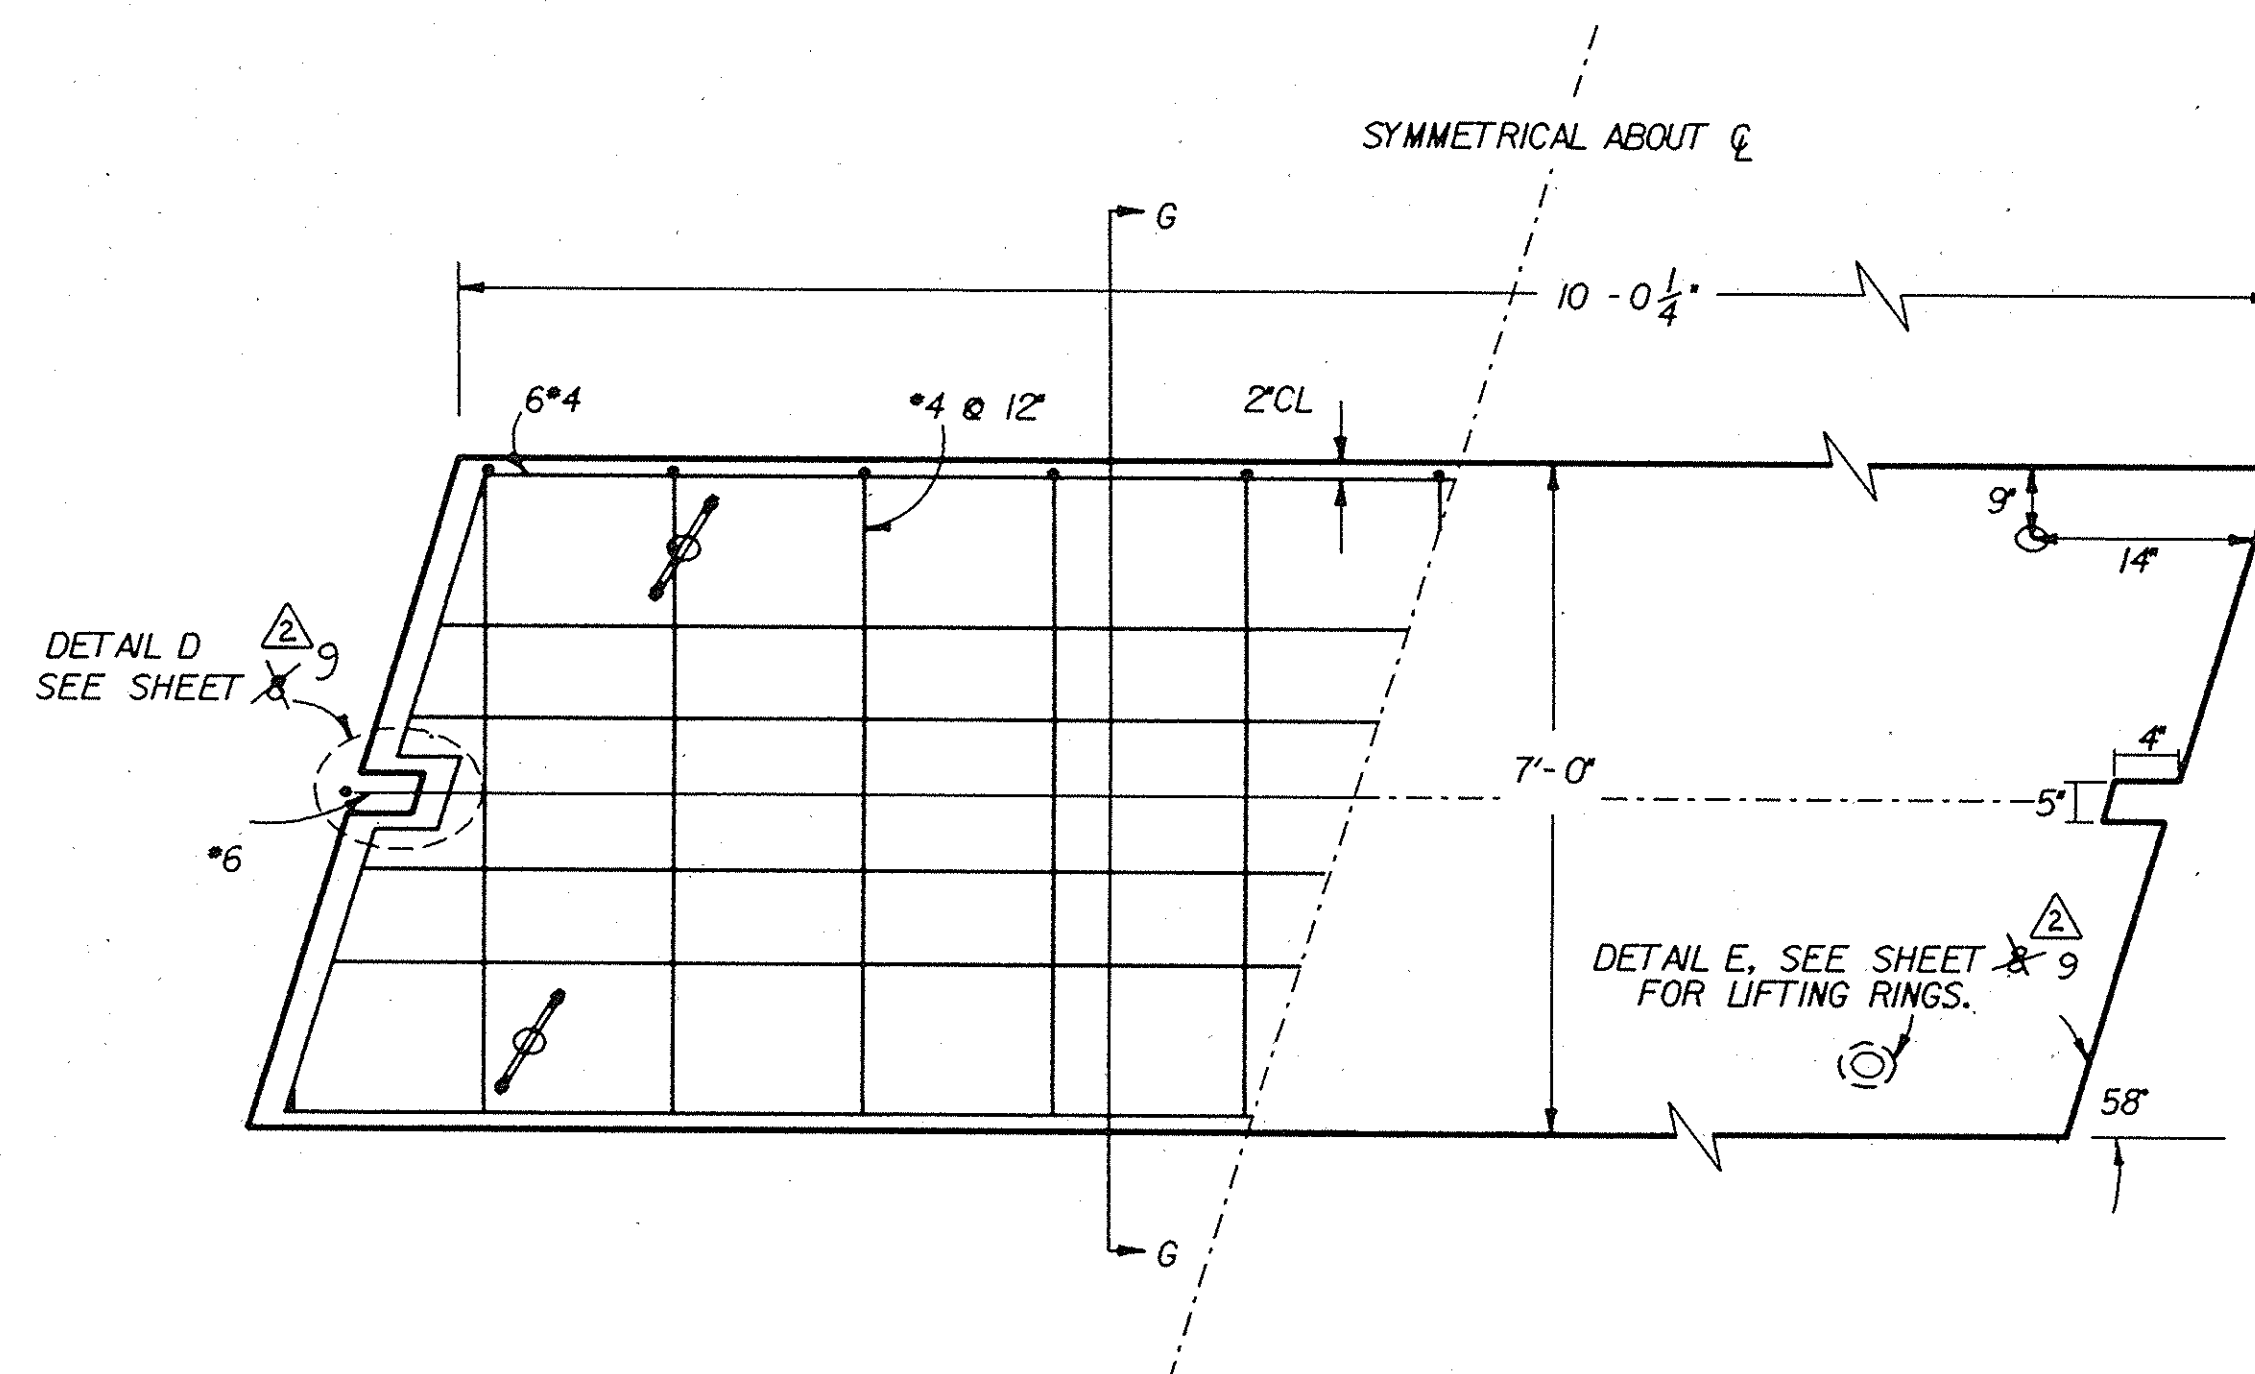

SECTION G - G NO SCALE

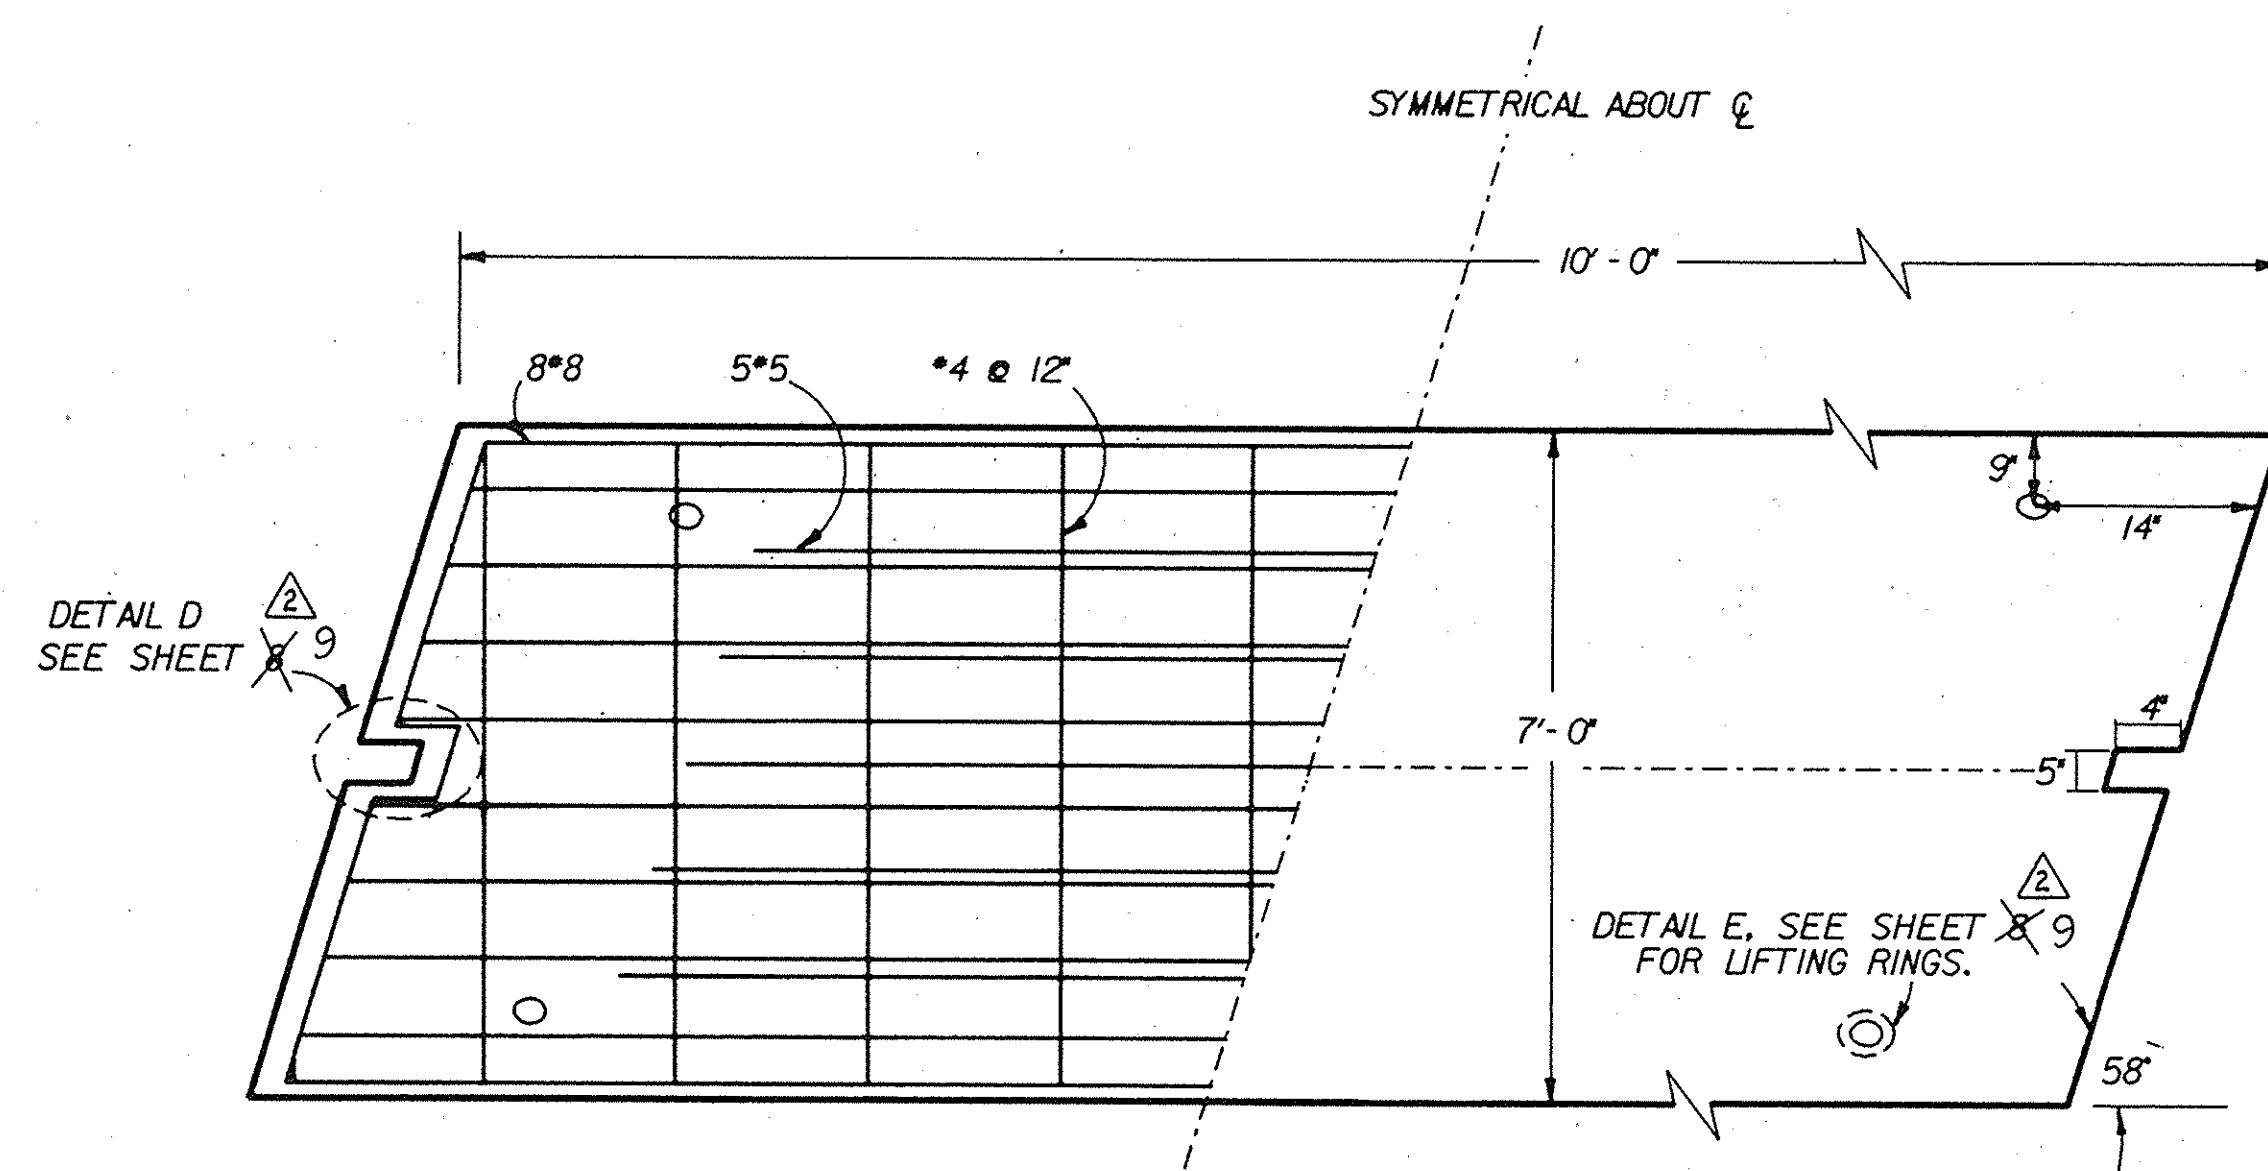

TYPICAL BOTTOM REINFORCEMENT & DIMENSIONS
SCALE HOR. 1"=2' ; VER. 1"=1'

		ORANGE COUNTY ENVIRONMENTAL MANAGEMENT AGENCY	
		SILVERADO CANYON ROAD	
		TOP SLAB REINFORCEMENT & DIMENSIONS	
		WESTERLY BOX	
3/11/11	Revised Reference Sht. #		
DATE	DESCRIPTION		
REVISION			
PREPARED UNDER SUPERVISION			
REGISTERED PROFESSIONAL ENGINEER			
ASHUTOSH MEHTA			
Exp. 12-31-19			
23553			
CIVIL ENGINEER			
STATE OF CALIFORNIA			
SCALE	DATE	CHECKED BY	SHEET
AS SHOWN			8
DRAWING NO.		OF 15	