




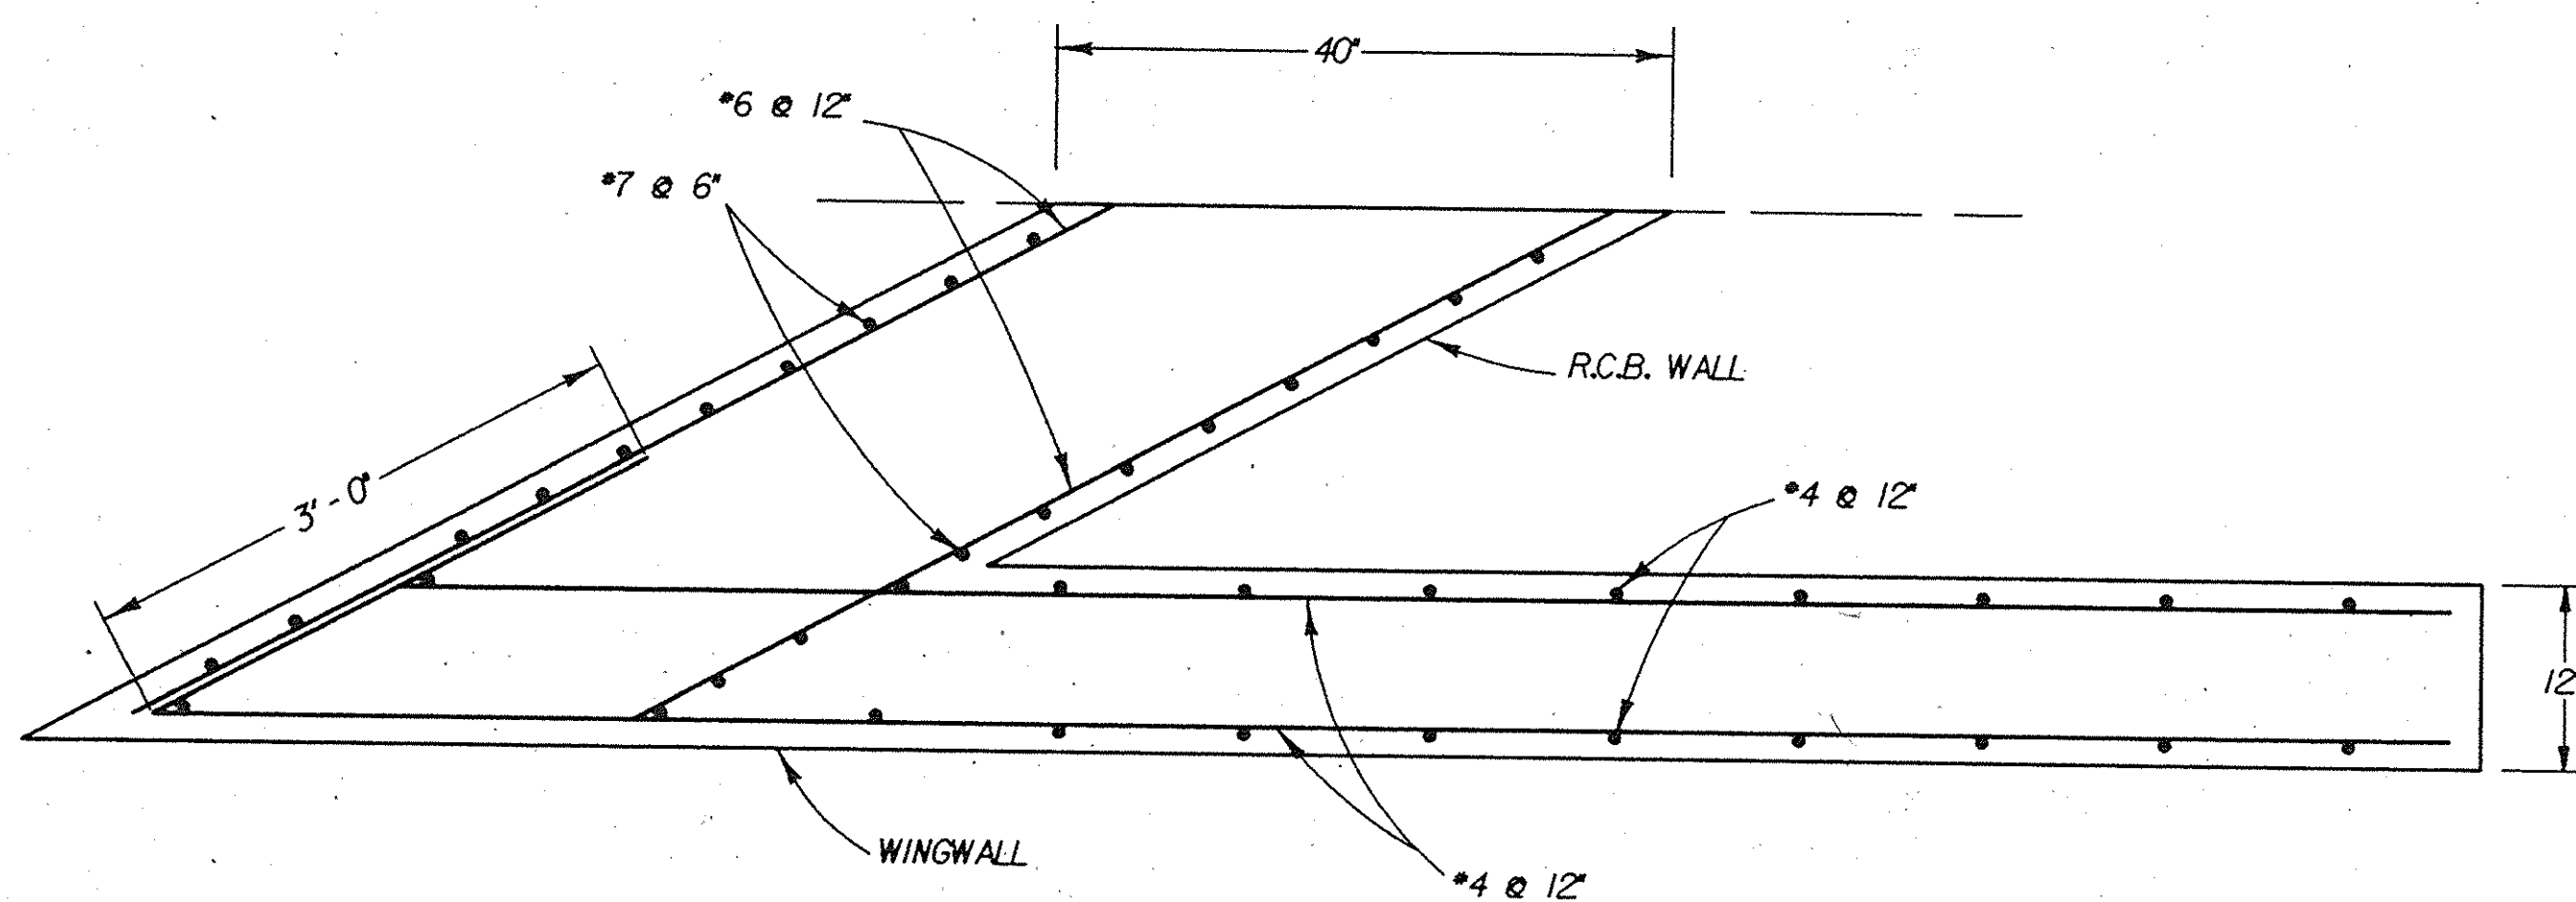


CONNECTION DETAIL W3 - EASTERLY BOX
SCALE 1" = 1'

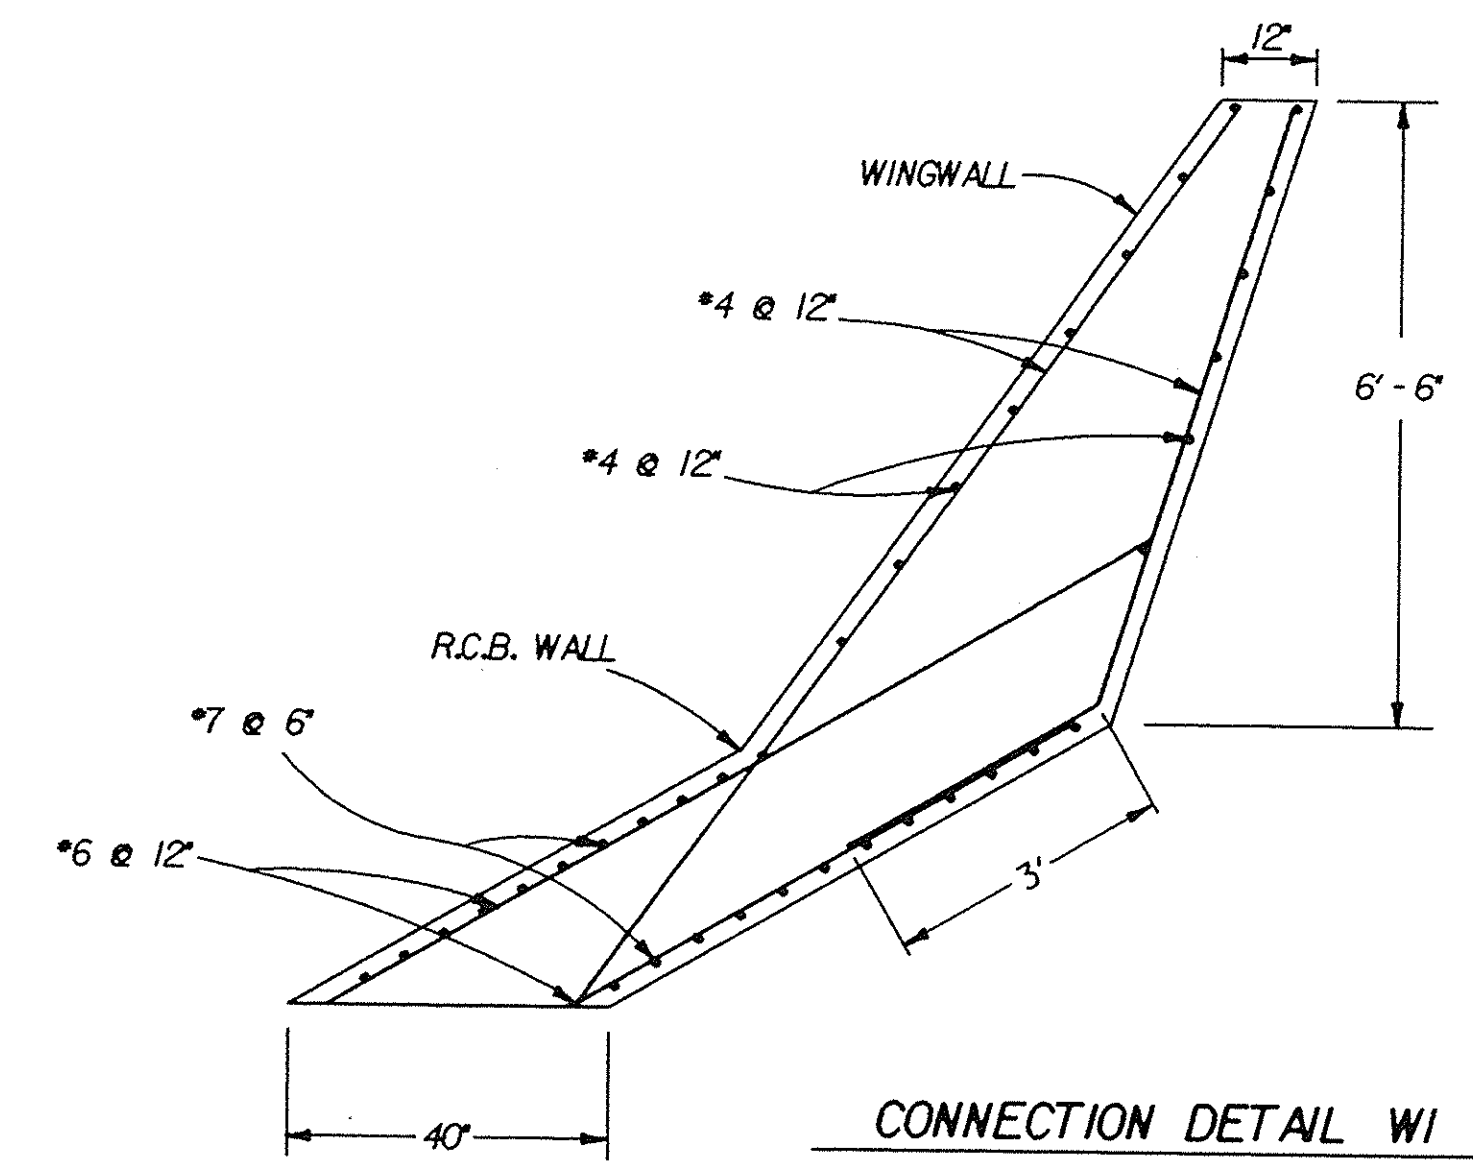

CONNECTION DETAIL W1
SCALE 1" = 2'-0" EASTERLY BOX

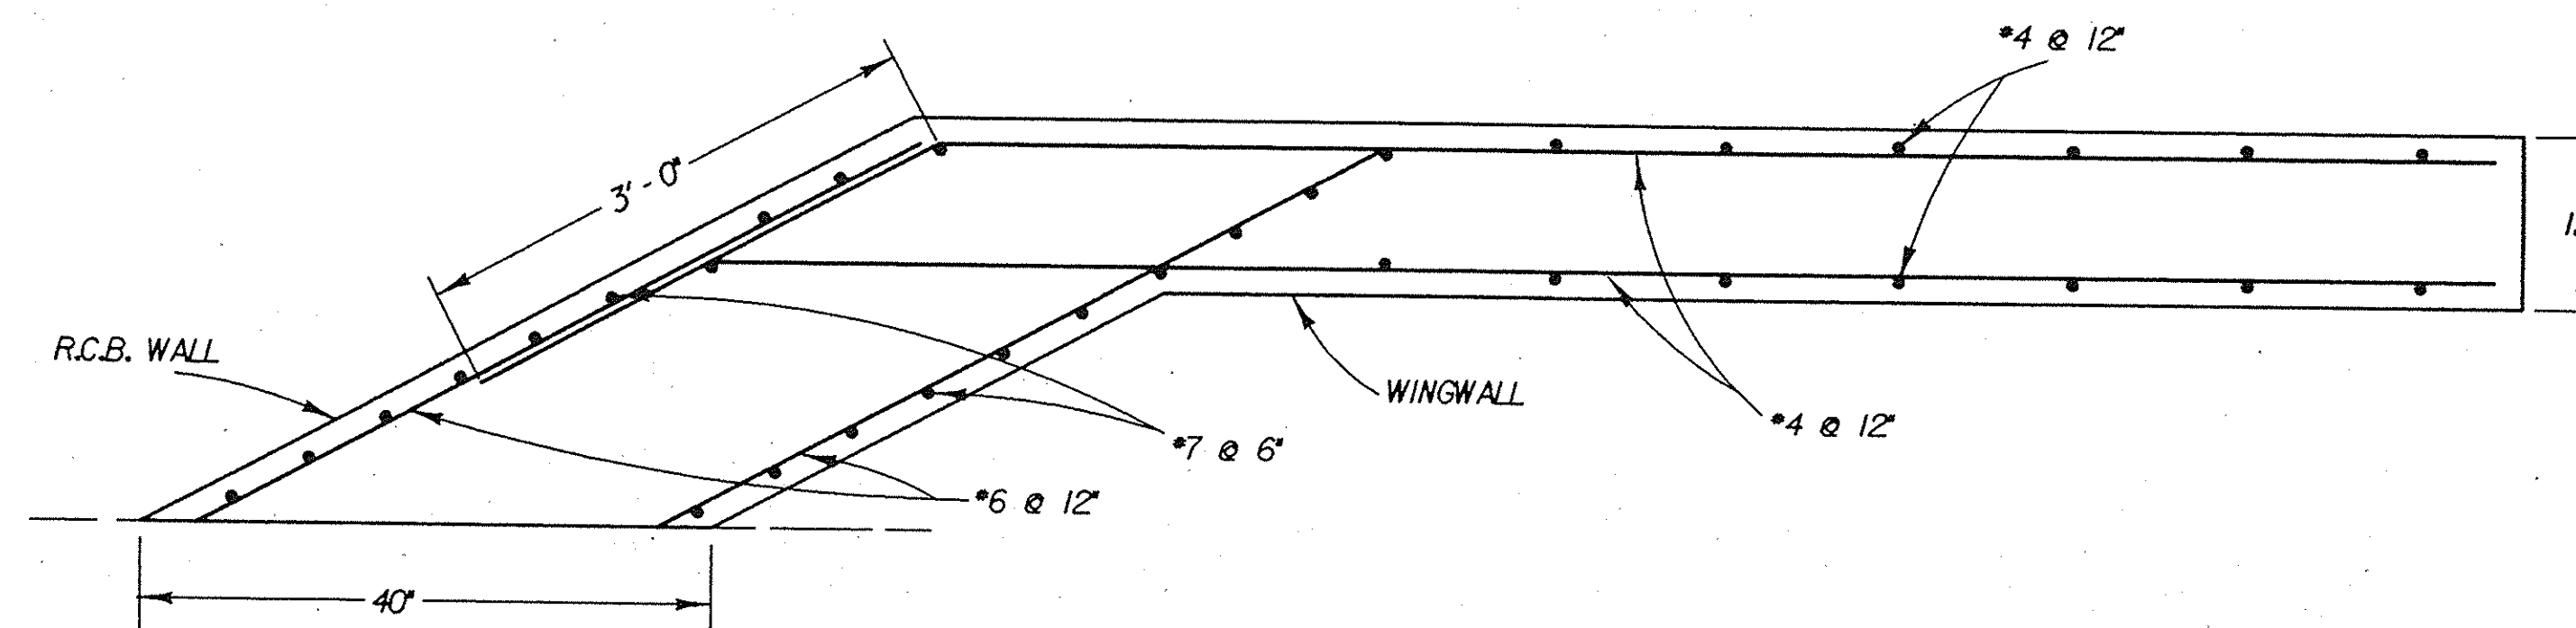

CONNECTION DETAIL W2 - EASTERLY BOX
SCALE 1" = 1'

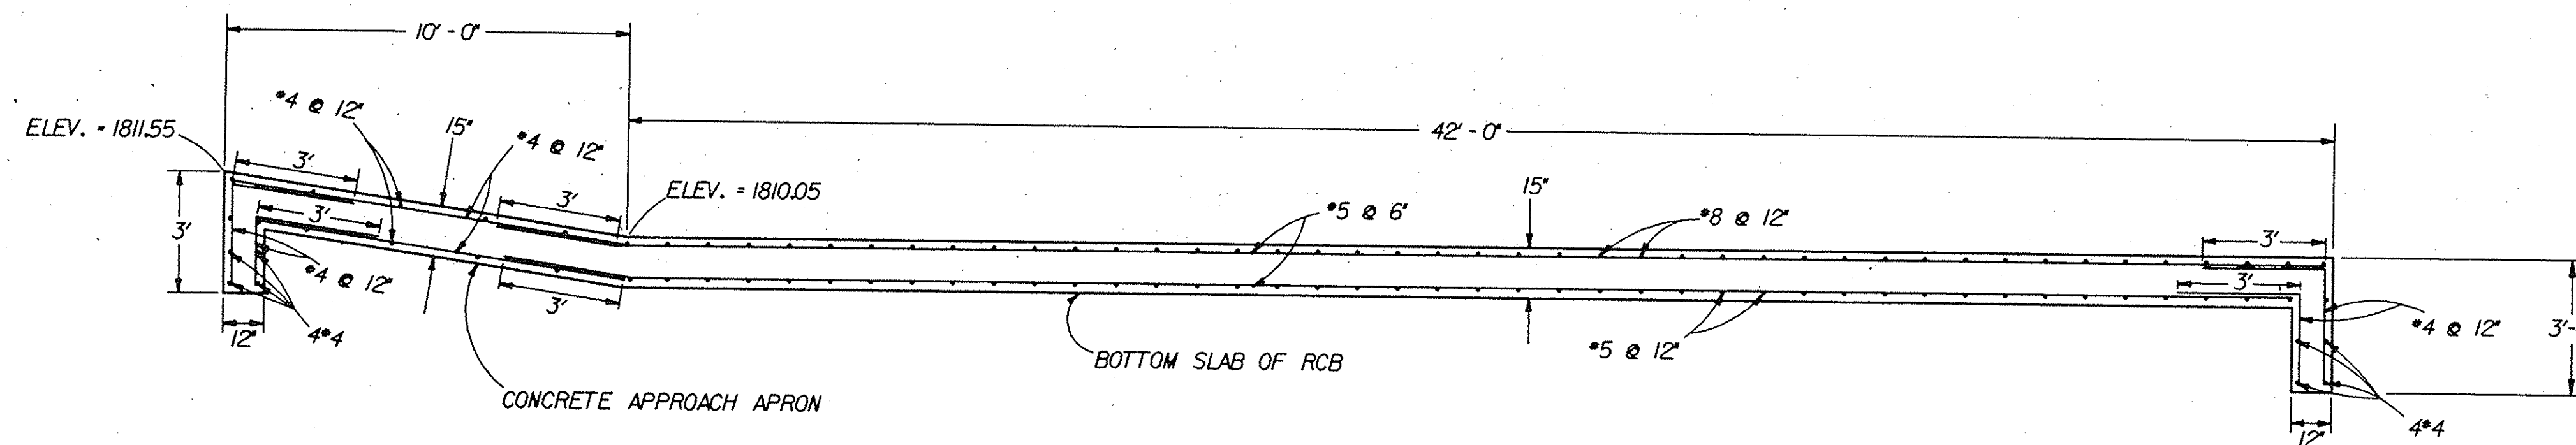

CONNECTION DETAIL - CONCRETE APPROACH SLAB
SCALE 1" = 3'

ORANGE COUNTY ENVIRONMENTAL MANAGEMENT AGENCY		SILVERADO CANYON ROAD	
EASTERLY BOX CONNECTION DETAILS		SHEET 10 OF 15	
DATE	DESCRIPTION	REVISION	CHECKED BY
PREPARED UNDER SUPERVISION	REGISTERED PROFESSIONAL ENGINEER ASHUTOSH MEHTA 23553 Exp. 12-31-98 STATE OF CALIFORNIA	CHECKED BY	CHECKED BY
SCALE	DATE	DRAWING NO.	
AS SHOWN			