



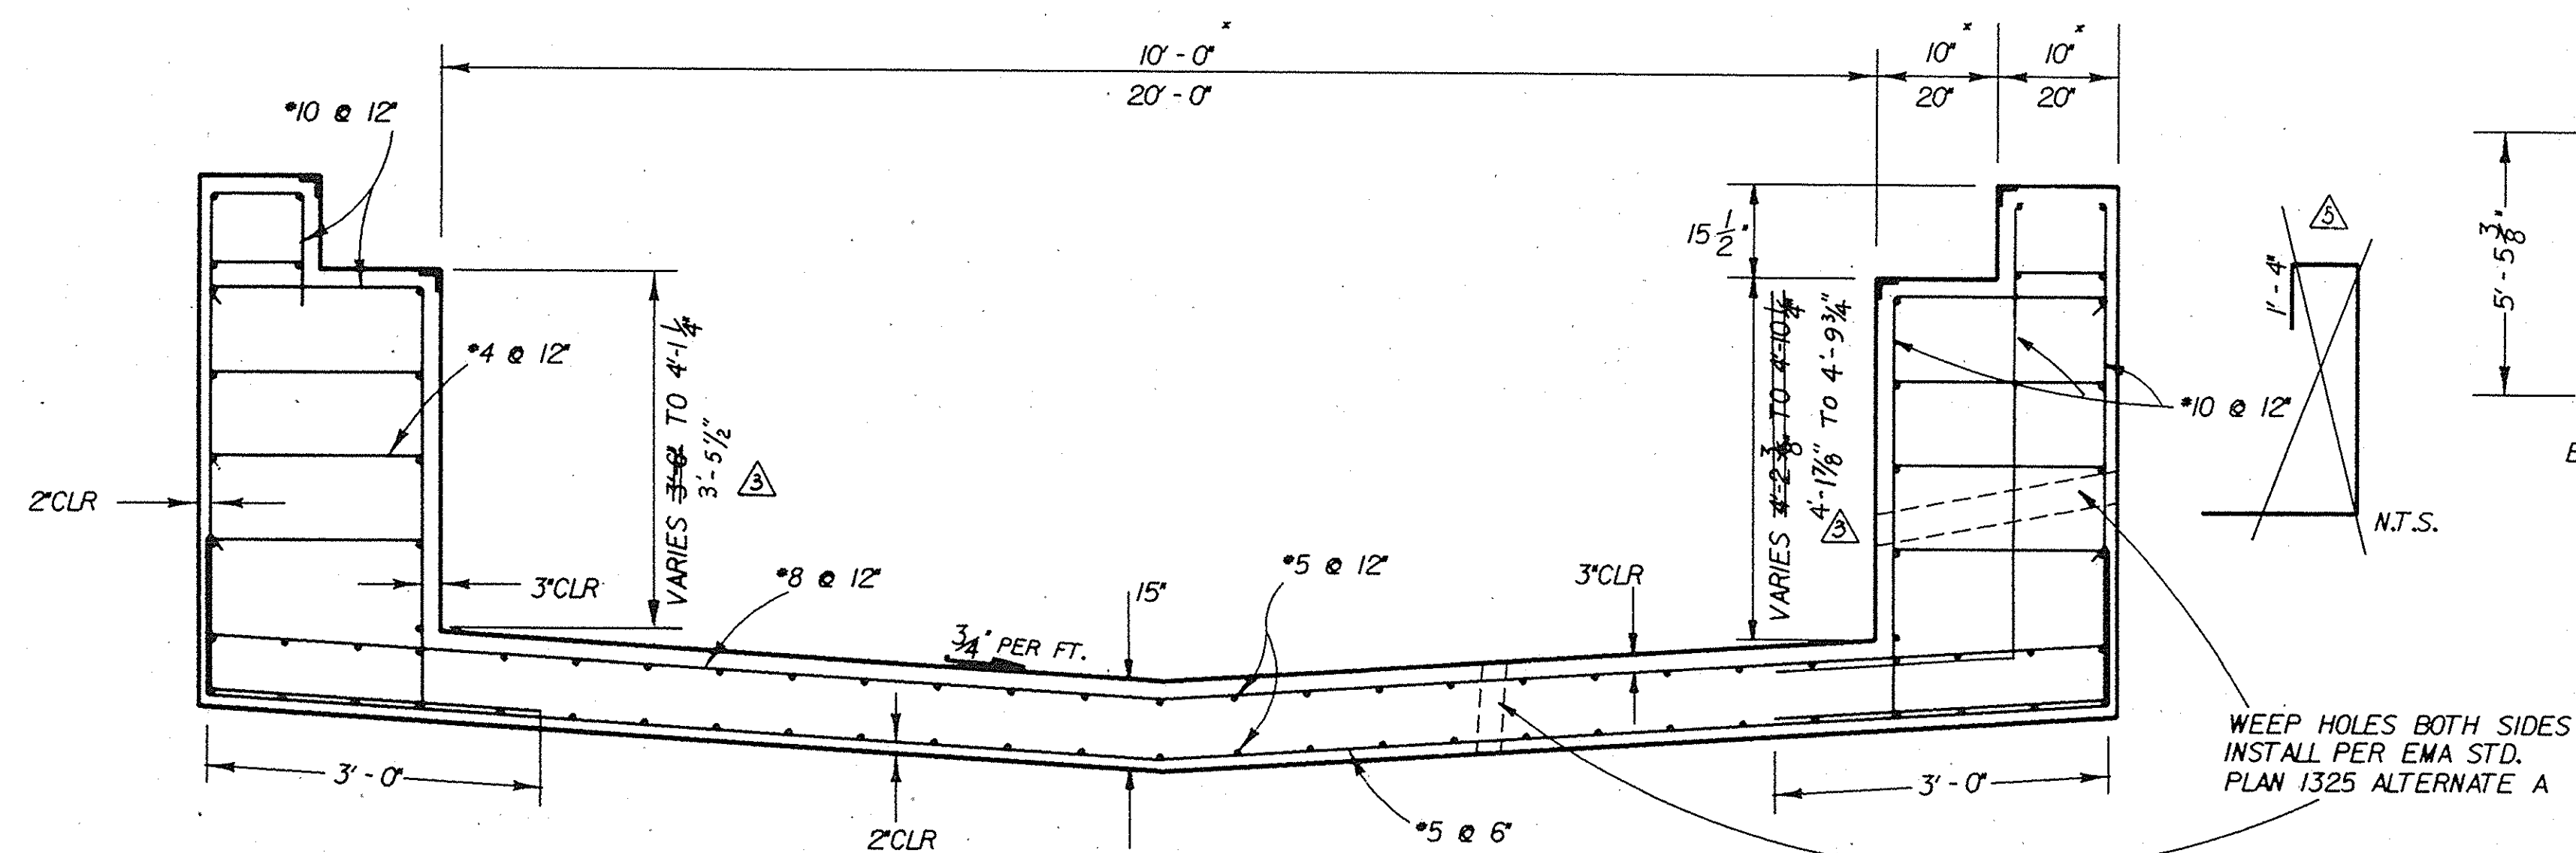


**TYPICAL LONGITUDINAL SECTION
REINFORCEMENT AND DETAILS** EASTERLY BOX


SCALE 1" = 2' NOTE: TOP SLAB NOT SHOWN (SKEWED 30°)

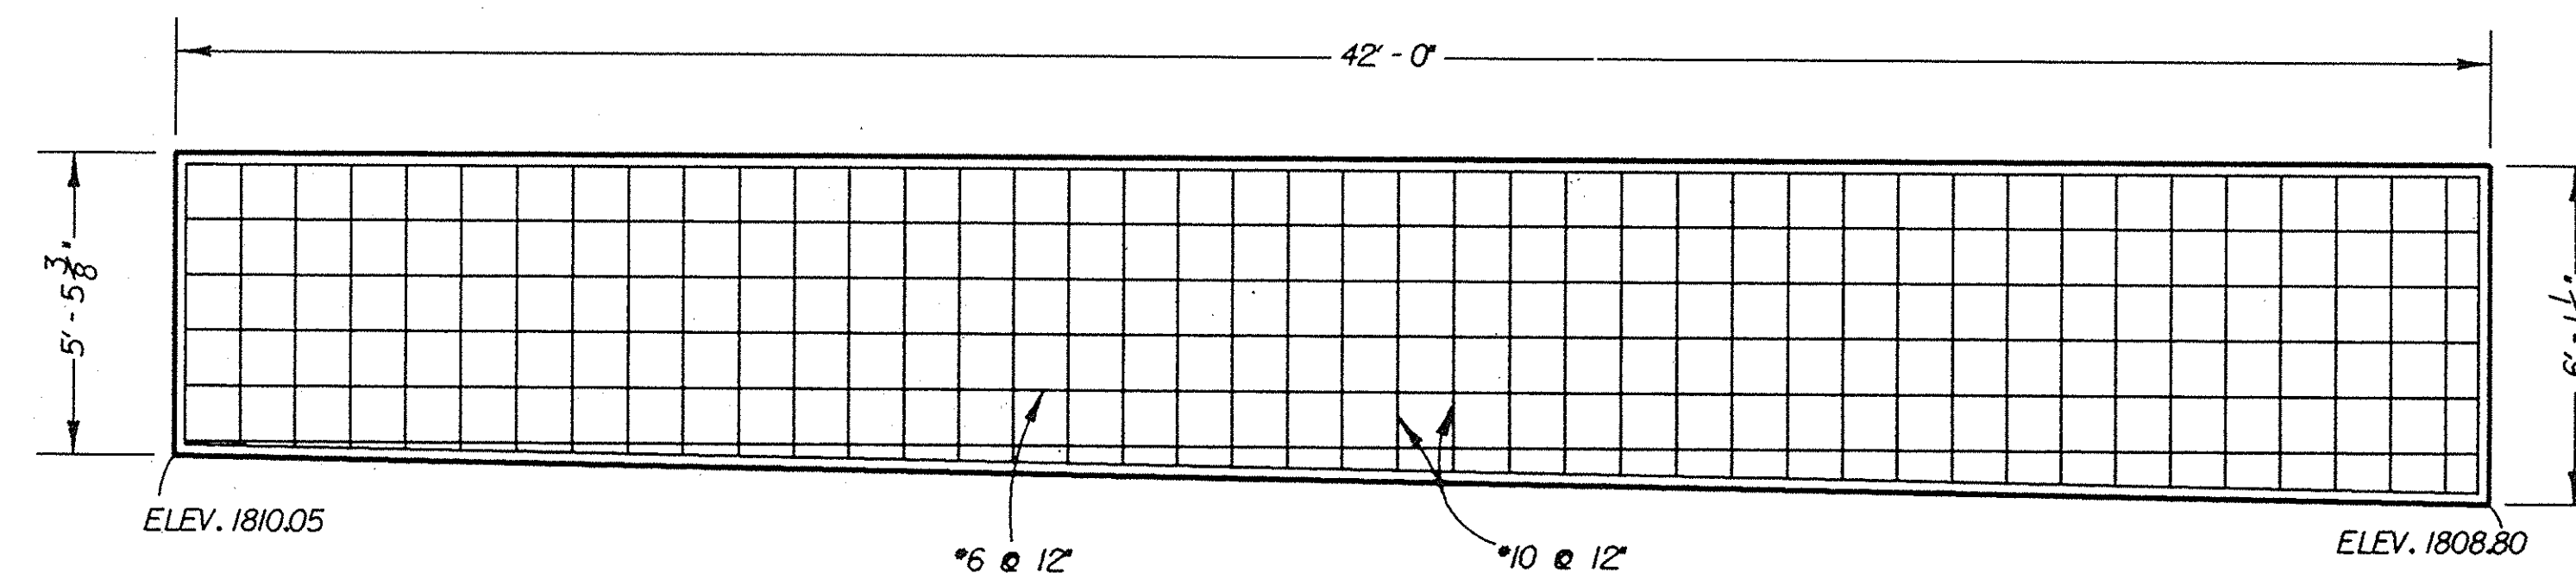

EASTERLY WALL PROFILE - EASTERLY BOX (REINFORCING TYPICAL
SCALE 1" = 3' (FACING EASTERLY) INSIDE & OUTSIDE)

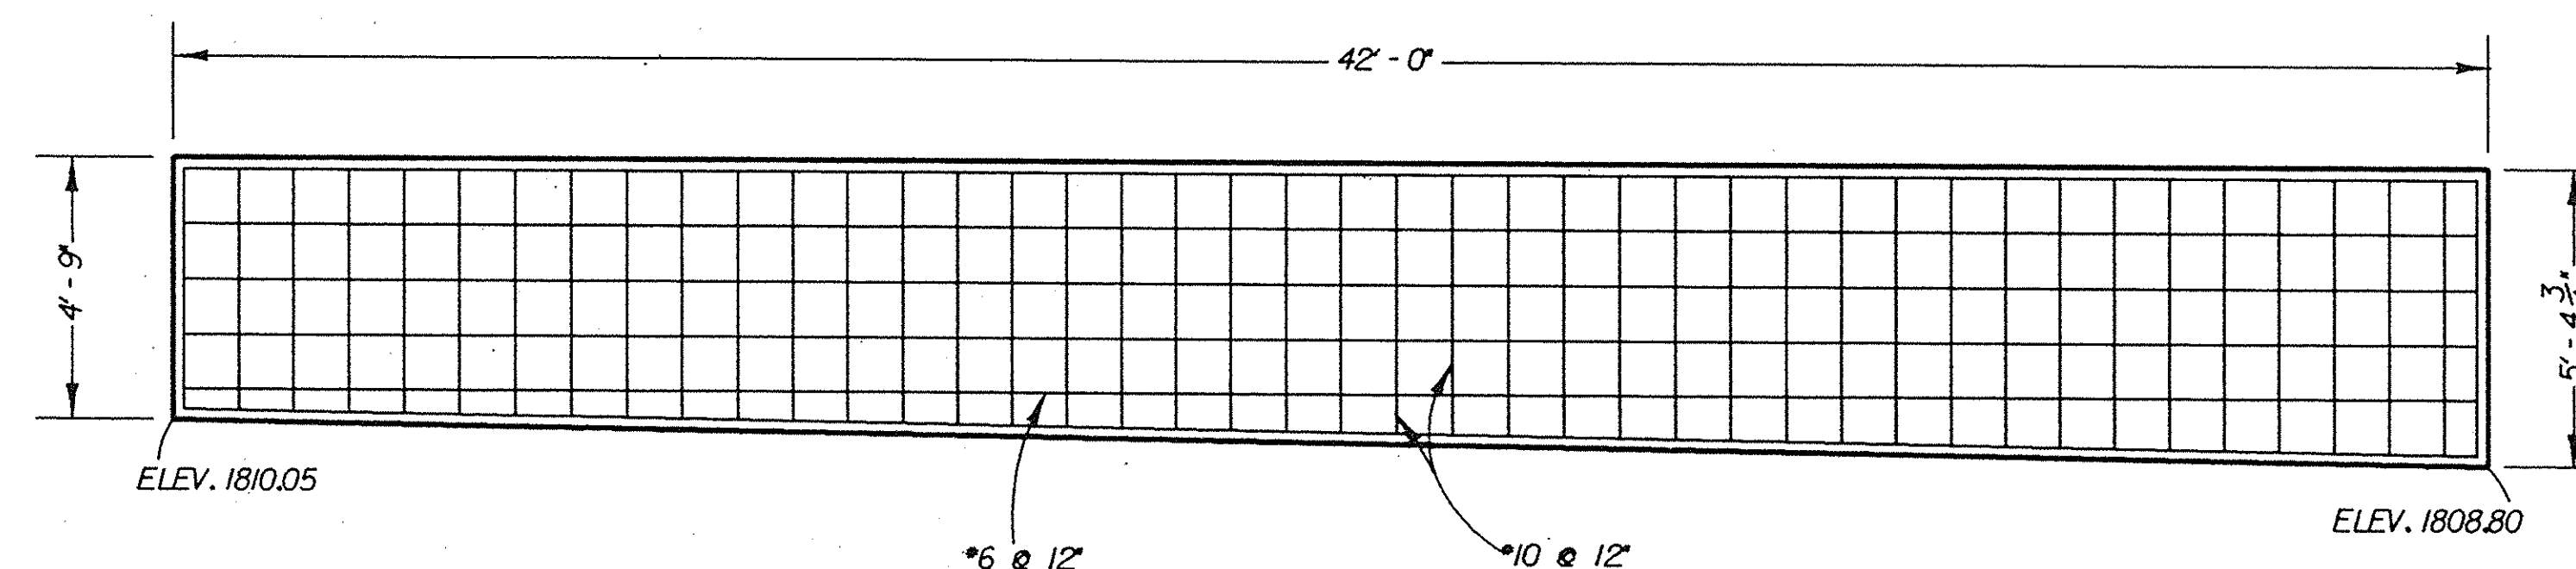

WESTERLY WALL PROFILE - EASTERLY BOX (REINFORCING TYPICAL
SCALE 1" = 3' (FACING EASTERLY) INSIDE & OUTSIDE)

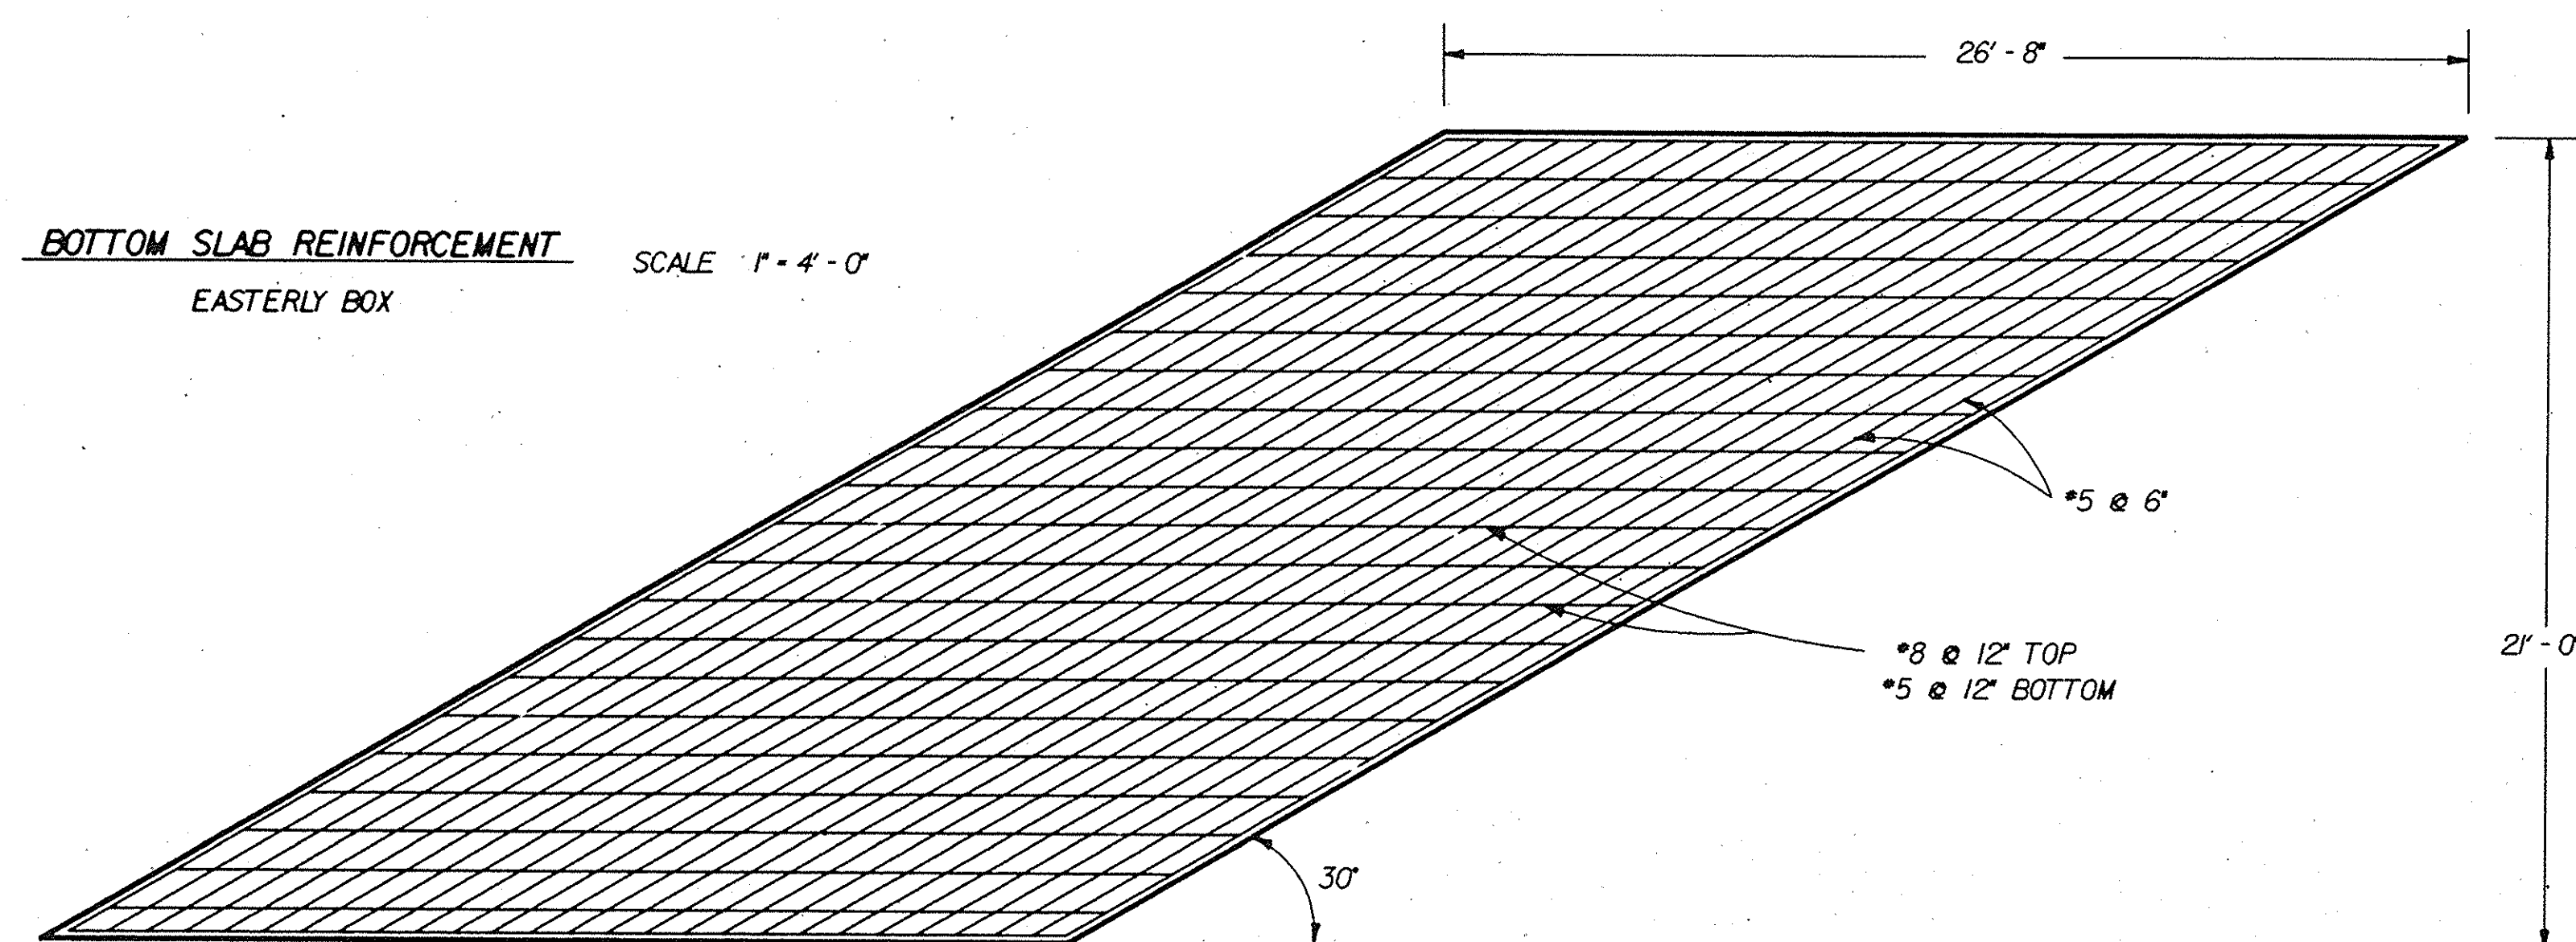

BOTTOM SLAB REINFORCEMENT EASTERLY BOX
SCALE 1" = 4'-0"

ORANGE COUNTY ENVIRONMENTAL MANAGEMENT AGENCY	
SILVERADO CANYON ROAD	
EASTERLY BOX DETAILS	
DESIGNED BY B. MCKINNEY	CHECKED BY BMM
SCALE AS SHOWN	DRAWING NO. 11
SHEET OF 15	

NO.	DATE	DESCRIPTION
1	3/19/11	Revised #10 @ 12 As Shown
2	3/14/11	Revised Dimensions As Shown

REGISTERED PROFESSIONAL ENGINEER
ASHUTOSH MENTA
23553
EXP. 12-31-13
CIVIL
STATE OF CALIFORNIA