



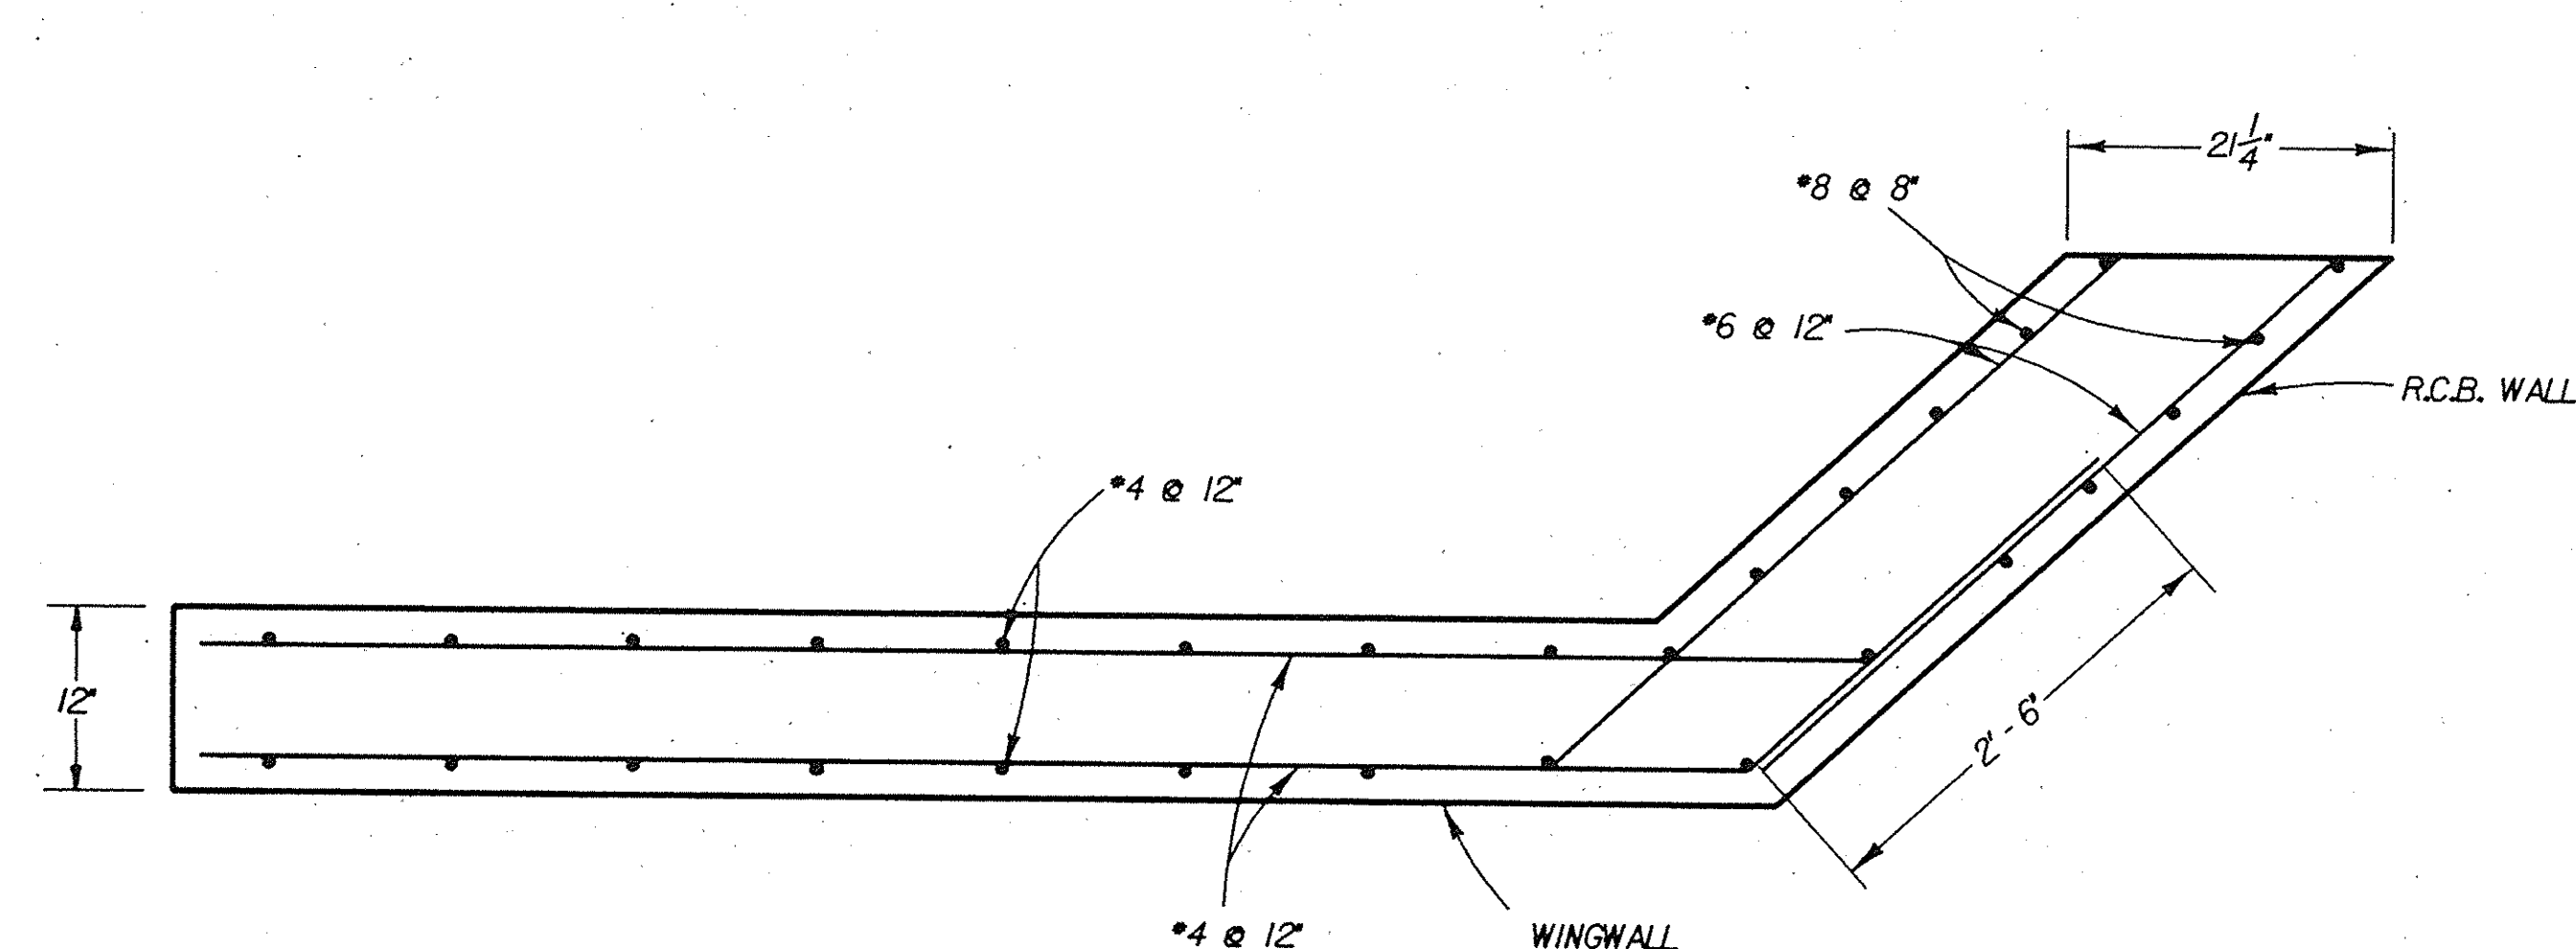

CONNECTION DETAIL W4 - WESTERLY BOX


SCALE 1" = 1'

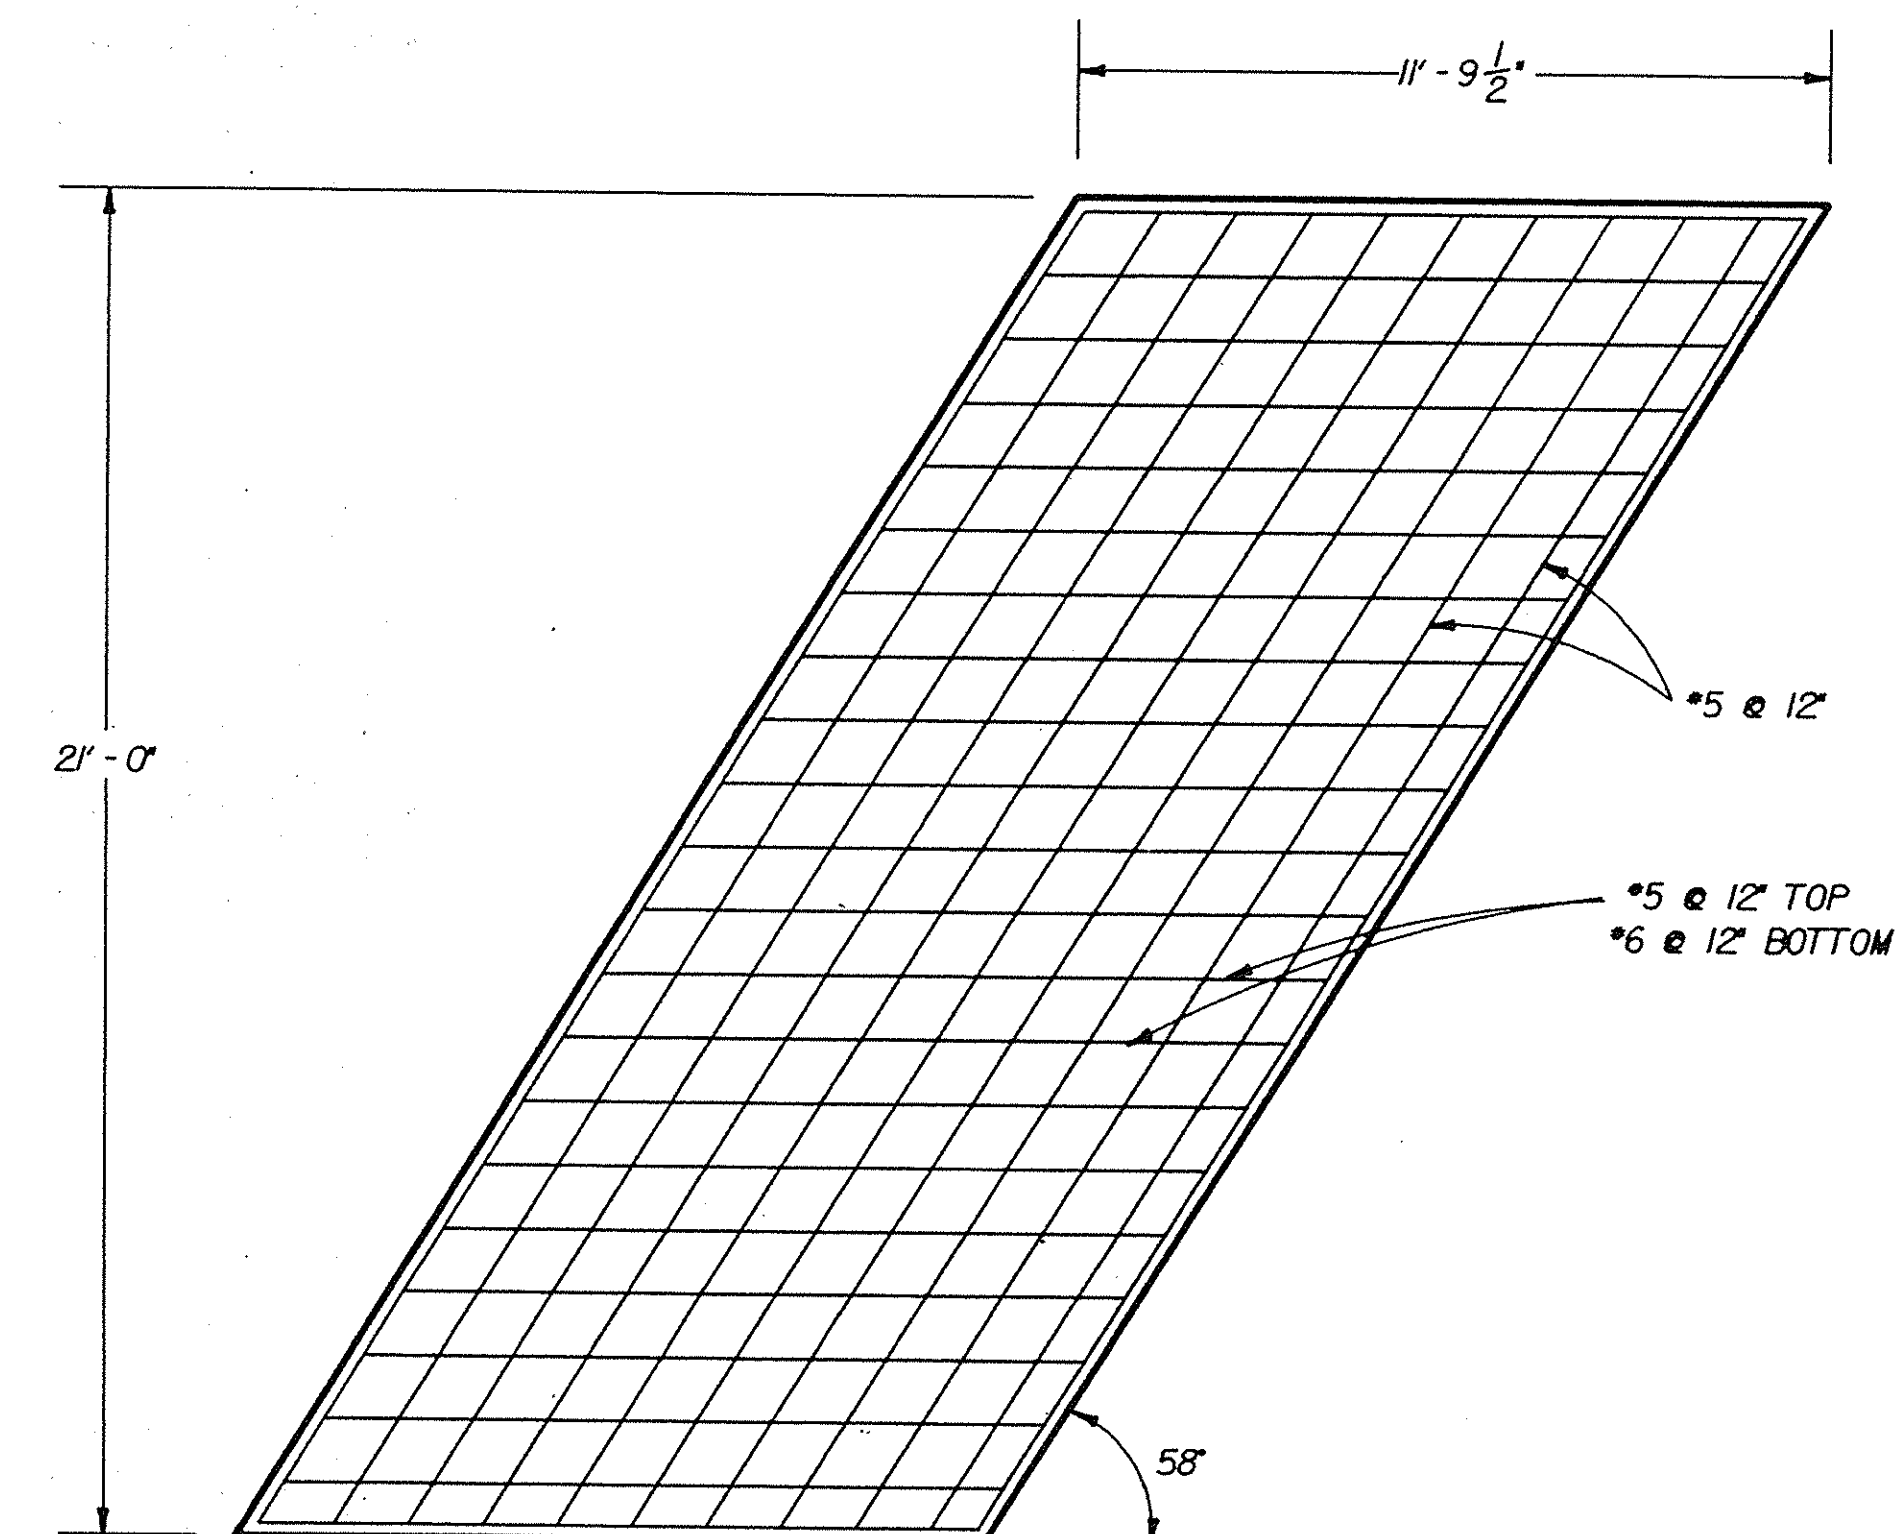

BOTTOM SLAB REINFORCEMENT

WESTERLY BOX


SCALE 1" = 3'-0"

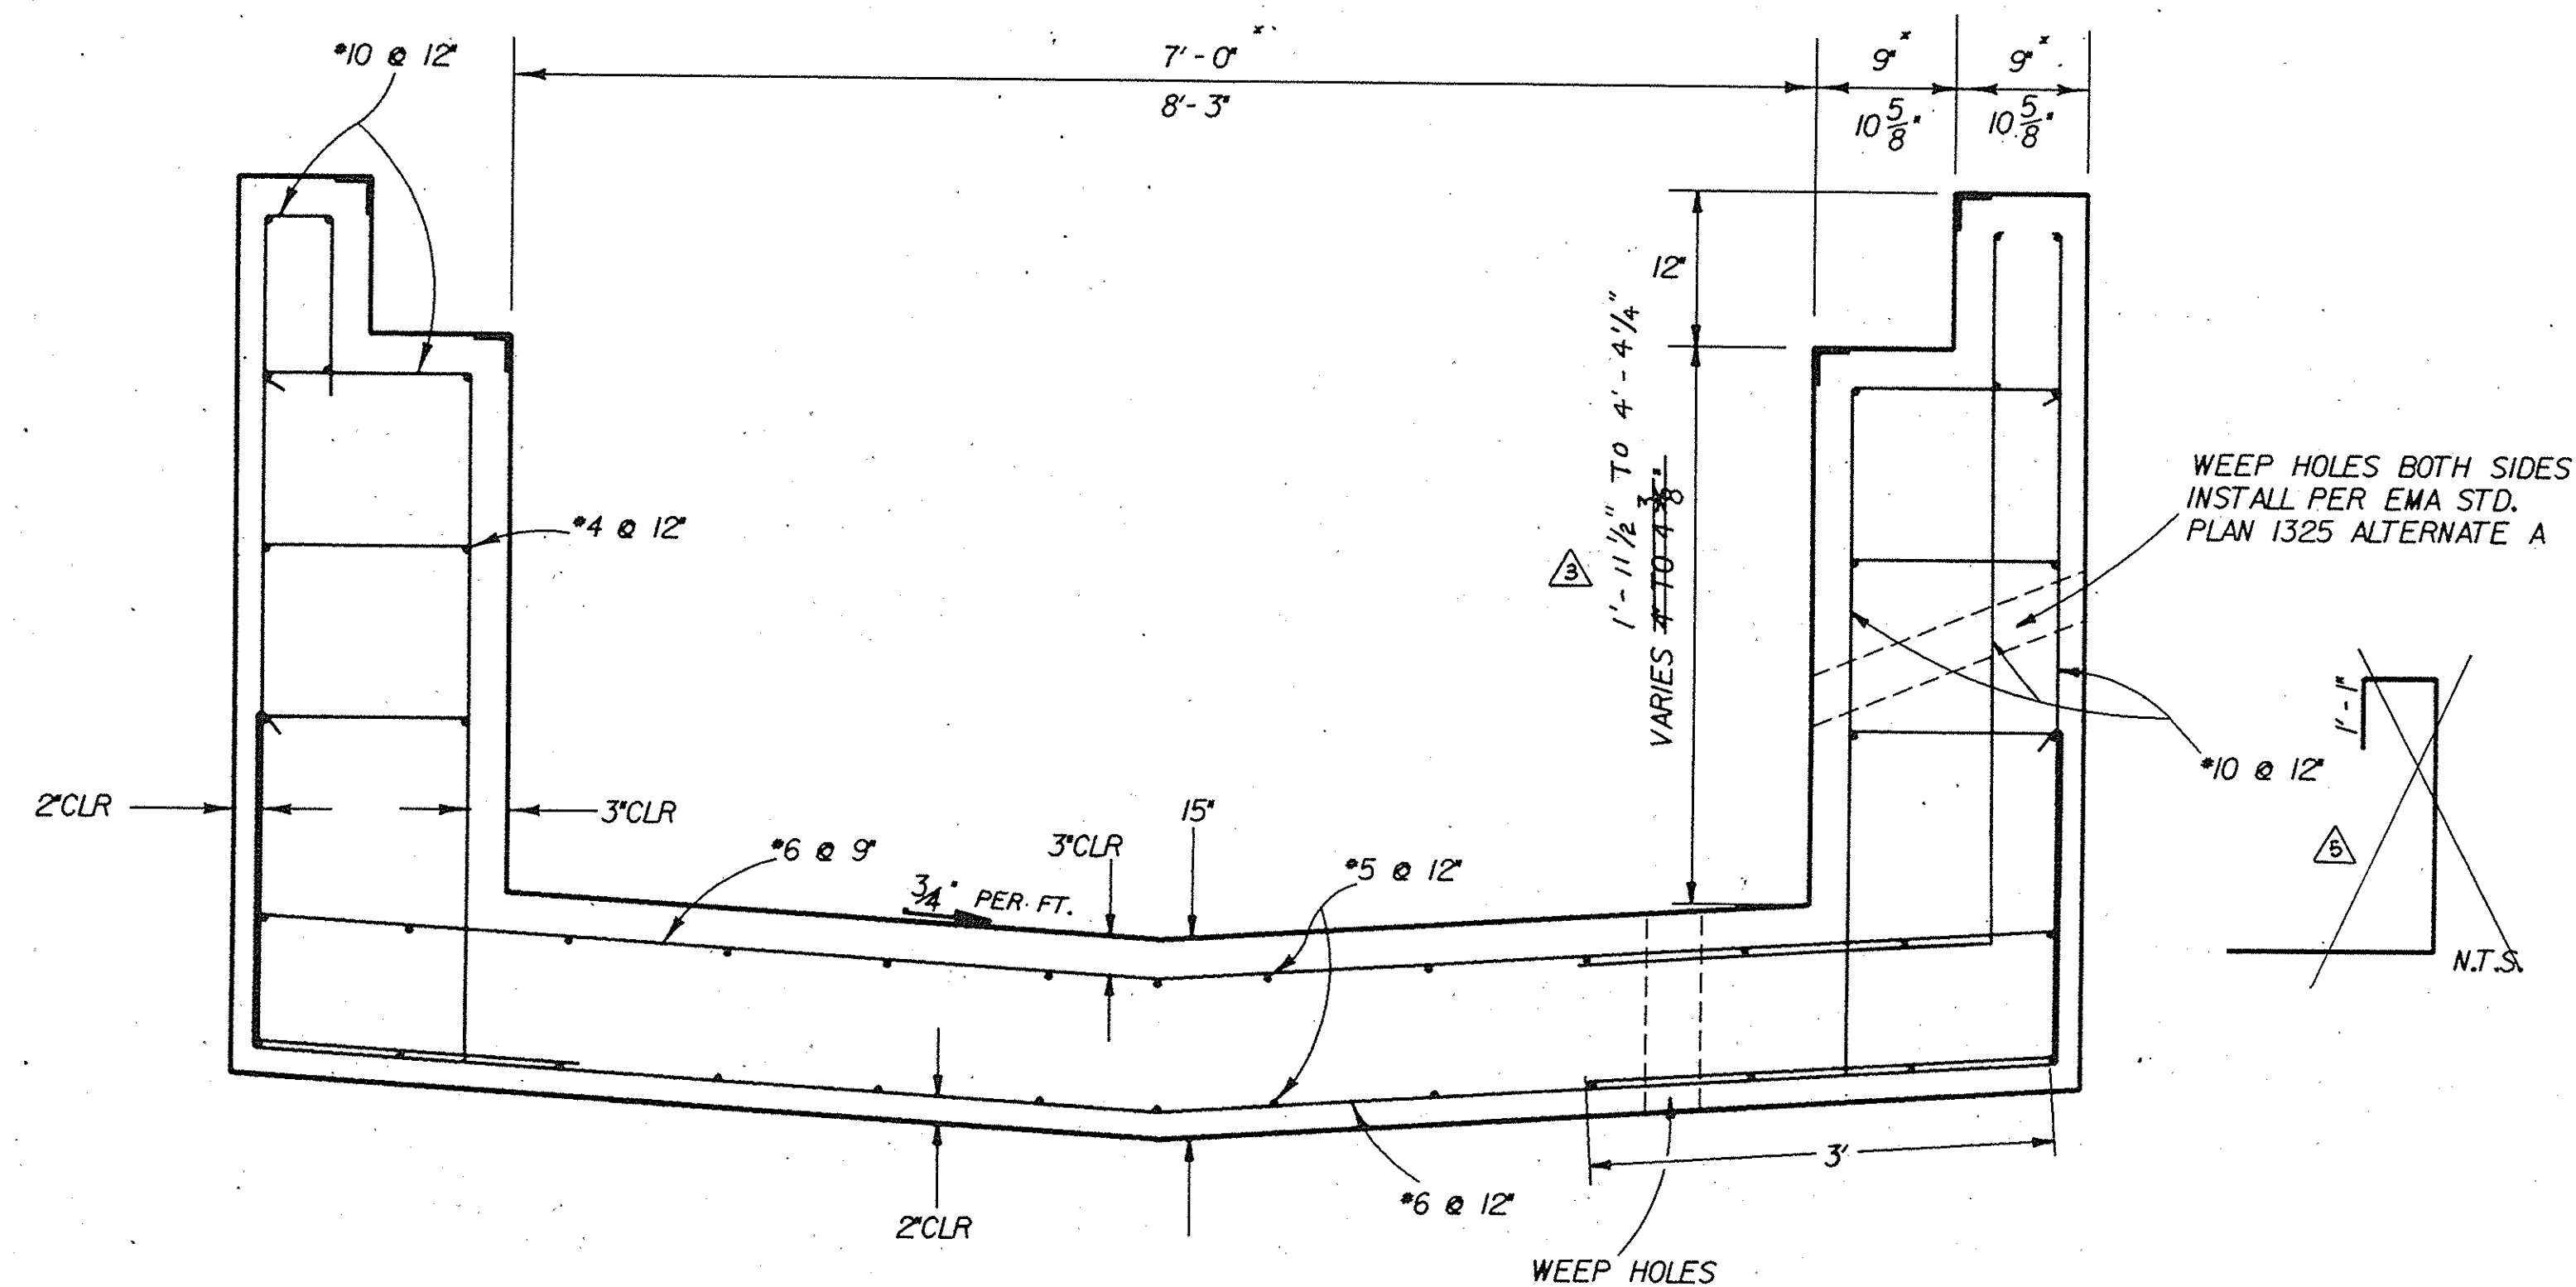

TYPICAL LONGITUDINAL SECTION
REINFORCEMENT AND DIMENSIONS

WESTERLY BOX

SCALE 1" = 1' NOTE: TOP SLAB NOT SHOWN (SKEWED 58°)

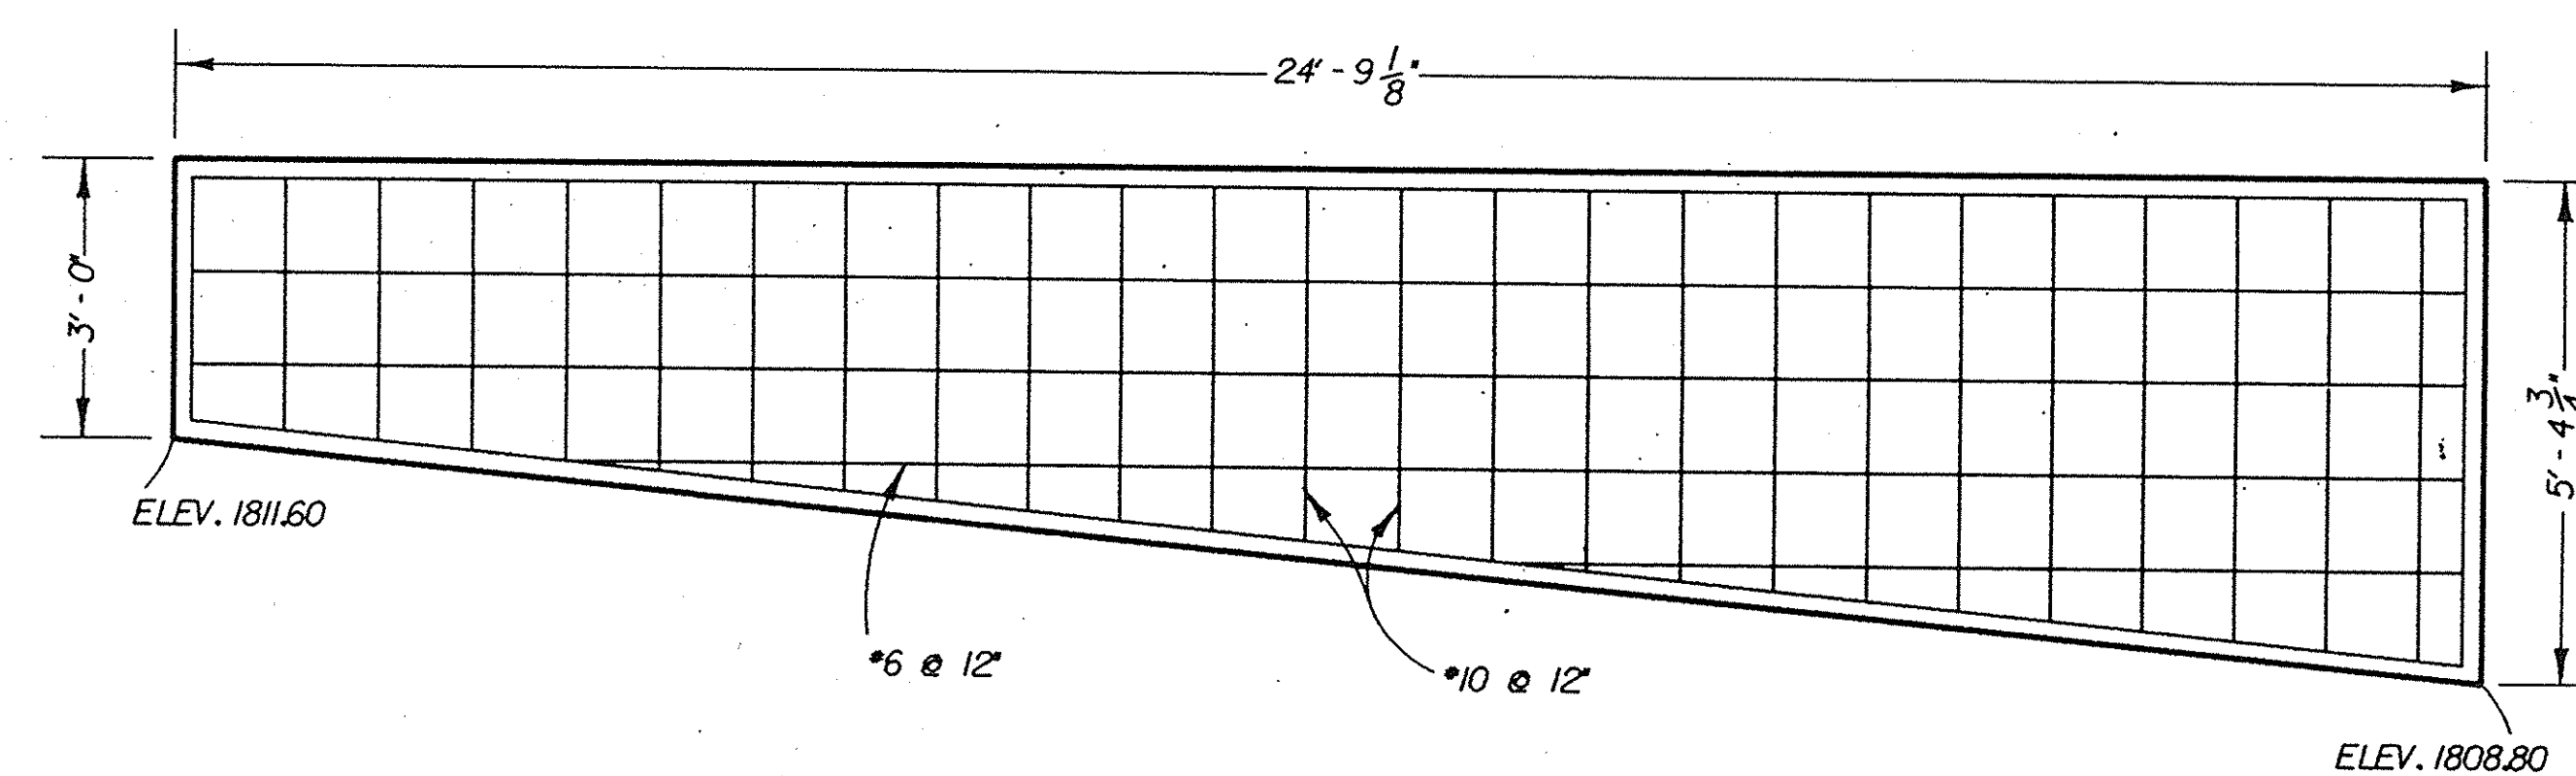

WALL PROFILE - WESTERLY BOX

SCALE 1" = 2'

(FACING EASTERLY)

ORANGE COUNTY ENVIRONMENTAL MANAGEMENT AGENCY		SILVERADO CANYON ROAD	
WESTERLY BOX DETAILS		SHEET 12 OF 15	
DATE	DESCRIPTION	REVISIONS	
3/19/91	Revised #10 @ 12 As Shown		
3/19/91	Revised Dimensions As Shown		
PREPARED UNDER SUPERVISION OF		REGISTERED PROFESSIONAL ENGINEER	
A.S. MEHTA		ASHUTOSH MEHTA	
23553		Exp. 12-31-99	
SCALE	DATE	CHECKED	DRAWING NO.
AS SHOWN		B.M.	