

ORANGE COUNTY ROAD DEPT.



STATE OF CALIFORNIA

PLANS FOR CONSTRUCTION OF

SLATER - SEGERSTROM BRIDGE

SA-31

ACROSS SANTA ANA RIVER
(CHANNEL E-01)

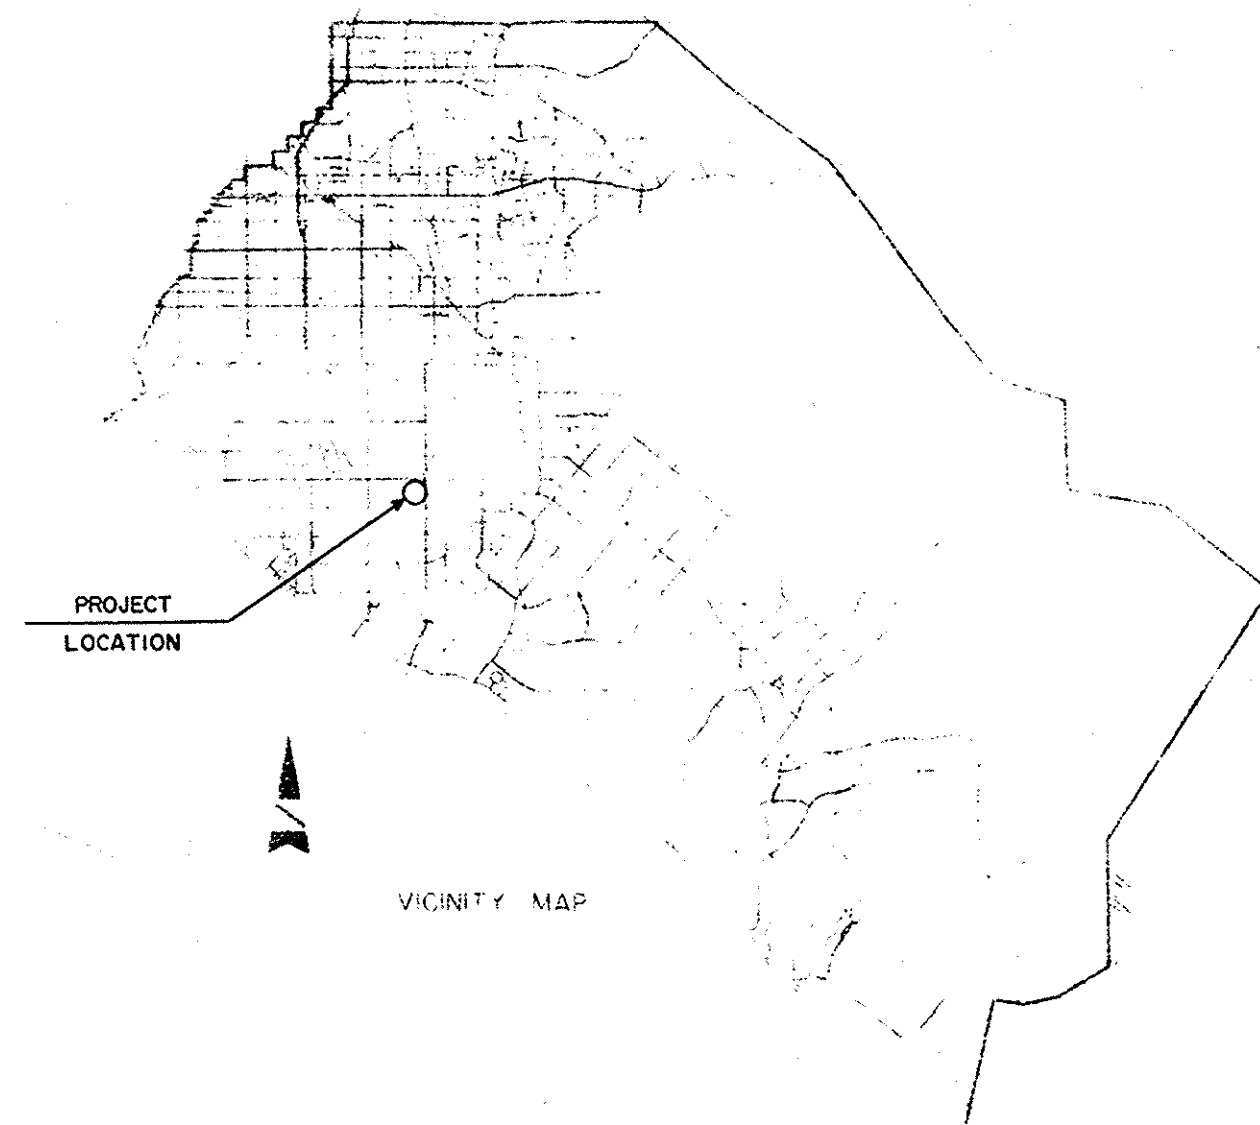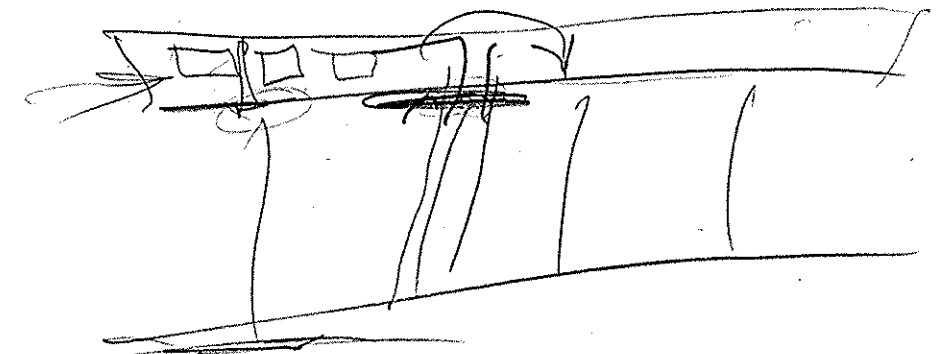

PROJECT
LOCATION


VICINITY MAP

BENCH MARK F.V. 69-70

IN THE SOUTHEAST PART OF INTERSECTION OF
NEWHOPE STREET AND SLATER AVENUE;
20.5 FEET EAST OF THE CENTERLINE
PROLONGATION OF THE STREET TO THE NORTH,
ABOUT 9 FEET SOUTH OF THE CENTERLINE
PROLONGATION OF THE AVENUE TO THE
WEST, 1 FOOT WEST OF THE CORNER OF A
CONCRETE BLOCK WALL IN THE TOP OF A
CONCRETE POST ABOUT 0.4 OF A FOOT
HIGHER THAN THE GROUND.

ELEV. 38.784

1970 ADJ.

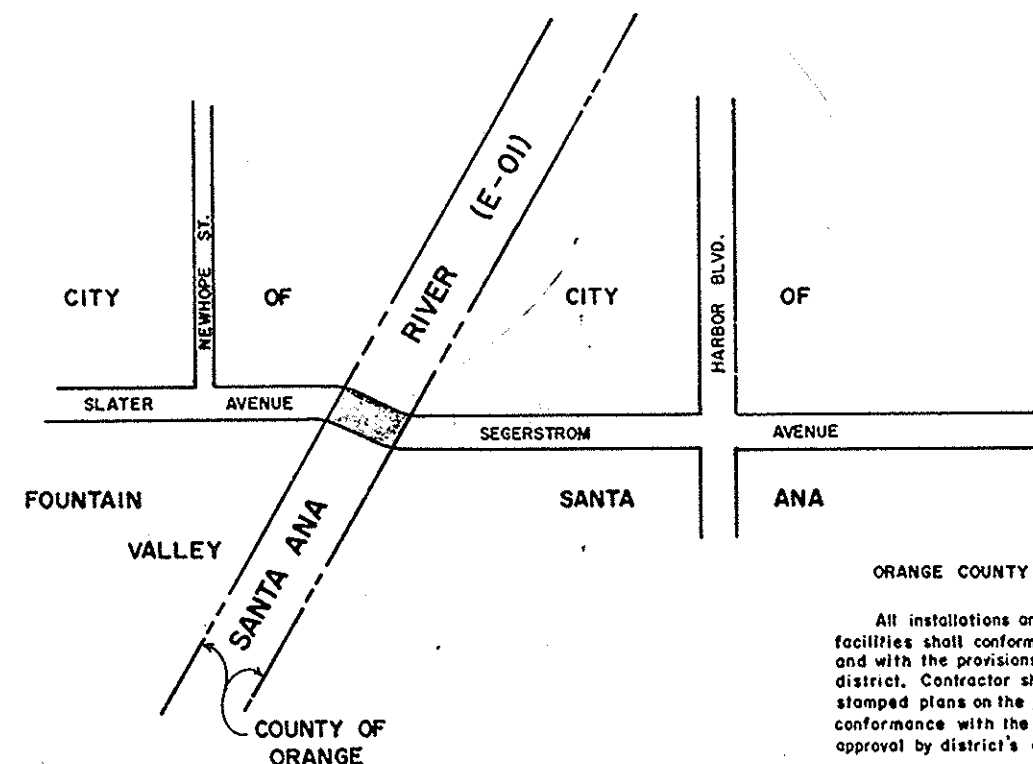

ORANGE COUNTY FLOOD CONTROL DISTRICT

All installations and work affecting flood control district facilities shall conform with district's standard specifications and with the provisions of the construction permit granted by district. Contractor shall maintain a copy of said permit and stamped plans on the job site. Use of district property and conformance with the above shall be subject to inspection and approval by district's duly assigned inspector.

DISTRICT INSPECTOR SHALL BE NOTIFIED PRIOR TO COMMENCEMENT OF ANY WORK IN ACCORDANCE WITH PERMIT PROVISIONS.

INDEX OF SHEETS

SHT. NO.	DESCRIPTION
1.	TITLE SHEET
2.	GENERAL PLAN & PROFILE
3.	FOUNDATION PLAN
4.	ABUTMENT DETAILS
5.	PIER DETAILS
6.	PIER EXTENSION DETAILS
7.	SUPERSTRUCTURE LAYOUT & REINFORCEMENT
8.	TYPICAL SECTION
9.	MISCELLANEOUS DETAILS
10.	GUARD RAIL - STRUCTURE EXCAVATION AND BACKFILL
11.	PILING DETAILS
12.	LOG OF TEST BORINGS
13.	EAST LEVEE ACCESS RAMP DETAILS
14.	LEVEE EXCAVATION & BACKFILL - SLOPE PROTECTION DETAILS

#11750
1-10-1008 51-31
SHEET 1 OF 14
RSD, 22.5.11
LINEN

APPROVED

[Signature] DATE *Apr 23 '74*

DR. 12 (11359)
SLATER-SEGERSTROM
BR. OVER SAR
SA-31 1975
55C-371
Thos. map: 858-41