
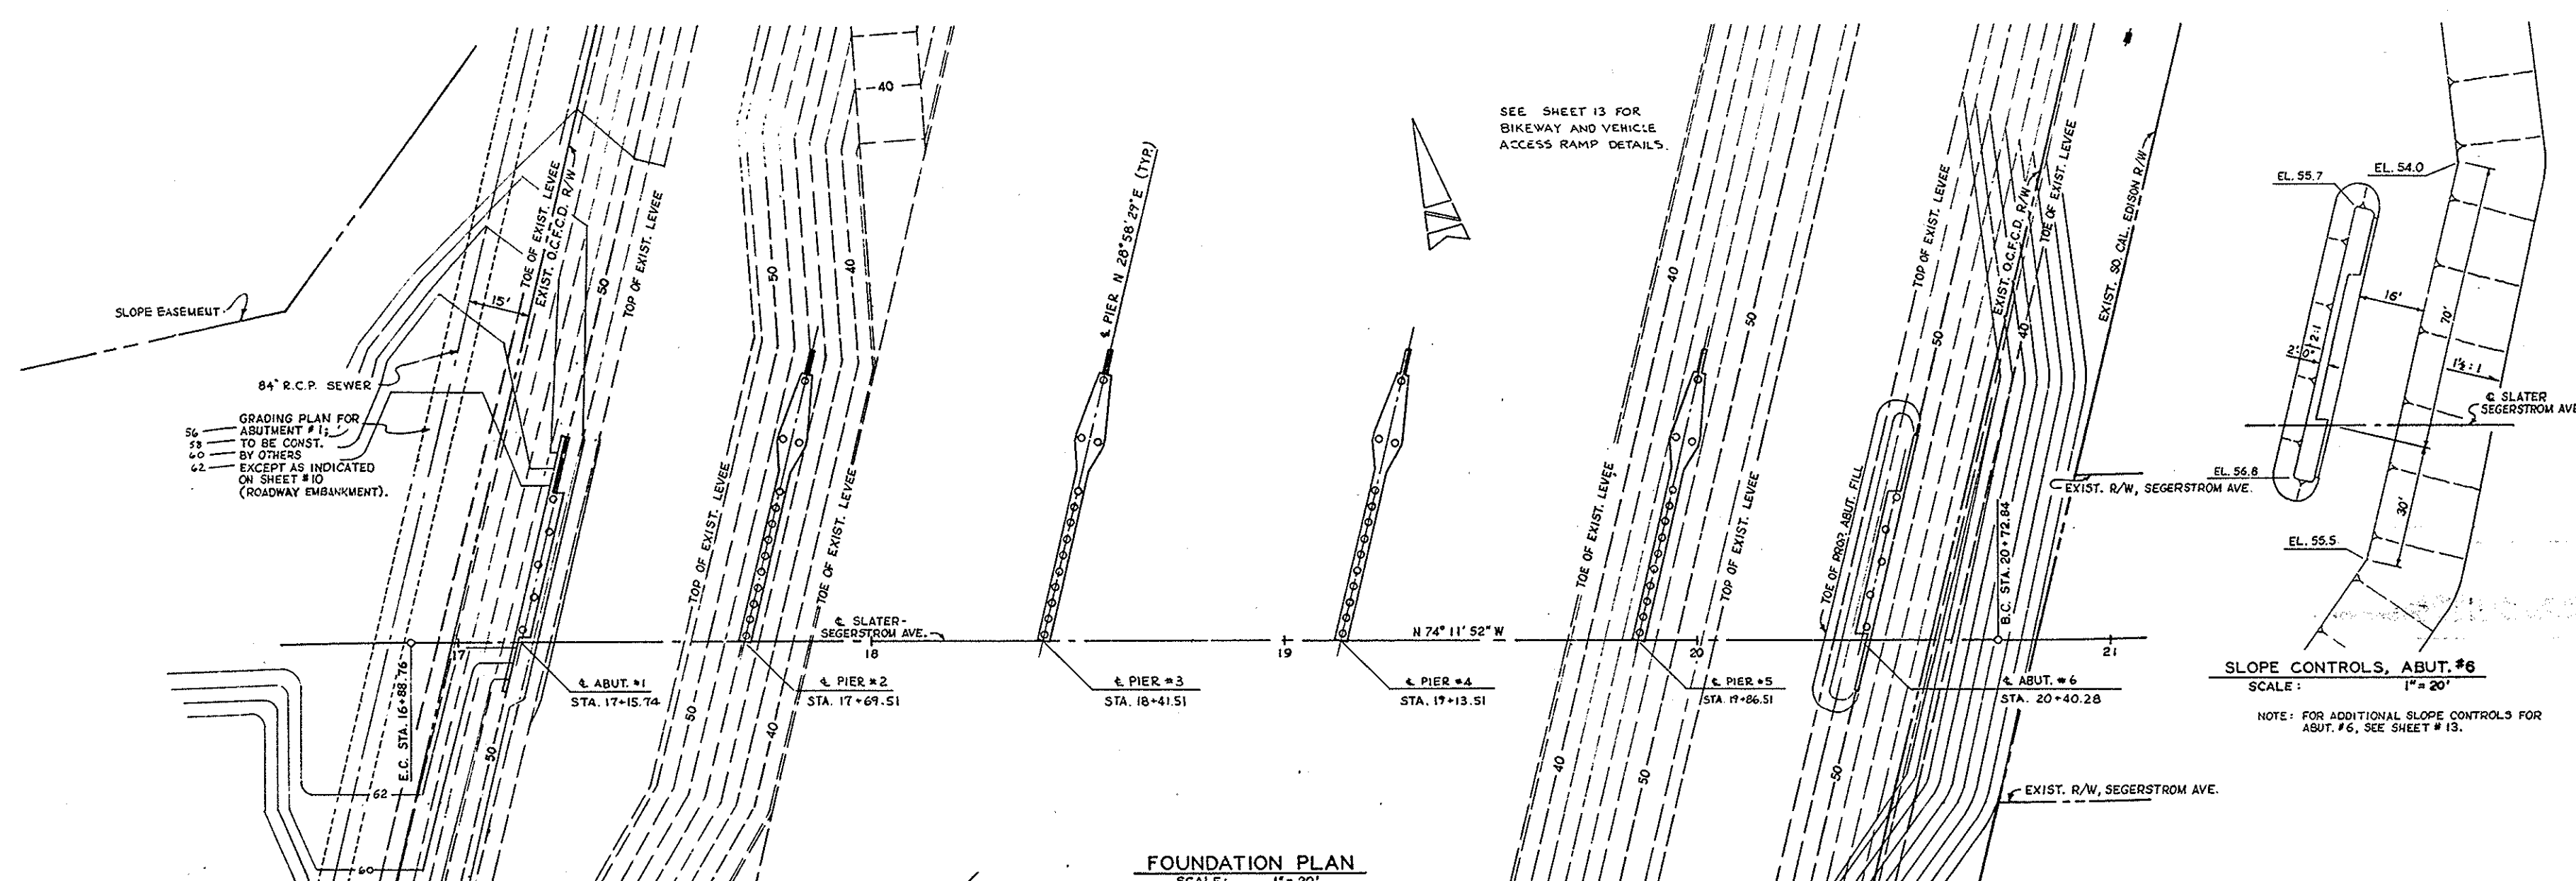
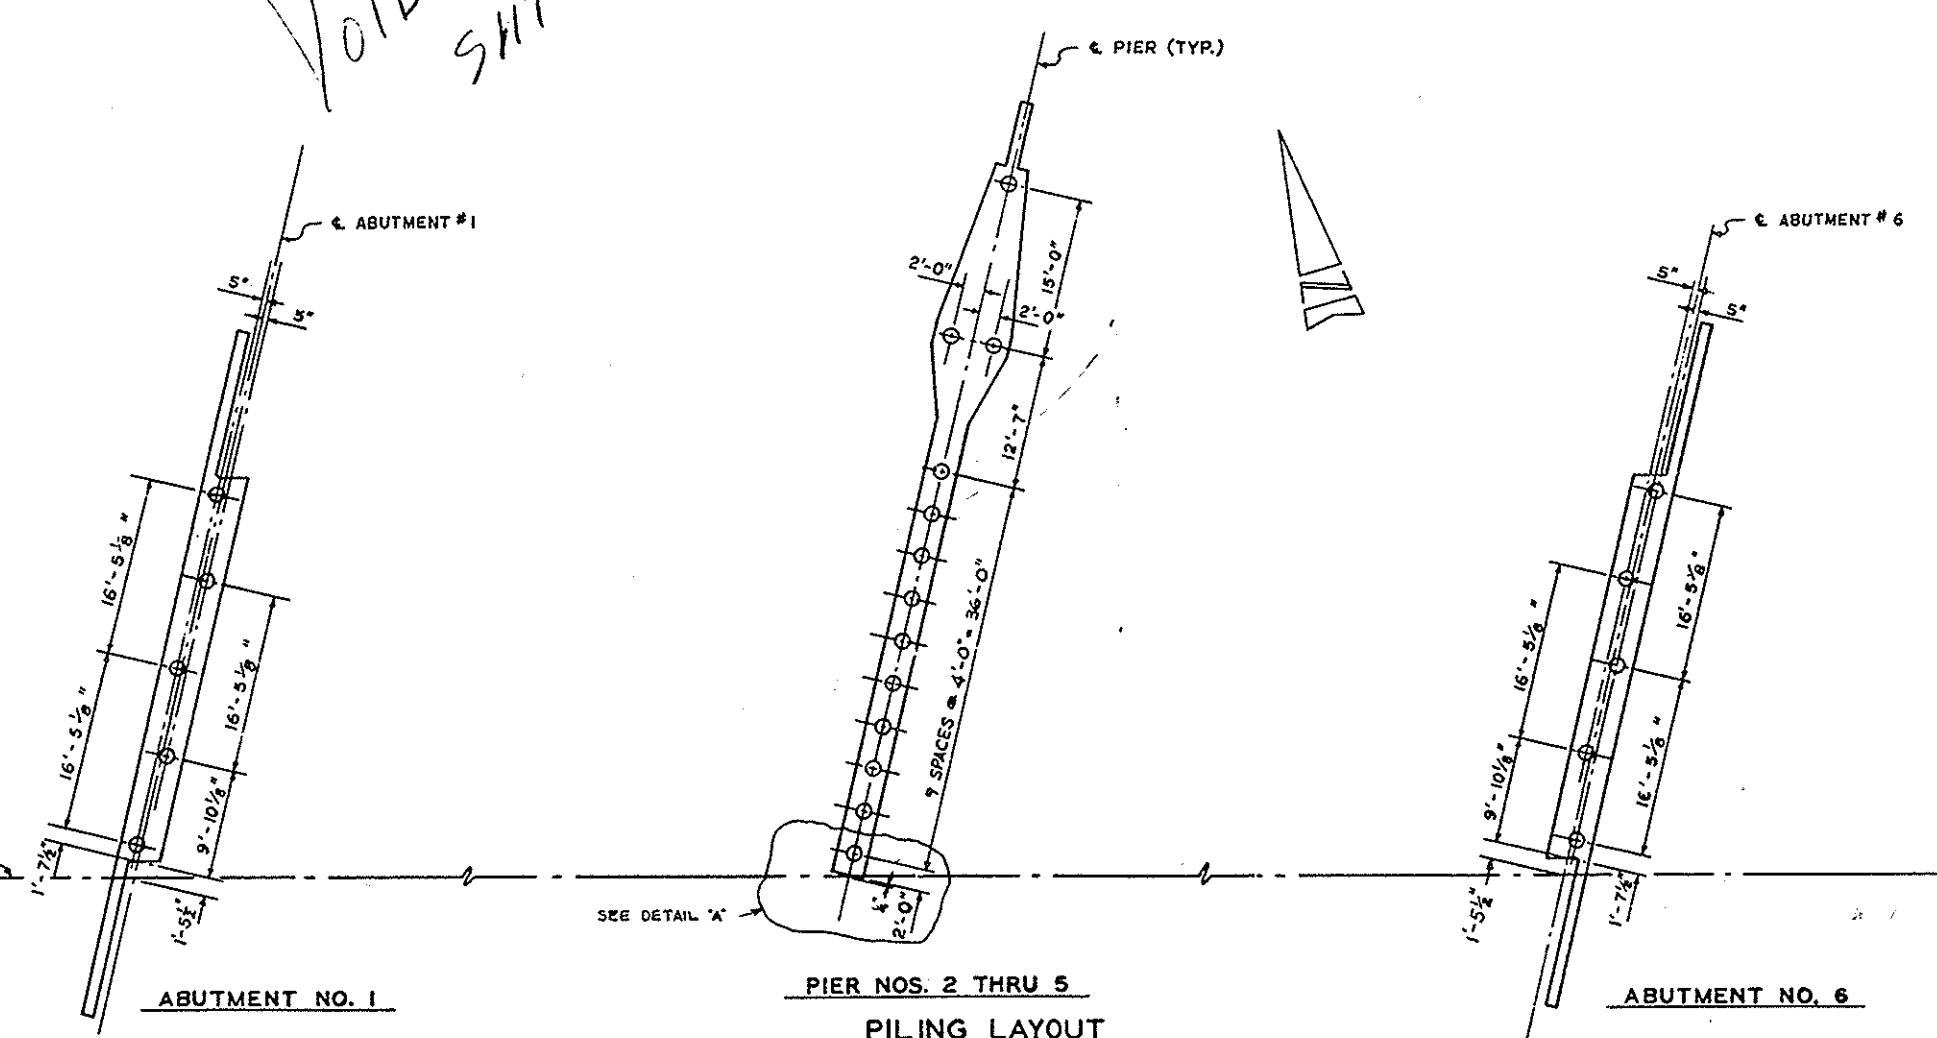


- NOTES:
1. PILE TYPE: CLASS 70 CONCRETE PILE
 2. EXISTING CONTOURS SHOWN ARE APPROXIMATE ONLY.
 3. ALL ABUTMENT PILES SHALL BE PREDRILLED TO ELEVATION 44.00
 4. CONTRACTOR SHALL CONSTRUCT TEMPORARY ACCESS ROAD TO MAINTAIN THROUGH ACCESS ALONG LEVEE.

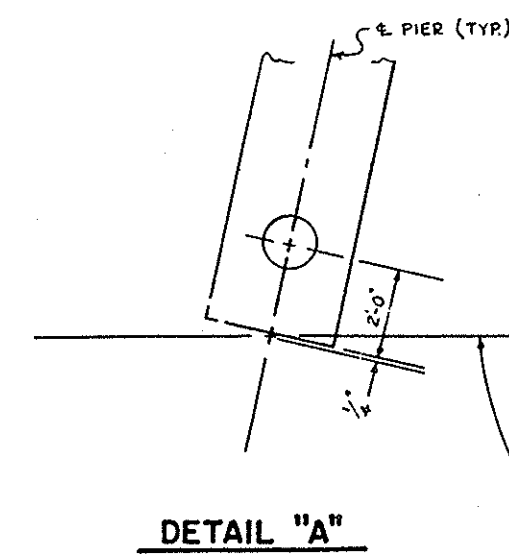

PILING DATA			
ABUT. OR PIER NO.	PILE NO.	PILE CUTOFF	PILE TIP
ABUT. #1	PILE #1	54.16	4.00
ABUT. #1	PILE #2	54.03	4.00
ABUT. #1	PILE #3	53.89	4.00
ABUT. #1	PILE #4	53.76	4.00
ABUT. #1	PILE #5	53.63	4.00
PIER #2	ALL PILES	32.25	4.00
PIER #3	ALL PILES	32.25	4.00
PIER #4	ALL PILES	32.25	4.00
PIER #5	ALL PILES	32.25	10.00
ABUT. #6	PILE #58	54.81	10.00
ABUT. #6	PILE #59	54.68	10.00
ABUT. #6	PILE #60	54.55	10.00
ABUT. #6	PILE #61	54.41	10.00
ABUT. #6	PILE #62	54.28	10.00

* PILES ARE NUMBERED BEGINNING WITH THE PILE NEAREST THE CENTERLINE OF SLATER-SEGERSTROM AVE. AND PROGRESSING NORTHERLY UPSTREAM BEGINNING WITH ABUTMENT #1 AND PROGRESSING FROM WEST TO EAST.

#11759
BRIDGE SA-BX 31
SHEET 3 OF 16
RED 22-511
CROSS SECTION

ORANGE COUNTY ROAD DEPARTMENT

SLATER-SEGERSTROM BRIDGE SA-31

FOUNDATION PLAN

AS SHOWN

SHEET 3 OF 16

DR. 12 (11359)