


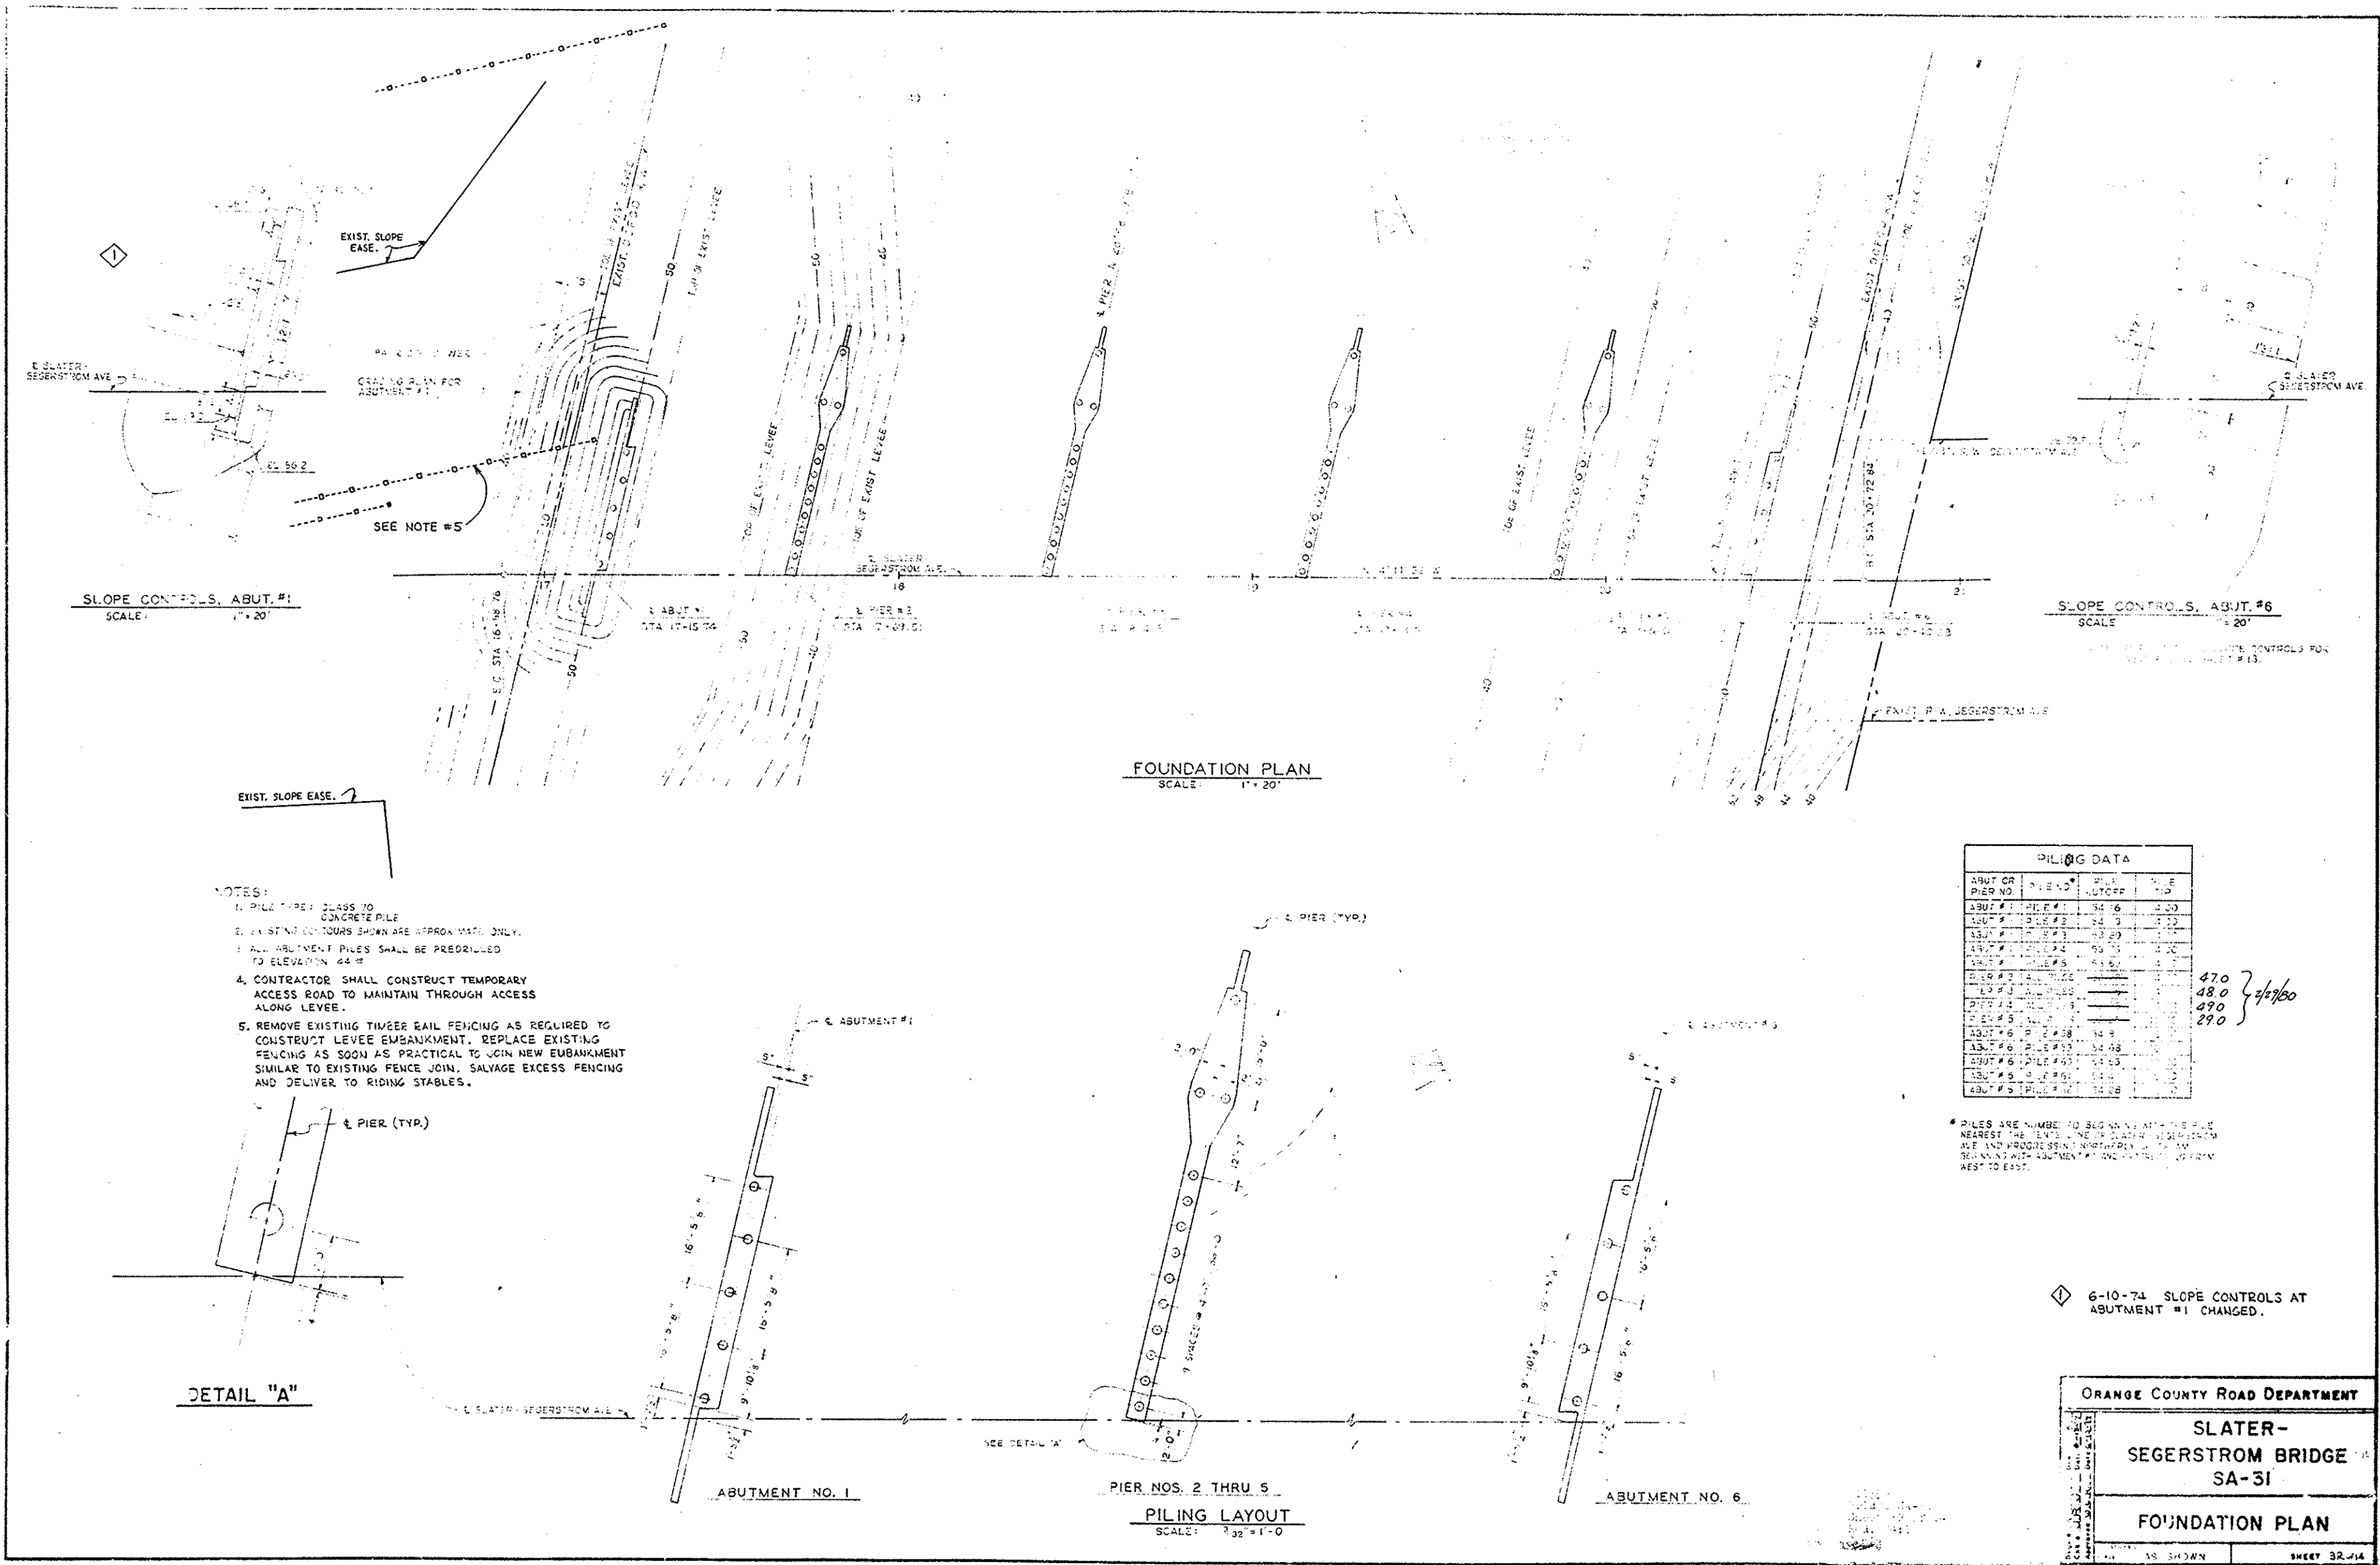

6-10-74 SLOPE CONTROLS AT ABUTMENT #1 CHANGED.

ORANGE COUNTY ROAD DEPARTMENT

SLATER-SEGERSTROM BRIDGE

SA-31

FOUNDATION PLAN

AS SHOWN

SHEET 32-114

R-12 (11359)