

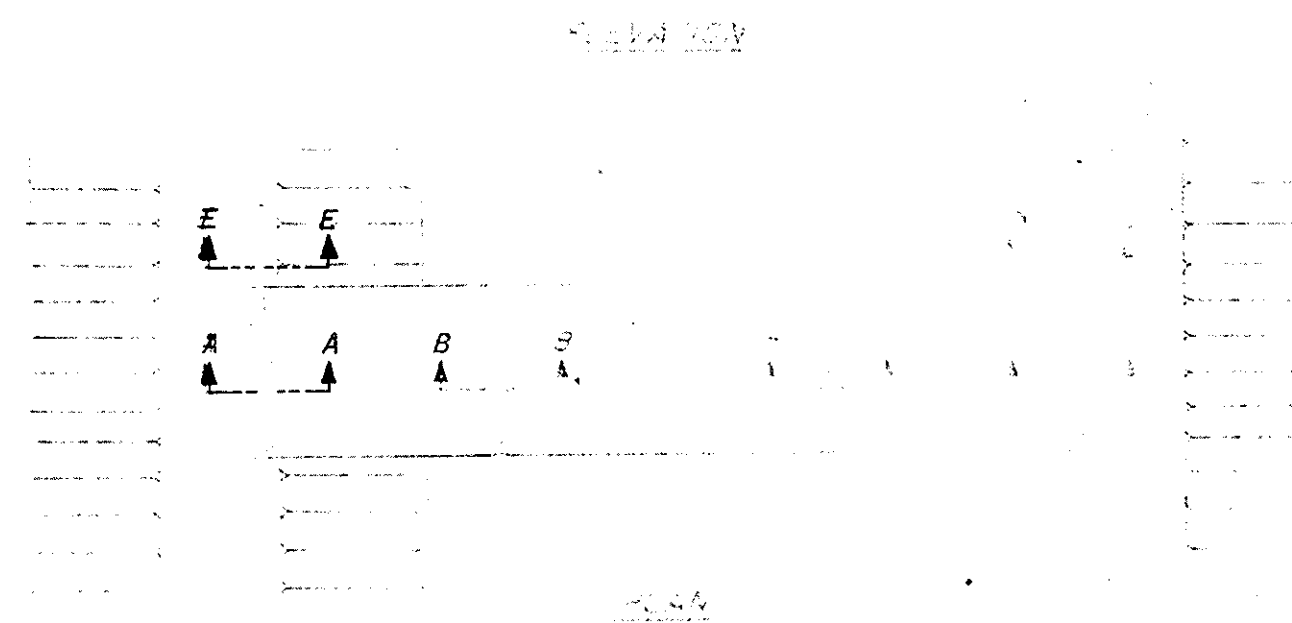



SECTION A-A
ABUTMENT #1

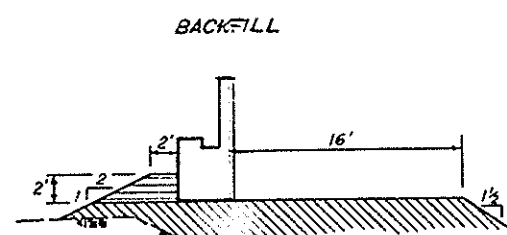

SECTION C-C
ABUTMENT #6

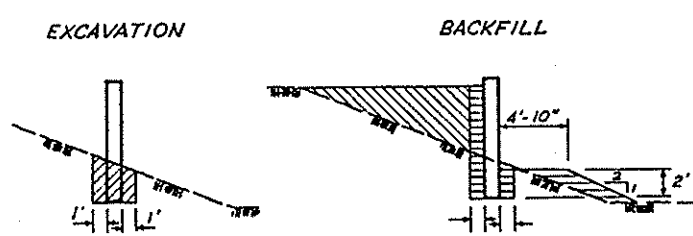

SECTION E-E
WINGWALLS @ ABUTMENT #1

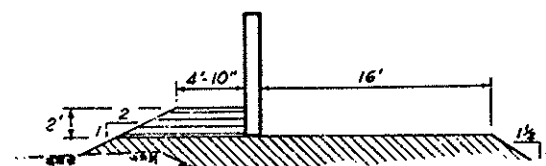


SECTION D-D
WINGWALLS @ ABUTMENT #6

LEGEND


- EXCAVATION
- BACKFILL
- STRUCTURE
- RAILROAD

STRUCTURE EXCAVATION &
BACKFILL DETAILS

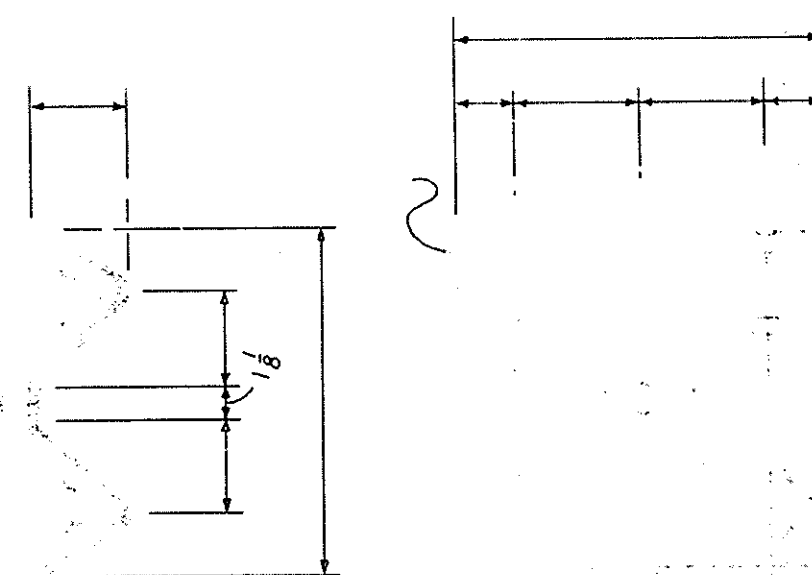

Note: 8"x8"x1'-2" Block not shown.

Limit of payment

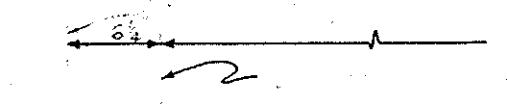


8"x8"x1'-2" block

Edge of deck

Metal beam guard rail

PLAN

VOID
SHT. 10R
SEE

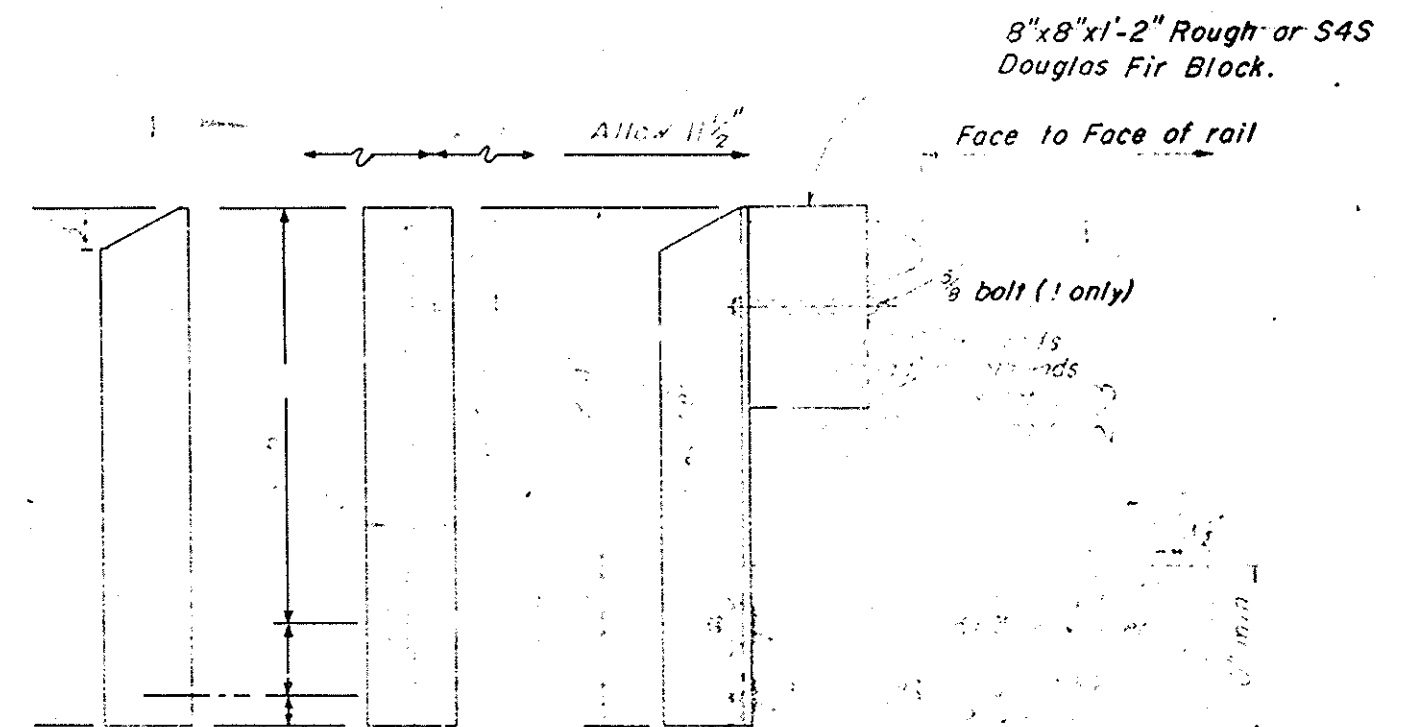

8"x8"x1'-2" Rough or S4S
Douglas Fir Block.

Face to Face of rail

1/2 bolt (! only)

POST FOR THIN SLABS

Master to bolts

#11759
BRIDGE 5A-31
SHEET 10 of 16
RED. 22.5.1
SEPIA

STATE ROAD DEPARTMENT
SLATER-
SEGERSTROM BRIDGE
5A-31
RAIL STRUCTURE
BACKFILL DETAILS

METAL BEAM GUARD RAIL DETAILS

DR. 12 (11359)