


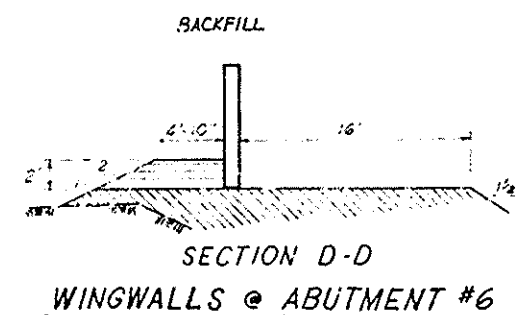
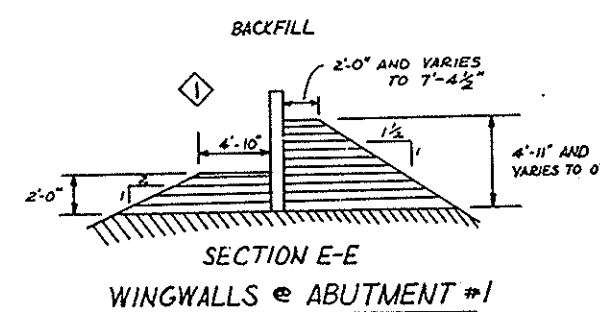
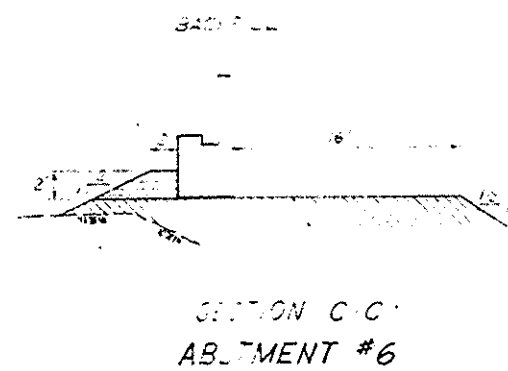
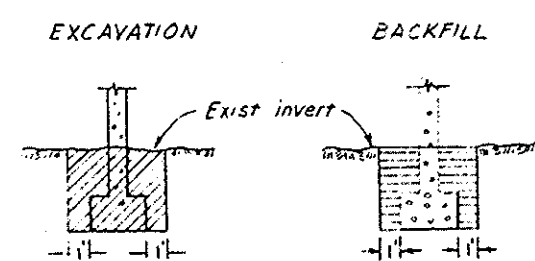
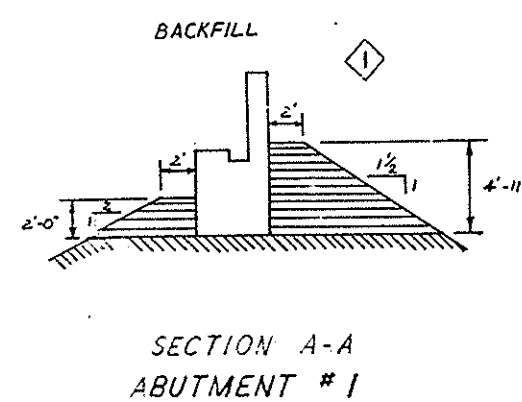
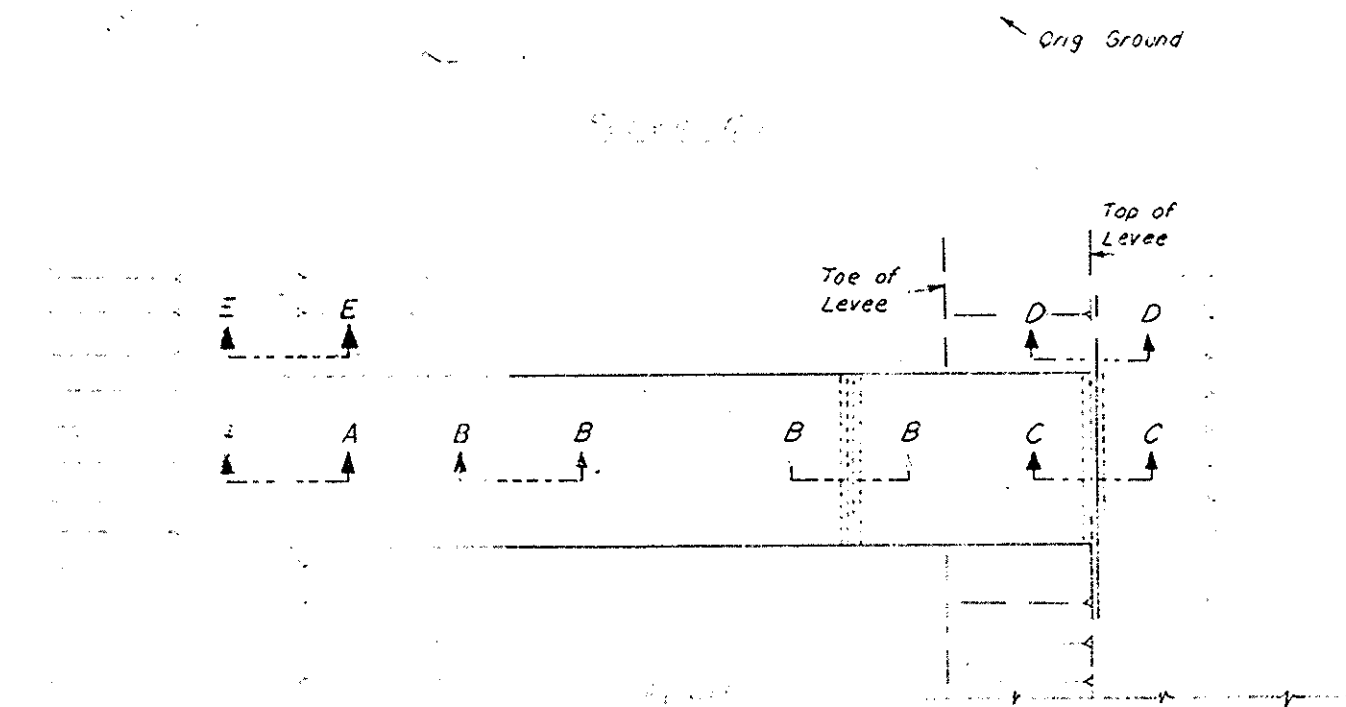


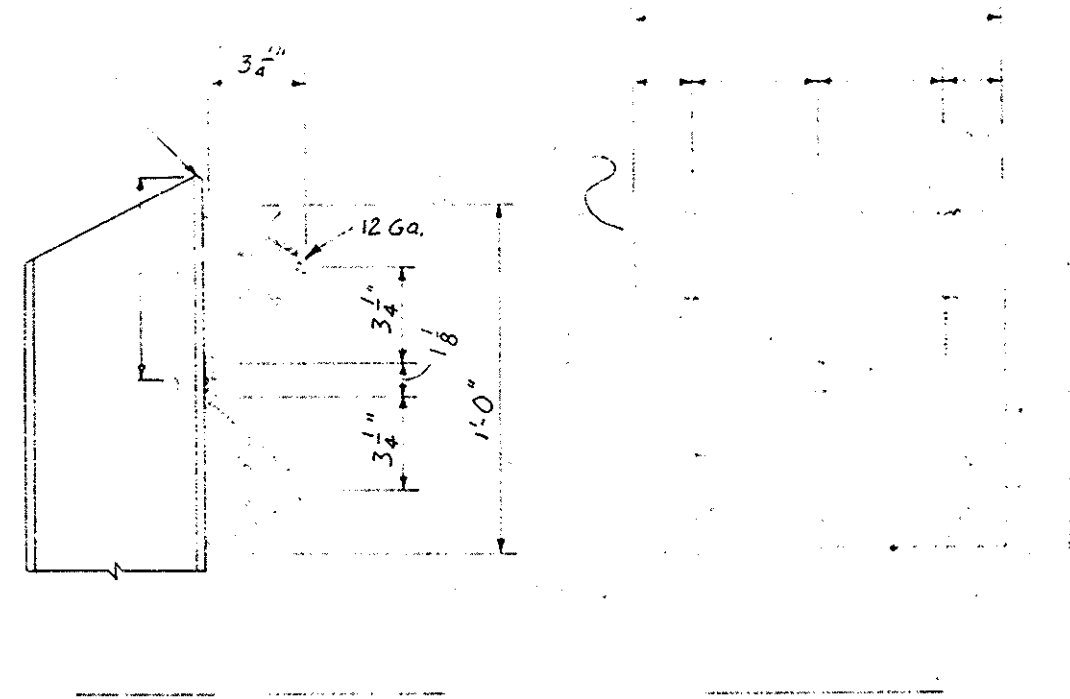

LEGEND

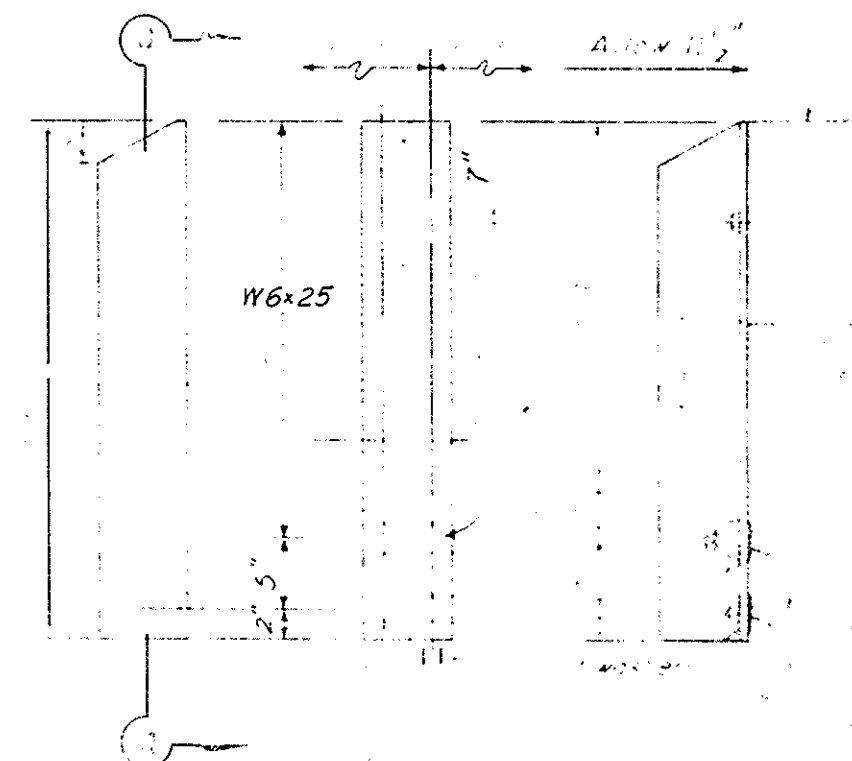

Note: 8"x8"x1'-2" Block not shown.

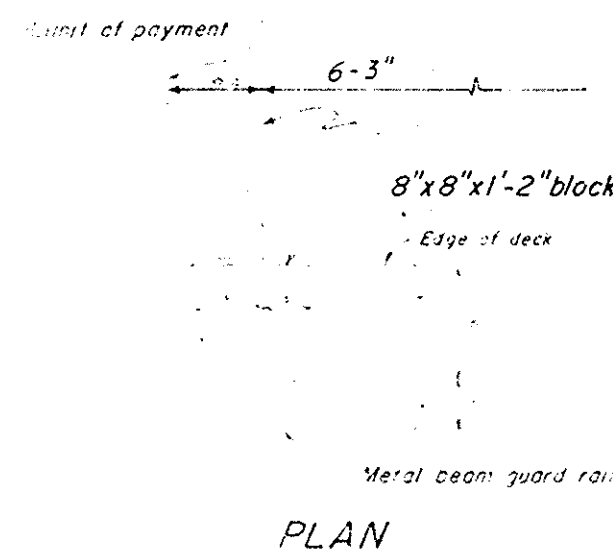

POST FOR THIN SLAB

6-10-74 - CHANGE IN BACKFILL
DETAIL.

COUNTY ROAD DEPARTMENT
SLATER-
SEGERSTROM BRIDGE
SA-31
METAL BEAM GUARD RAIL STRUCTURE
BACKFILL DETAILS

METAL BEAM GUARD RAIL DETAILS

FILED
SLATER
SA-31
STRUCTURE
DETAILS

12-12(11359)