

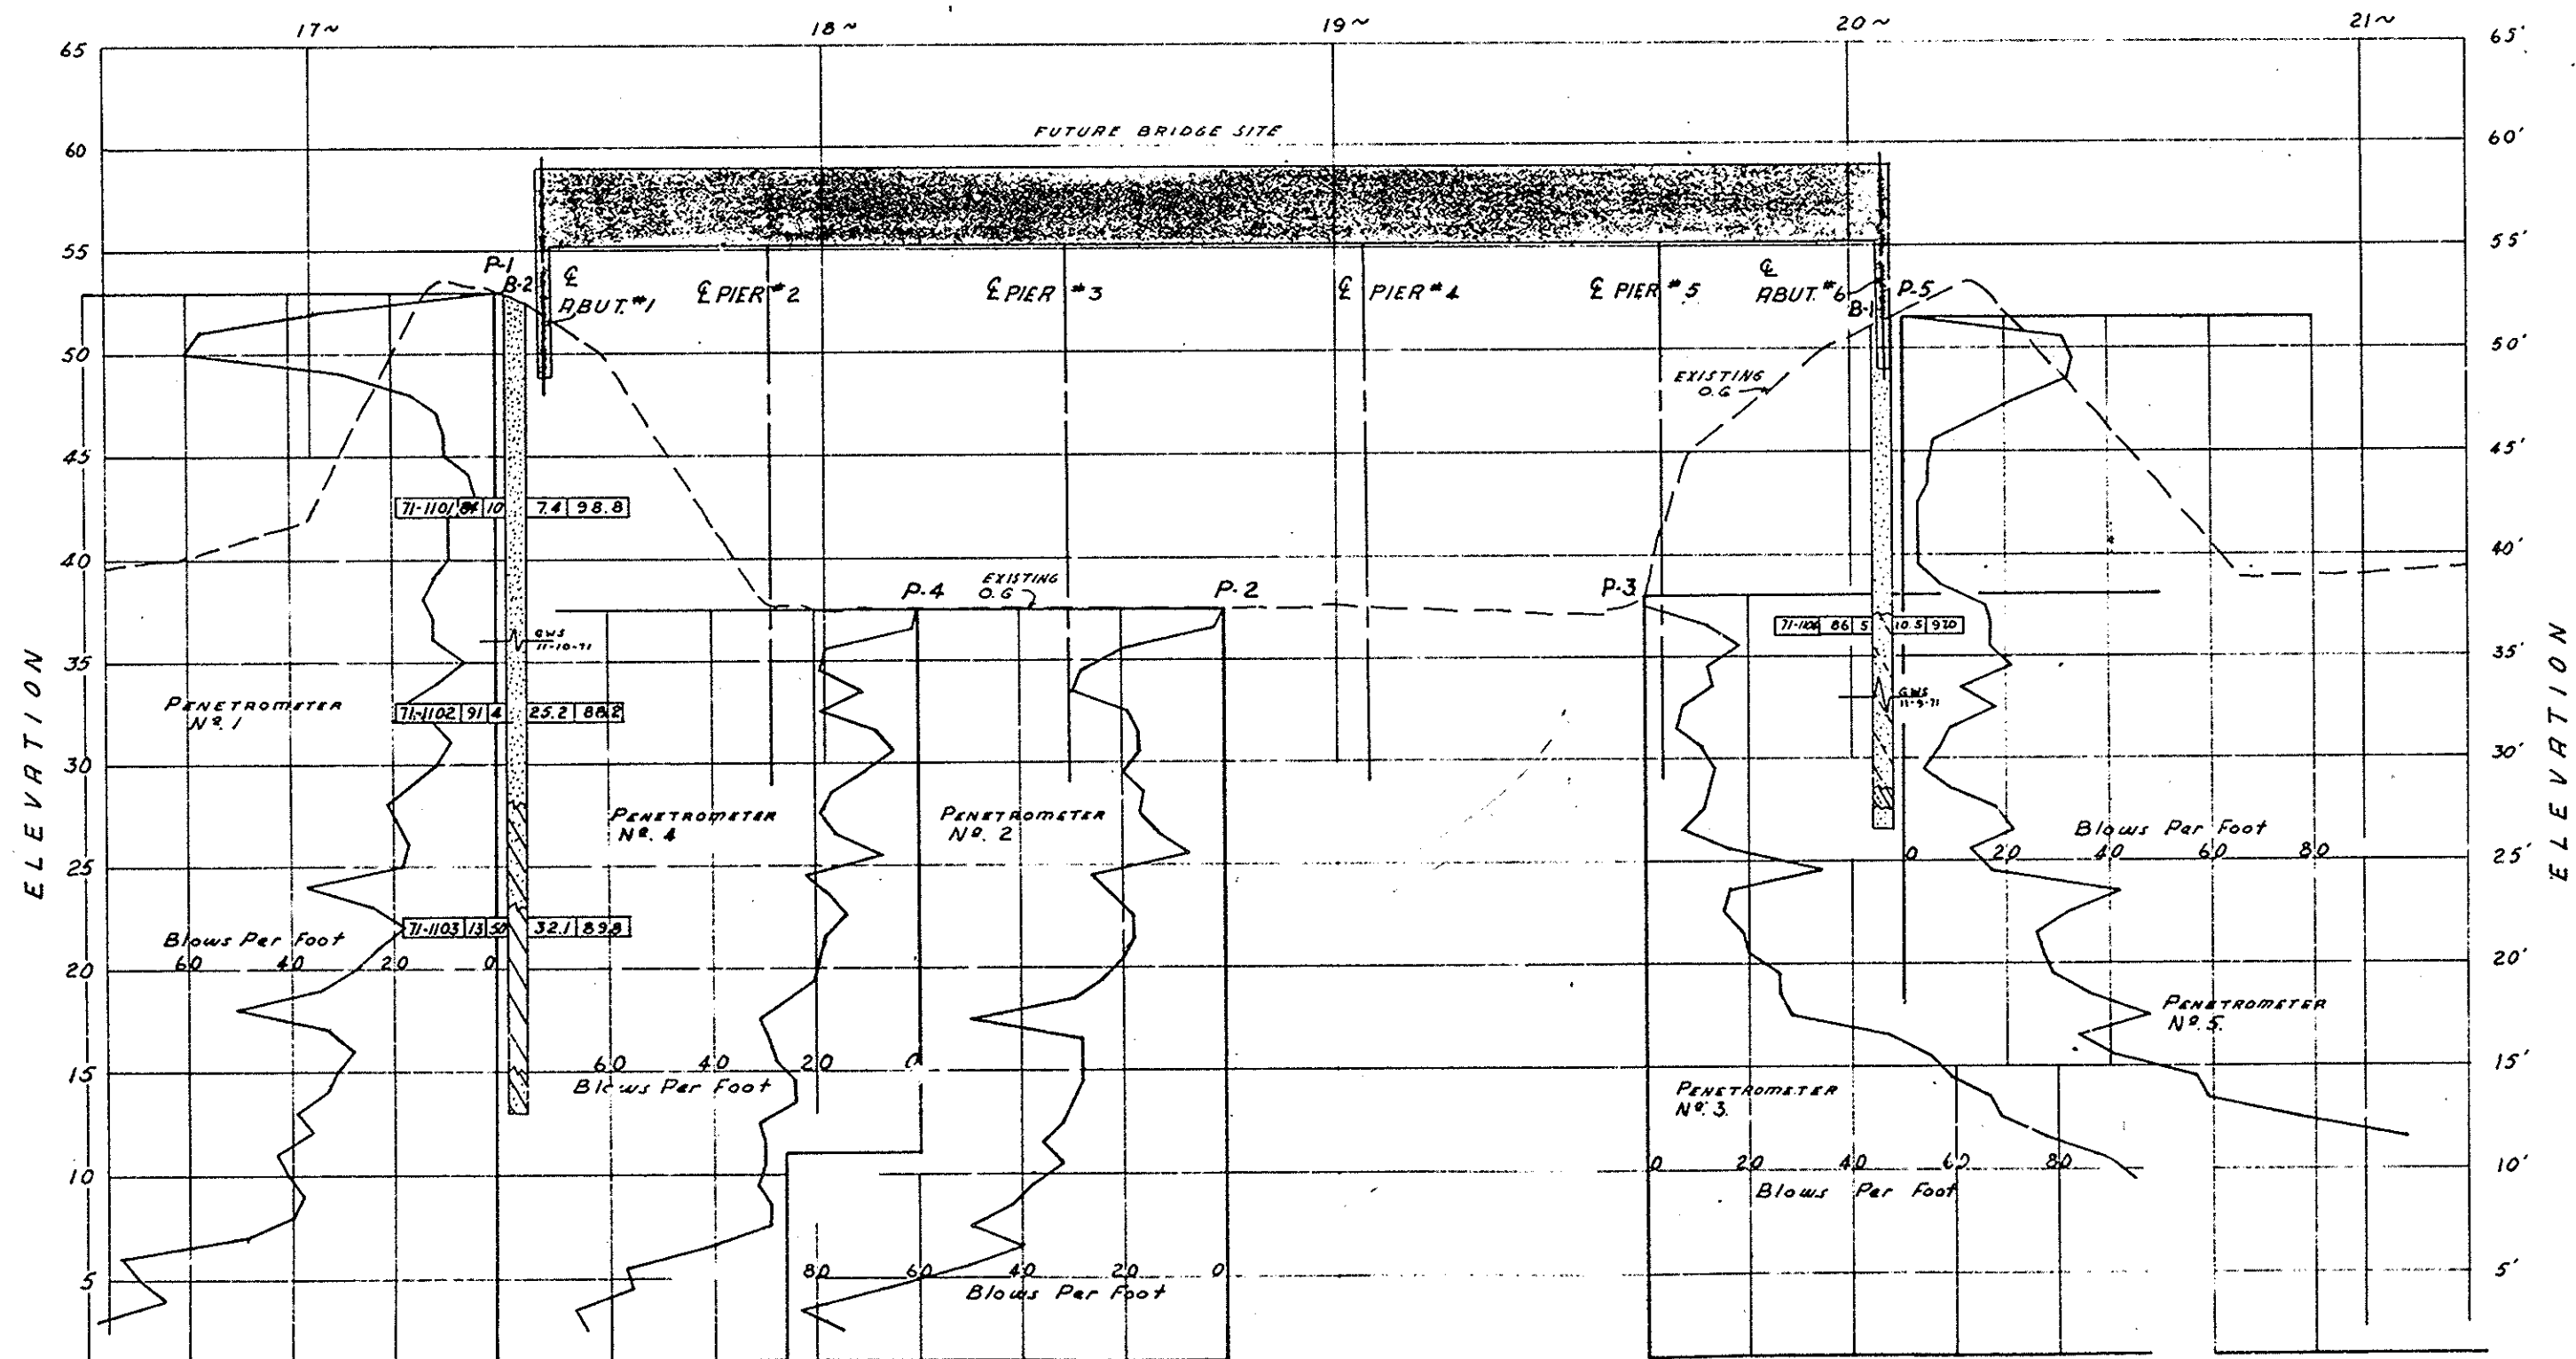


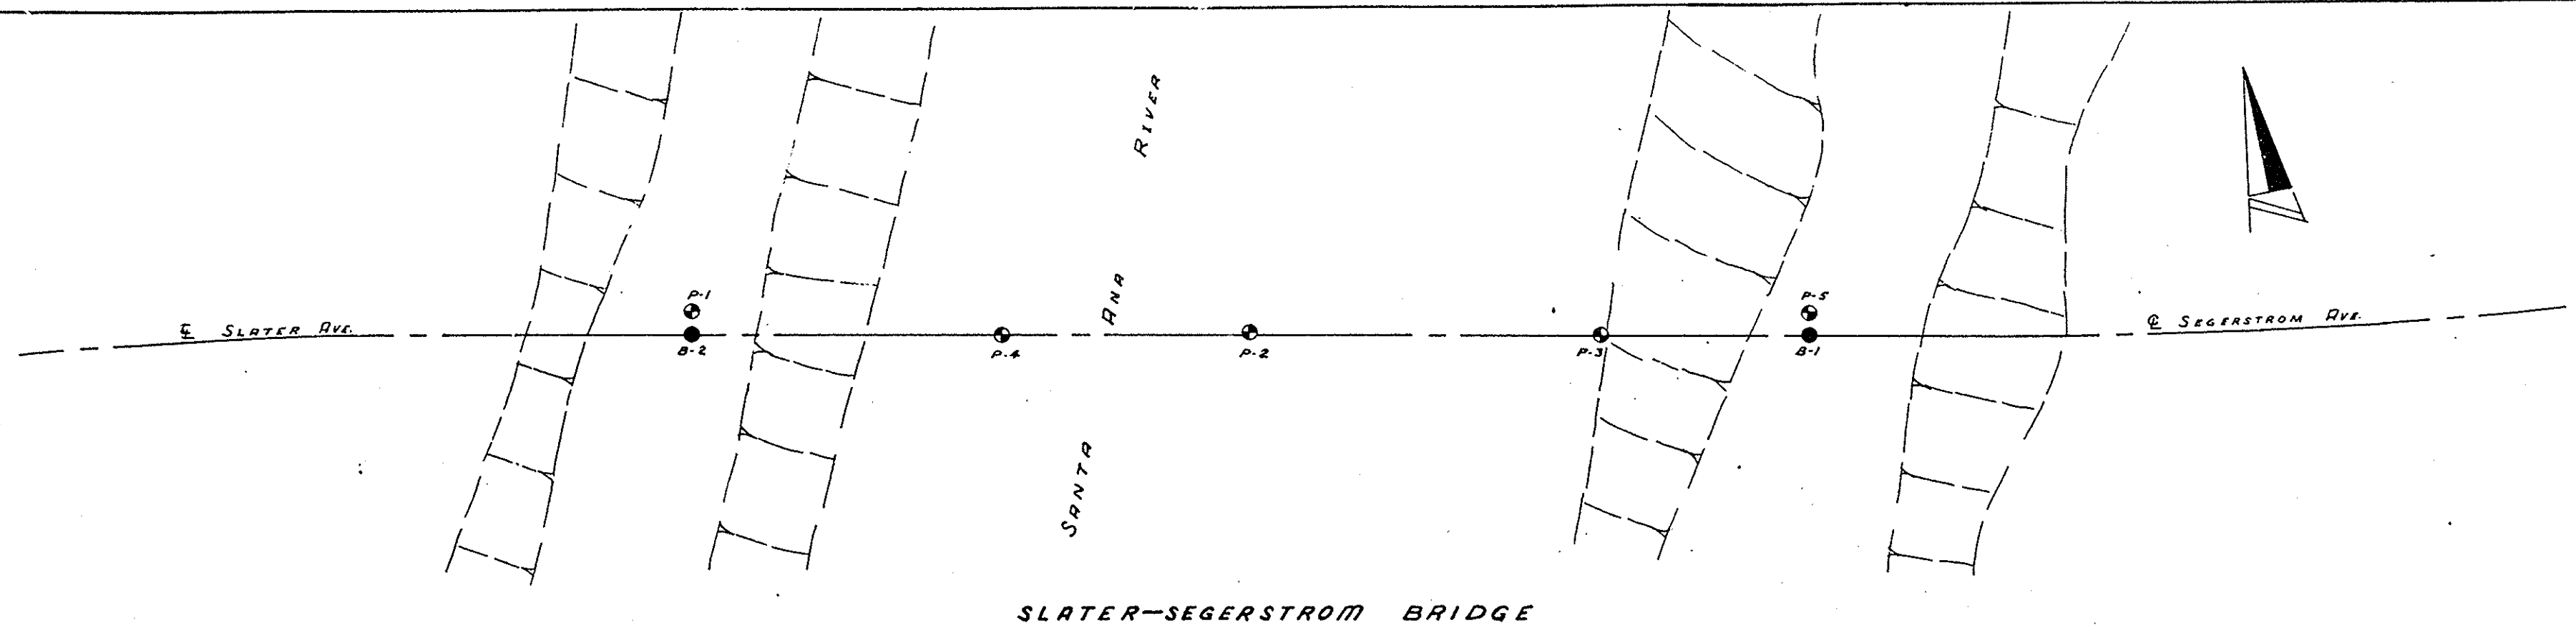

LEGEND

- 8" Boring Location
- ⊙ Penetrometer Location

TYPICAL BORING

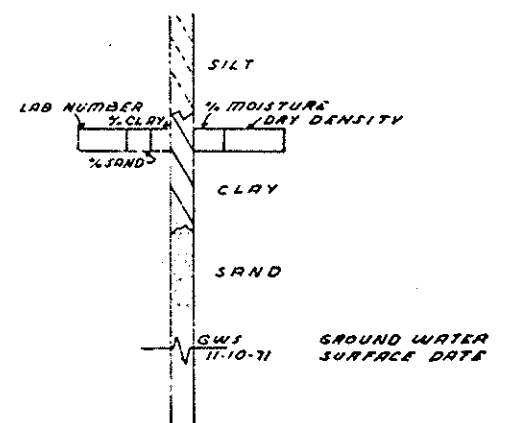

411359
BRIDGE SA-31
SHEET 12 OF 16
RED. 22.5:1
SEPIA

ORANGE COUNTY ROAD DEPARTMENT

SLATER-
SEGERSTROM BRIDGE
SA-31

LOG OF TEST BORINGS

AS SHOWN

DR. 12(11359)