

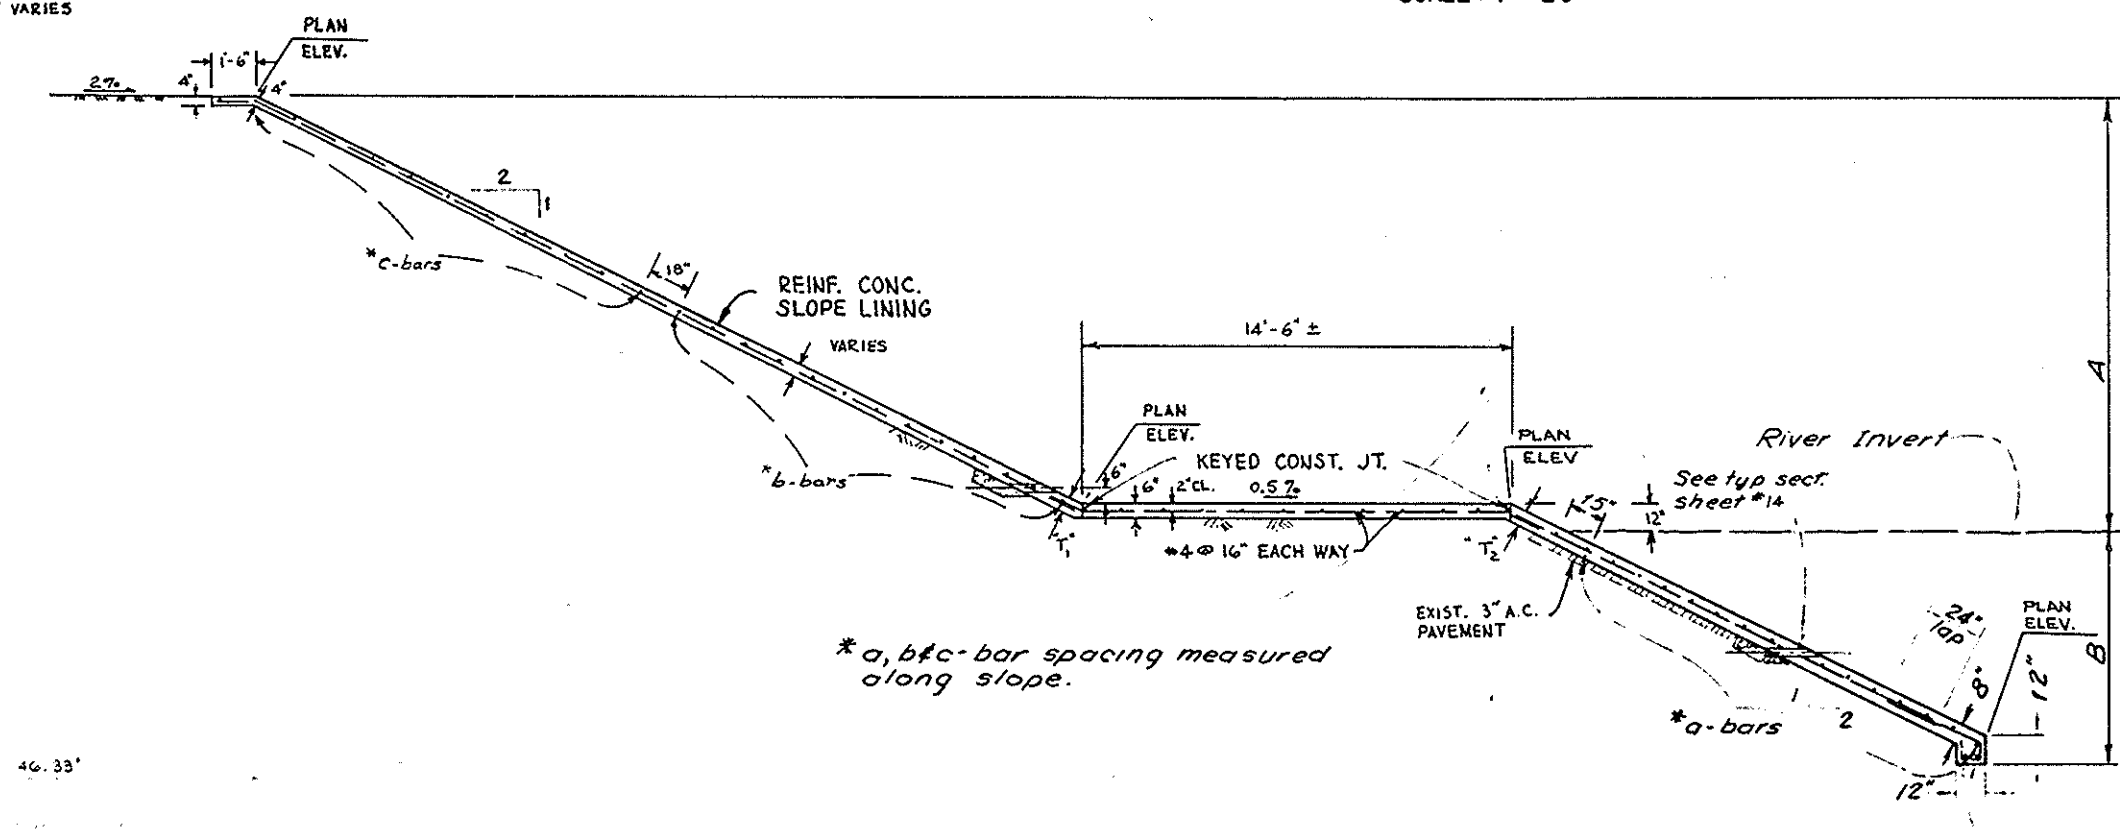
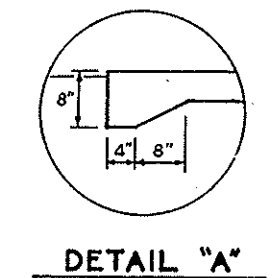
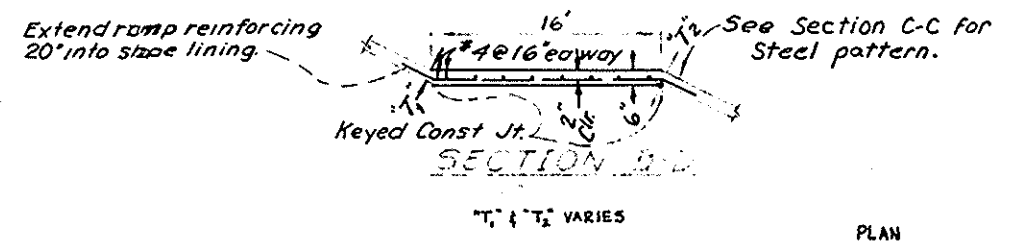
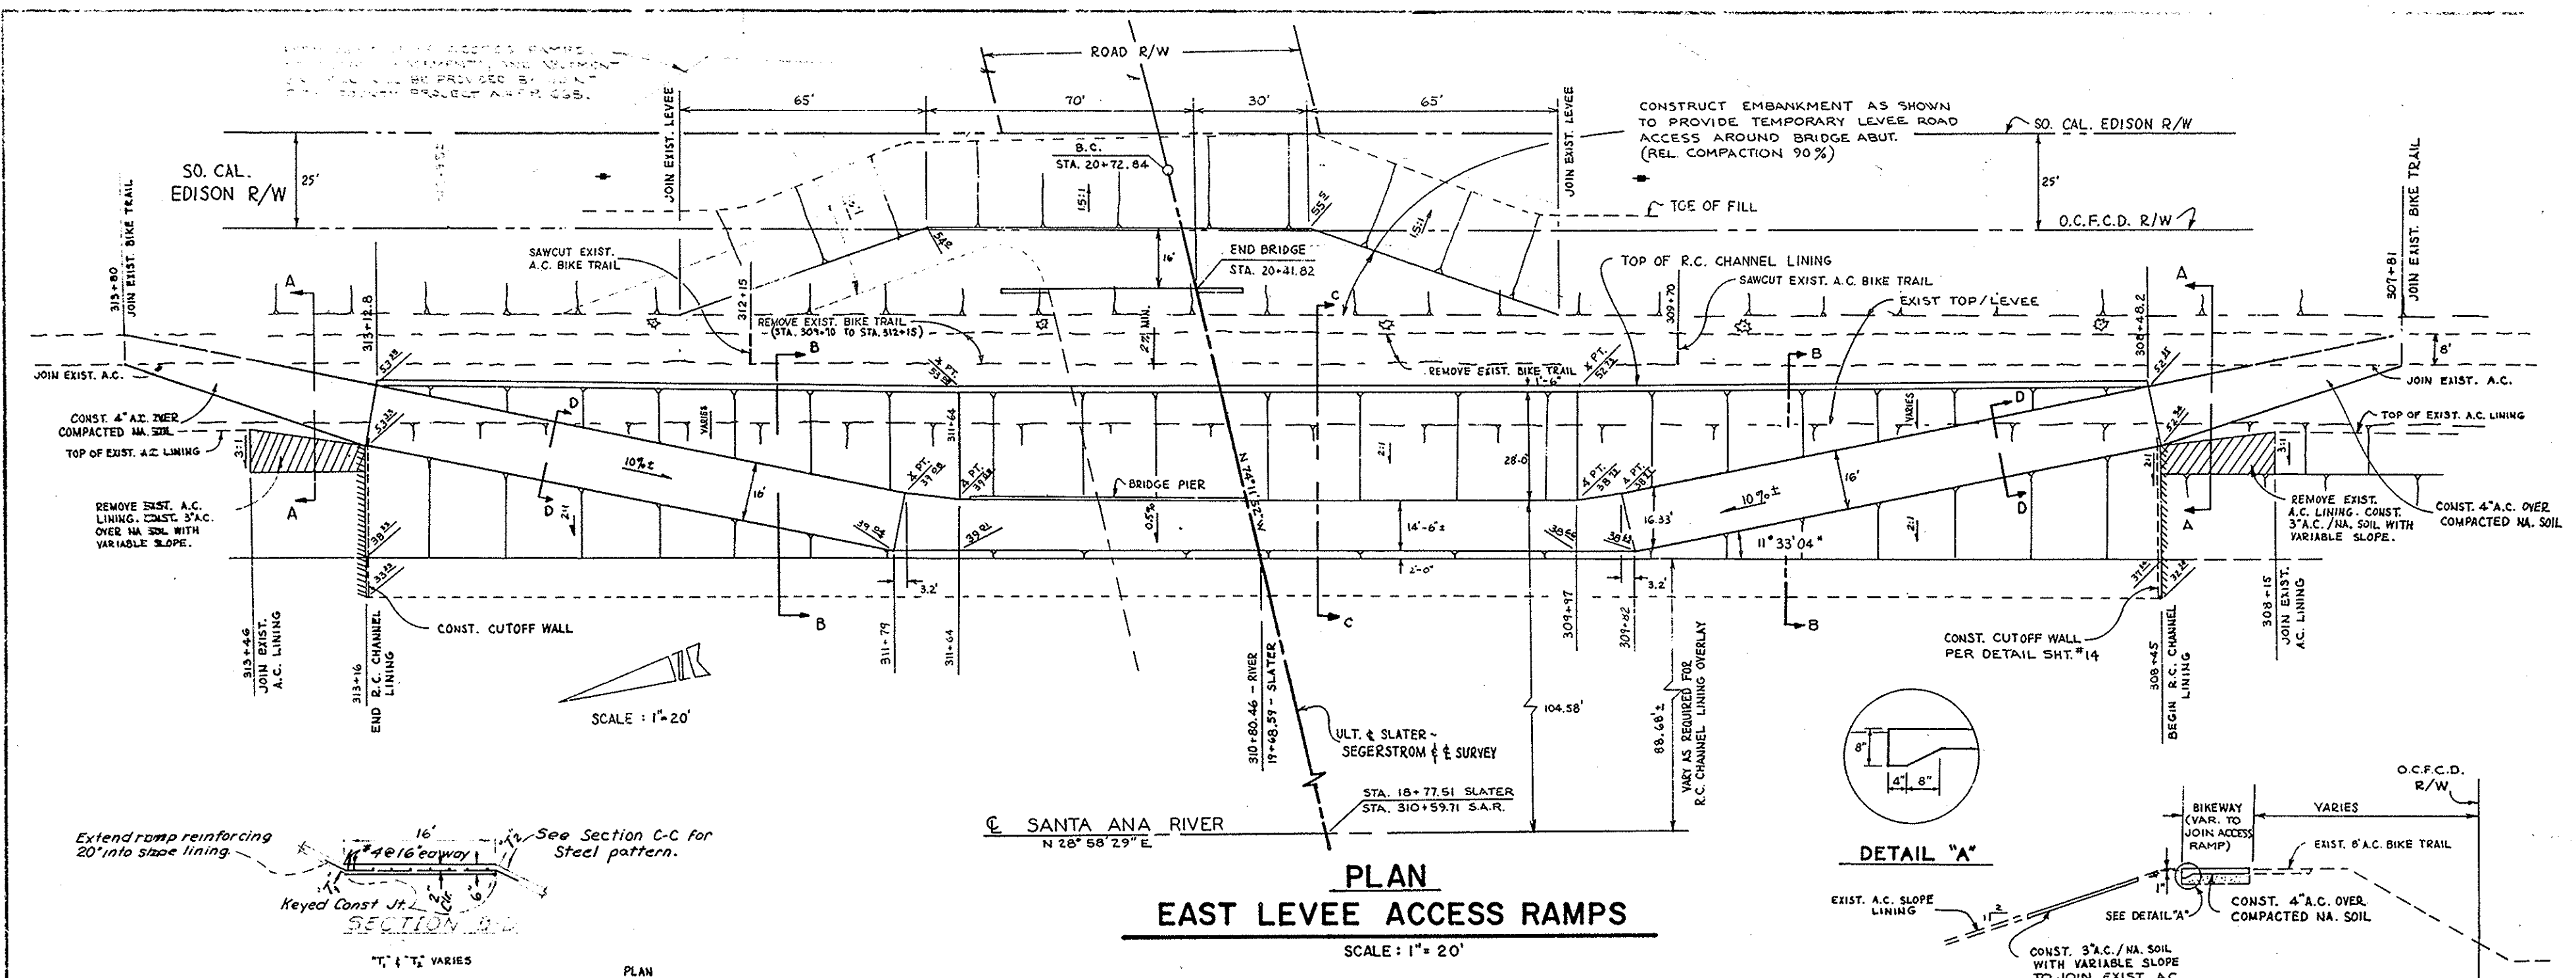


TABLE OF DIMENSIONS

Station to Station	A	B	a-bars	b-bars	c-bars
308+45 - 313+16	15.00'	0.00'	18 - #4 @ 12"	12 - #4 @ 5'	9 - #4 @ 18"

TYPICAL SECTION
BRIDGE PIER DETAIL

SLATER -
SEGERSTROM - BRIDGE
SA-31
EAST LEVEE
ACCESS RAMPS DETAILS
SCALE: AS SHOWN
DR. 12 (11359)