




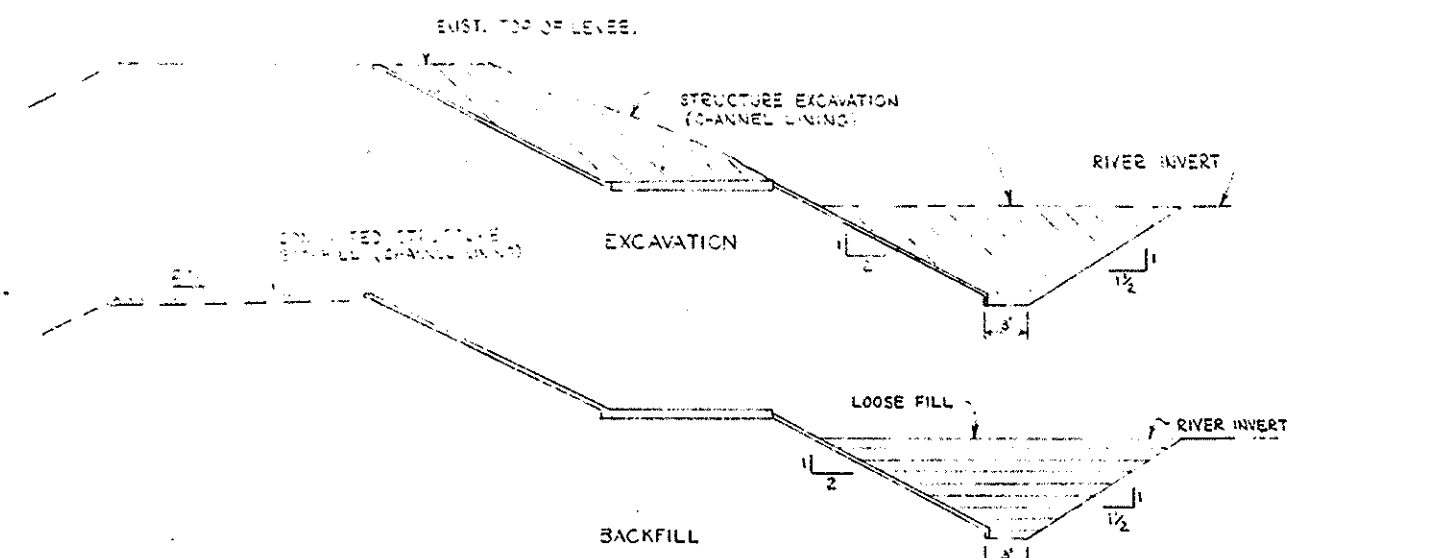


STRUCTURE EXCAVATION AND BACKFILL FOR  
R.C. CHANNEL LINING  
NO SCALE

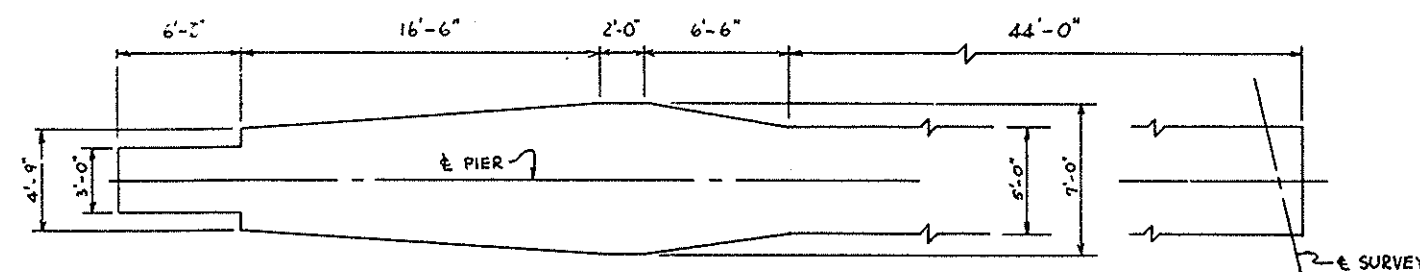


PAY LIMITS FOR SLOPE PROTECTION REMOVAL AND REPLACEMENT  
SCALE: 1/4" = 1'-0"

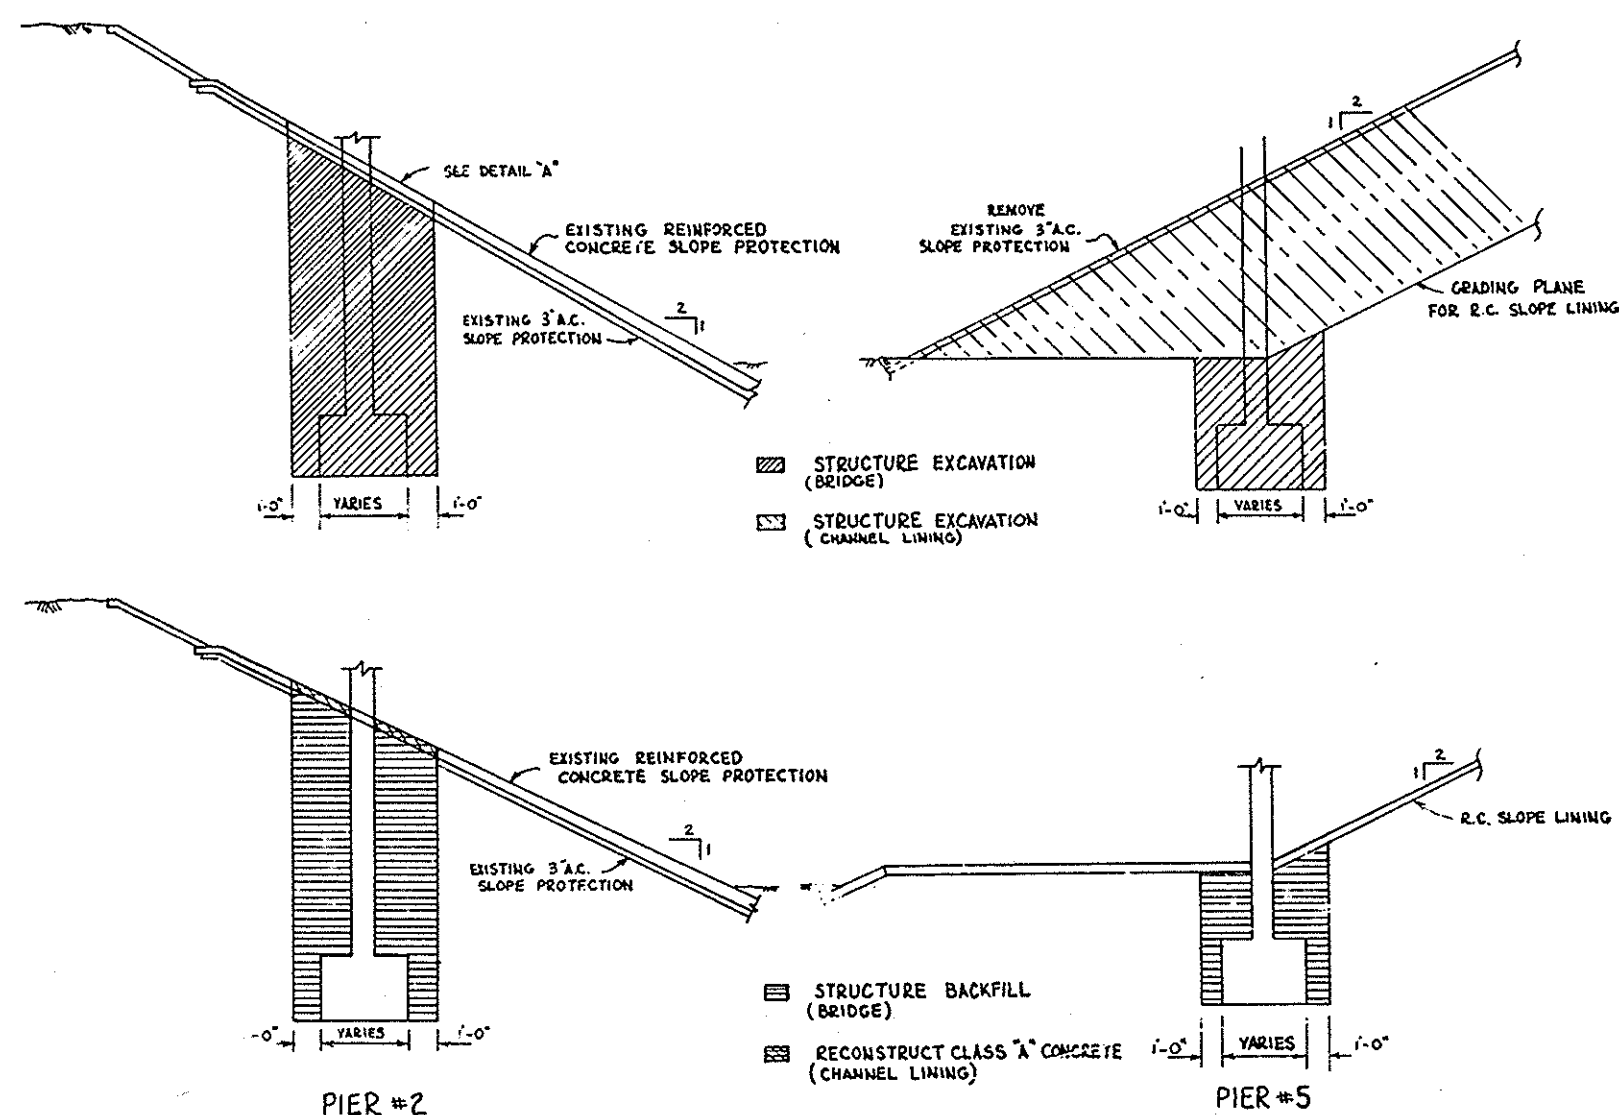


TYPICAL EXCAVATION & BACKFILL (BRIDGE)  
NO SCALE

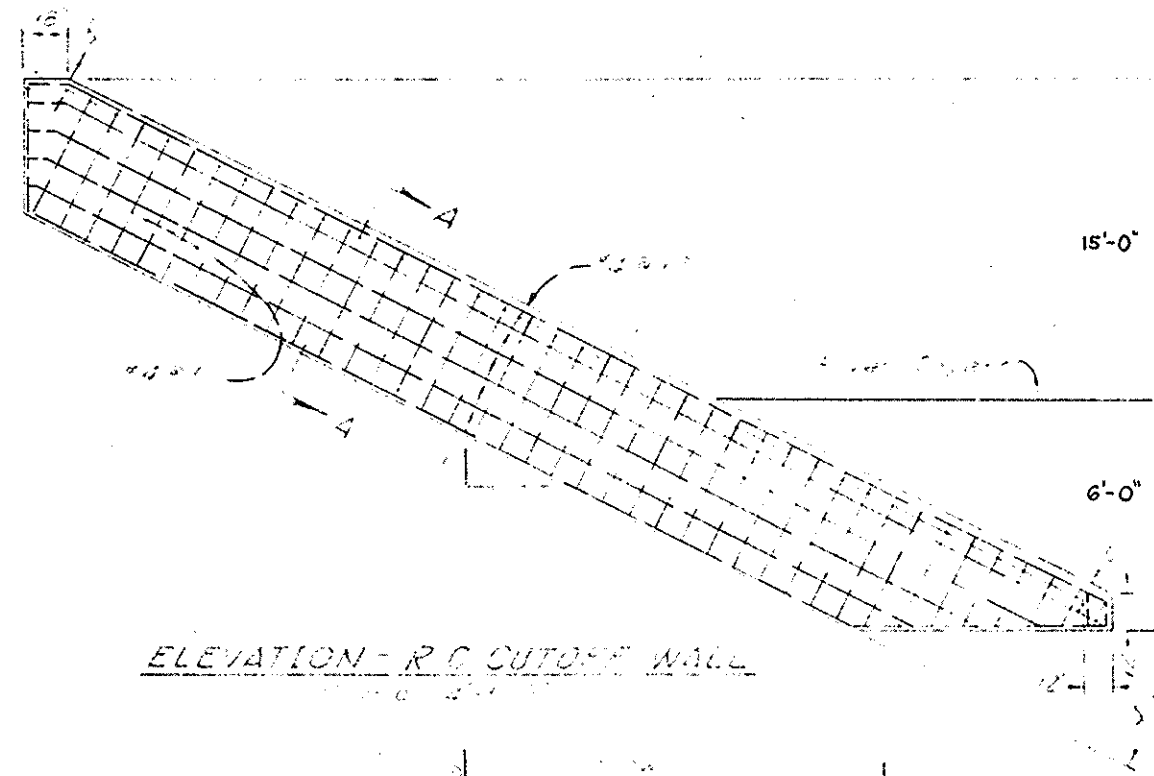


ELEVATION - R.C. CUTOFF WALL

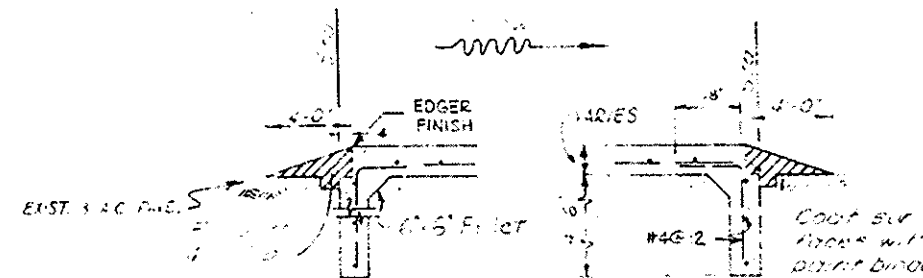

SECTION A-A SECTION A-A  
R.C. CUTOFF WALL R.C. CUTOFF WALL

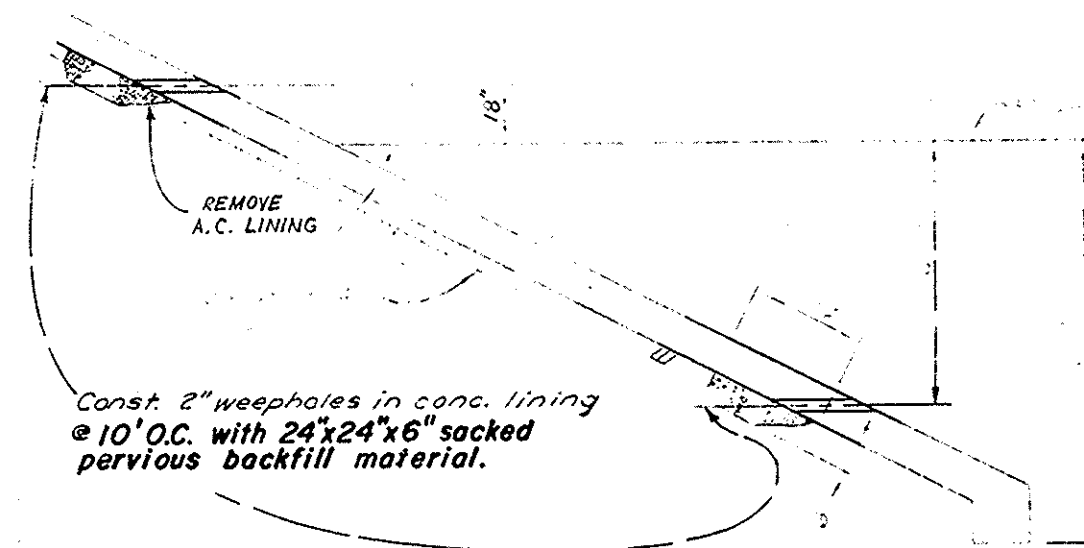

TYPICAL SECTION  
GRAVEL DRAIN

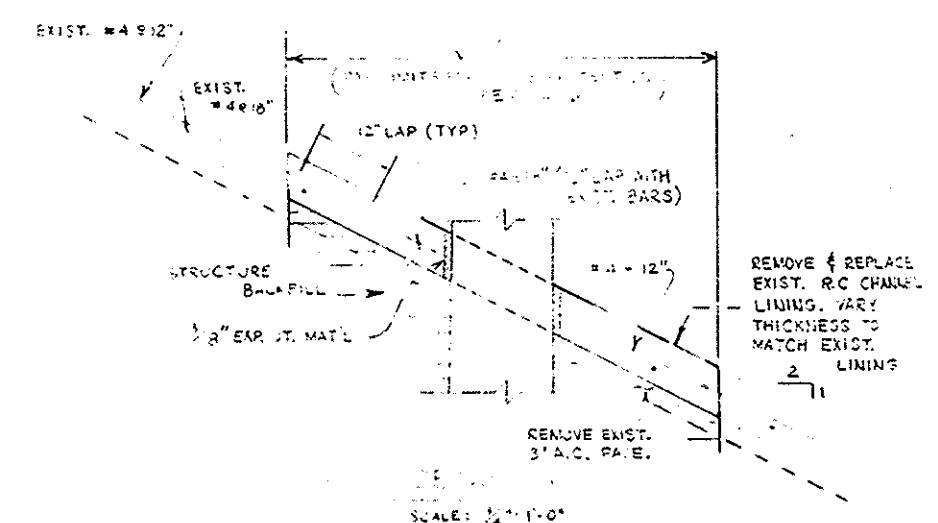

SCALE: 1/4" = 1'-0"

#11159  
BRIDGE SA-31  
SHEET 15 OF 15  
RSD, 22.5.11  
SEPTA

|                                                           |          |
|-----------------------------------------------------------|----------|
| SPRING COUNTY ROAD DEPARTMENT                             |          |
| SLATER-<br>SEGERSTROM BRIDGE<br>SA-31                     |          |
| LEVEE EXCAVATION & BACKFILL<br>- SLOPE PROTECTION DETAILS |          |
| AS SHOWN                                                  | 15 OF 15 |

DR. 12 (11359)