



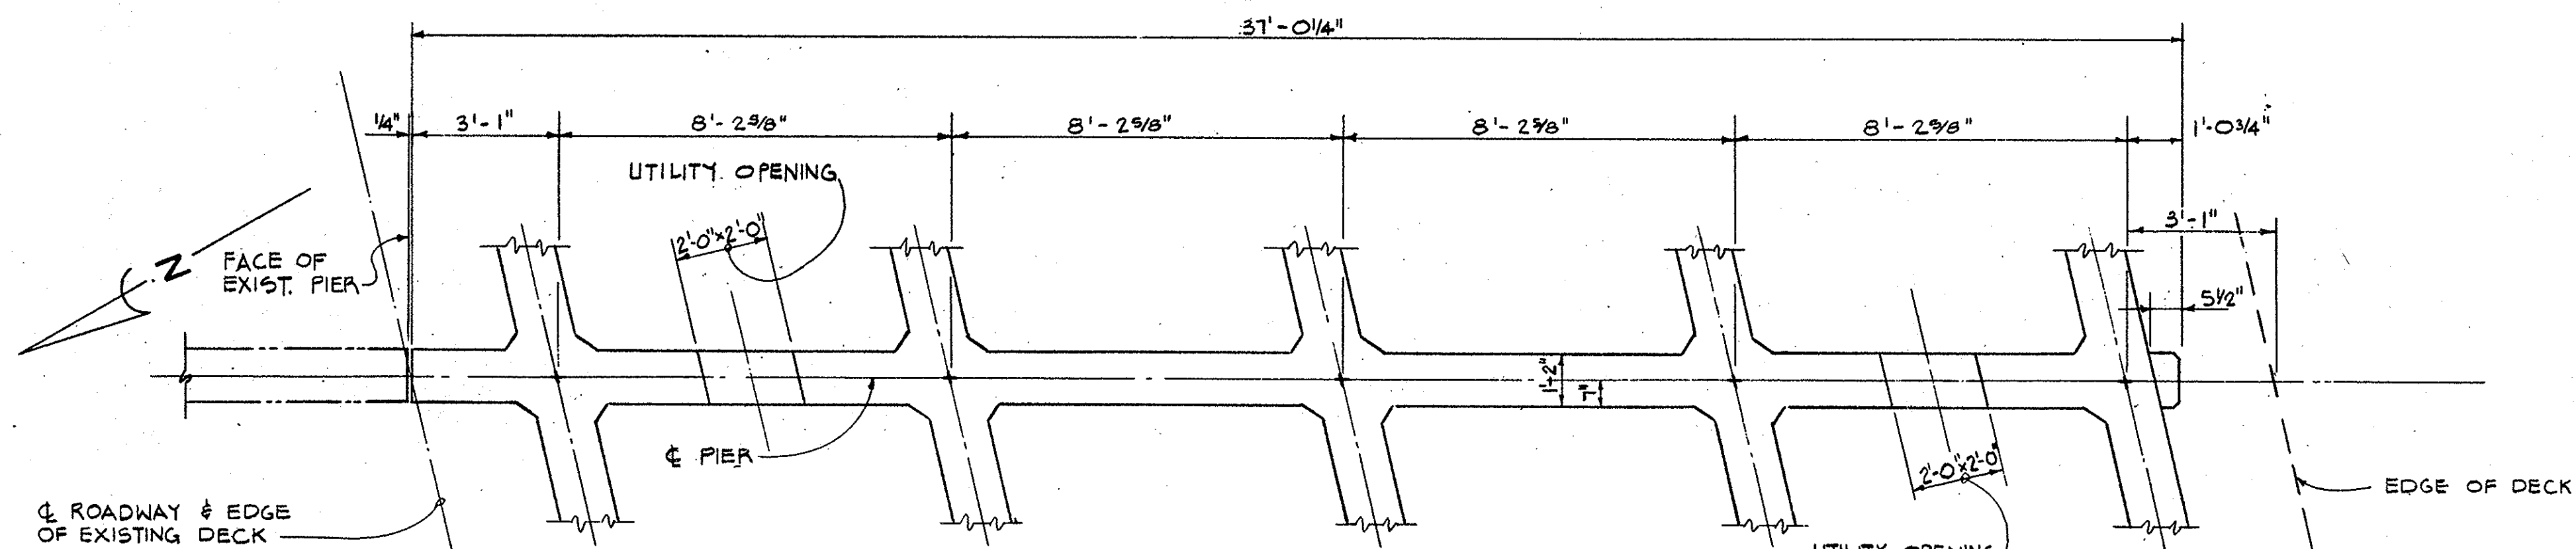


SECTION A-A
SCALE: 3/8" = 1'-0"

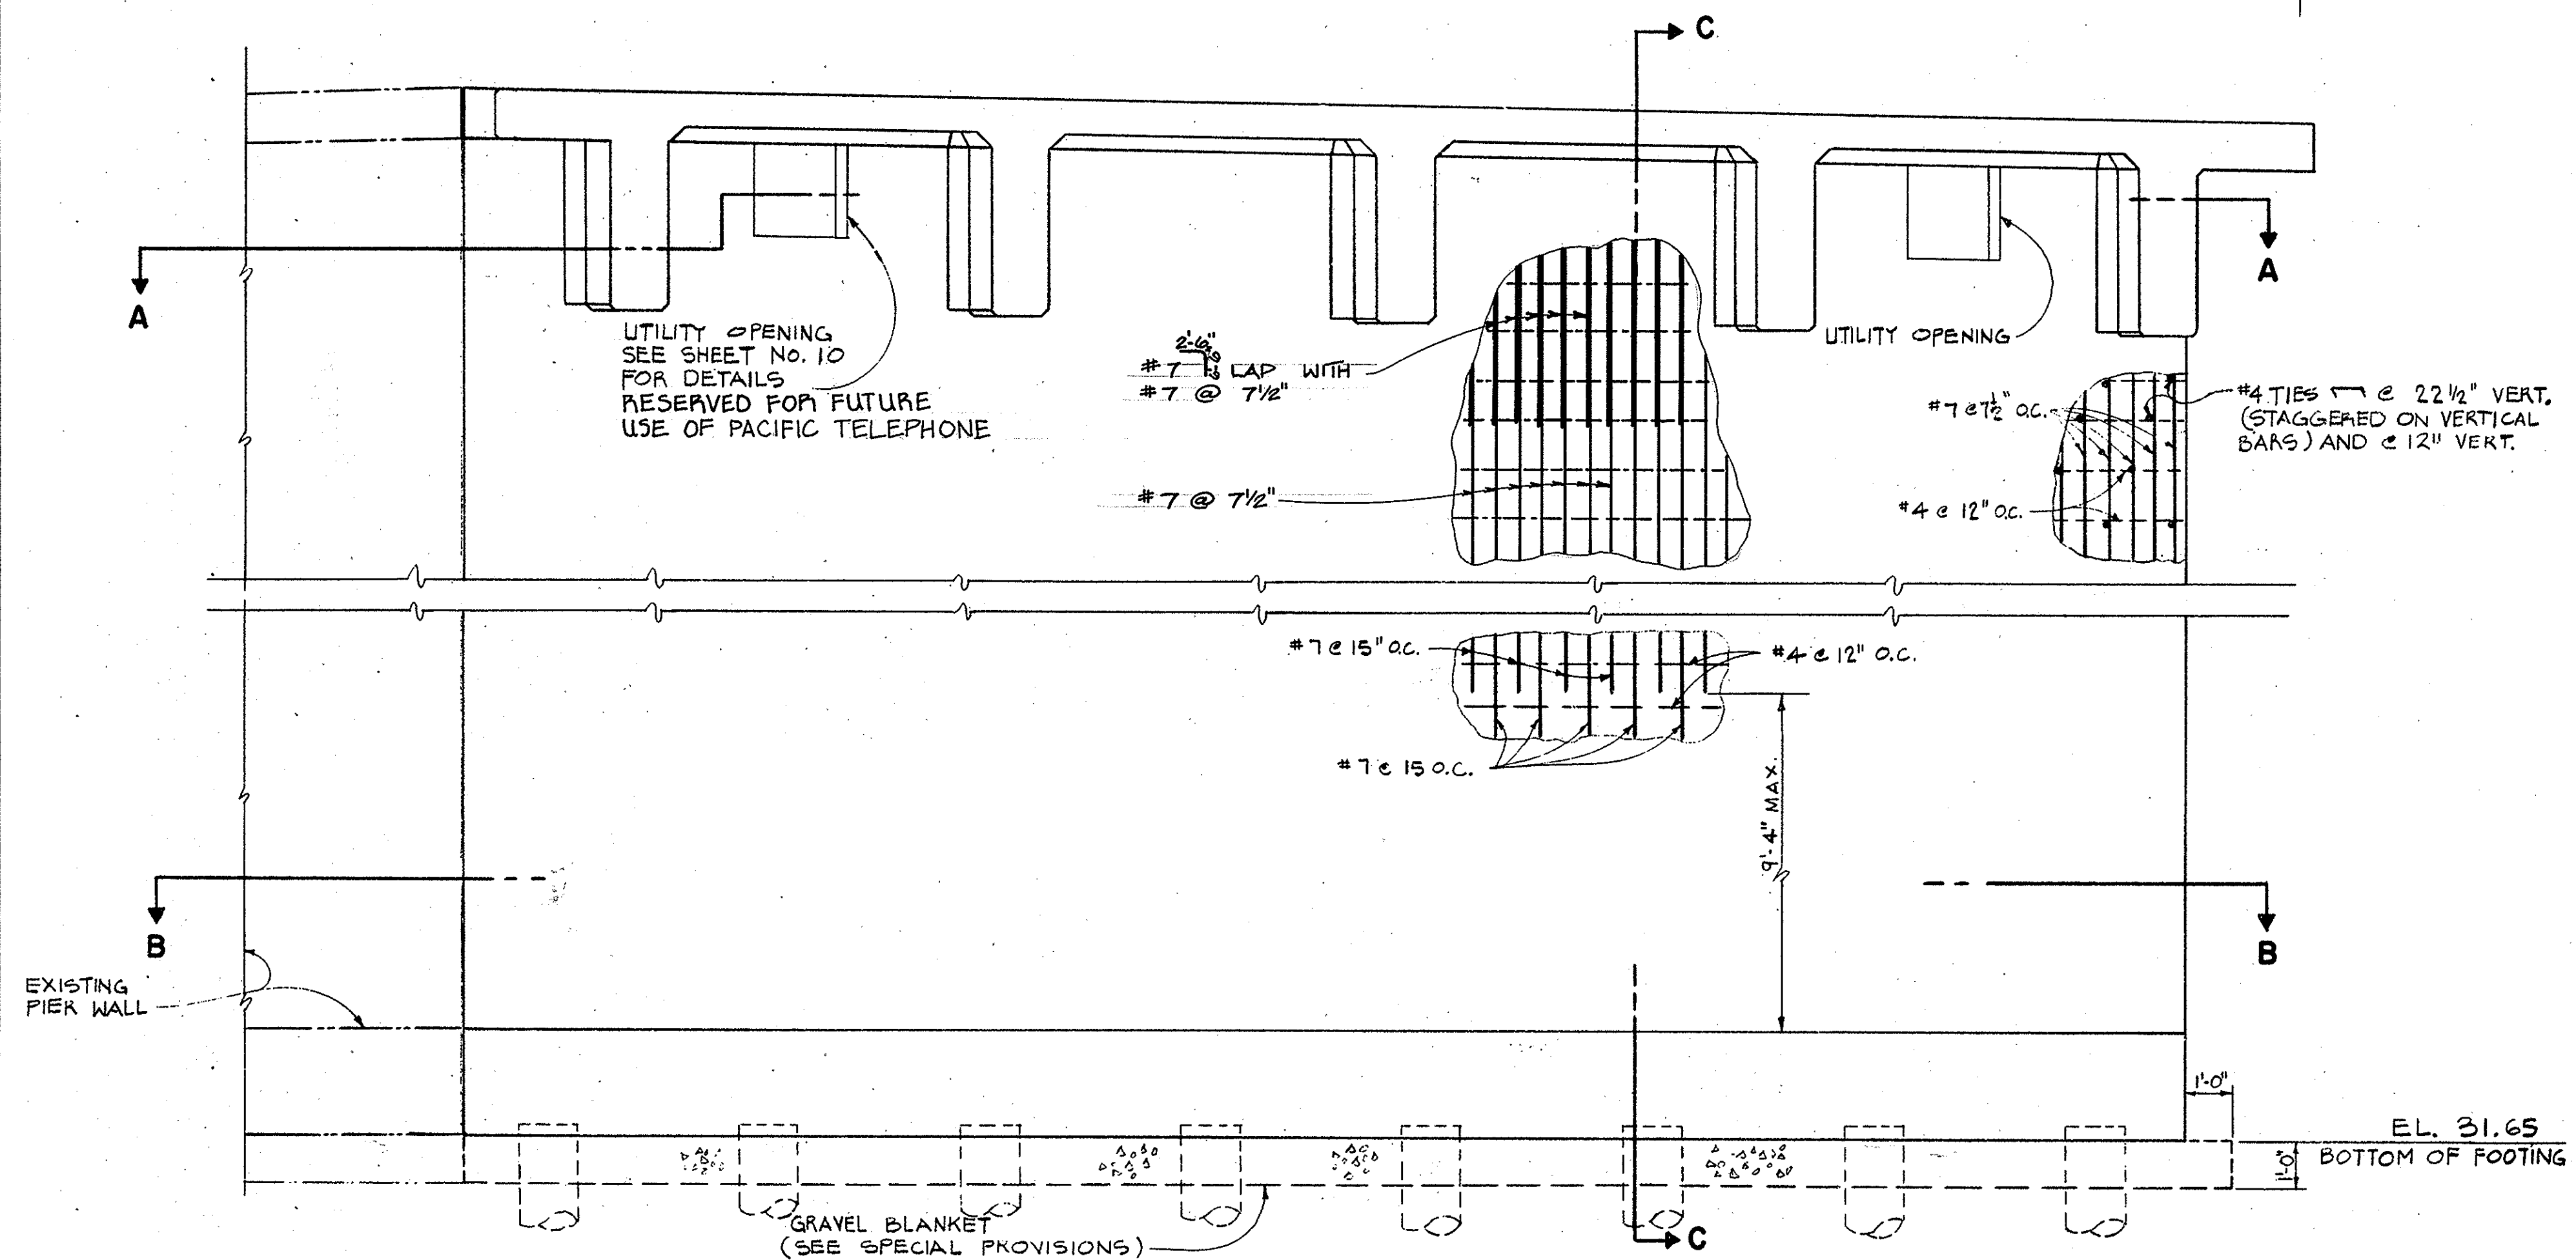


ELEVATION
SCALE: 3/8" = 1'-0"


NOTE: VIEW LOOKS AHEAD ON STATION.

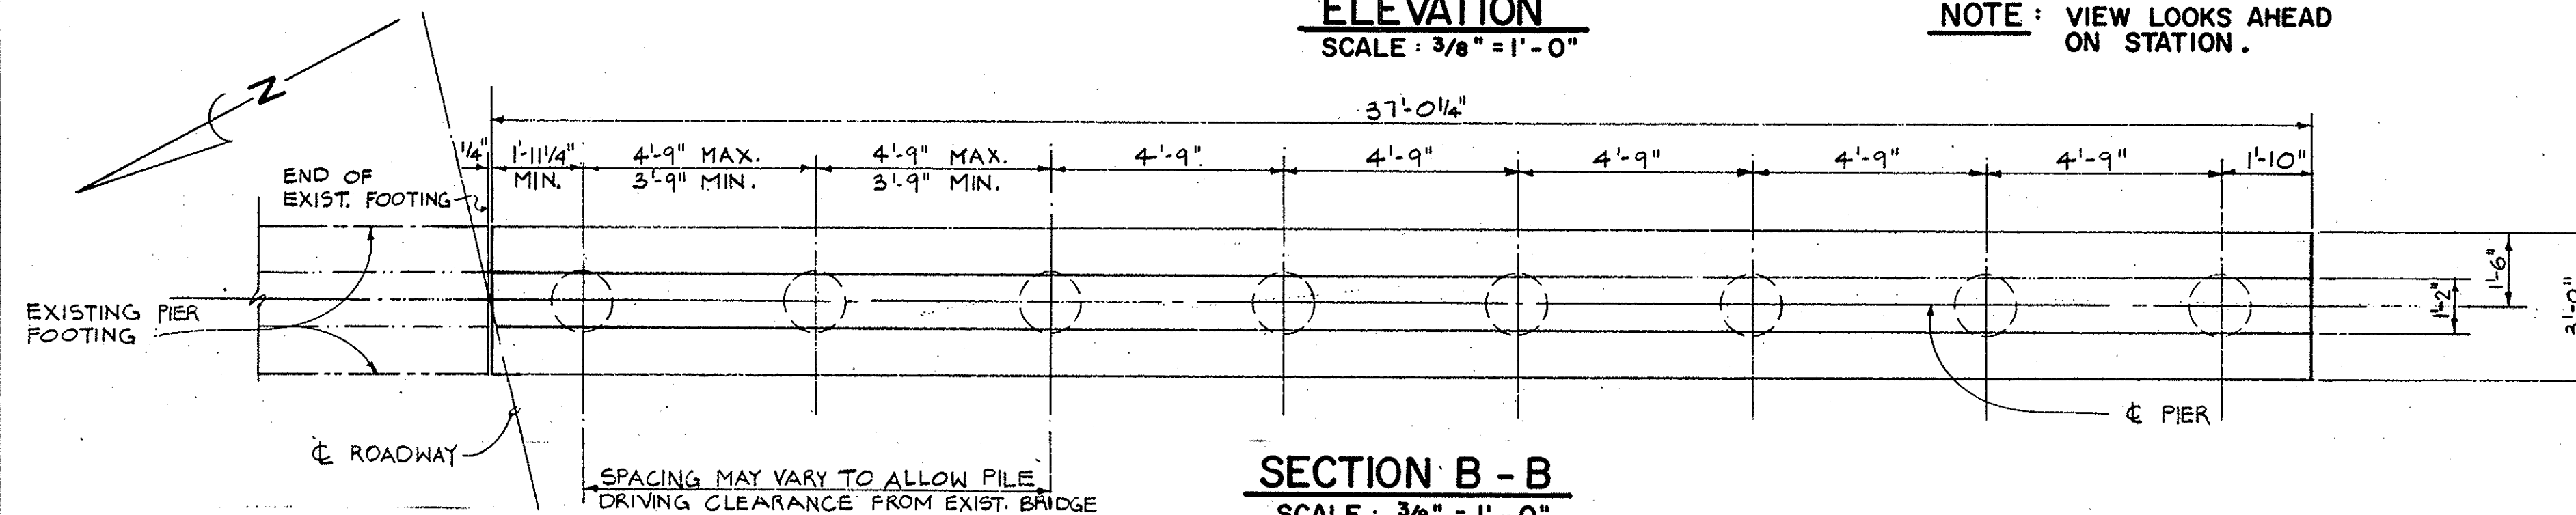


SECTION B-B
SCALE: 3/8" = 1'-0"

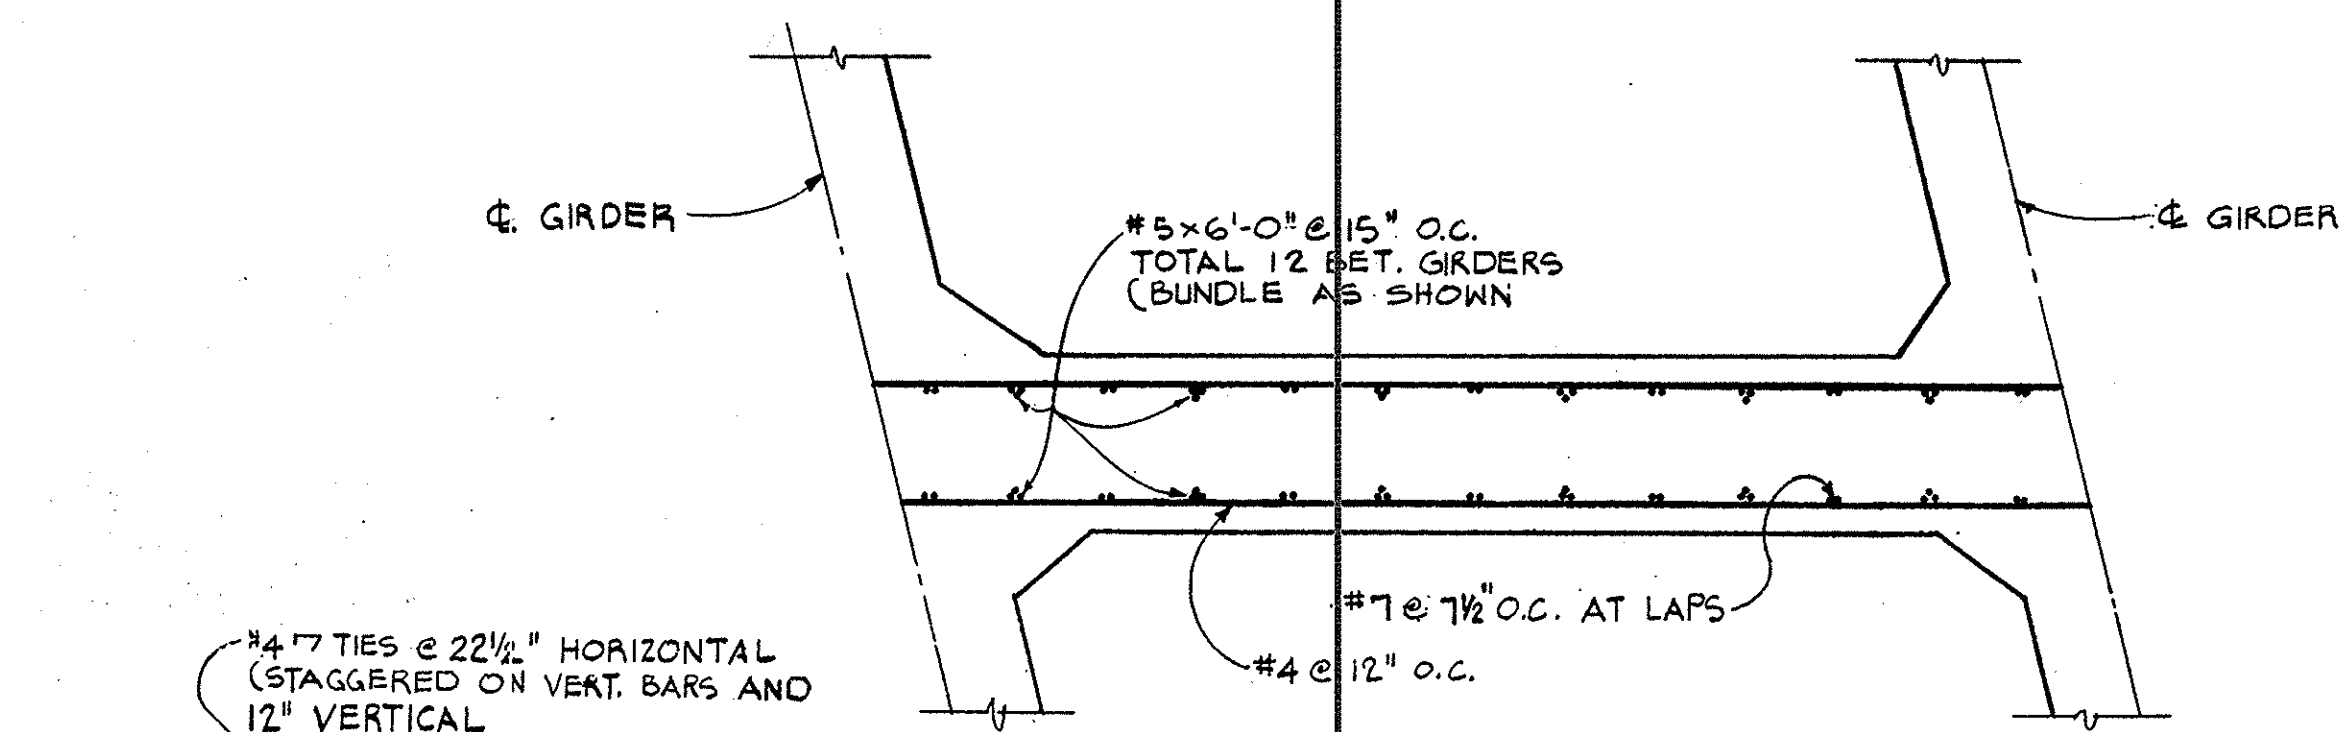

SECTION D-D
SCALE: 3/4" = 1'-0"

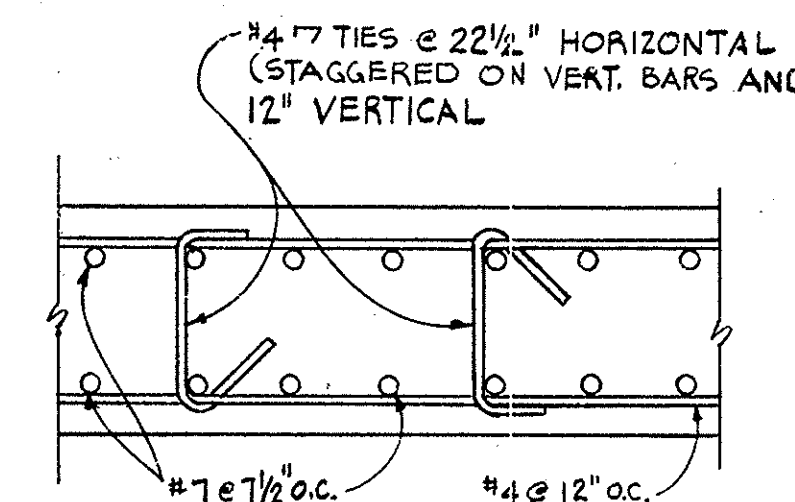

SECTION E-E
SCALE: 1" = 1'-0"

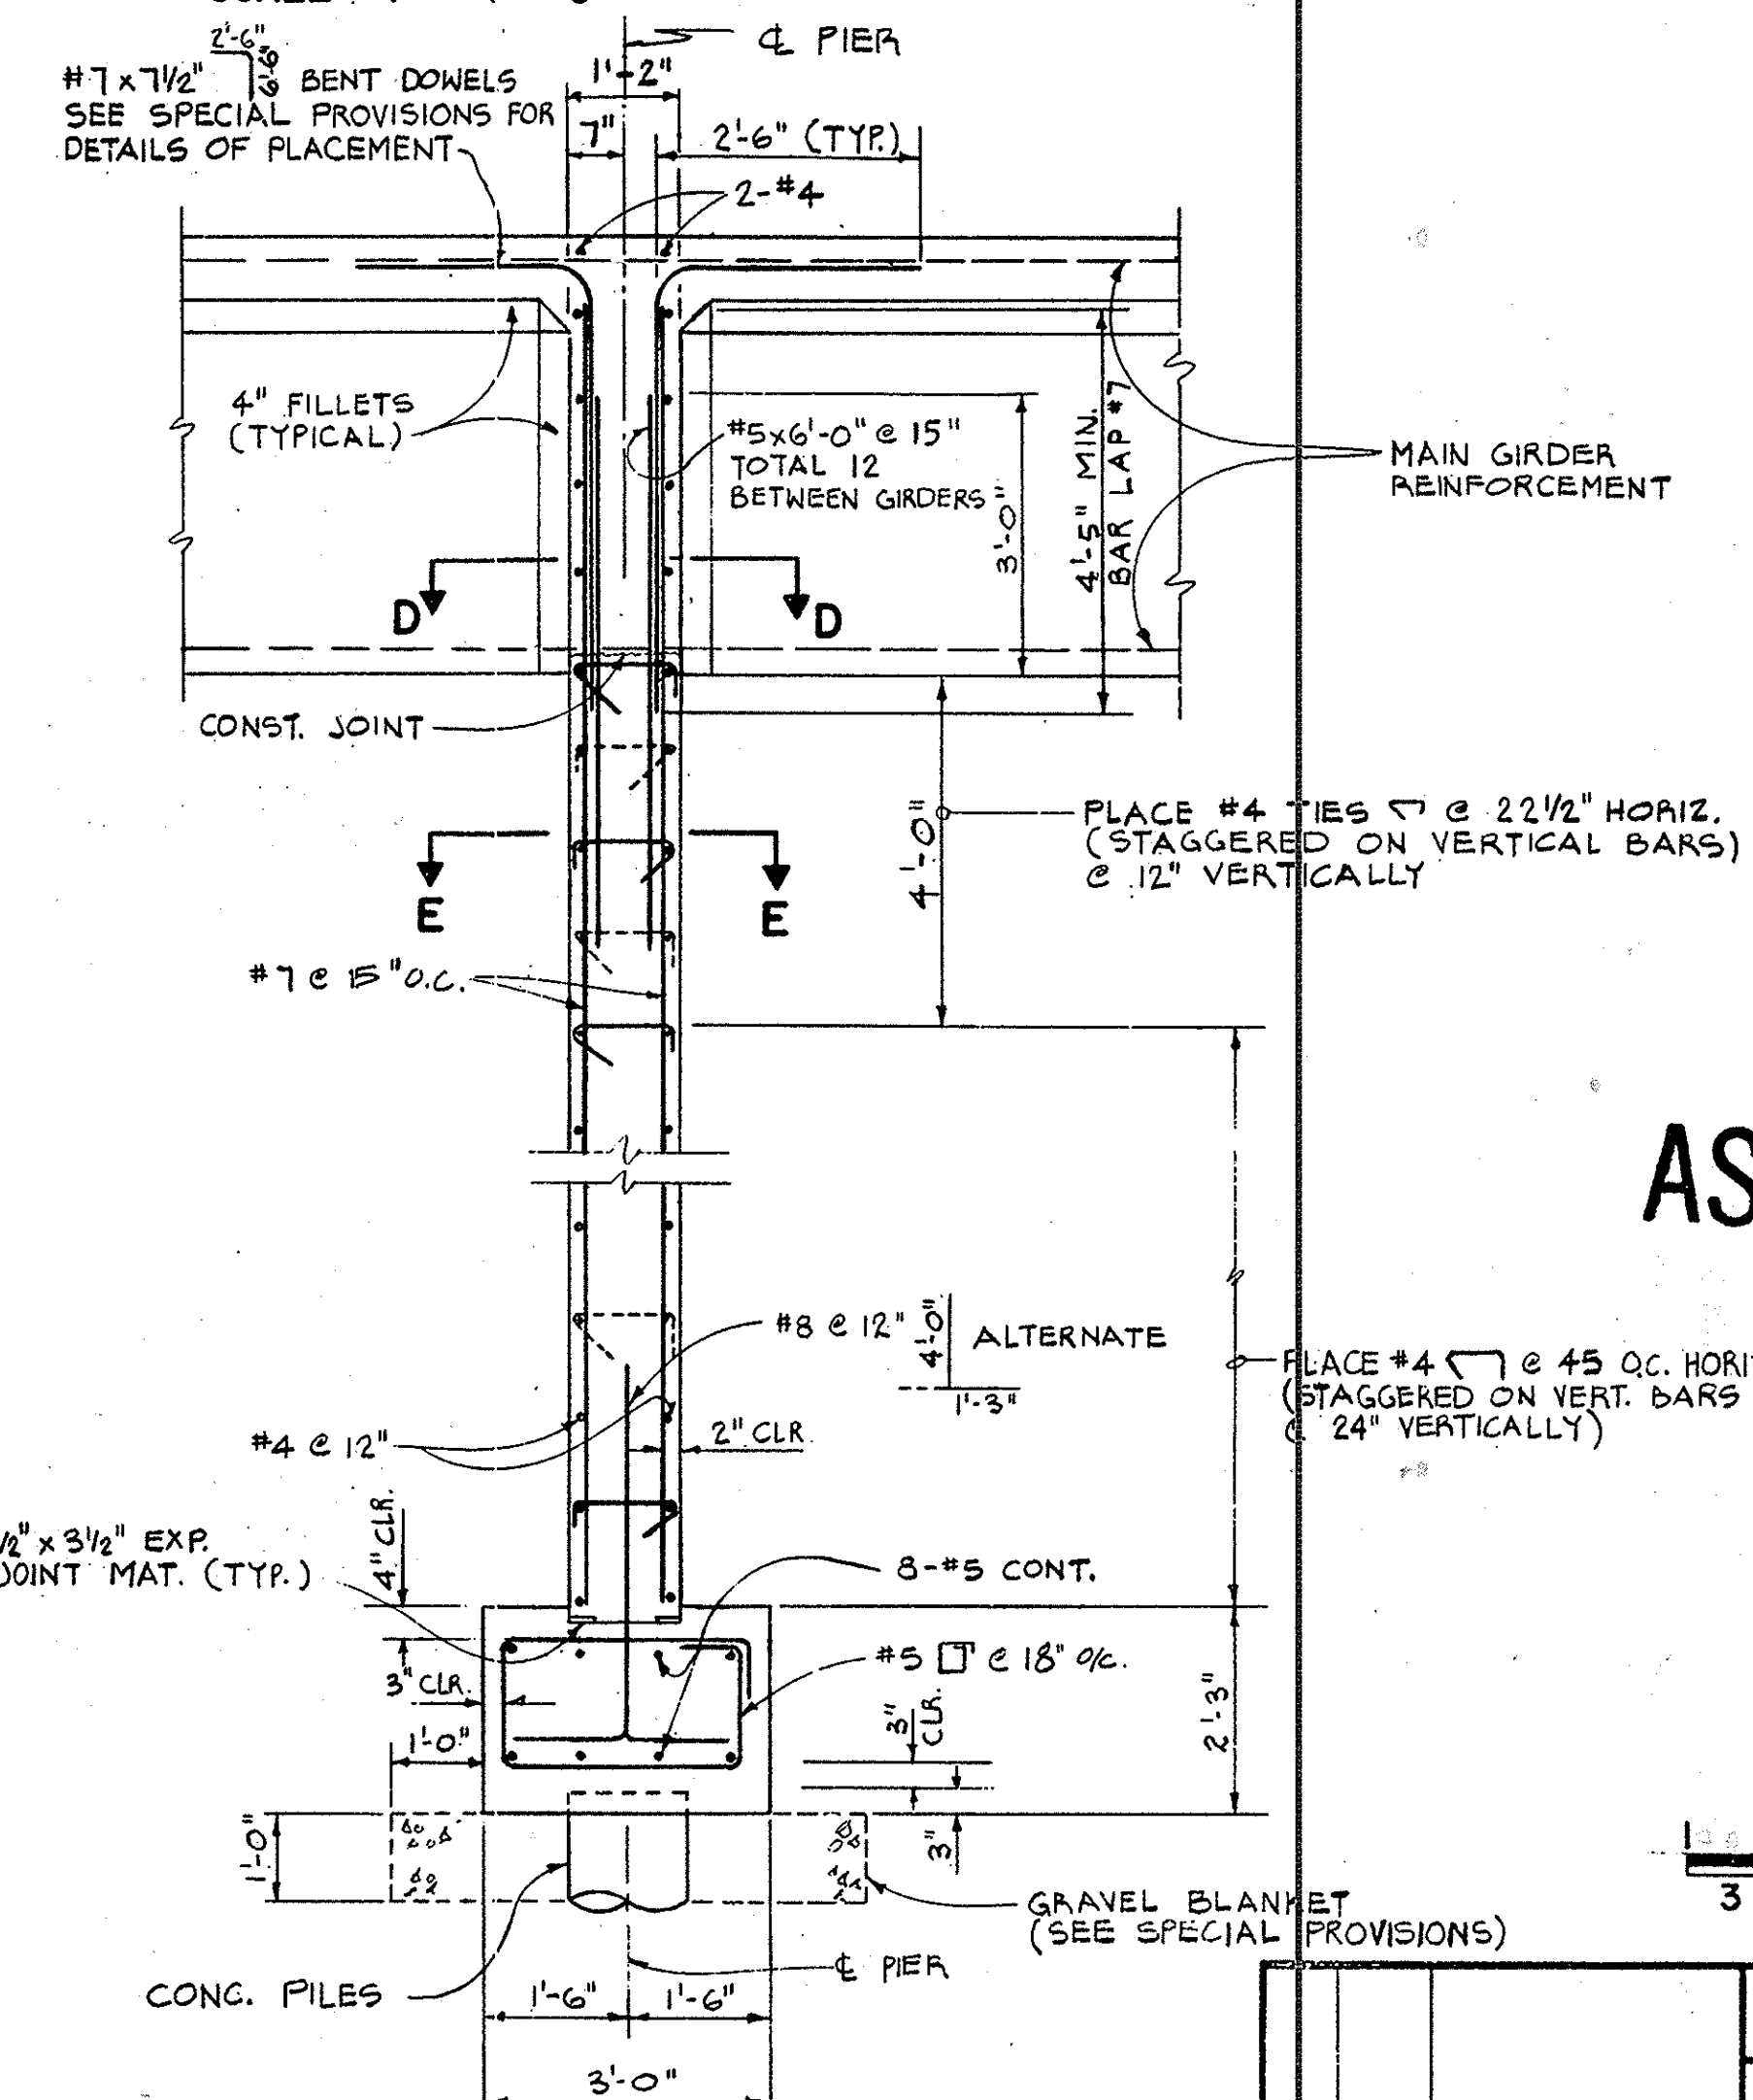

SECTION C-C
SCALE: 1/2" = 1'-0"

AS BUILT

1 1/2 0 1 2
3 inches on original drawing

WHEELER & GRAY
CONSULTING ENGINEERS

Abraham W. Gray
S.E. # 918

ORANGE COUNTY
ENVIRONMENTAL MANAGEMENT AGENCY
SLATER-SEGERSTROM BRIDGE
(SA-31A) WIDENING OVER
SANTA ANA RIVER (EOI)

PIER DETAILS

MARK	DATE	DESCRIPTION	PREPARED UNDER SUPERVISION OF	DATE	SHEET
REVISIONS					
DESIGNED	W.F. POND	SCALE	DATE	DWG. NO.	5
DRAWN	E.G.	CHECKED	W.F.P.	AS SHOWN	