




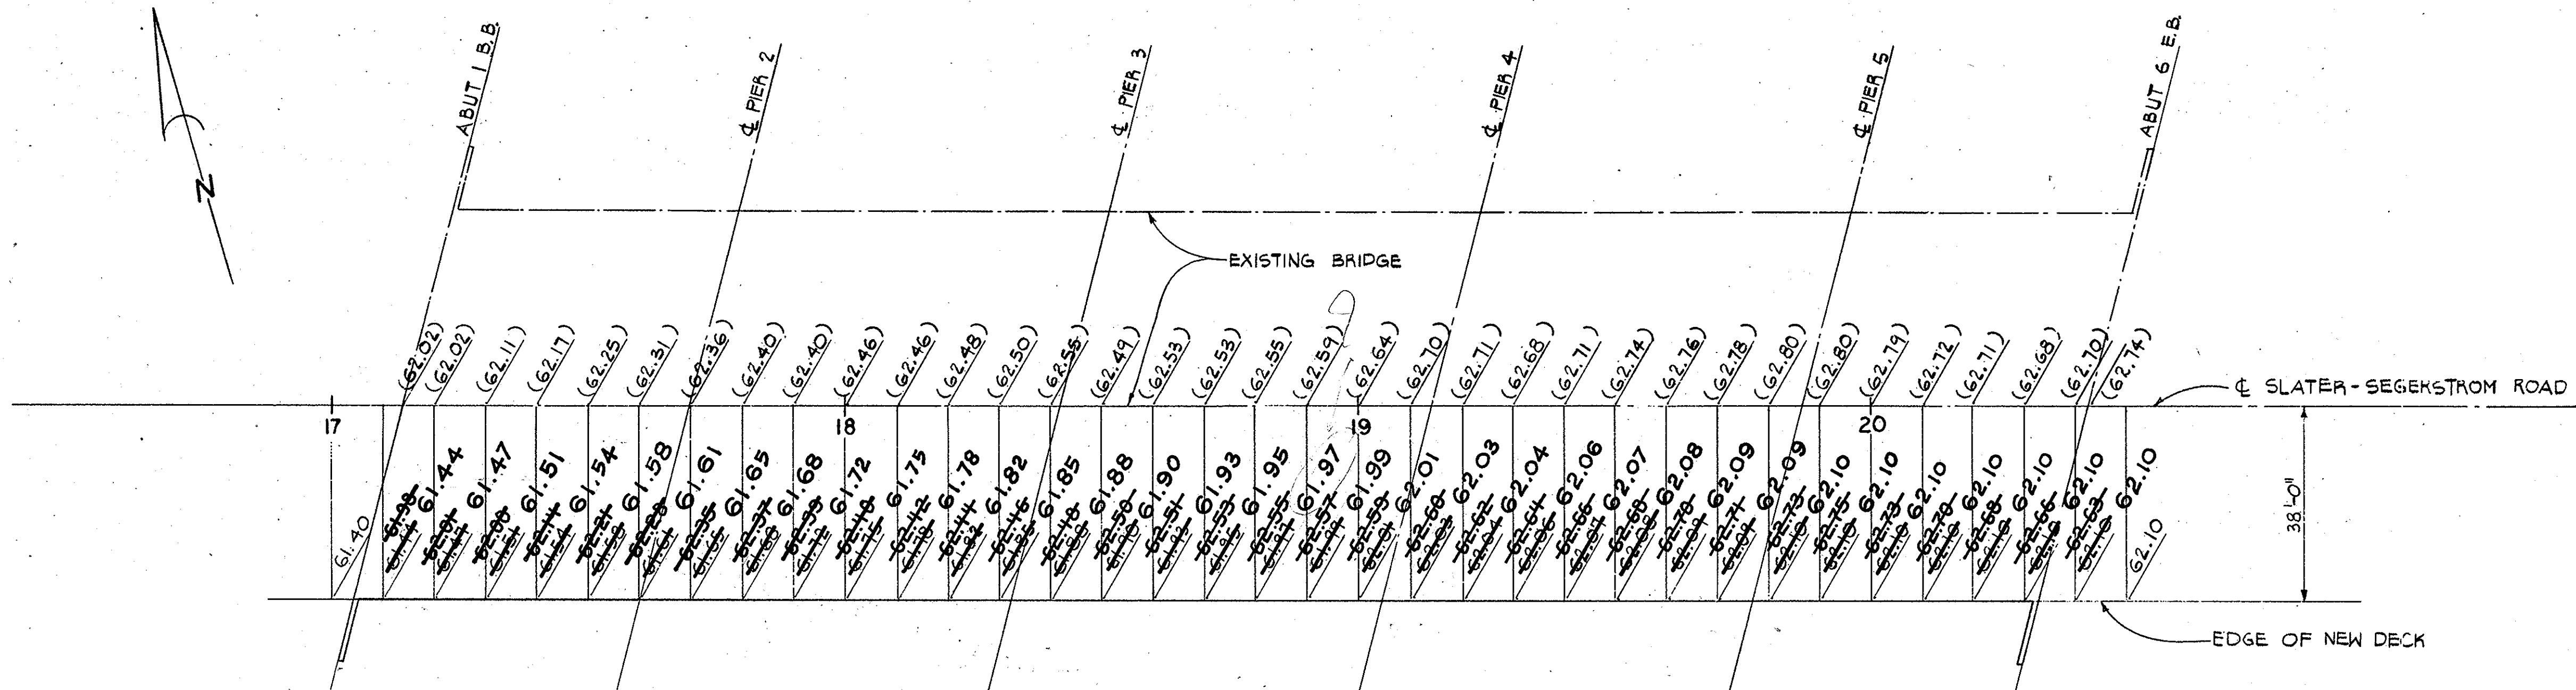

DECK GRADES
SCALE: 1" = 20'
() ARE EXISTING EDGE OF DECK GRADES

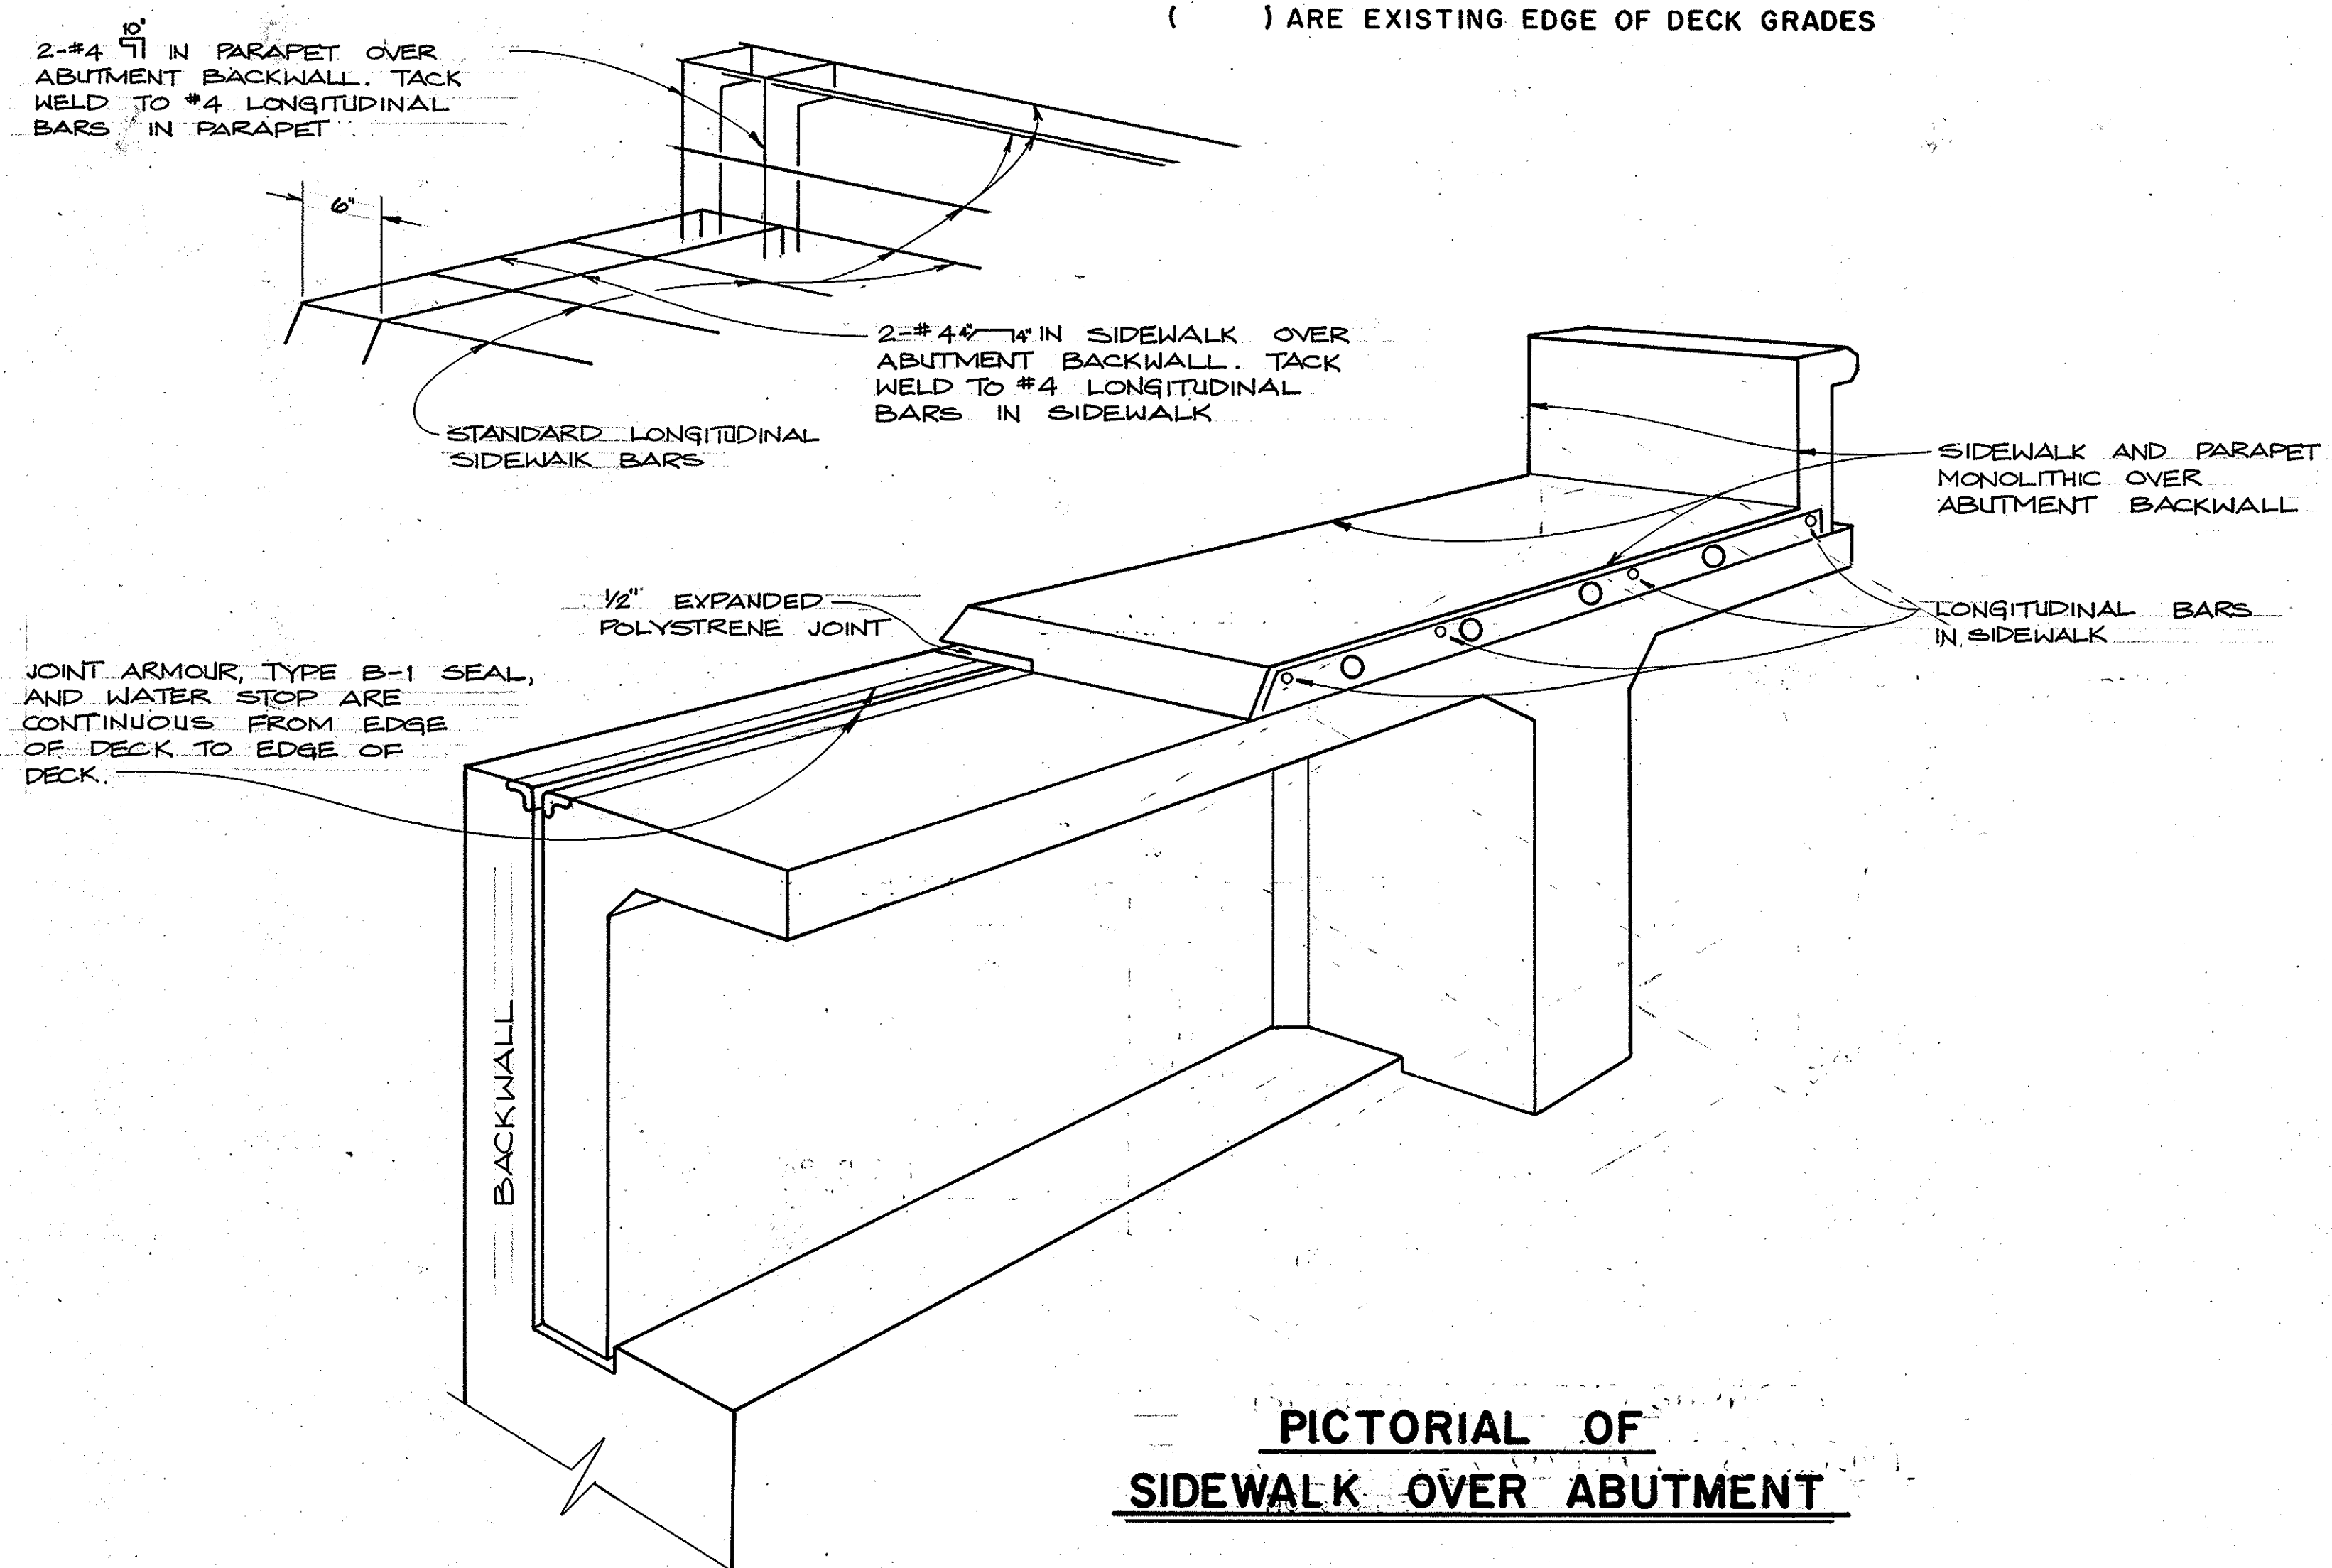

**PICTORIAL OF
SIDEWALK OVER ABUTMENT**

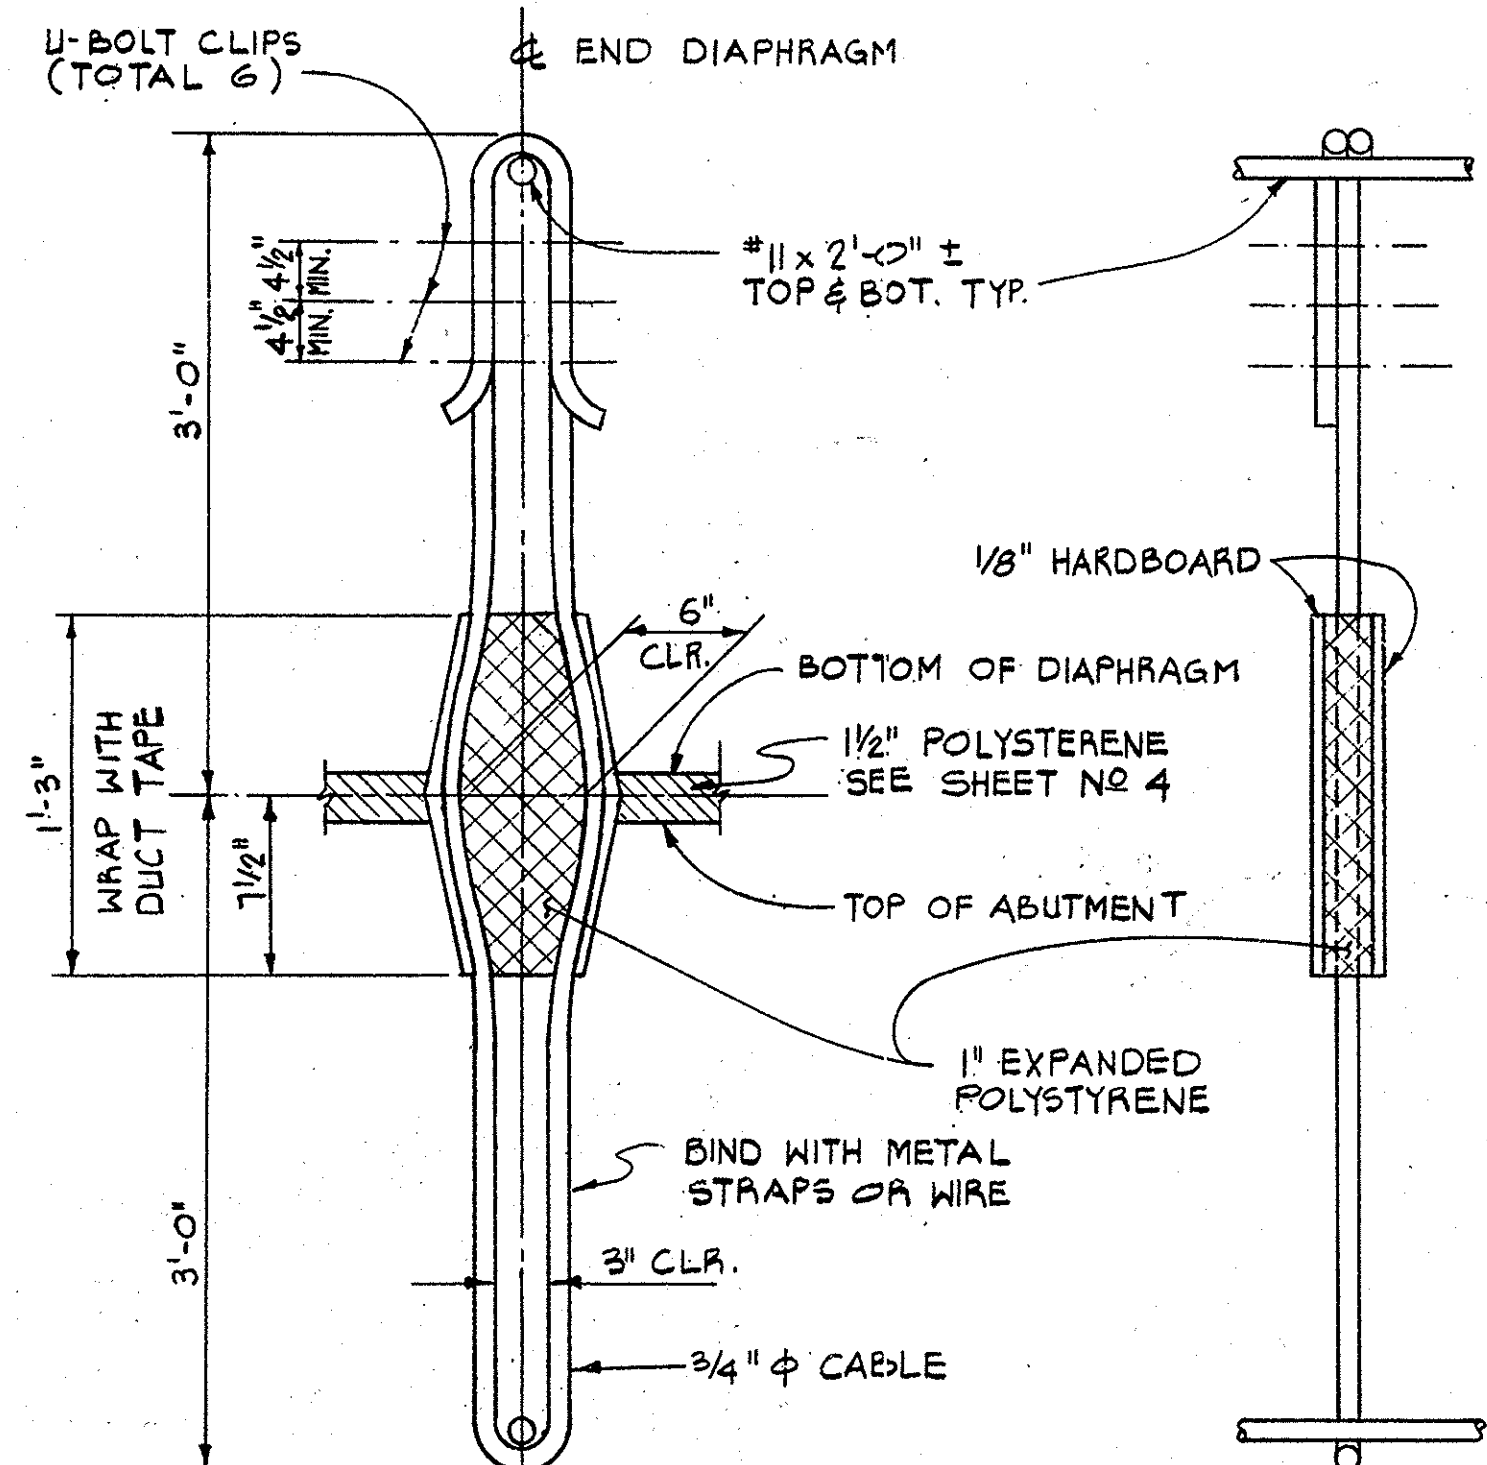

**ELEVATION
SECTION
VERTICAL RESTRAINER
NO SCALE**

MEASURED 1/18/82

SETTLEMENT PIN ELEVATIONS		
LOCATIONS	RIGHT SIDE (DECK PIN)	LEFT SIDE (DECK PIN)
ABUTMENT N°1	61.40	61.57
SPAN N°1	65.65	61.70
PIER N°2	61.92	61.89
SPAN N°2	61.93	61.96
PIER N°3	62.04	62.09
SPAN N°3	62.03	62.11
PIER N°4	62.14	62.22
SPAN N°4	62.16	62.26
PIER N°5	62.27	62.29
SPAN N°5	62.17	62.22
ABUTMENT N°6	62.12	62.24

DESCRIPTION OF DATUM:
T.B.M. ELEV. 59.27
NAIL & TIN 85' S'LY OF E. OF SLATER
AVE. SET IN TOP OF W'LY A.C. DIKE
OF S'LY ACCESS RAMP.

NOTE:
FOR USE OF RESIDENT ENGINEER
UPON COMPLETION OF CONSTRUCTION.
* DECK PIN @ 6" FROM CURB FACE.

NOTE:
DURING CONCRETE POUR FOR END
DIAPHRAGMS, VERTICAL RESTRAINER
UNITS SHALL BE DRAWN TAUT
AND PLUMB.

AS BUILT

1 1/2 0 1 2
3 inches on original drawing

WHEELER & GRAY CONSULTING ENGINEERS		S.E.# 918	
ORANGE COUNTY ENVIRONMENTAL MANAGEMENT AGENCY			
SLATER-SEGERSTROM BRIDGE (SA-31A) WIDENING OVER SANTA ANA RIVER (EOI)			
MISCELLANEOUS DETAILS			
7-83 AS BUILT		PREPARED UNDER SUPERVISION OF <i>James H. Foster</i> 5-11-83	
DATE	DESCRIPTION	SCALE	DATE
DESIGNED W.F.POND	REVISIONS	AS SHOWN	DWG. NO.
DRAWN E.G.	CHECKED W.F.P.		