

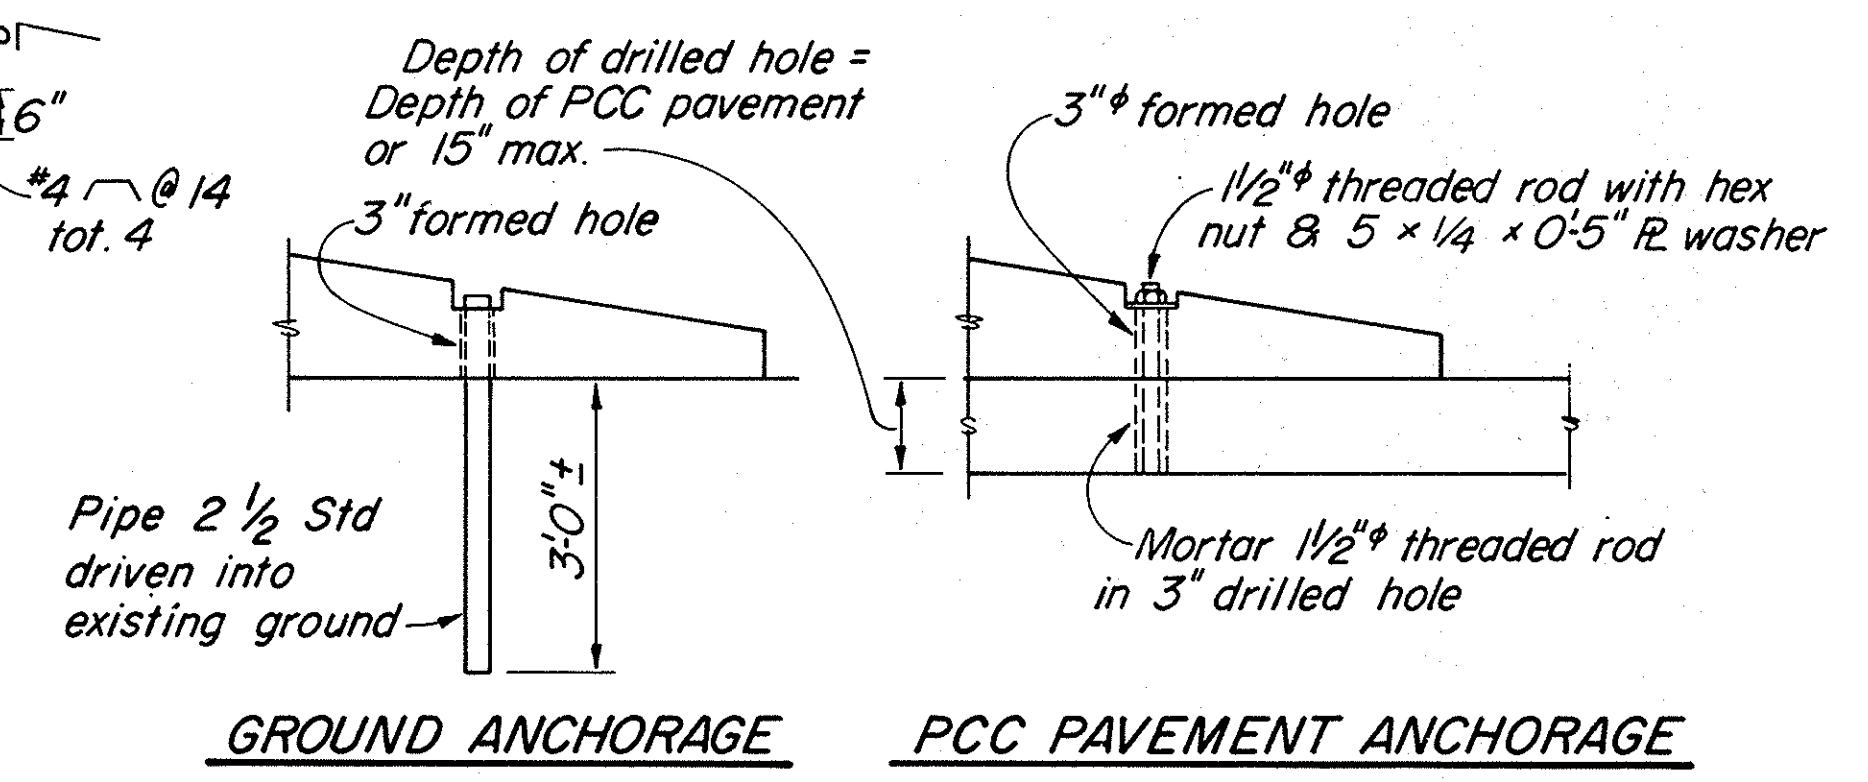
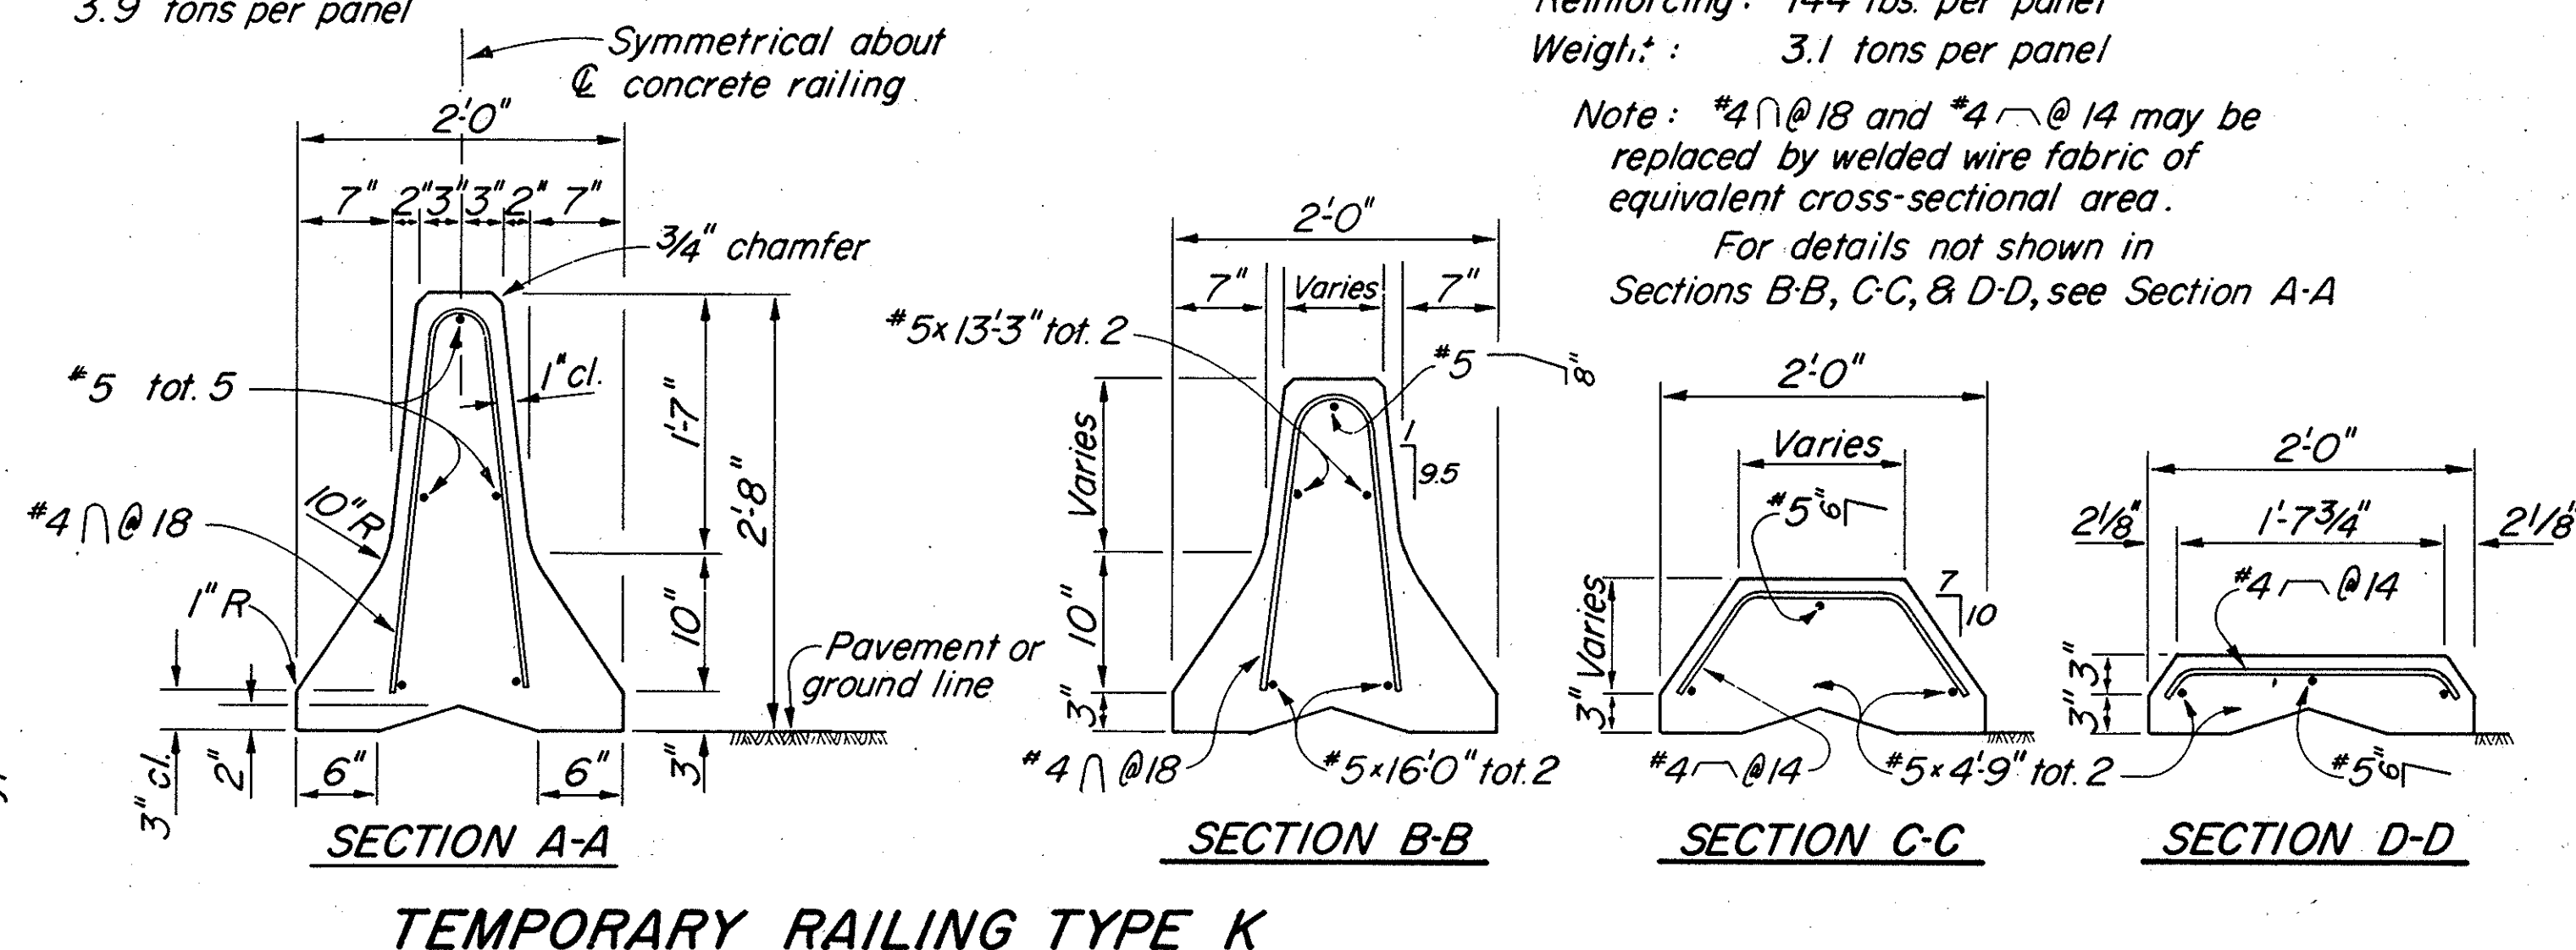


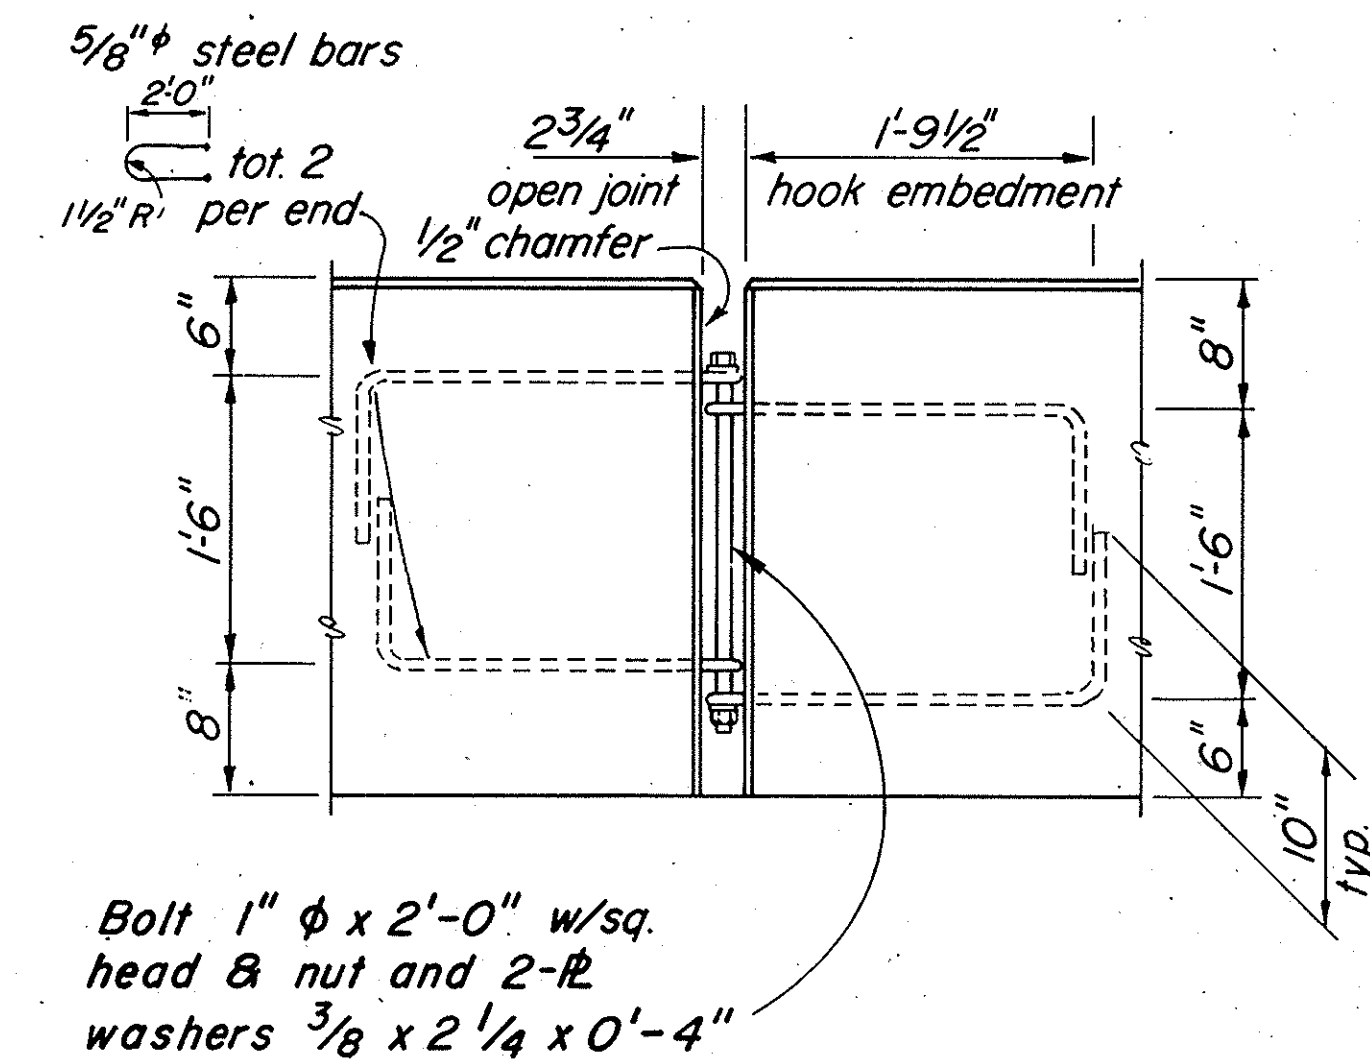

- NOTES:**
- Alternative details for lifting the precast concrete panels of the Temporary Railing Type K may be submitted by the Contractor for the Engineer's approval.
 - All Temporary Railing Type K shall become the property of the Orange County EMA. See Special Provisions.

AS BUILT

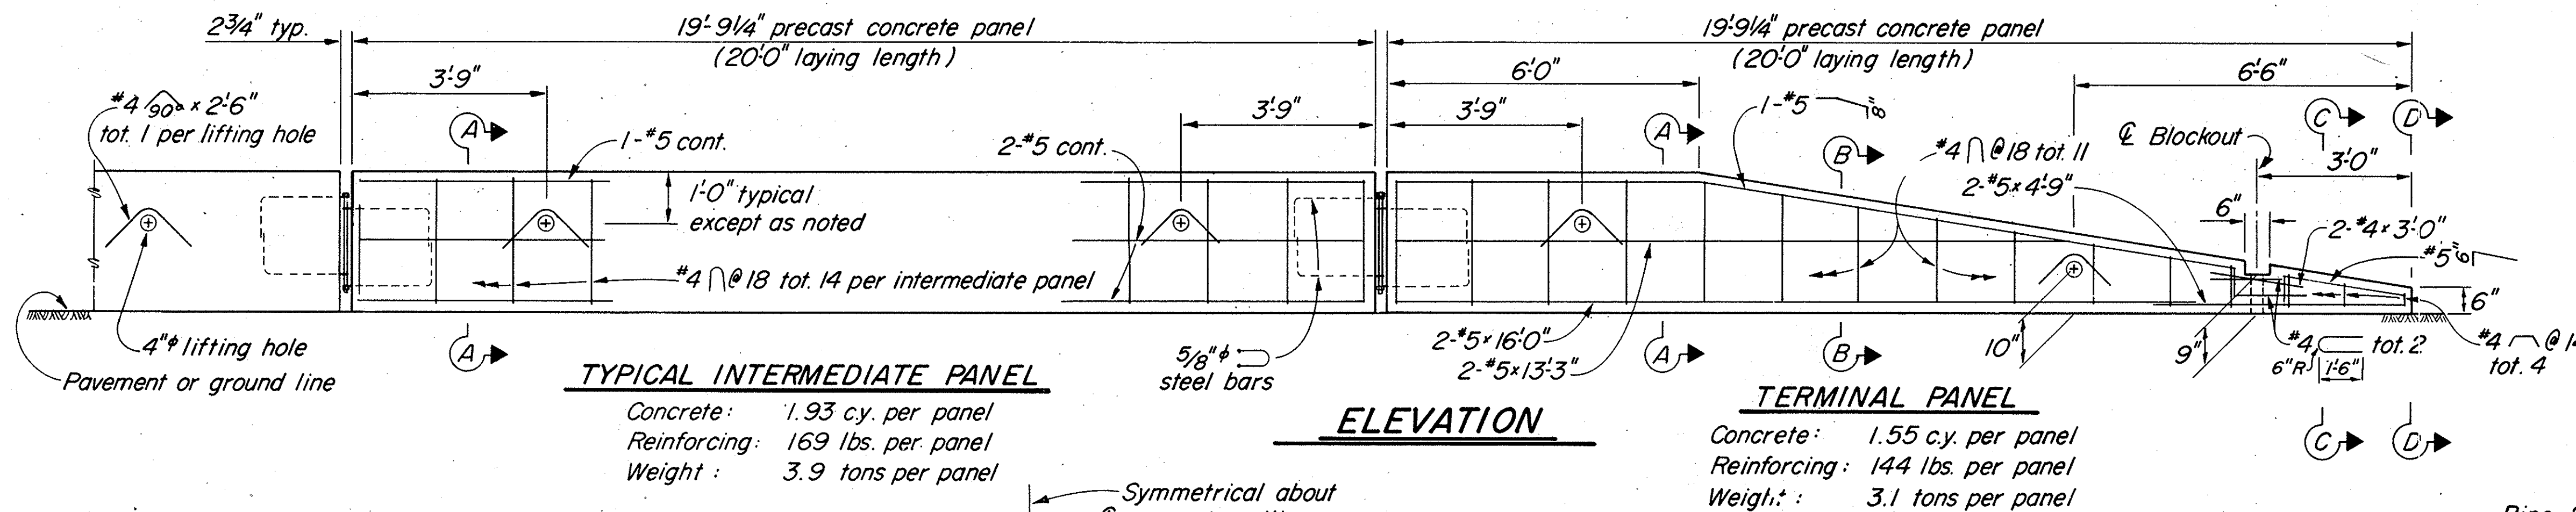

WHEELER & GRAY CONSULTING ENGINEERS S.E. #918		ORANGE COUNTY ENVIRONMENTAL MANAGEMENT AGENCY SLATER-SEGERSTROM BRIDGE (SA-31A) WIDENING OVER SANTA ANA RIVER (EOI)	
		TEMPORARY RAILING	
MARK: A DATE: 5-11-81	DESCRIPTION: 7-83 AS BUILT	PREPARED UNDER SUPERVISION OF:	SHEET: 13
REVISIONS DESIGNED: W.F. POND DRAWN: E.G. CHECKED: W.F.P.		SCALE: AS SHOWN DATE:	DWG. NO.: