



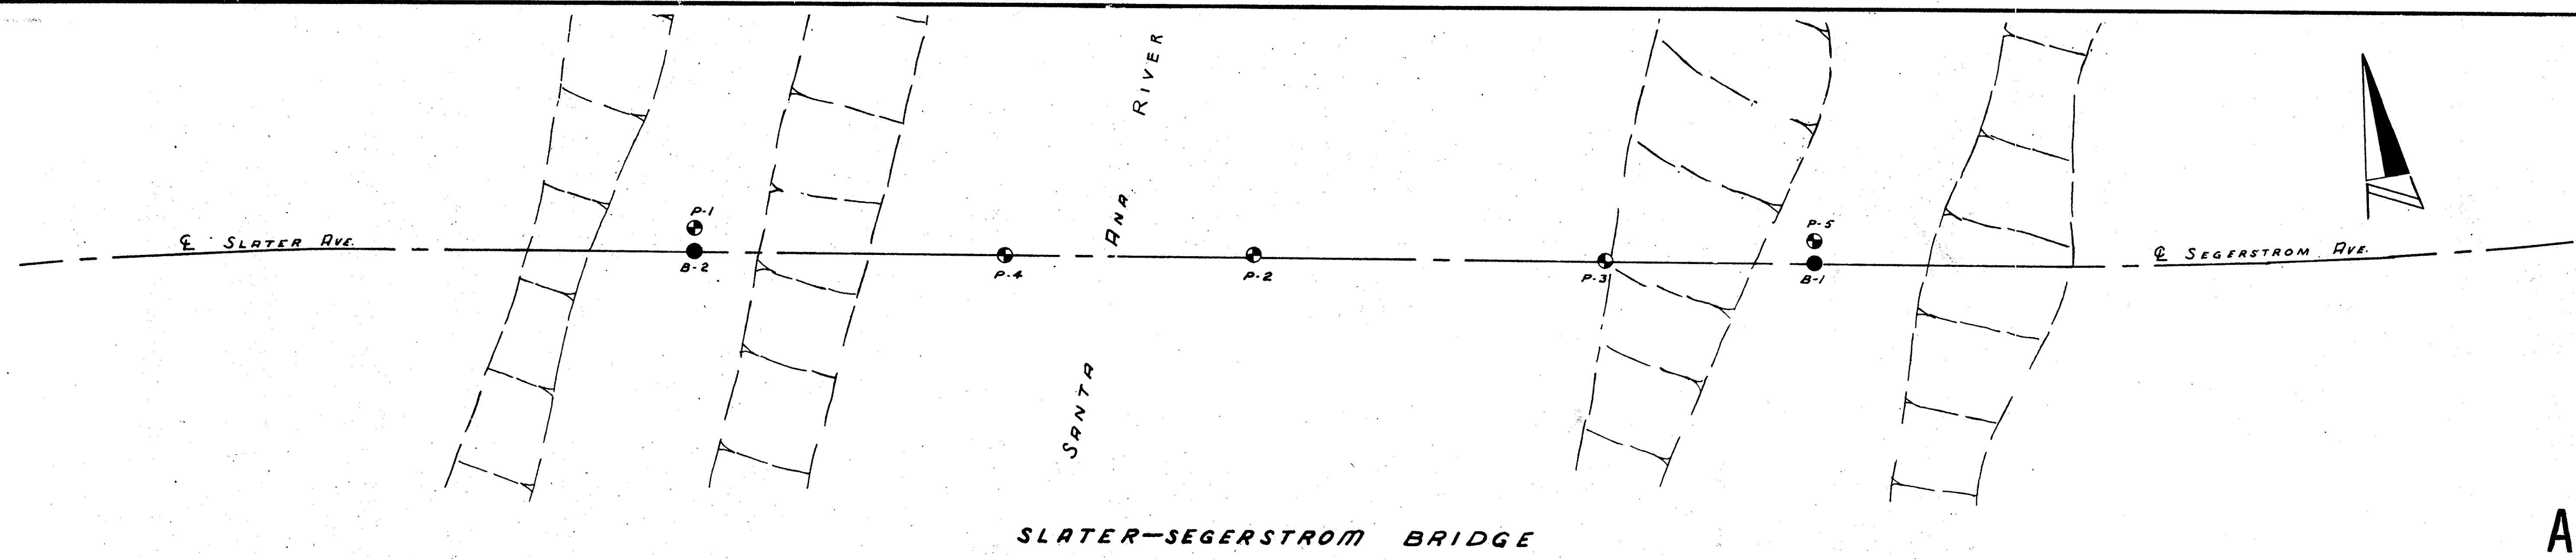

WHEELER & GRAY
CONSULTING ENGINEERS
[Signature]
S.E. #918

AS BUILT

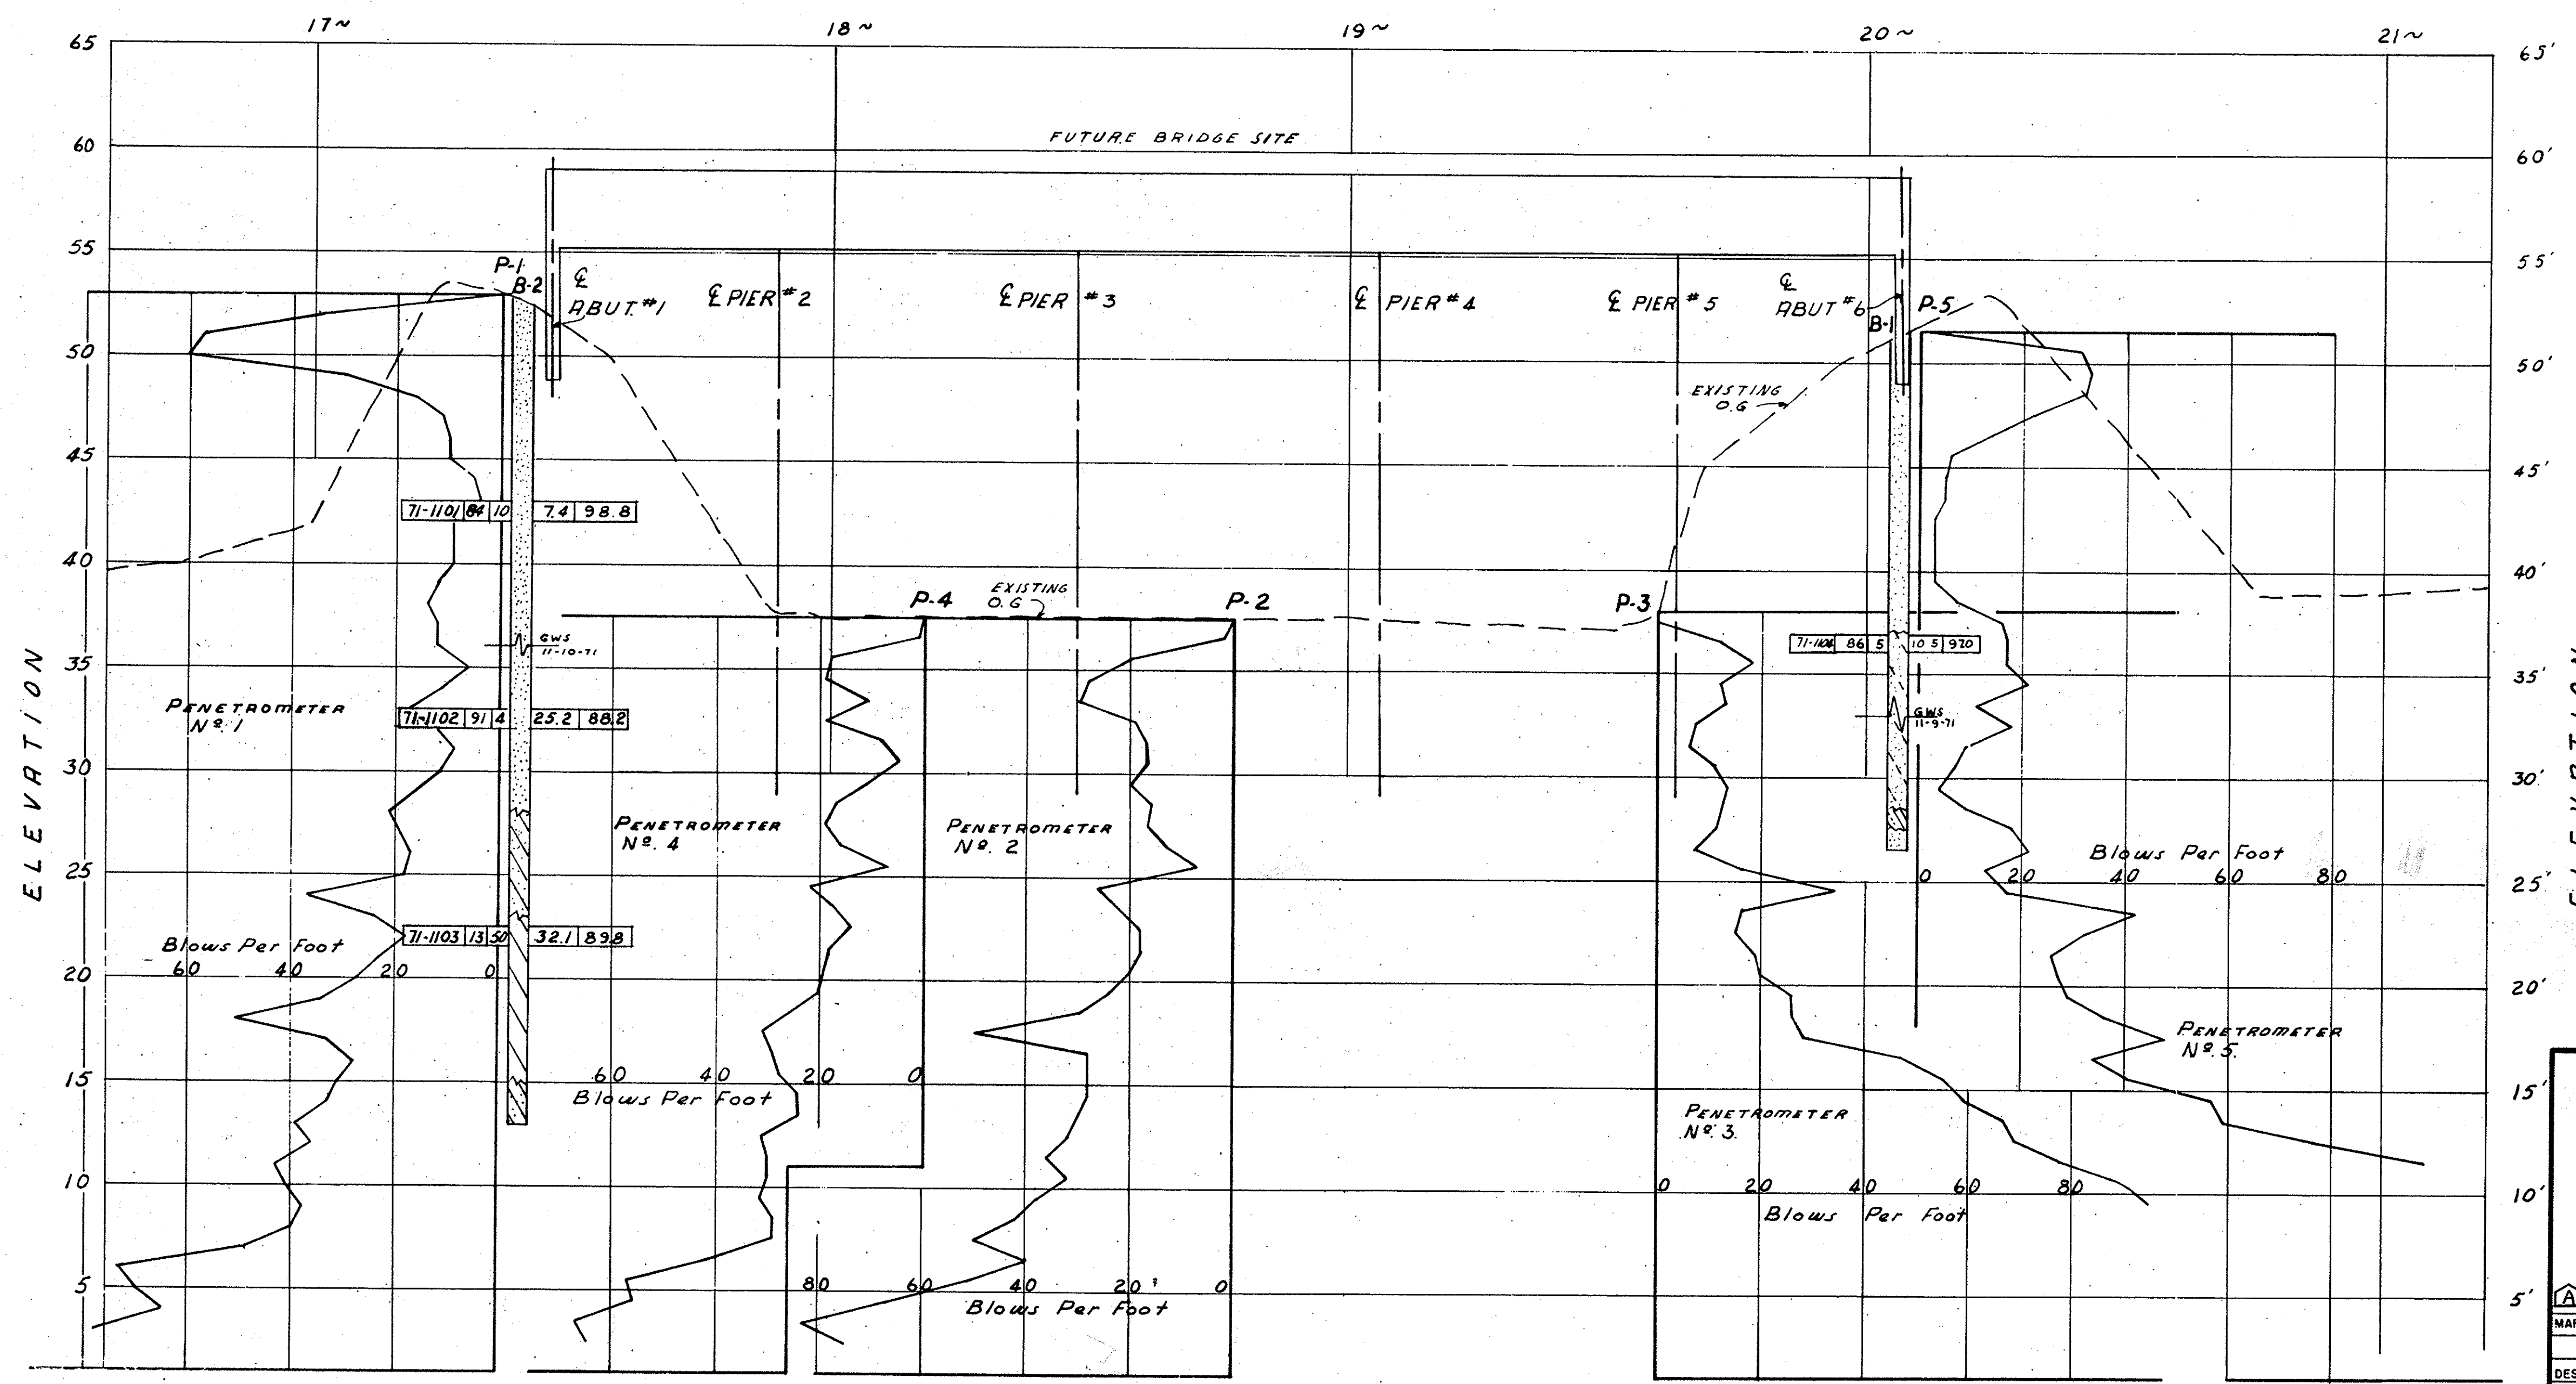


NOTE:
FOR SUMMARY OF PILE DRIVING DATA FROM EXISTING SLATER-SEGERSTROM BRIDGE SEE SHEET 2.

LEGEND

- 8" Boring Location
- ⊕ Penetrometer Location

TYPICAL BORING

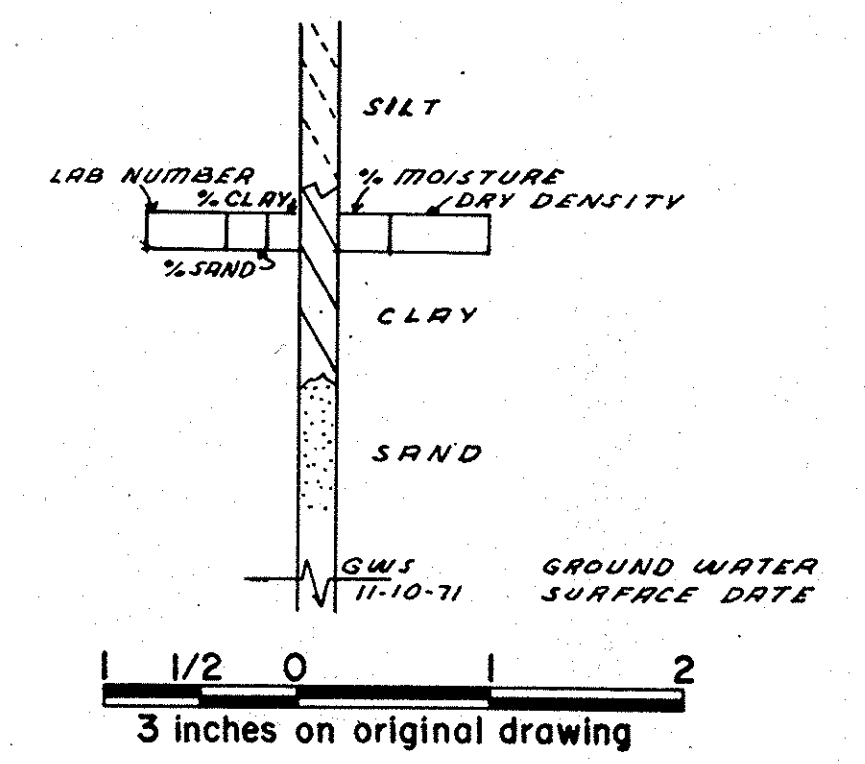

ORANGE COUNTY ENVIRONMENTAL MANAGEMENT AGENCY			
SLATER-SEGERSTROM BRIDGE (SA-31A) WIDENING OVER SANTA ANA RIVER (EOI)			
LOG OF TEST BORINGS			
7-83 AS BUILT			
MARK	DATE	DESCRIPTION	PREPARED UNDER SUPERVISION OF <i>[Signature]</i> DATE 5-1-81
REVISIONS			
DESIGNED	W.F. POND	SCALE	DATE
DRAWN	E.G.	CHECKED	W.F.P.
ASSHOWN			DWG. NO. 15