

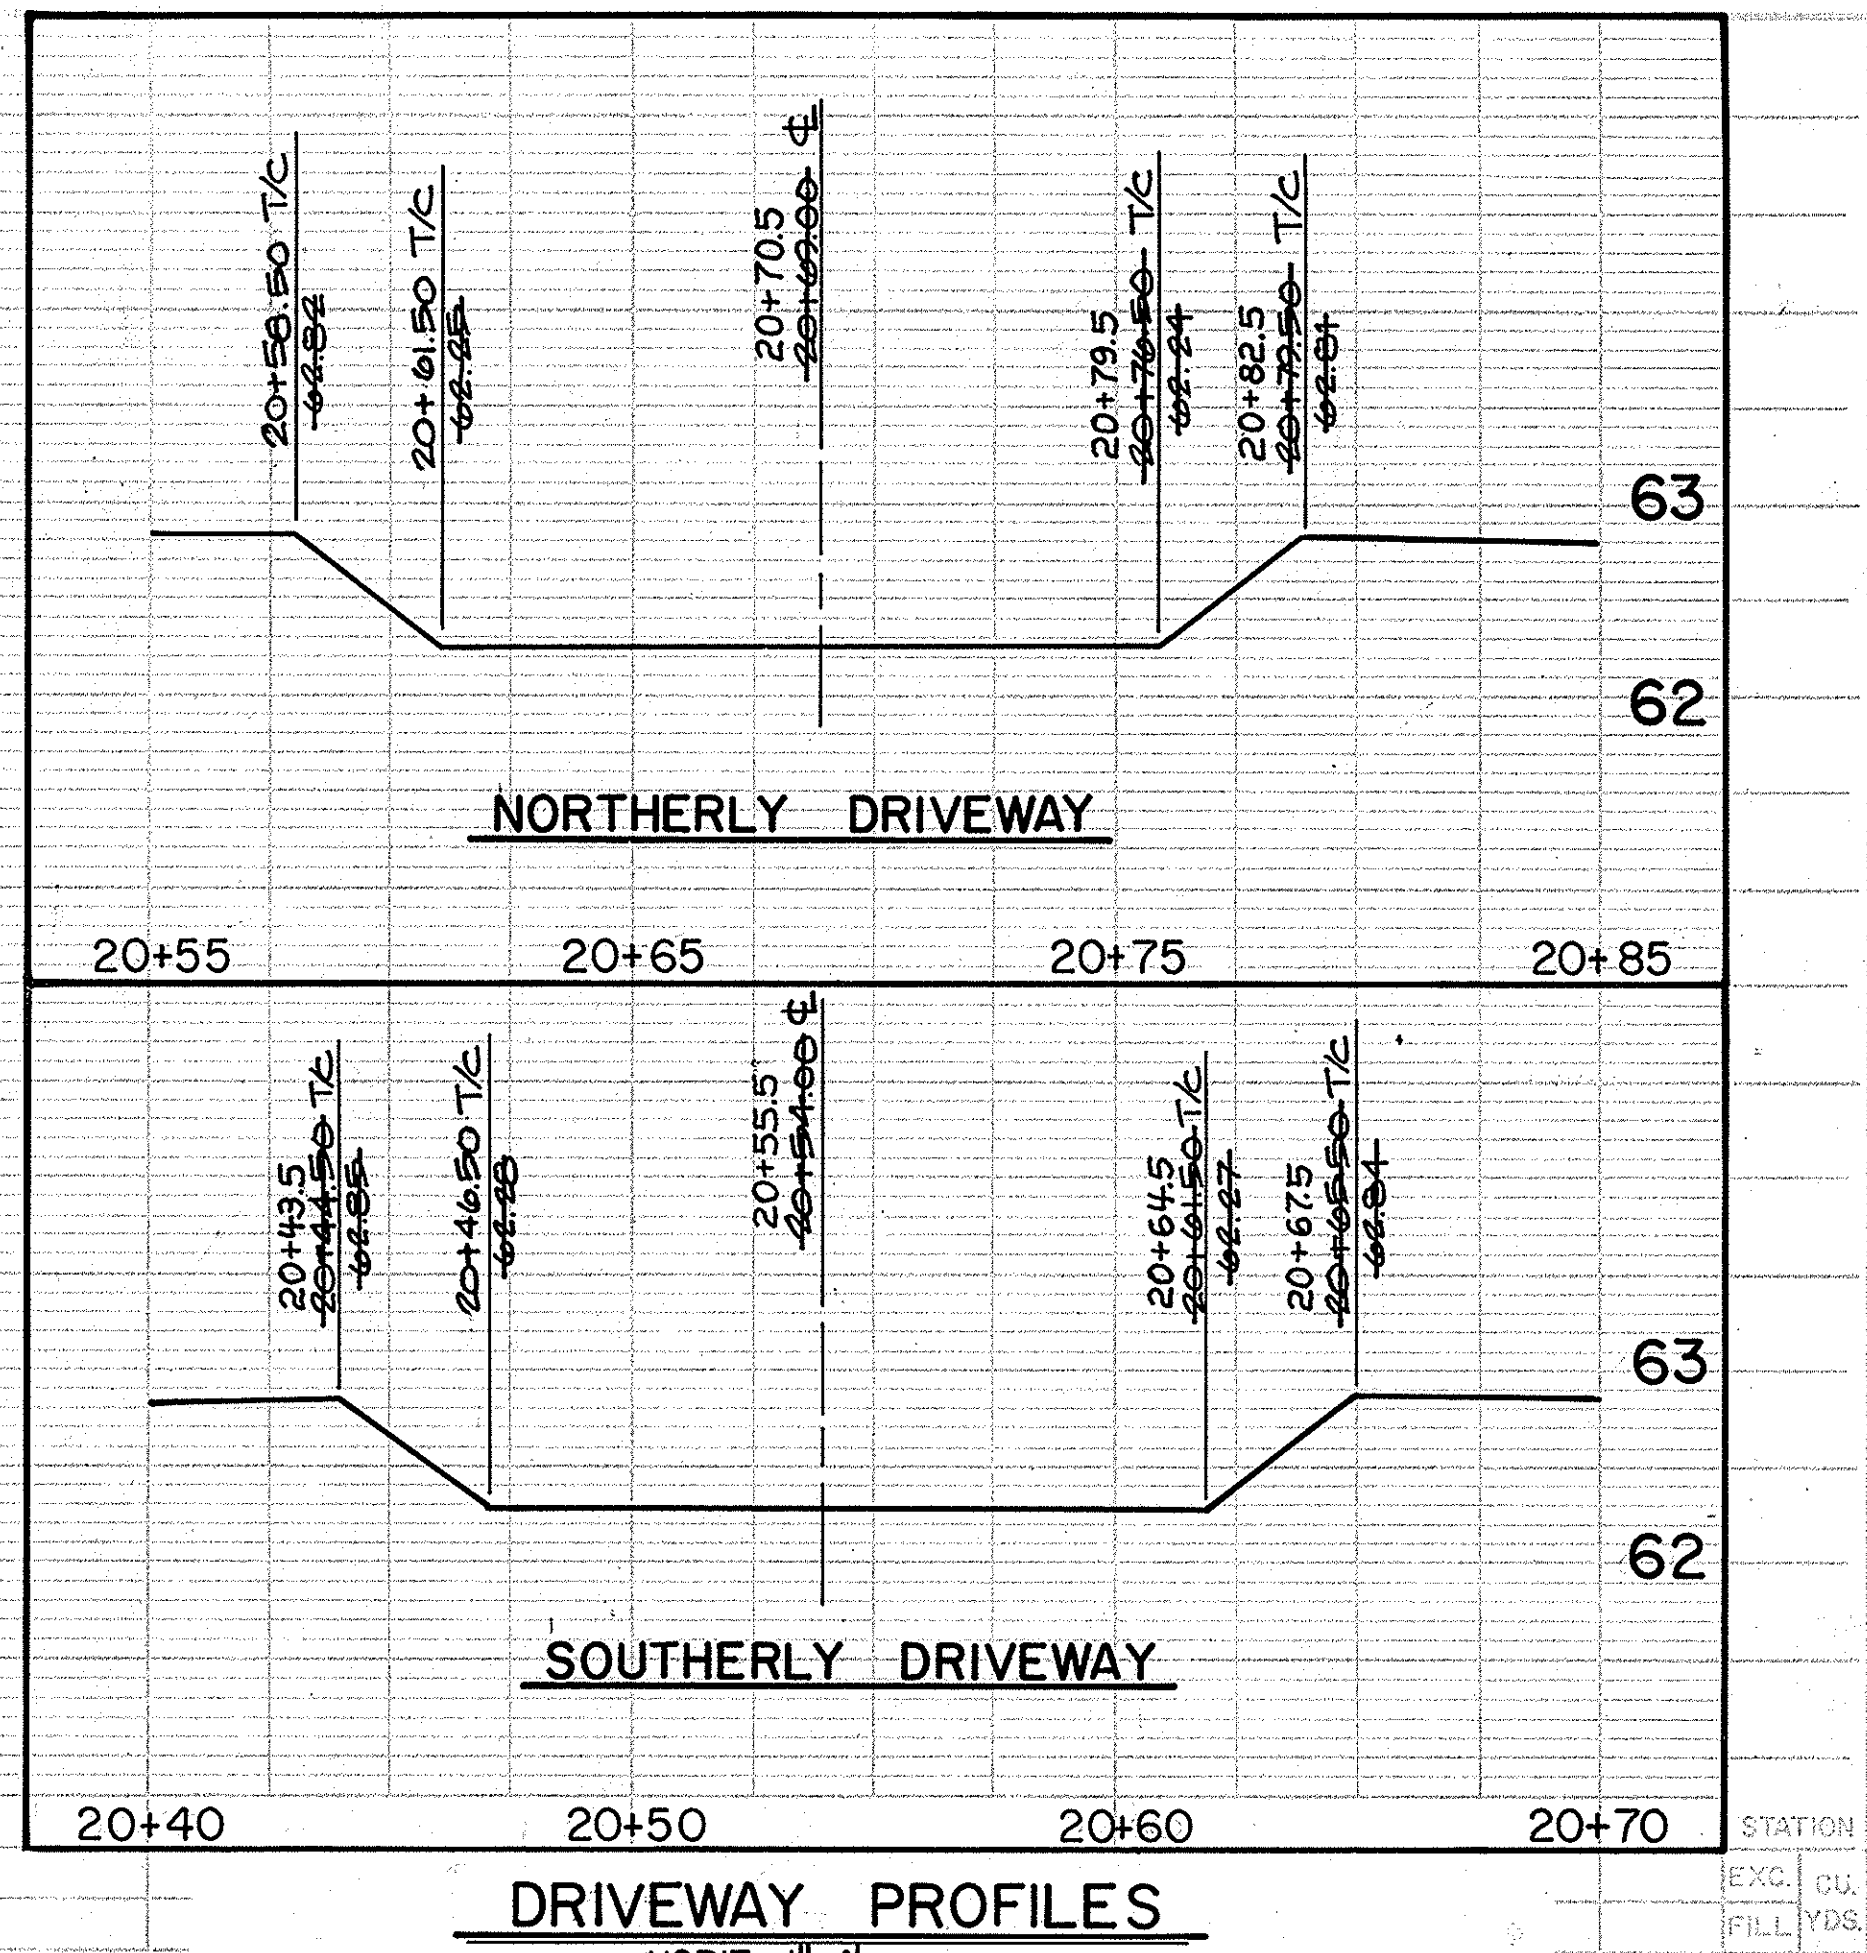
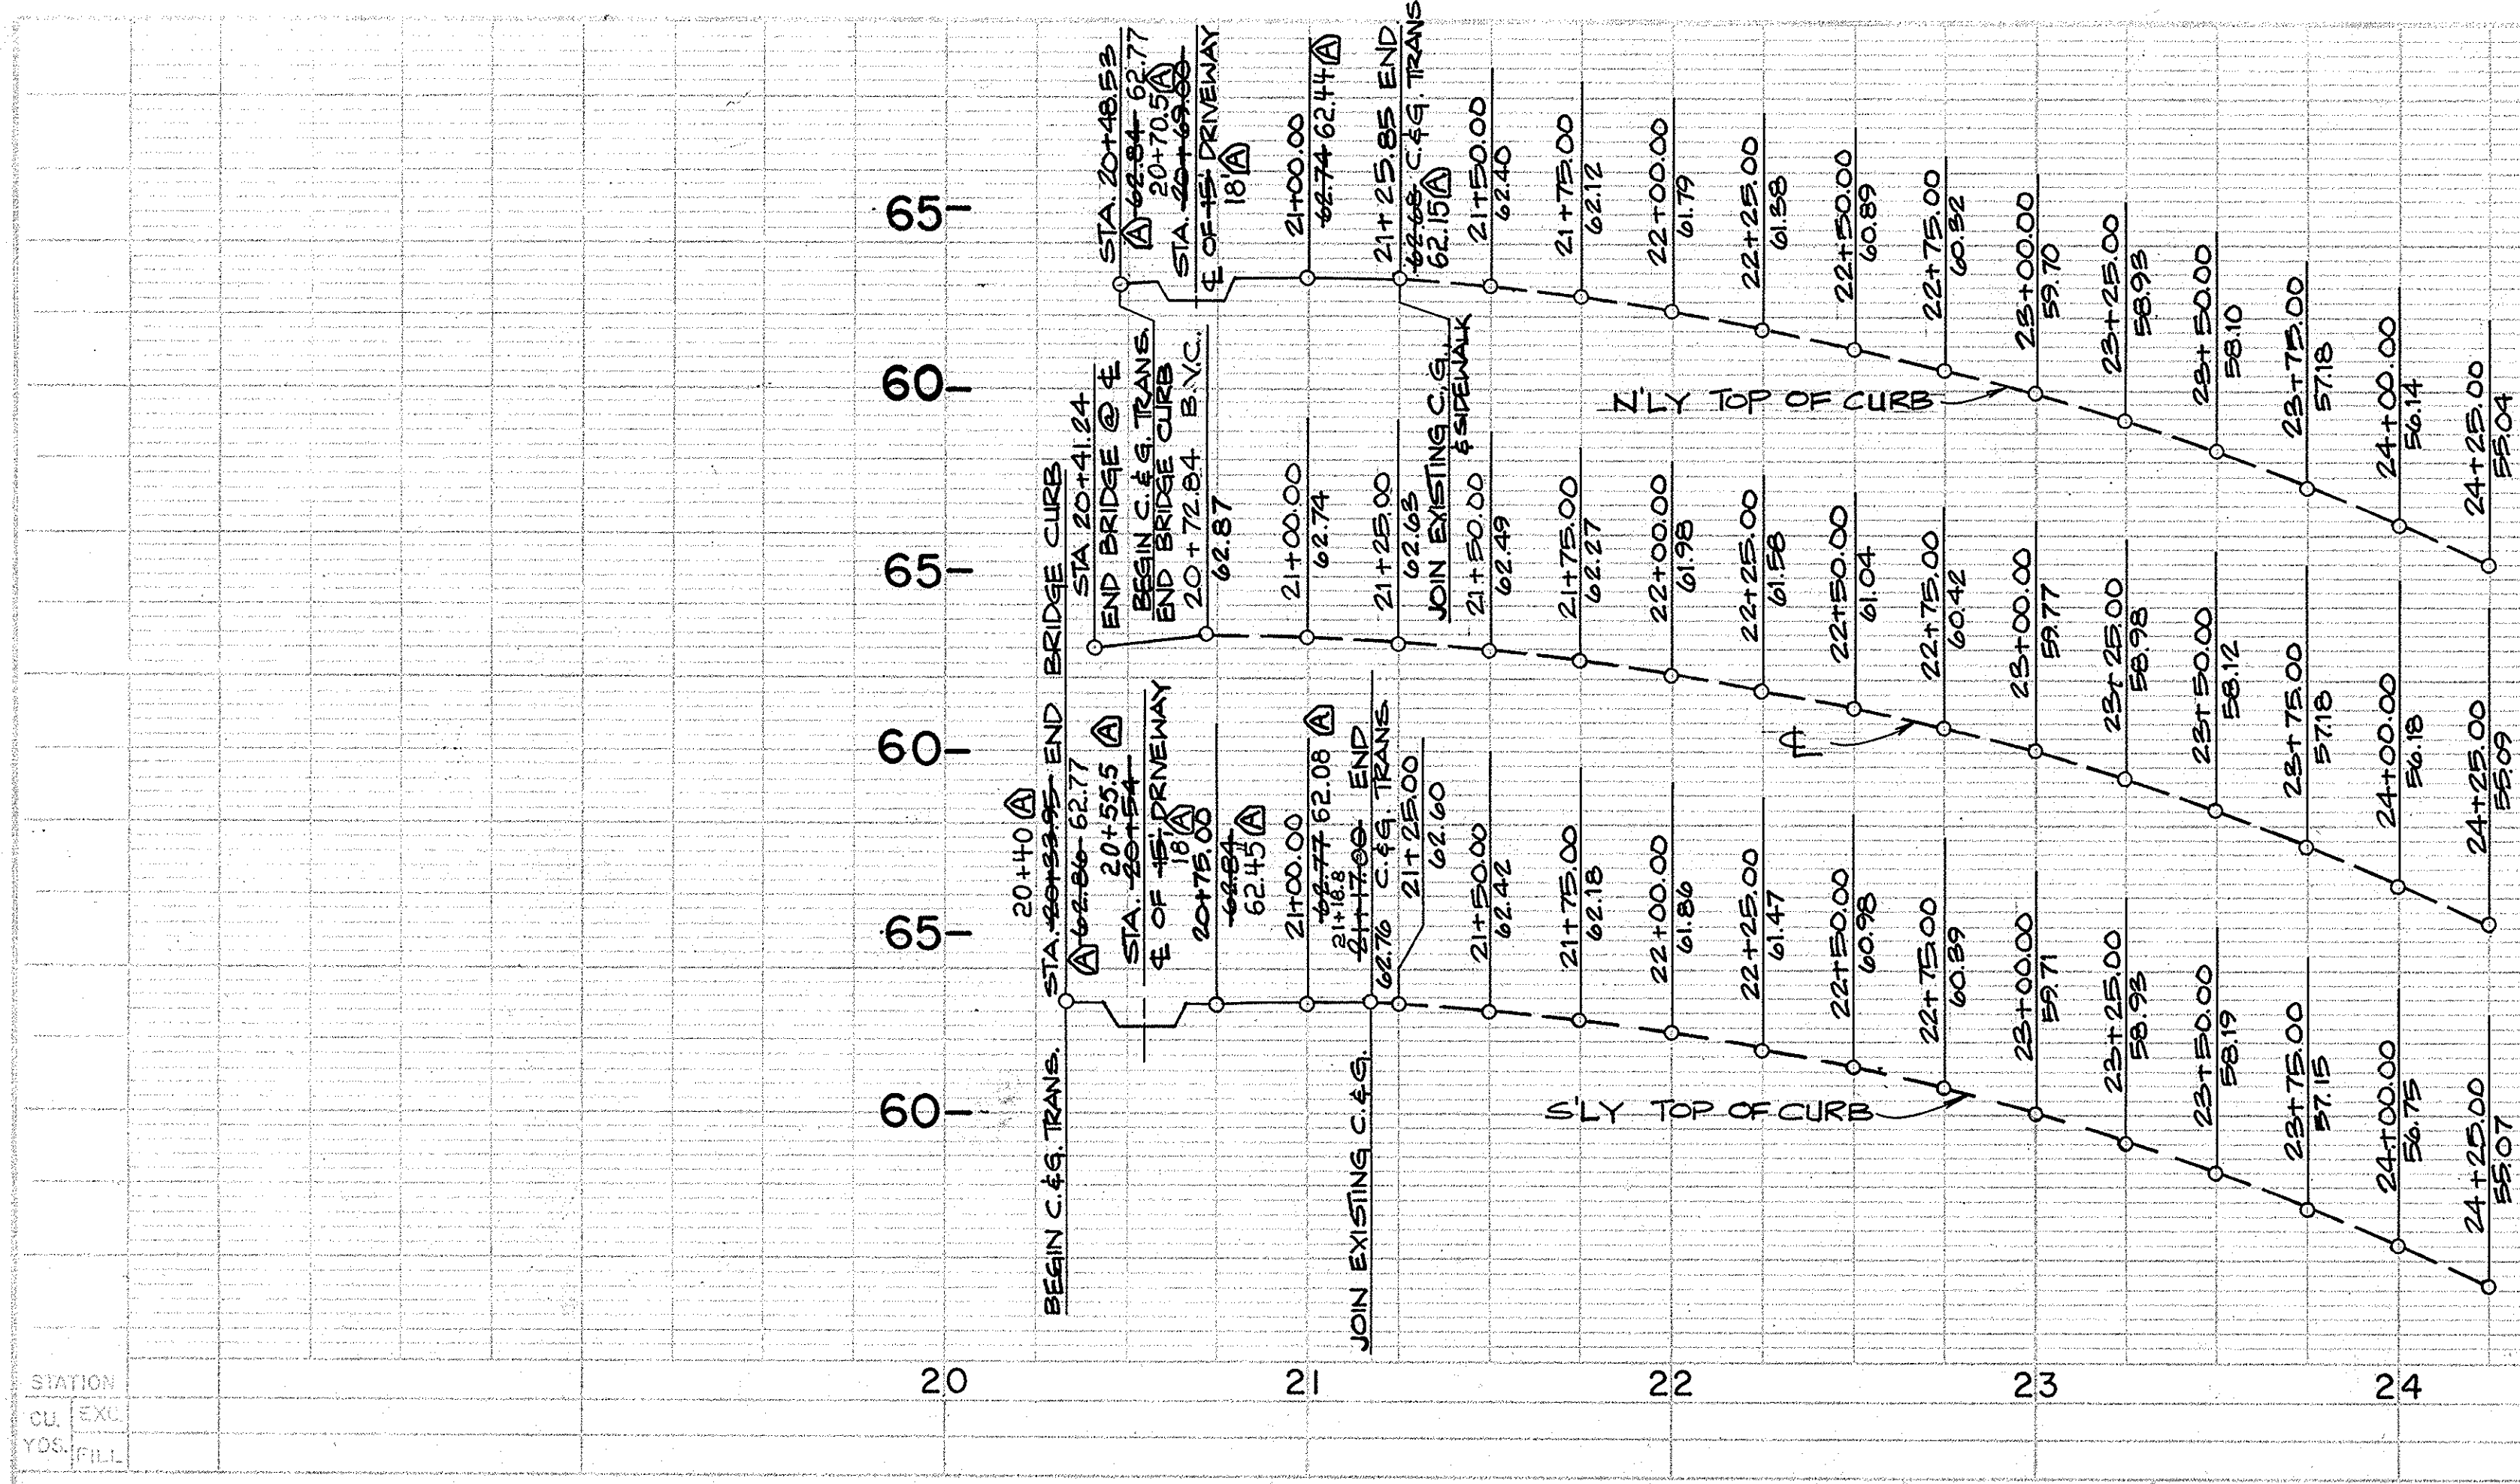


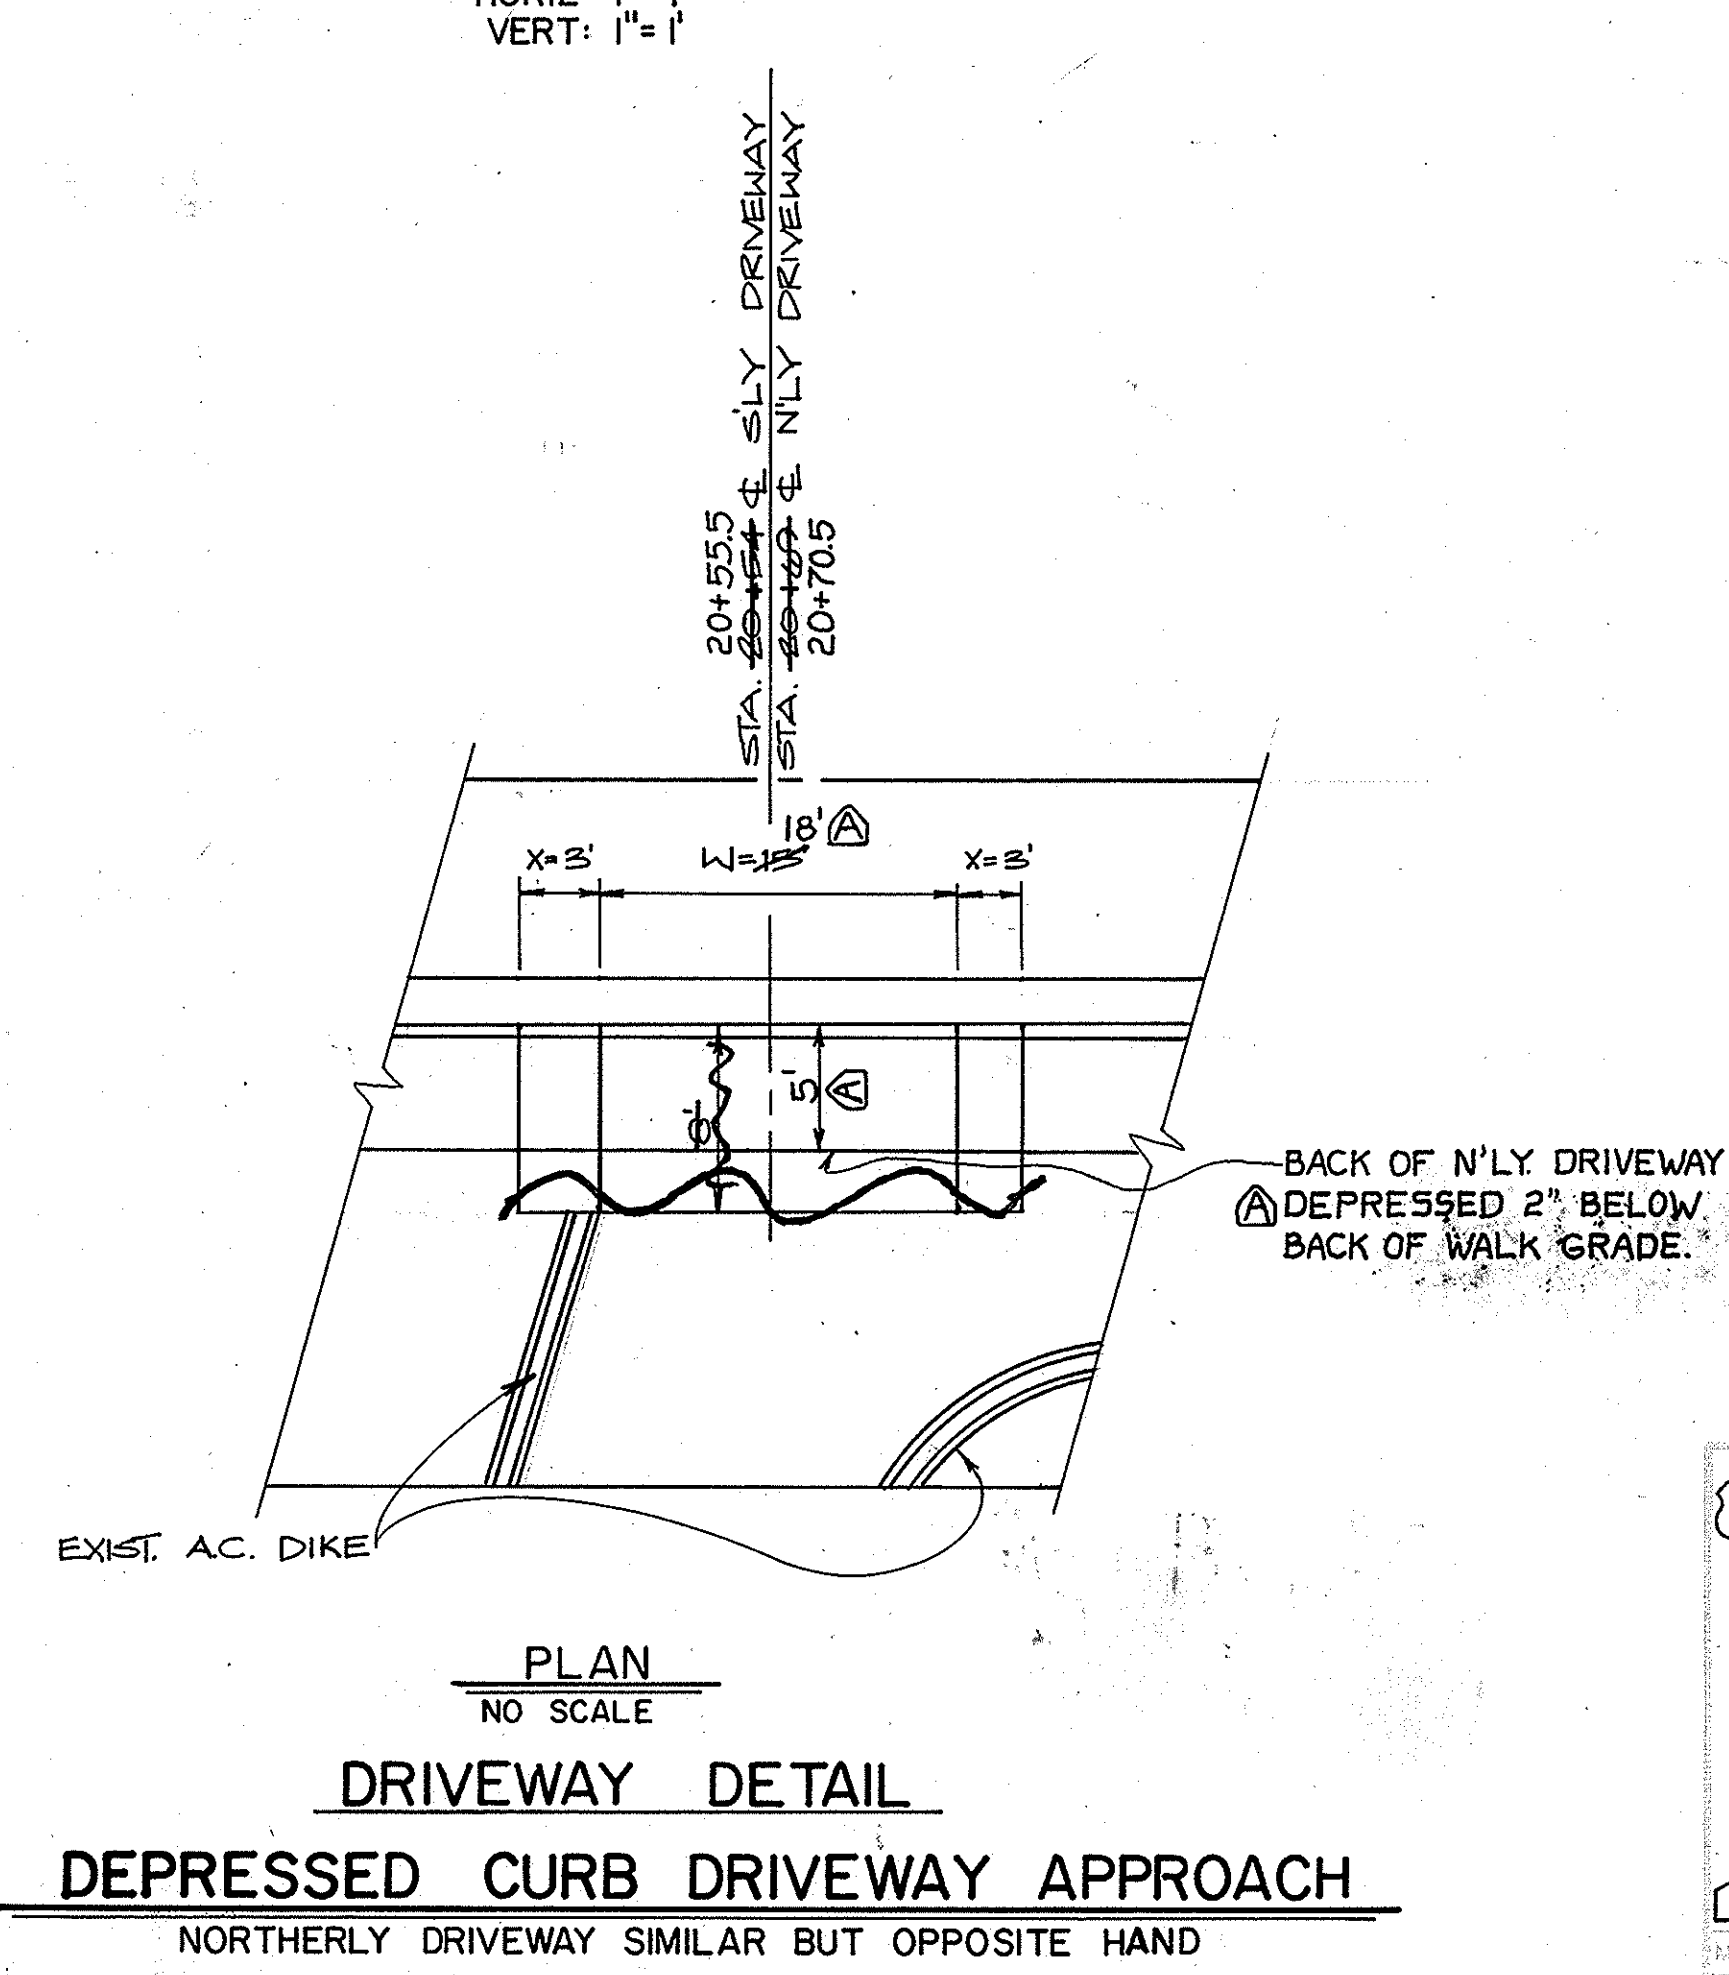

- ### CONSTRUCTION NOTES
- ① — PROTECT IN PLACE
 - ② — RAISE TO GRADE BY OTHERS
 - ③ — REMOVE
 - ④ — CONSTRUCT 5' WIDE P.C.C. SIDEWALK
 - ⑤ — RESURFACE A.C. MAINTENANCE RAMP & FEATHER TO JOIN EXISTING
 - ⑥ — CONSTRUCT 0.60' DEEP LIFT A.C. OVER NATIVE SOIL.
 - ⑦ — CONSTRUCT CURB, GUTTER & SIDEWALK

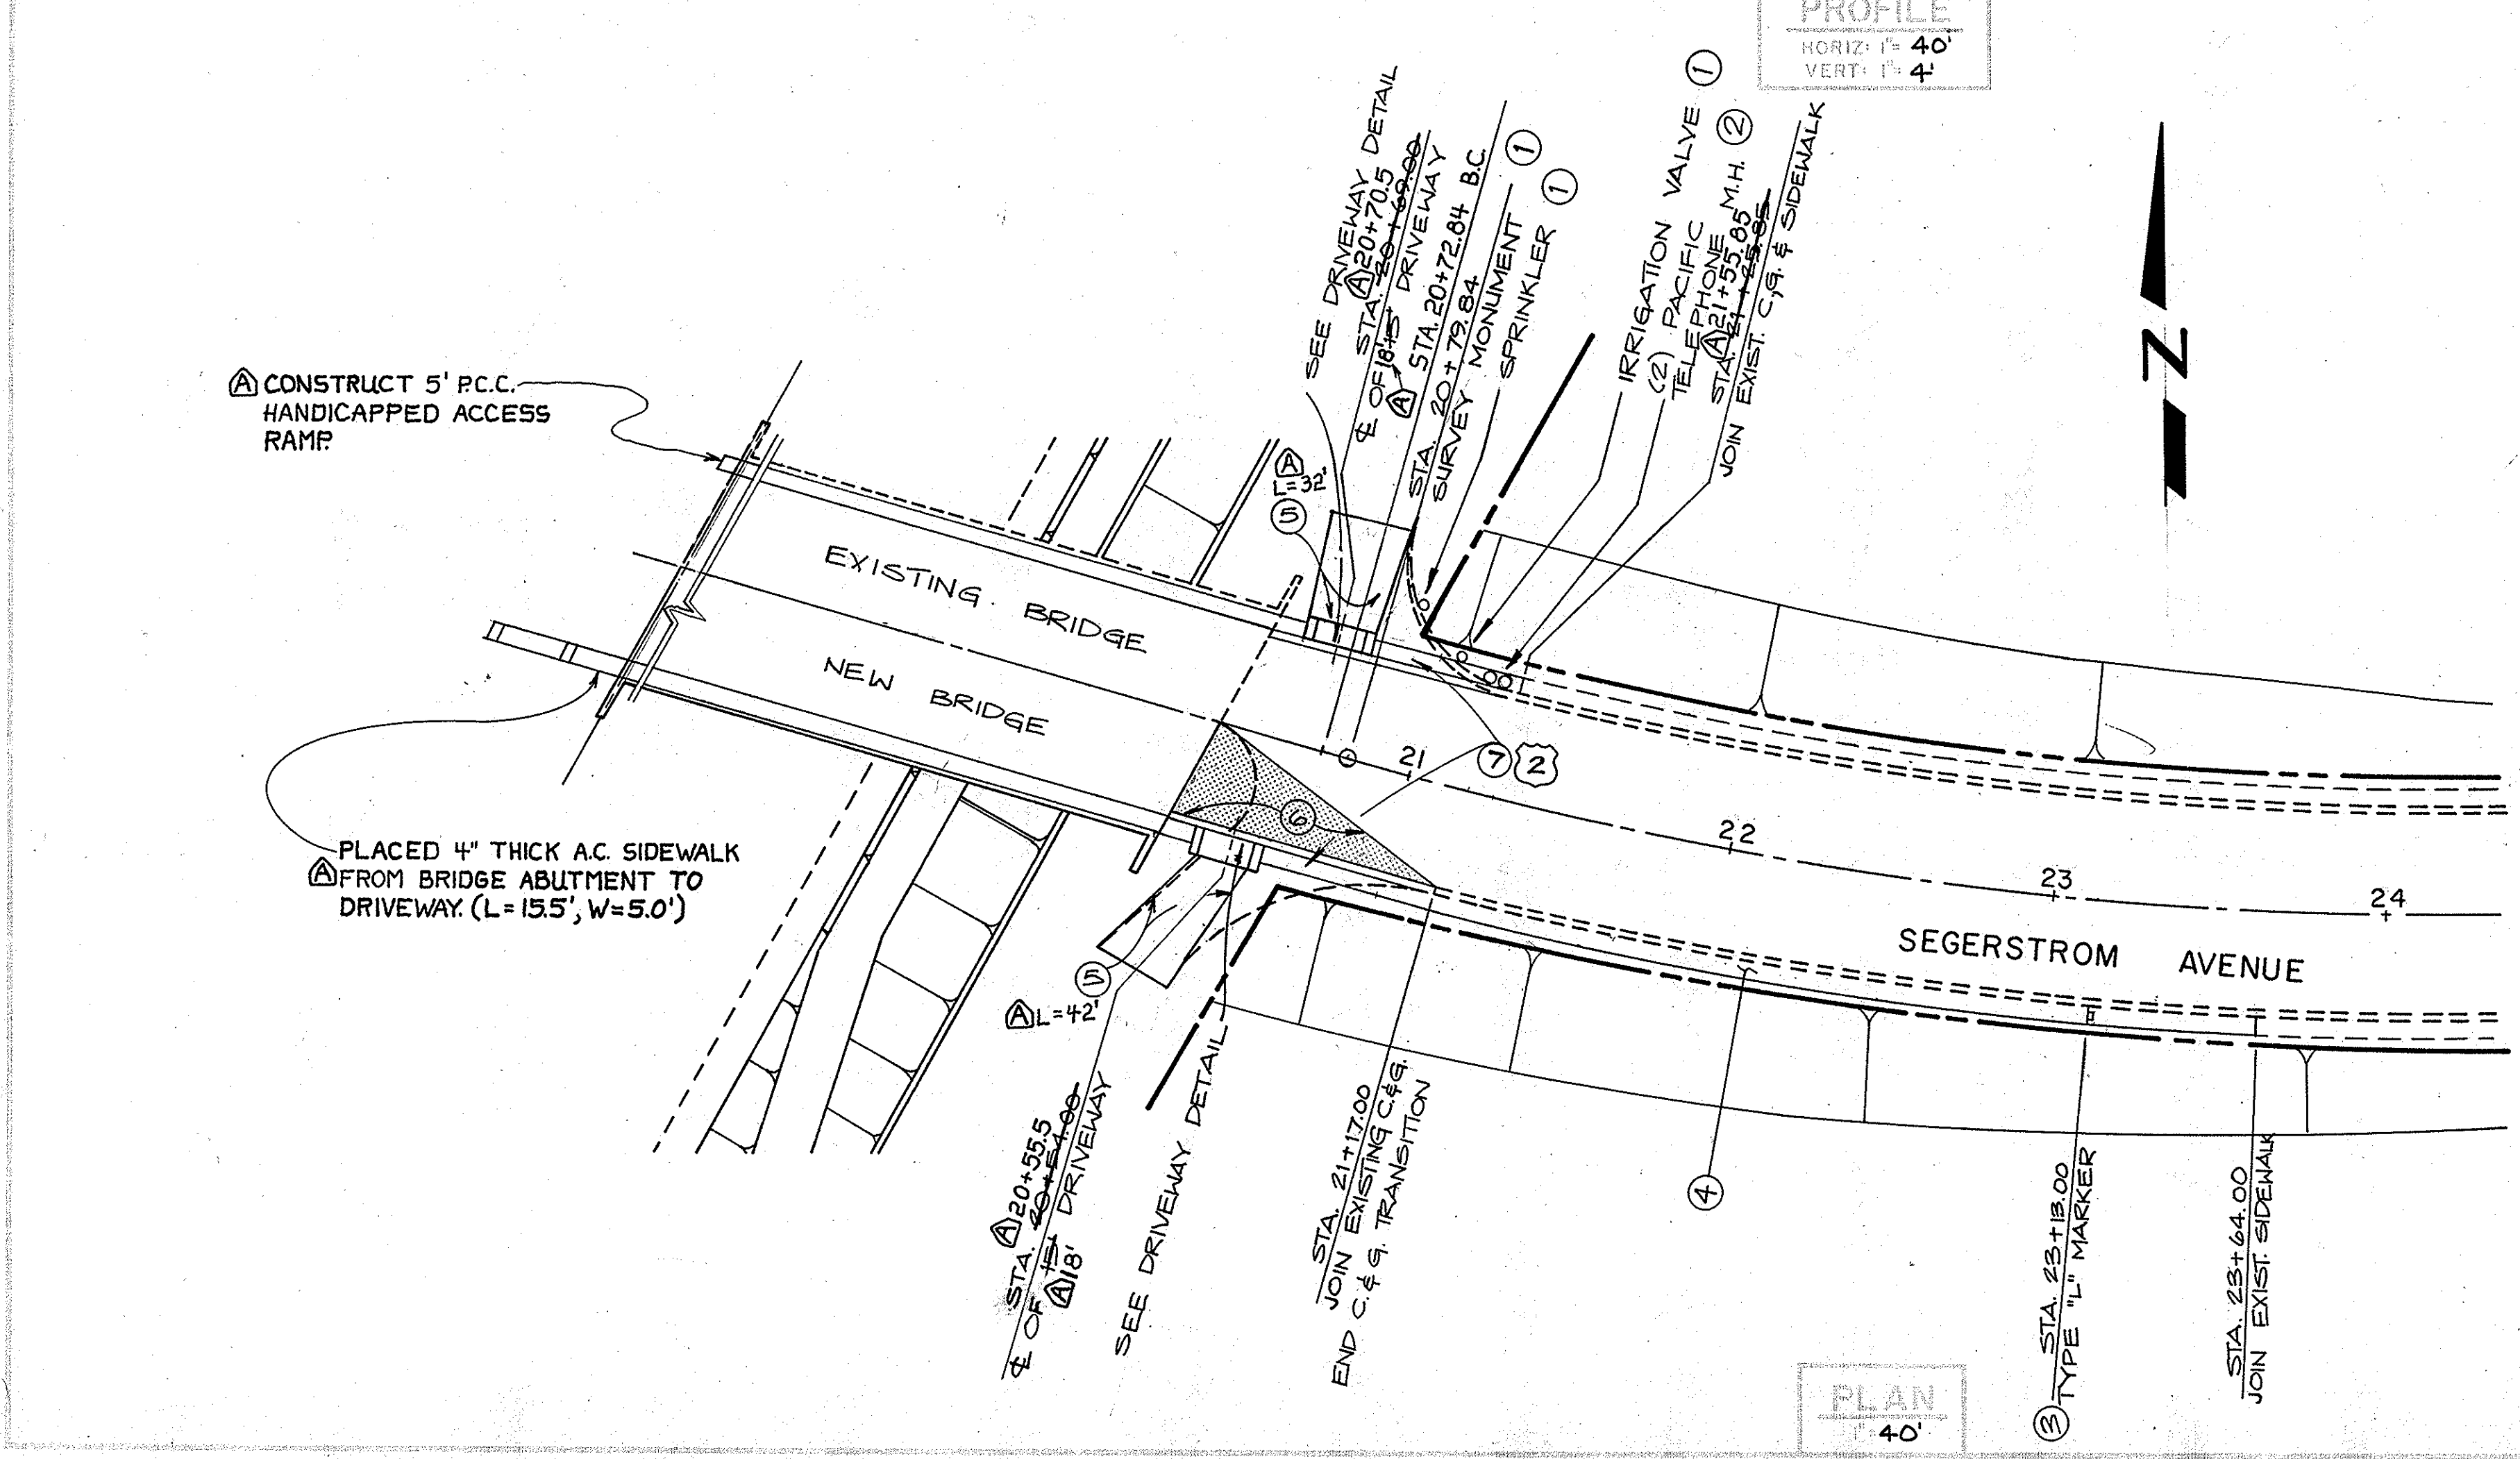

AS BUILT

② 7-81 NOTE #7 ADDED ⑦ 7-83 AS BUILT	ORANGE COUNTY ENVIRONMENTAL MANAGEMENT AGENCY SLATER SEGERSTROM BRIDGE (SA 31A) WIDENING OVER SANTA ANA RIVER (EOI)	ROAD APPROACH DETAILS	
	DESIGNED: G.W. FOSTER CHECKED: G.W.F.	SCALE: AS SHOWN DATE:	SHEET: 17
	PREPARED UNDER SUPERVISION OF: <i>John William Foster</i>		