

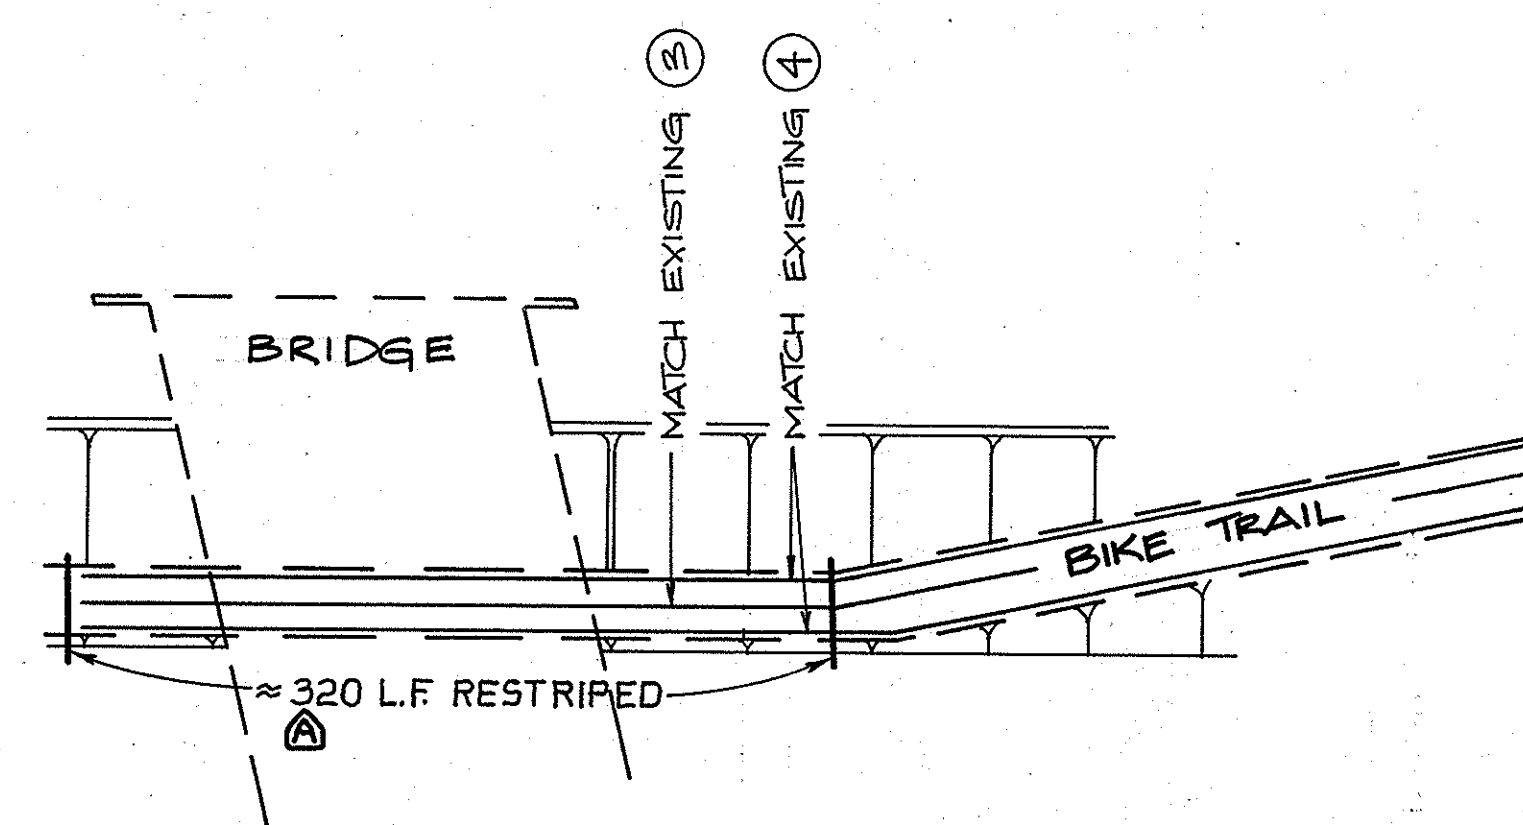
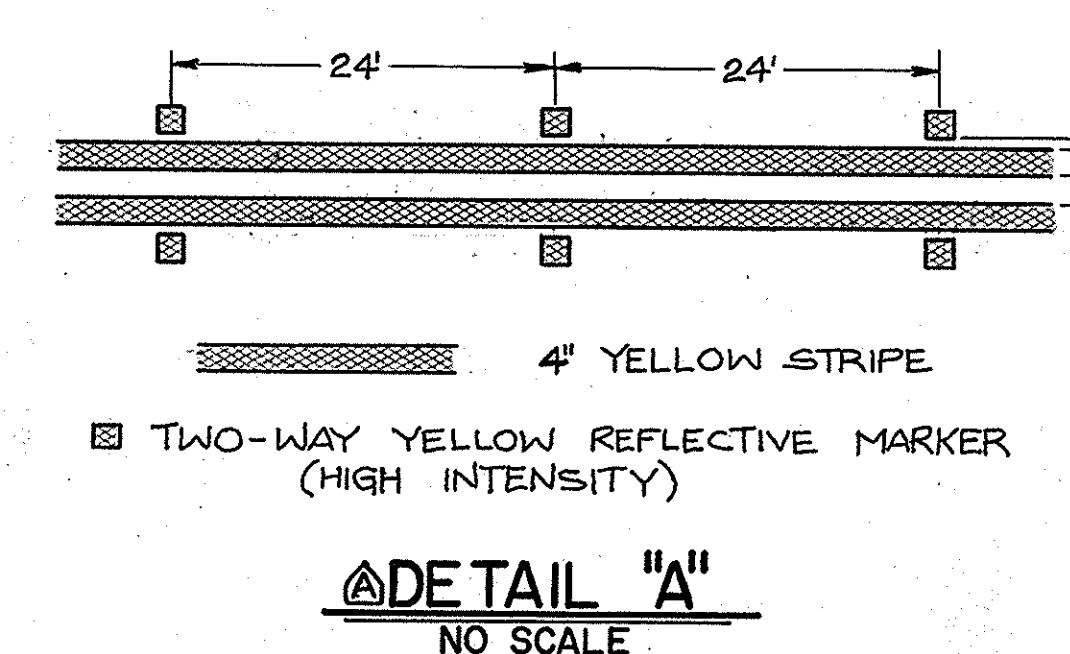
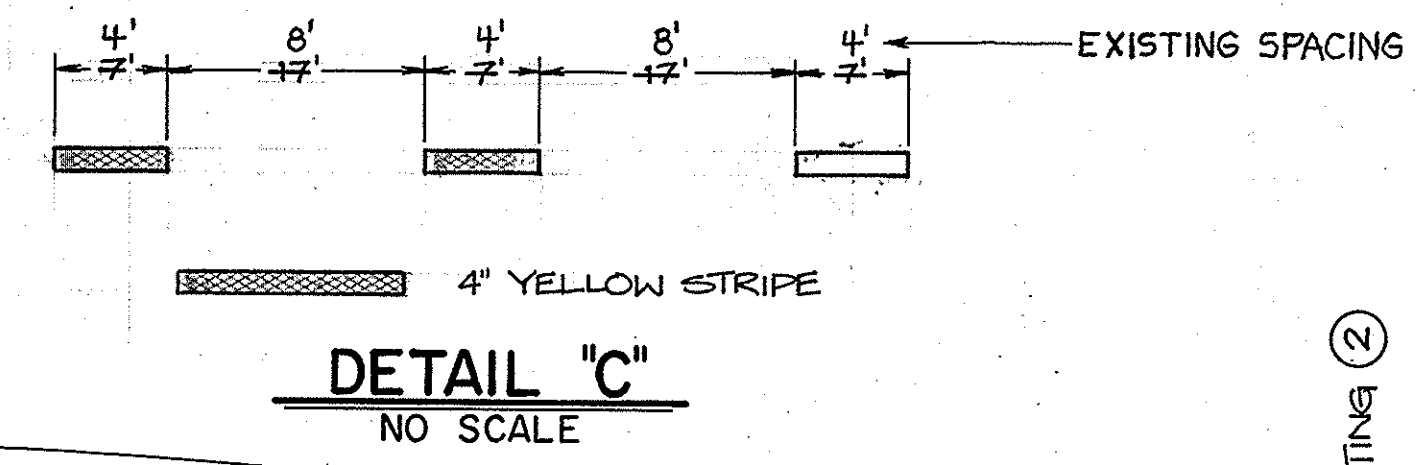
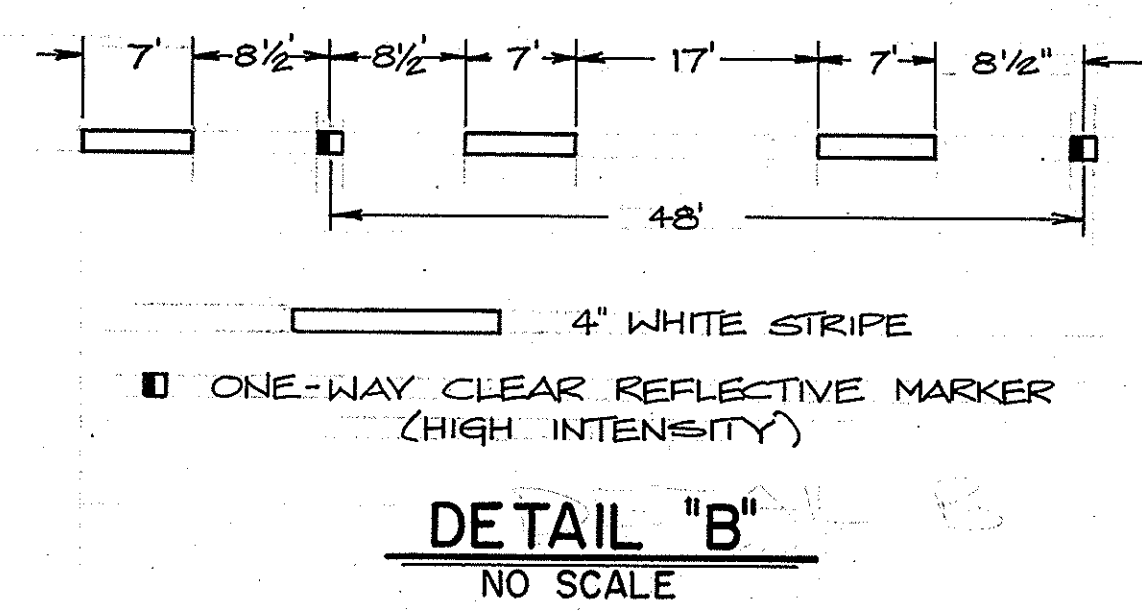
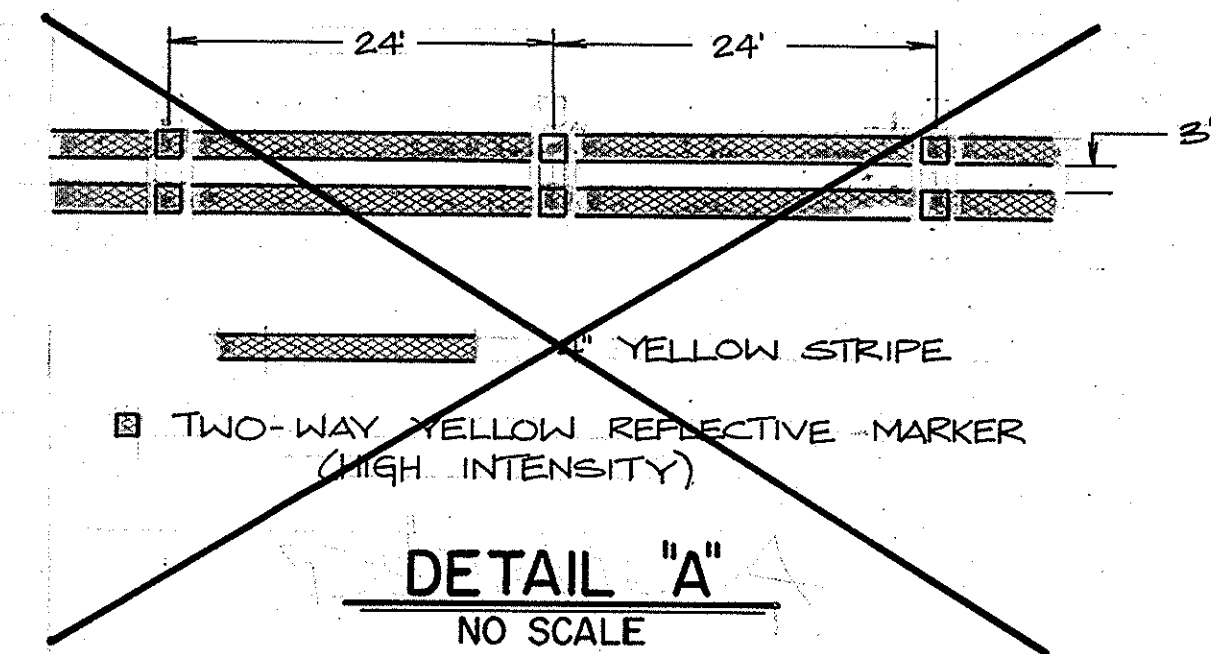


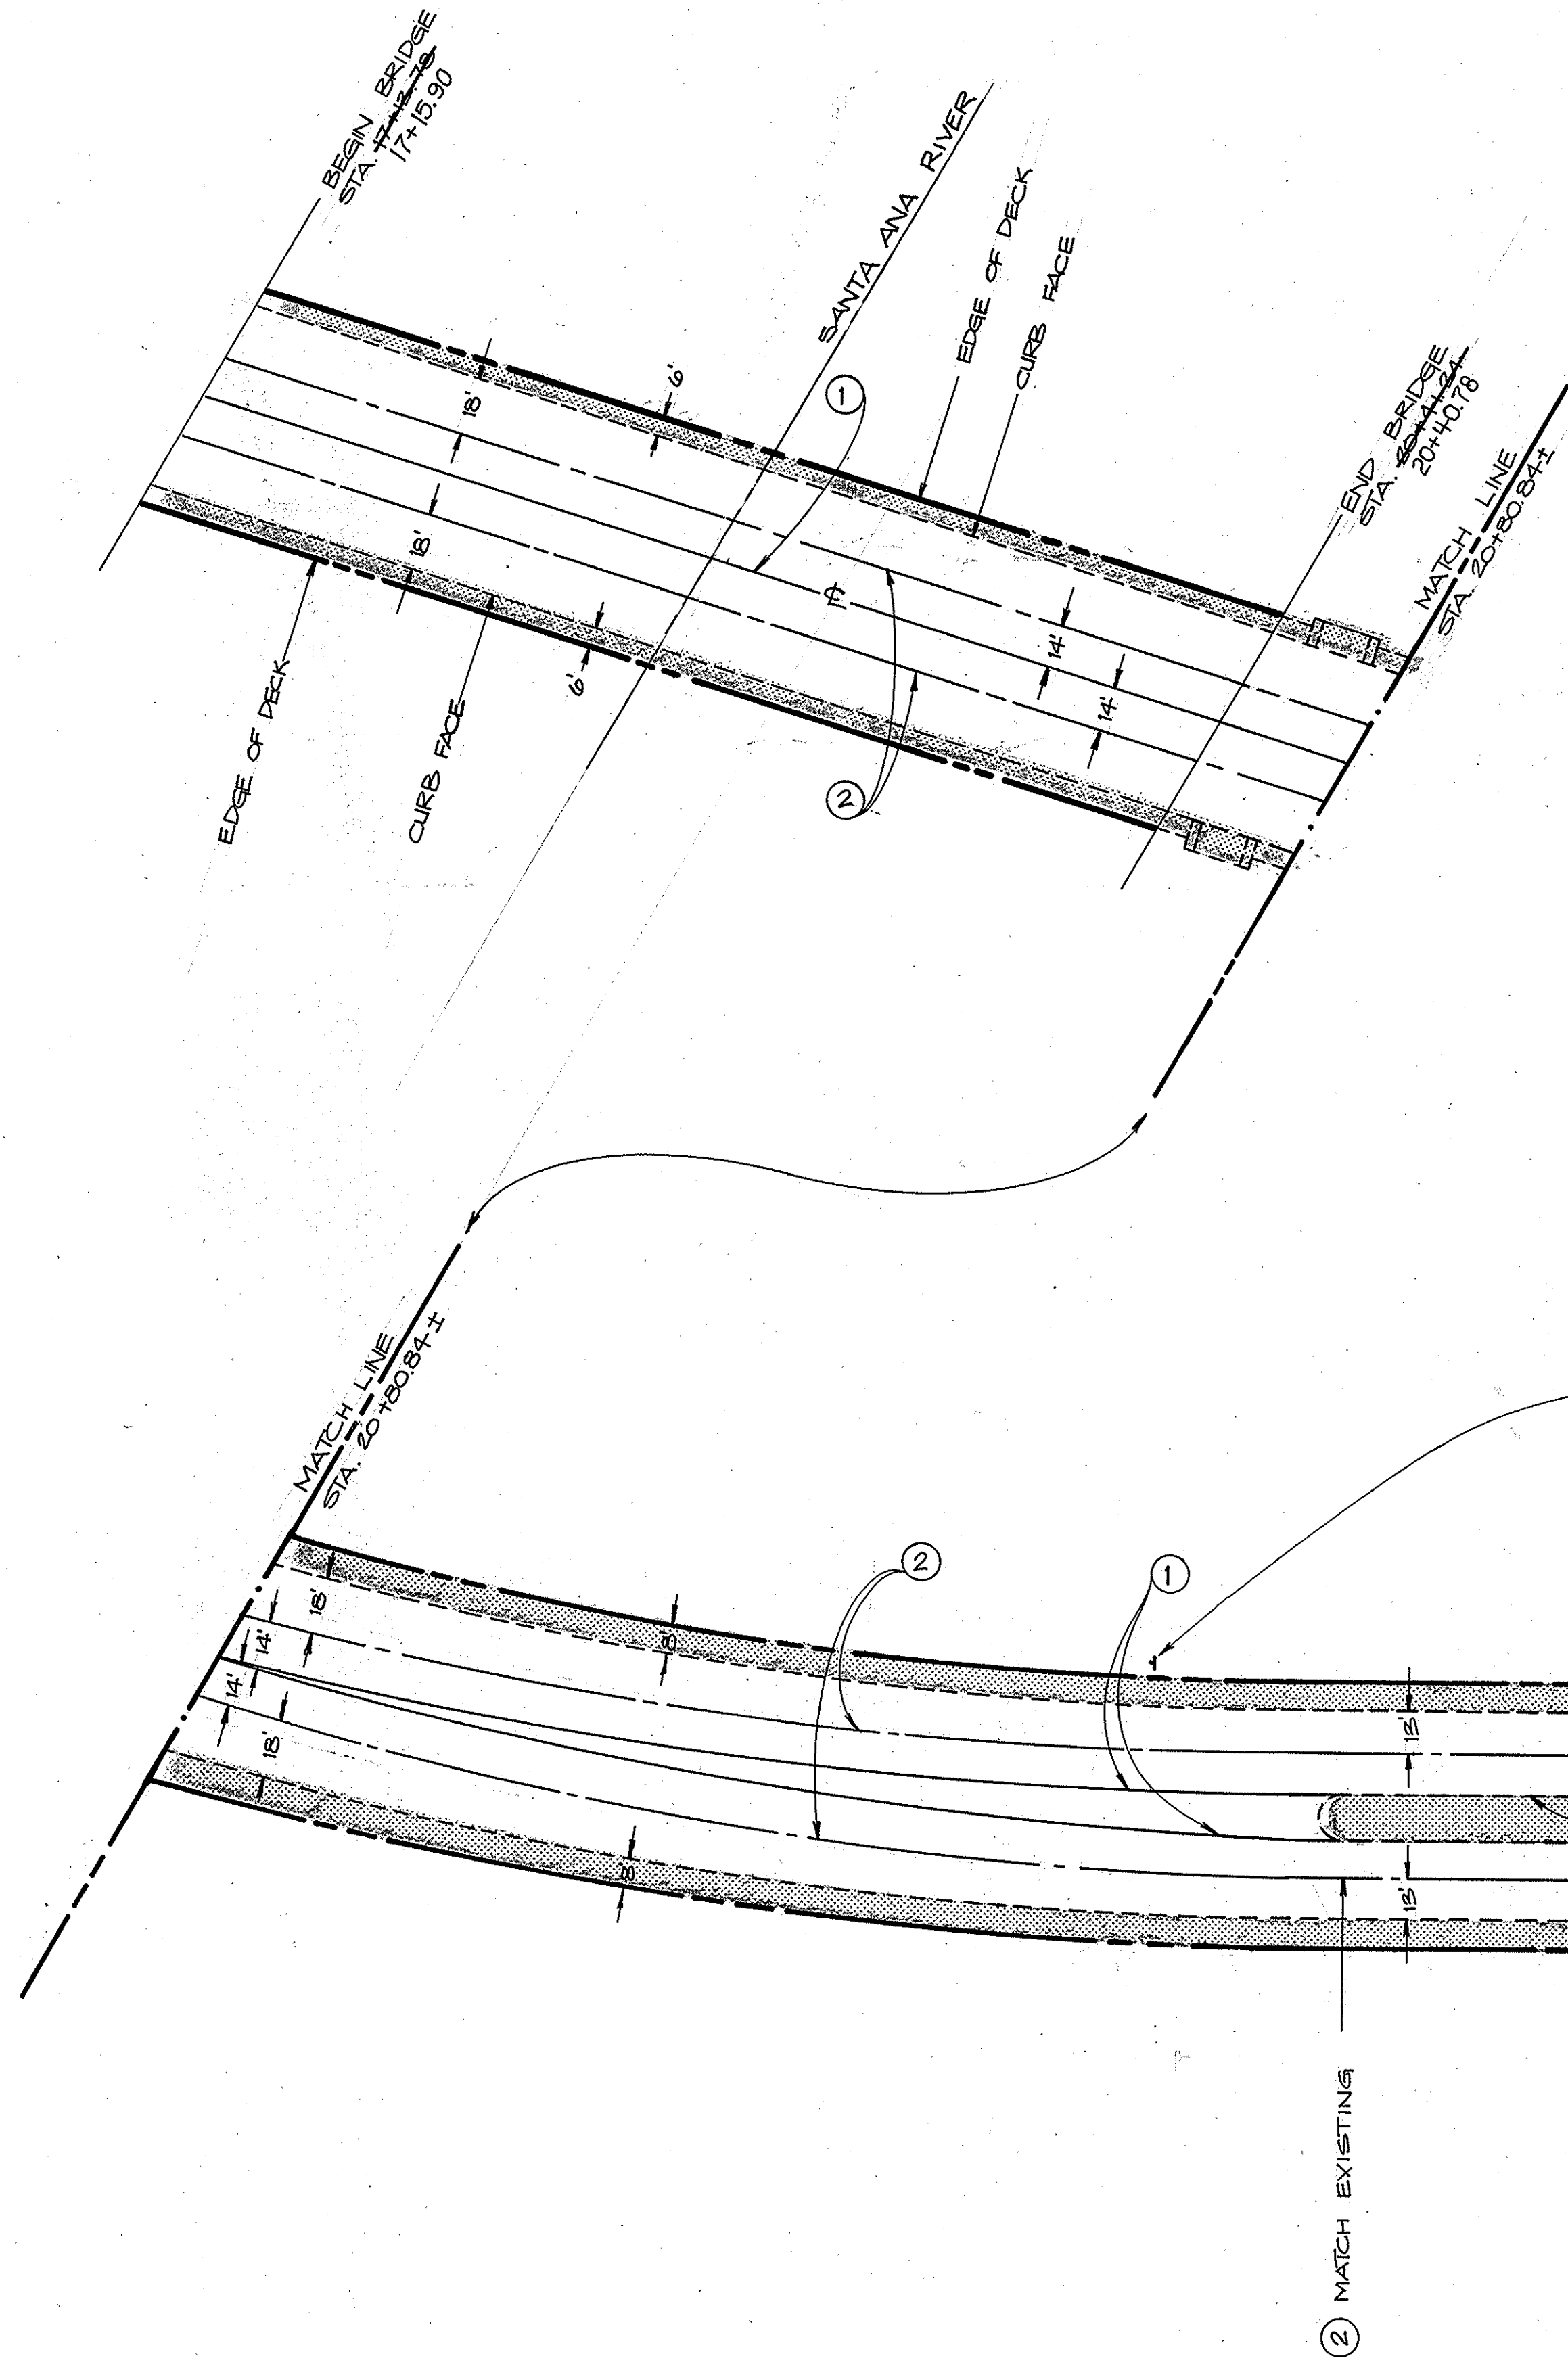

- CONSTRUCTION NOTES**
- ① STRIPE DOUBLE YELLOW PER DETAIL "A" (4")
 - ② STRIPE 4" DASH WHITE PER DETAIL "B"
 - ③ STRIPE 4" DASH YELLOW PER DETAIL "C"
 - ④ STRIPE 5" SOLID WHITE TO MATCH EXISTING.
 - ⑤ REMOVE EXISTING DOUBLE YELLOW.
 - ⑥ PROTECT EXISTING 8" WHITE.

DETOUR CURVE DATA

$\Delta = 16^\circ 21' 55"$
 $R = 1200'$
 $L = 342.75'$
 $T = 172.55'$

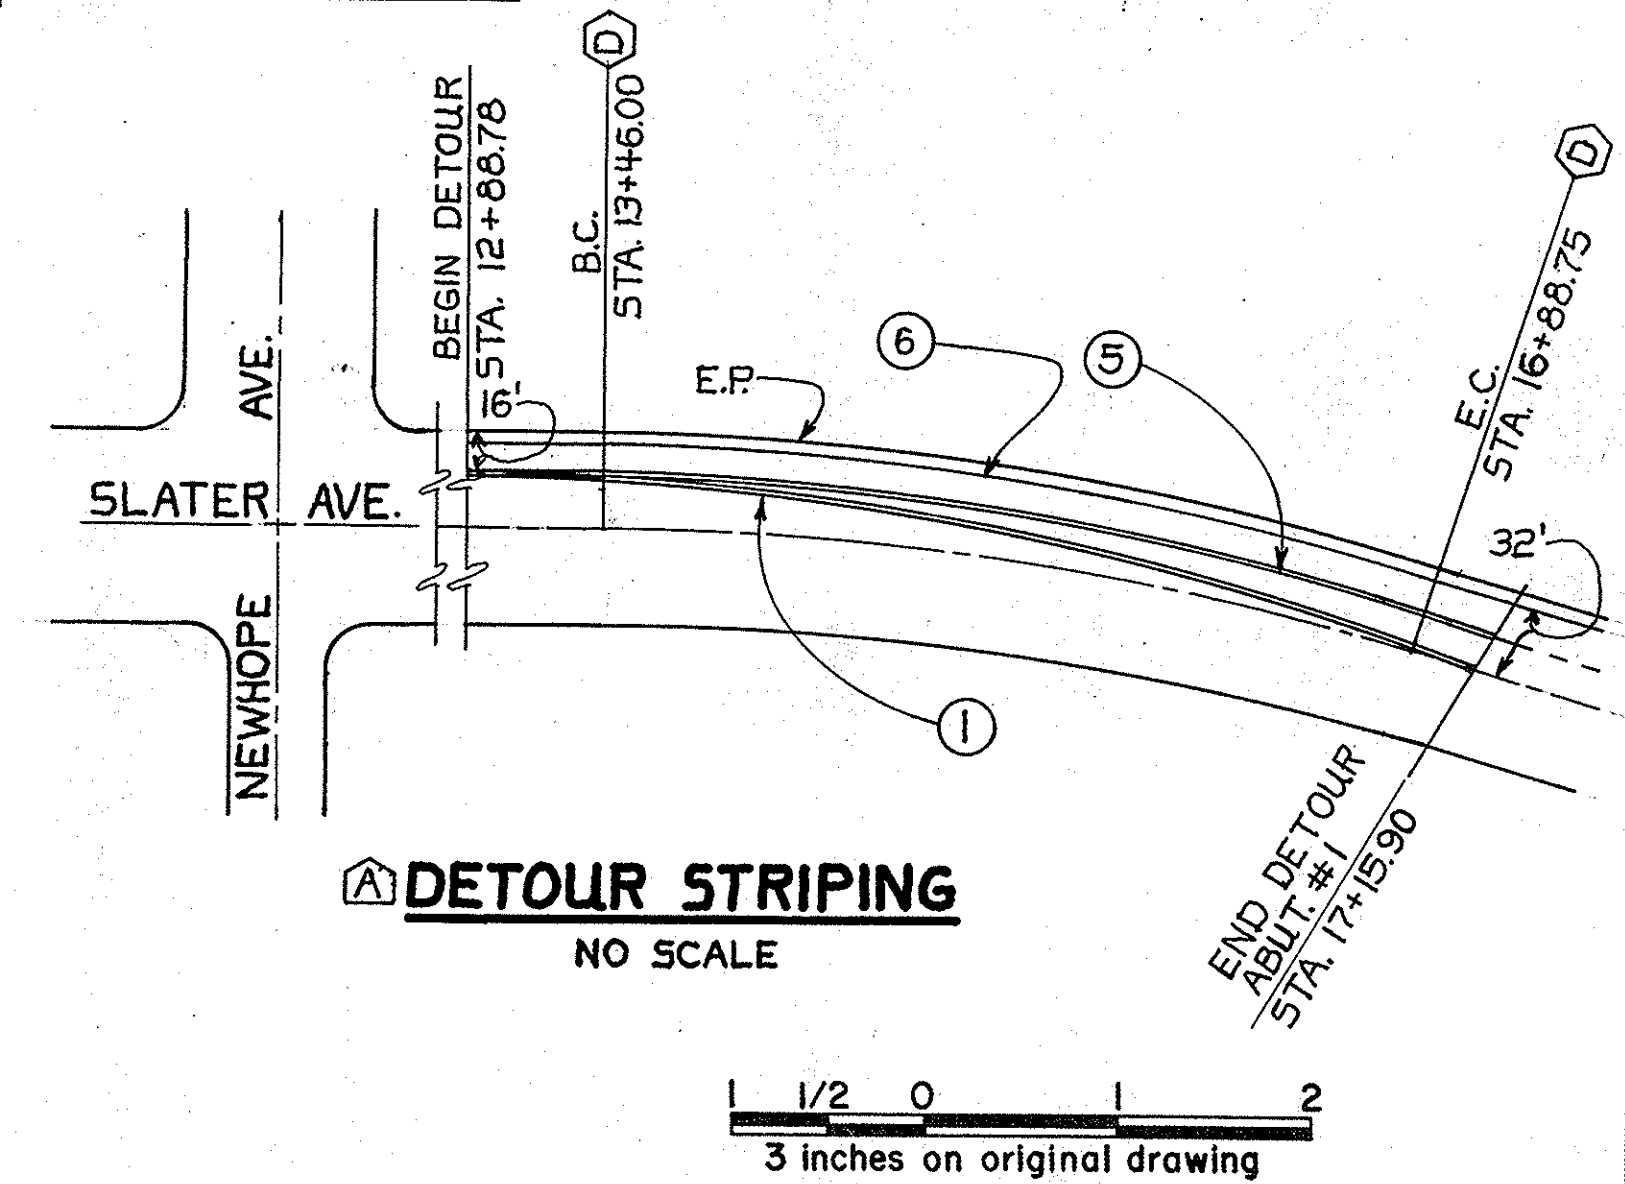

SEGERSTROM AVE.
SCALE: 1"=40'

AS BUILT

ORANGE COUNTY ENVIRONMENTAL MANAGEMENT AGENCY			
SLATER-SEGERSTROM BRIDGE (SA 31A) WIDENING OVER SANTA ANA RIVER (EOI)			
TRAFFIC STRIPING DIAGRAM			
7-83 AS BUILT			
MARK	DATE	DESCRIPTION	PREPARED UNDER SUPERVISION OF
REVISIONS			
DESIGNED	M.M.H.	SCALE	DATE
DRAWN	P.L.B.	CHECKED	G.W.F.
AS SHOWN		DWG. NO.	18