


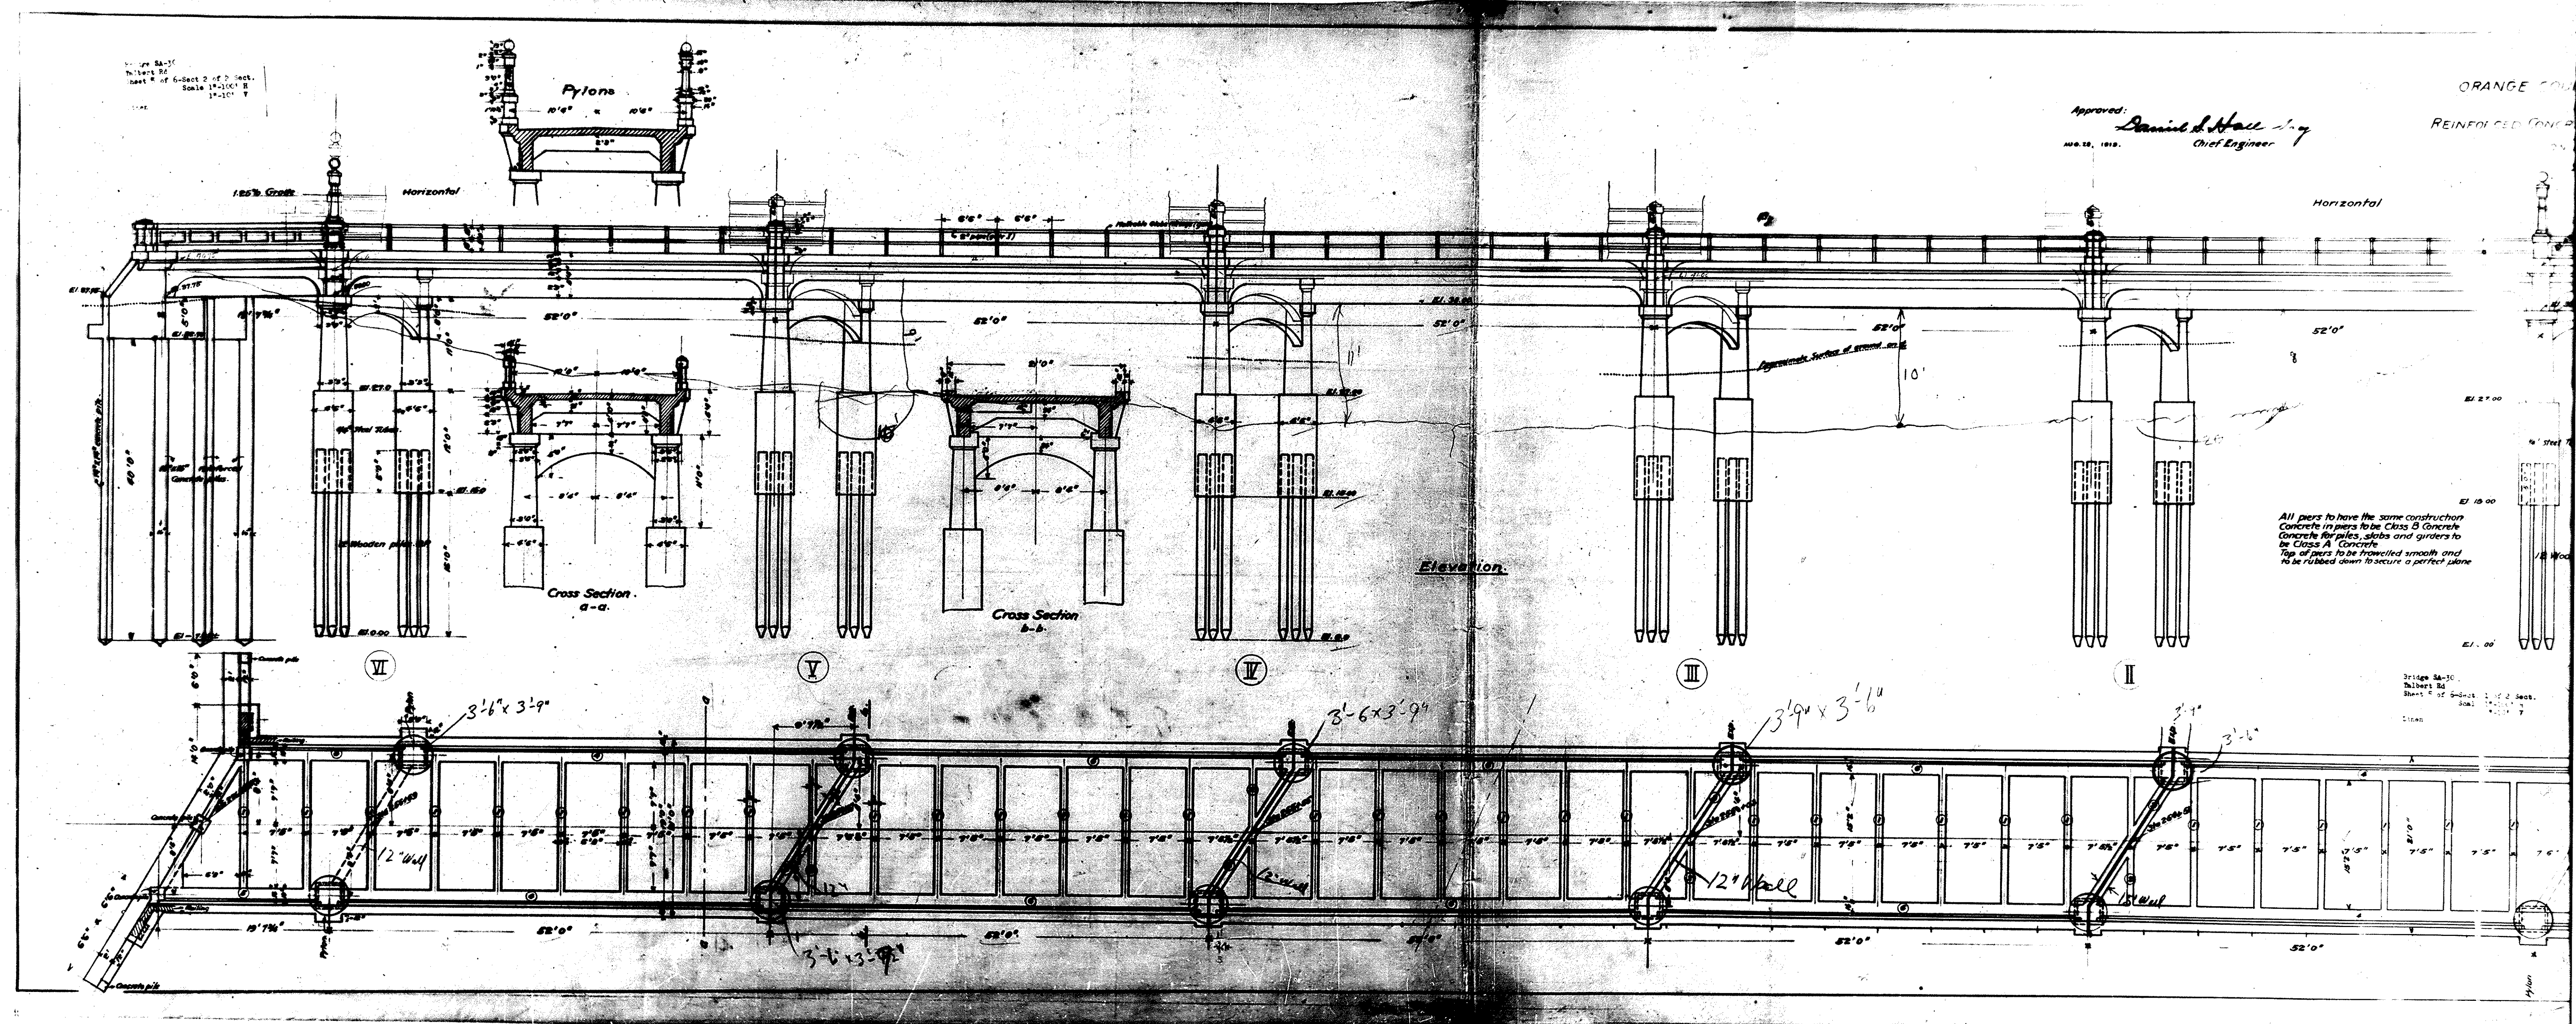

REINFORCED CONCRETE

Horizontal

*All piers to have the same construction.
Concrete in piers to be Class B Concrete.
Concrete for piles, slabs and girders to
be Class A Concrete.
Top of piers to be trowelled smooth and
to be rubbed down to secure a perfect plane*

Bridge 3A-10.
Talbert Rd
Sheet 5 of 6-Sect. 2 of 2 Sect.
Scale 1"=200' 4
"=100' 7
Linen

Sht 5/5

~~6/7~~