


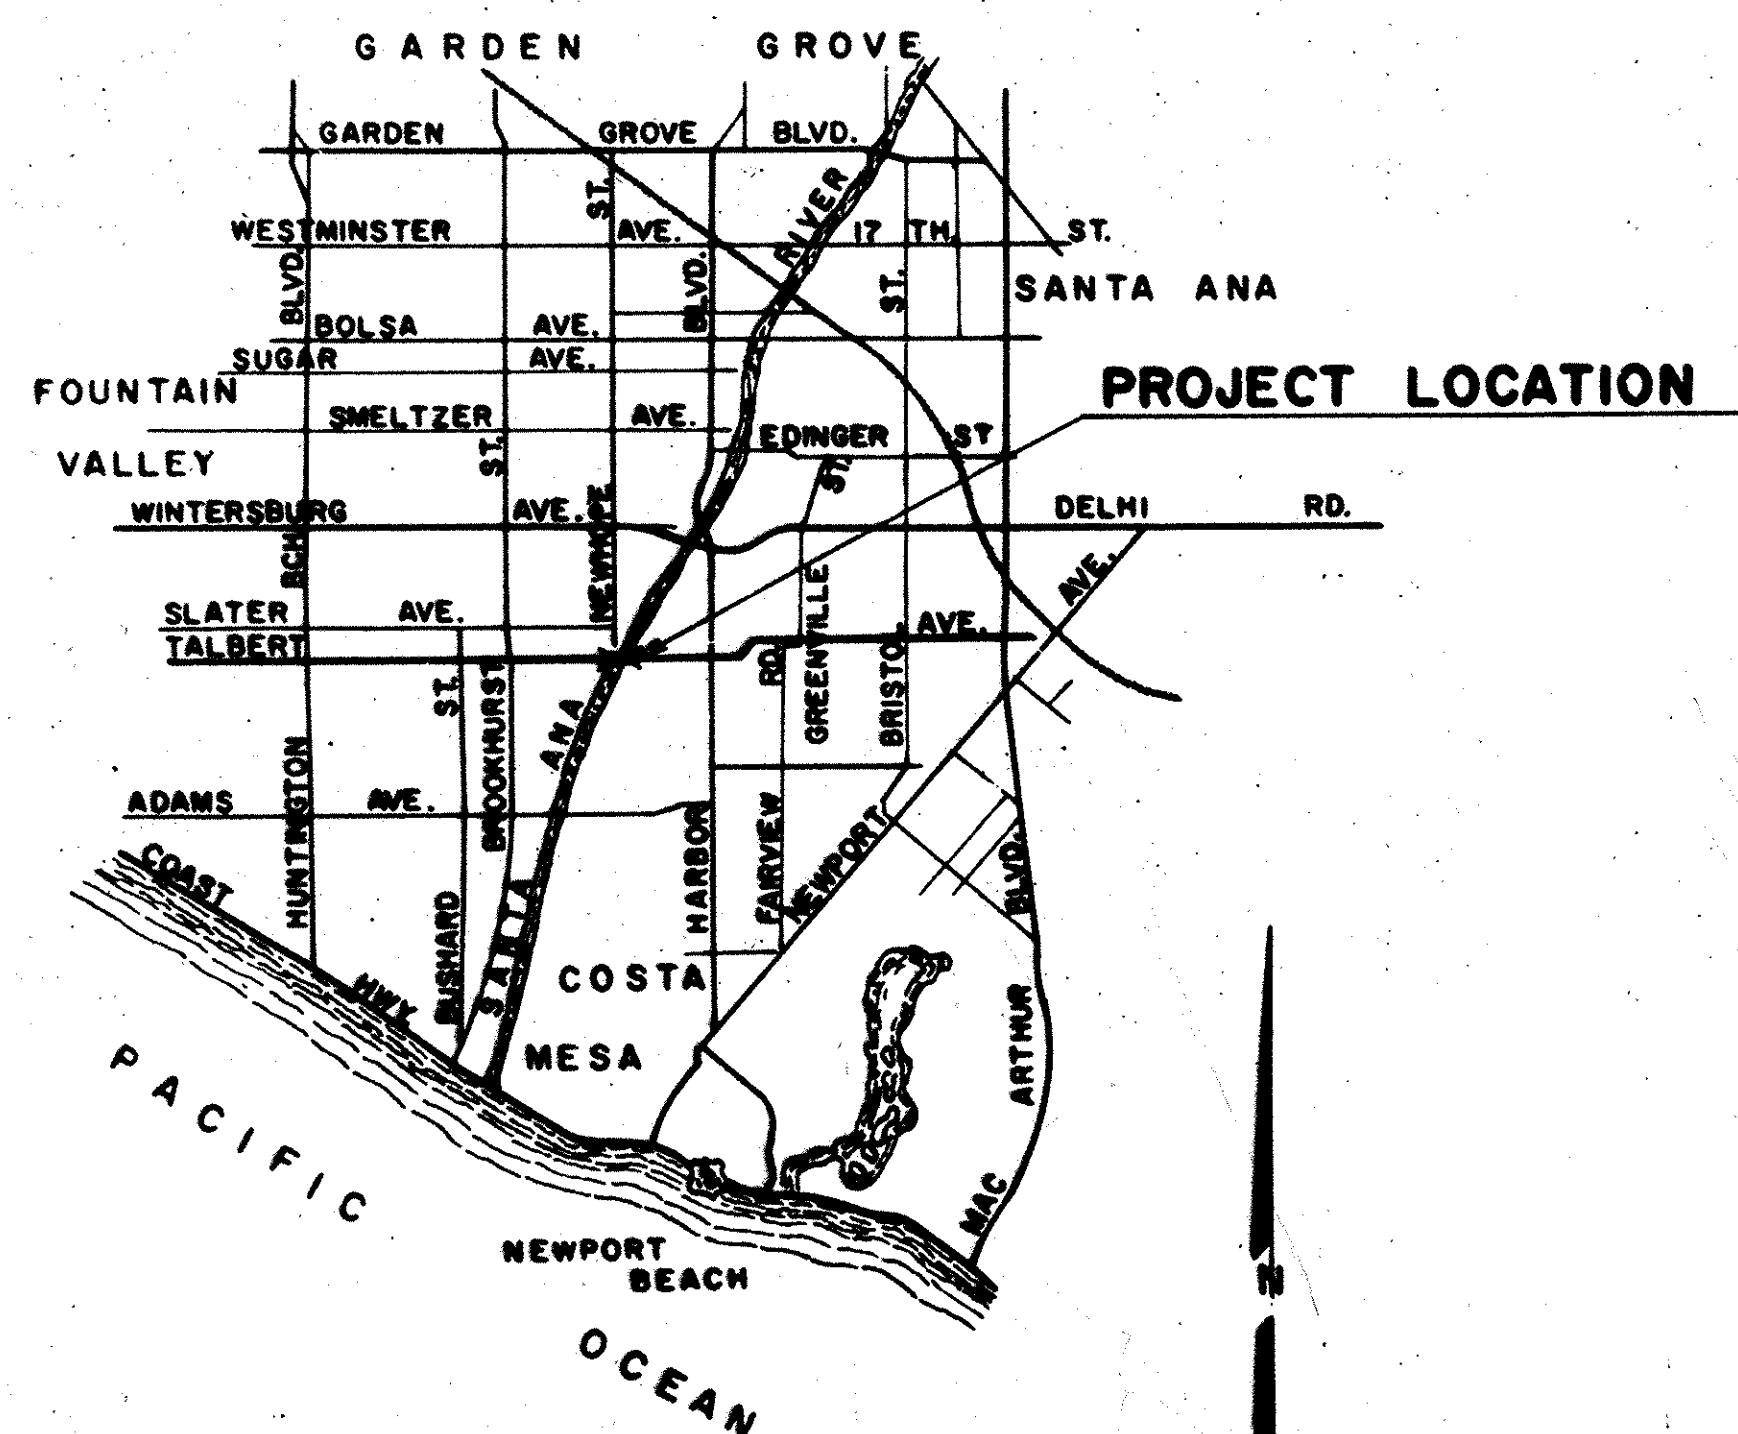

LOCATION MAP
1" = 5/8 Mile approx.

ORANGE COUNTY HIGHWAY DEPARTMENT STATE OF CALIFORNIA

PLAN AND PROFILE

TALBERT AVENUE BRIDGE

ACROSS SANTA ANA RIVER (CHANNEL E1) SA-32
FROM STATION 8+42.55 TO STATION 11+39.30
TOTAL LENGTH 0.056 MILES

INDEX OF SHEETS

SHEET	NO 1/	TITLE SHEET
"	" 2	GENERAL PLAN
"	" 3	PILE PLAN
"	" 4	ABUTMENT DETAIL
"	" 5	PIER DETAIL
"	" 6	SUPERSTRUCTURE
"	" 7	TYPICAL SECTION
"	" 8	STANDARD DETAILS
"	" 9	HINGE DETAIL
"	" 10	RAIL DETAIL
"	" 11	PILE STANDARDS
"	" 12	LOG OF TEST BORINGS


COUNTY OF ORANGE

Alvin S. Tolan
ROAD COMMISSIONER
CIVIL ENGINEER LICENSE NO. 7872

7-27-61
DATE

H. J. Colman
FLOOD CONTROL ENGINEER
CIVIL ENGINEER LICENSE NO. 7188

7-25-61
DATE

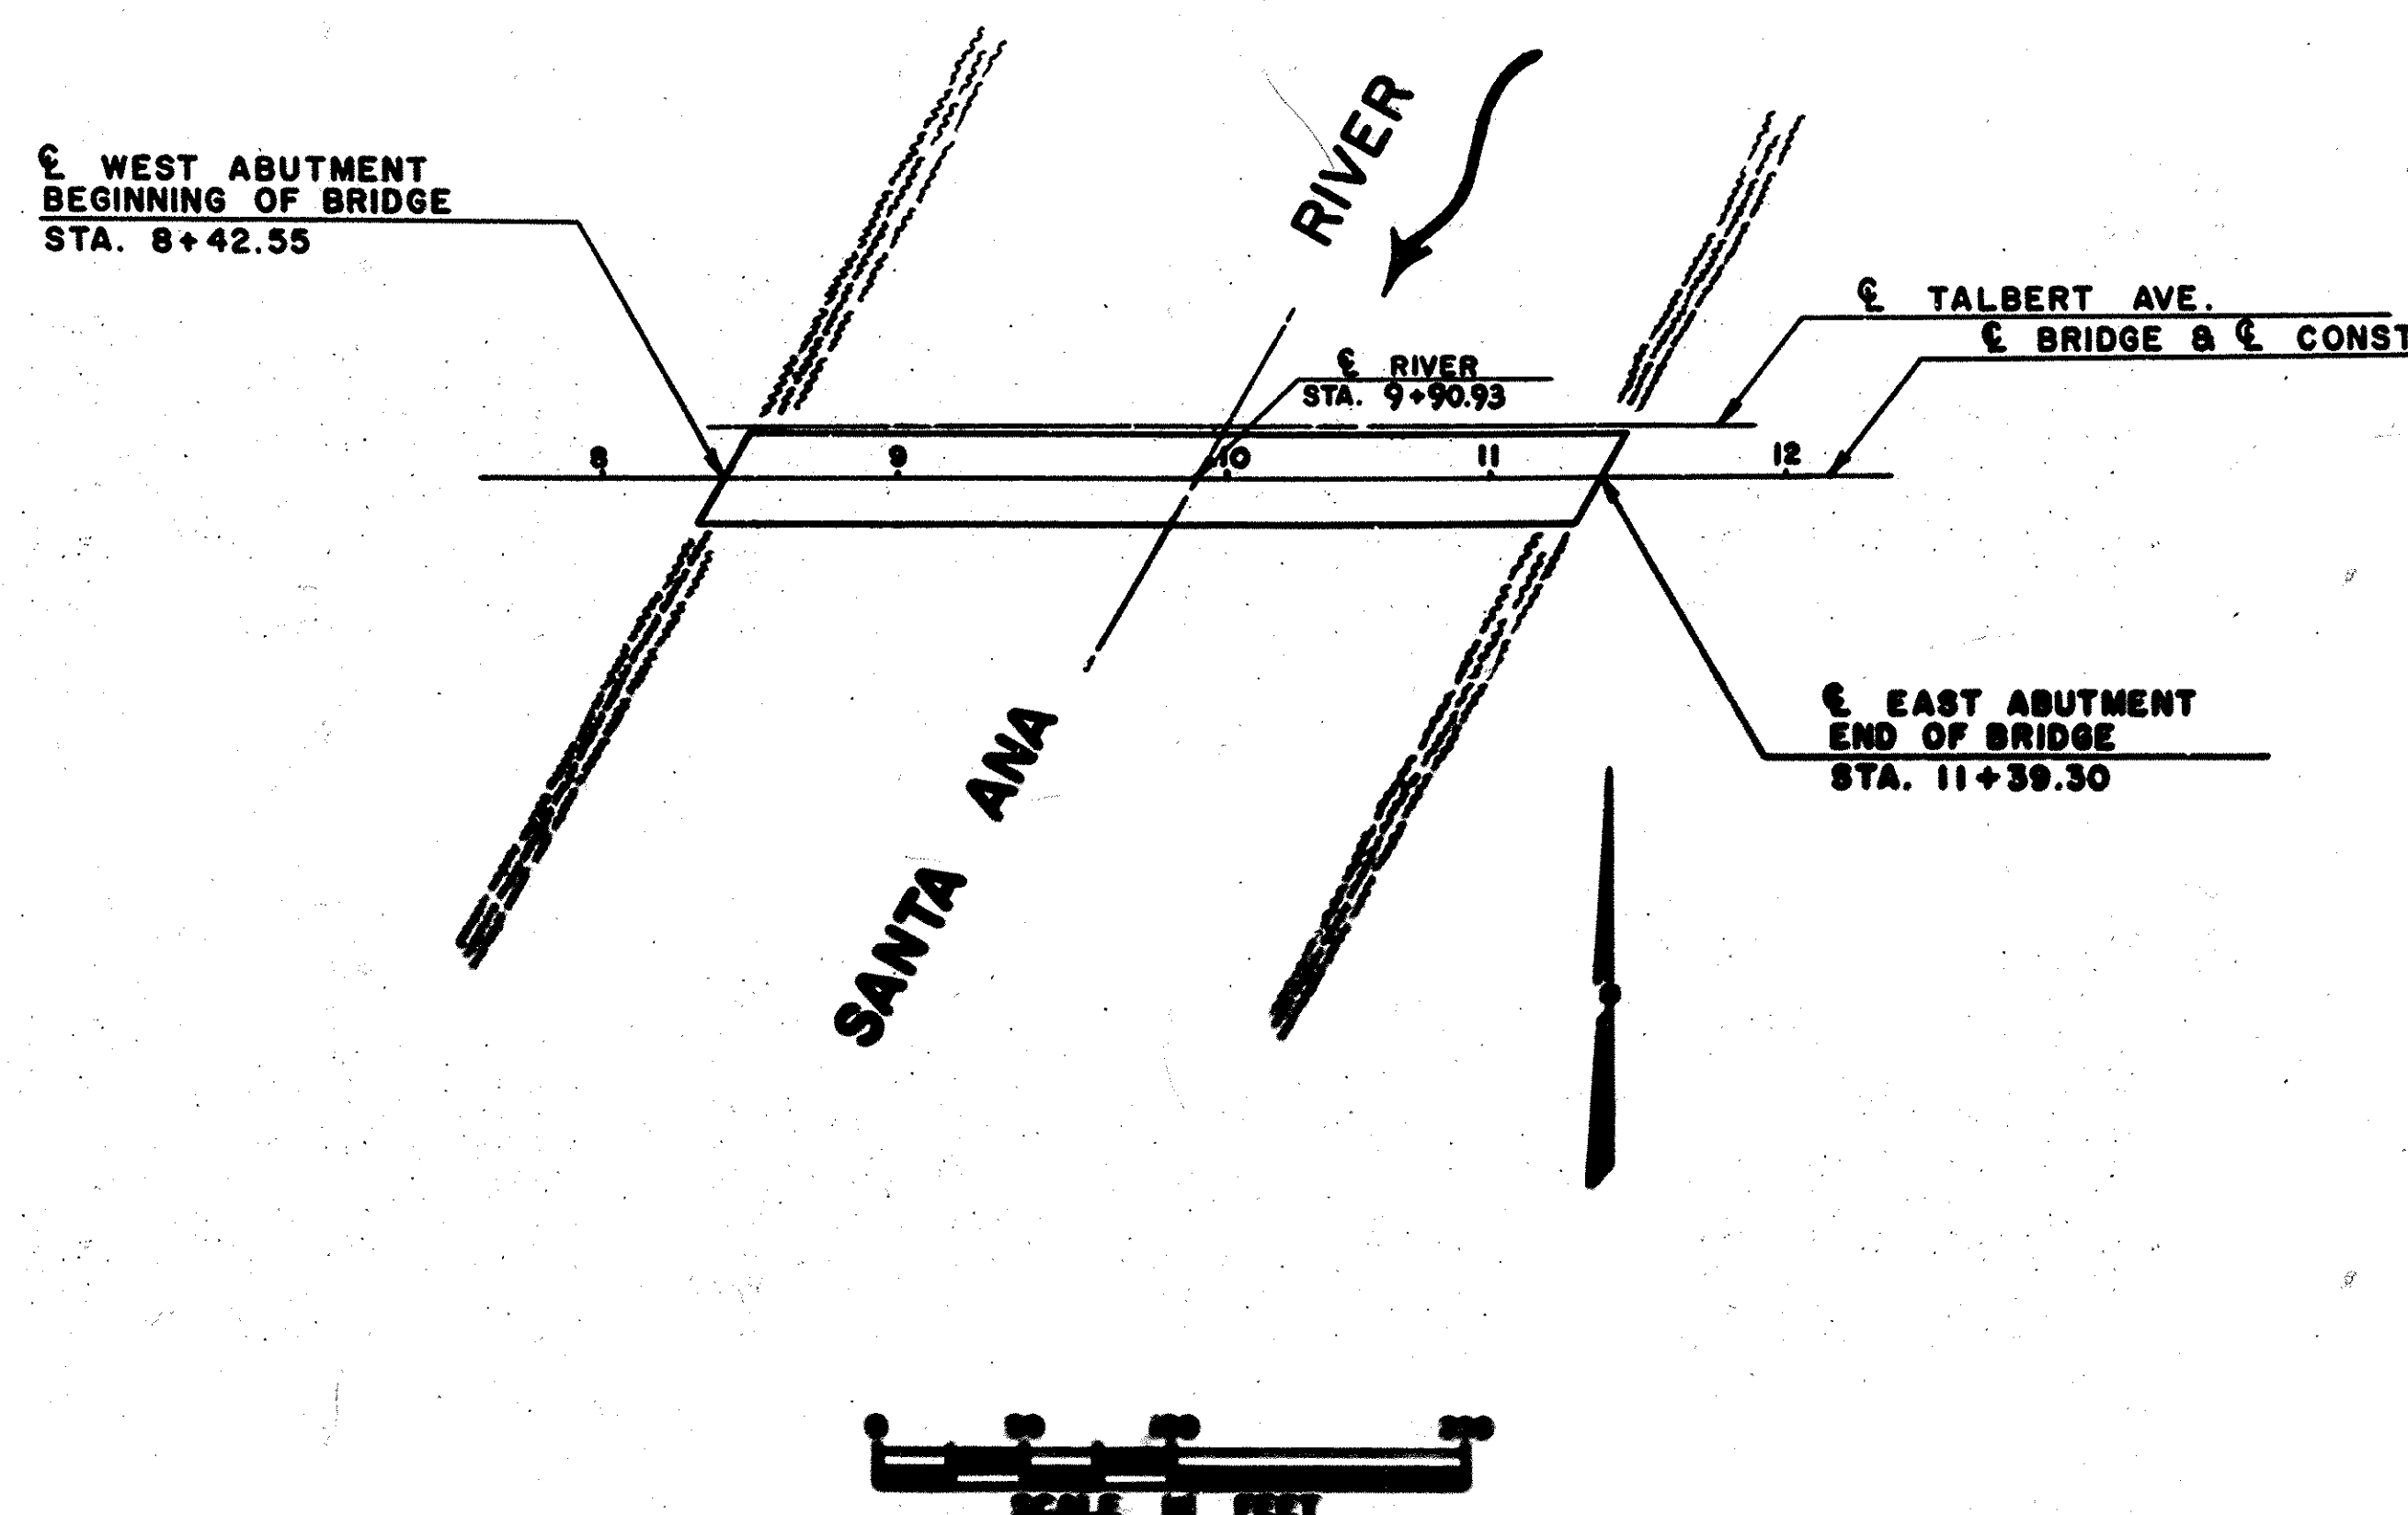

CONVENTIONAL SIGNS	
COUNTY LINE	RAILROAD TRACKS
CITY LIMITS	CULVERTS
R/W LINE	WOOD FENCE
BASE OR SURVEY LINE	WIRE FENCE
CONSTRUCTION	CHAIN LINK FENCE
TRAVELED WAY	CORRUGATED METAL FENCE
RAILROAD TRACKS	CONCRETE WALL
CULVERTS	MASONRY WALL
WOOD FENCE	HEAD OR RIGGS
WIRE FENCE	DAM OR RETAINING WALL
CHAIN LINK FENCE	FILL SLOPE
CORRUGATED METAL FENCE	CUT SLOPE
CONCRETE WALL	
MASONRY WALL	
HEAD OR RIGGS	
DAM OR RETAINING WALL	
FILL SLOPE	
CUT SLOPE	

SA 32
Talbert Ave. Bridge
Sheet 1 of 12
Ref. Ratio 72.5:1
Scale - Graphic
Autopositive

MICROFILMED
JUN 18 1962