



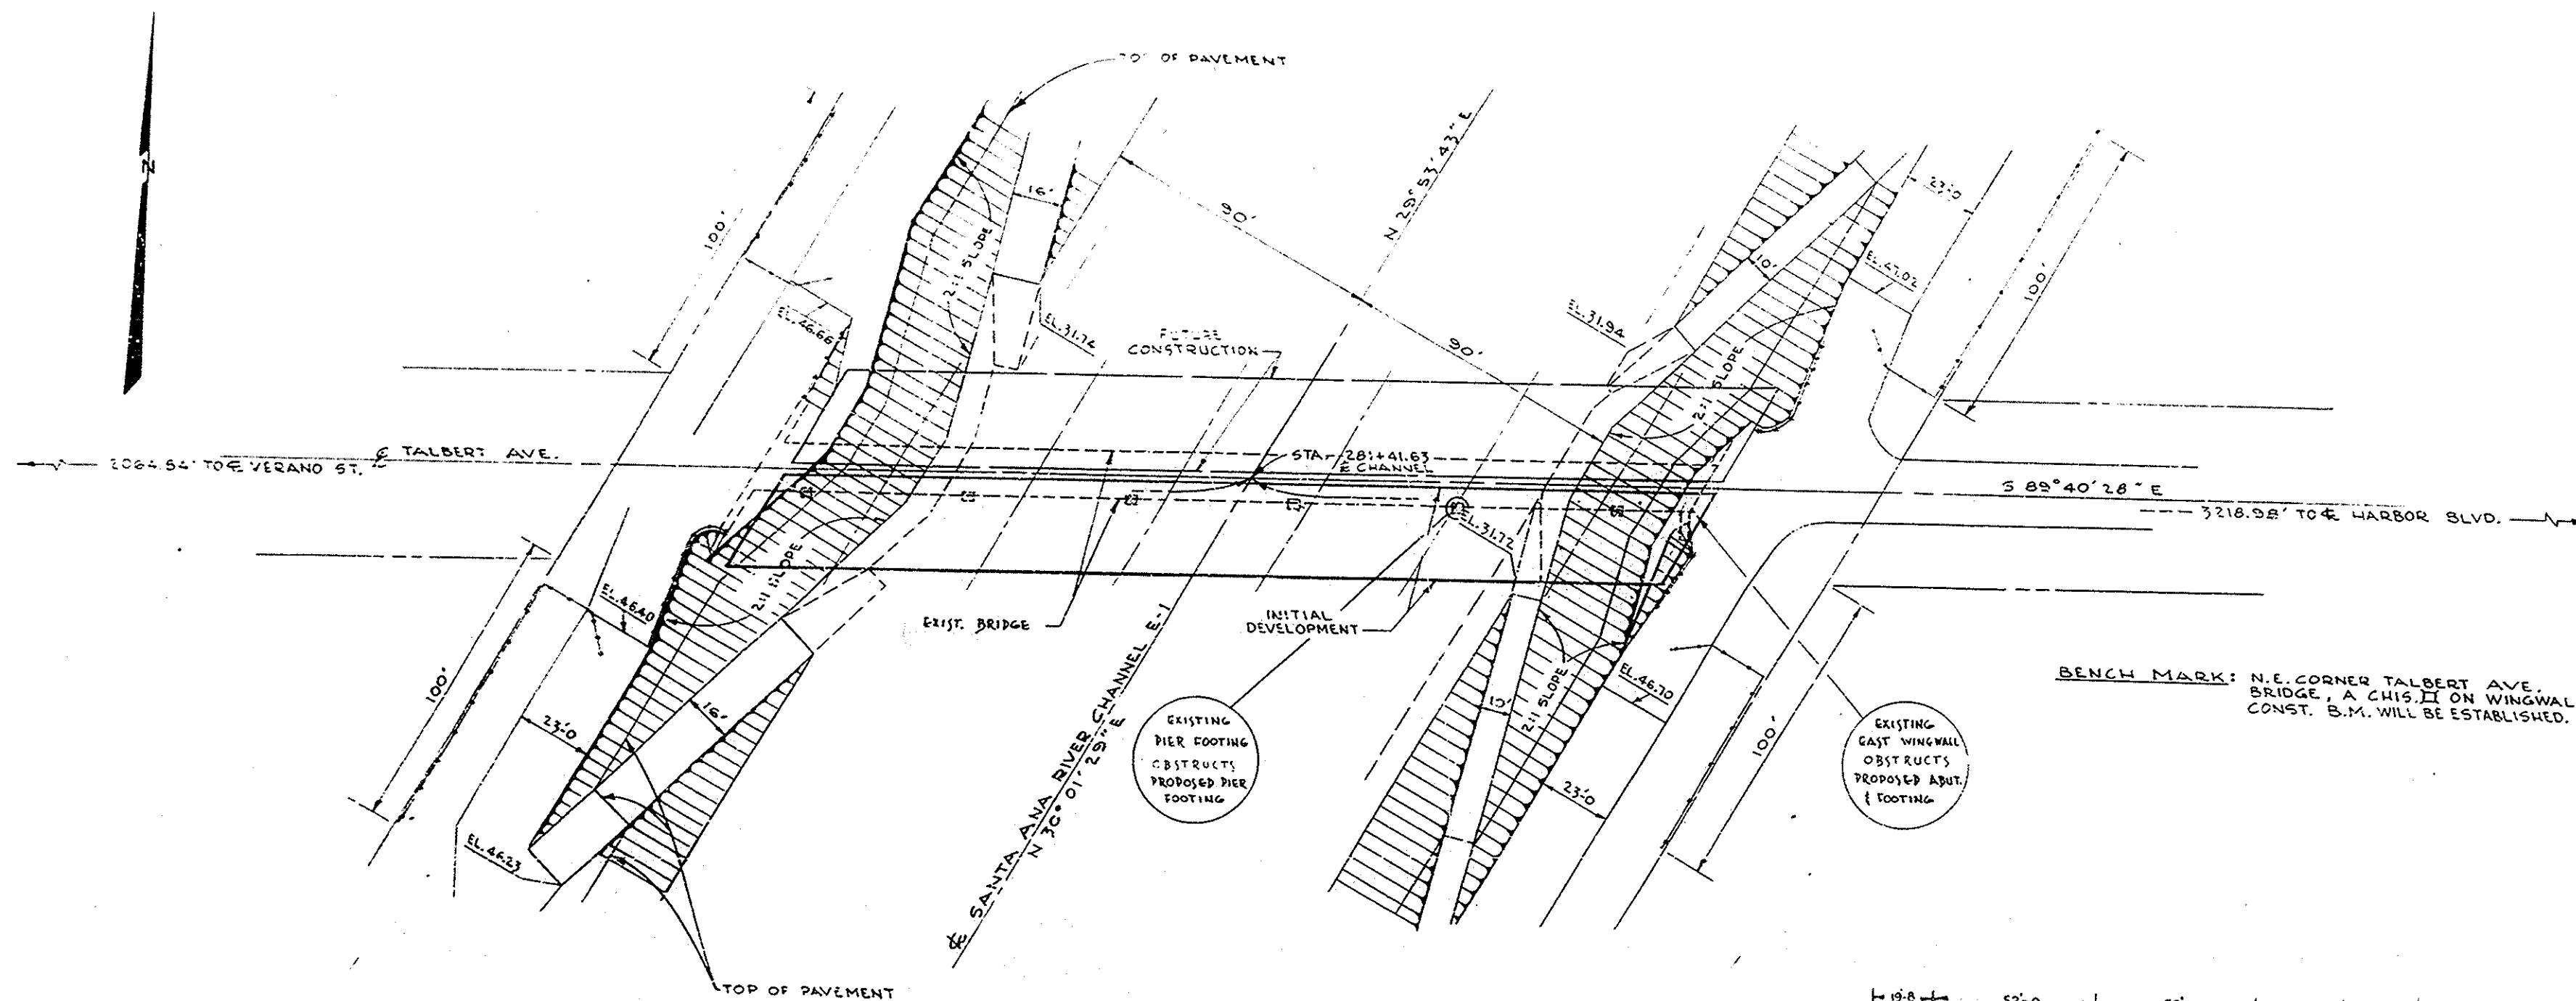

PLAN

SCALE 1" = 30'


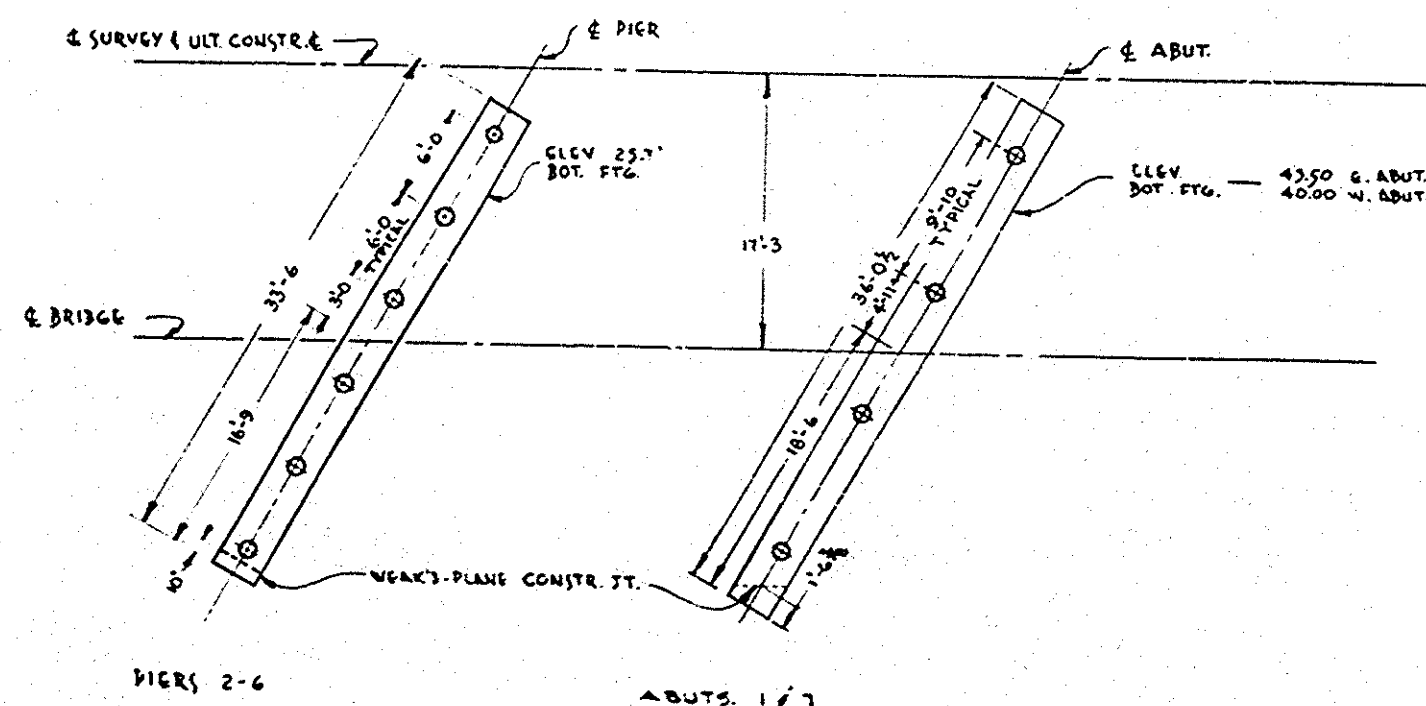


PILE LAYOUT

SCALE 1" = 10'

PIILING DATA

FOOTING NUMBER	SPEC. PILE TIP ELEV.	ELEV. PILE CUTOFF
ABUT. 1	-12	40.50
PIER 2	-12	26.20
PIER 3	-12	26.20
PIER 4	-12	26.20
PIER 5	-12	26.20
PIER 6	-12	26.20
PIER 7	-12	26.20
ABUT. 8	-12	44.00

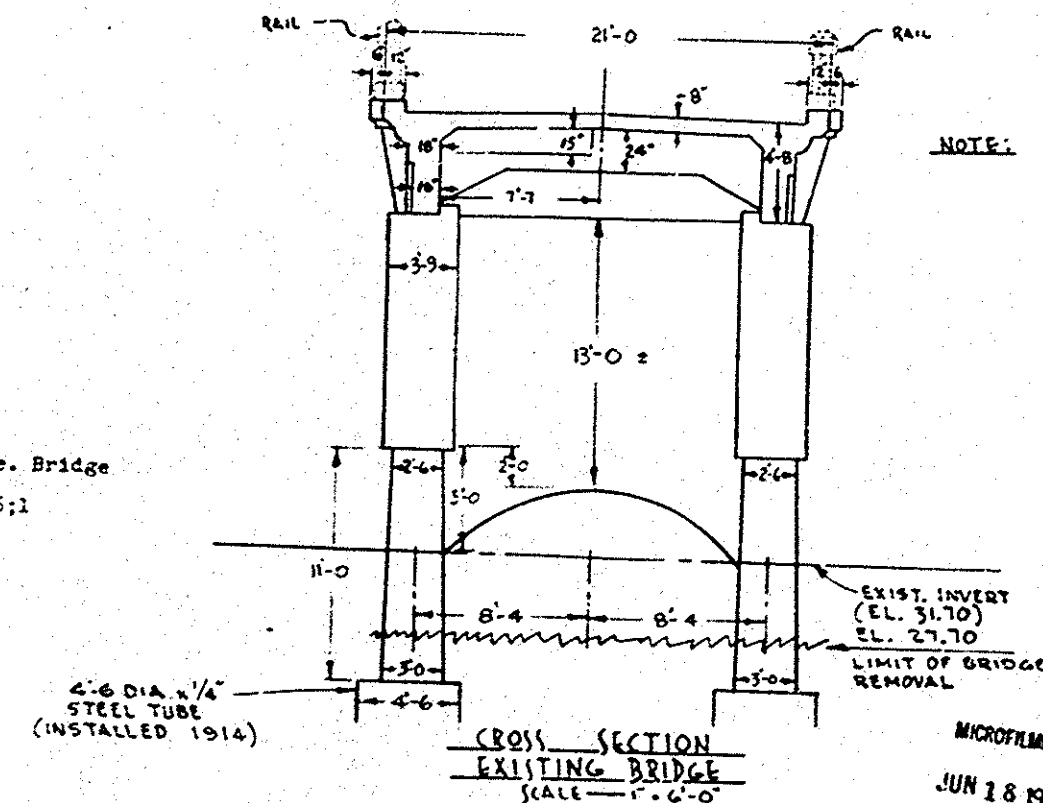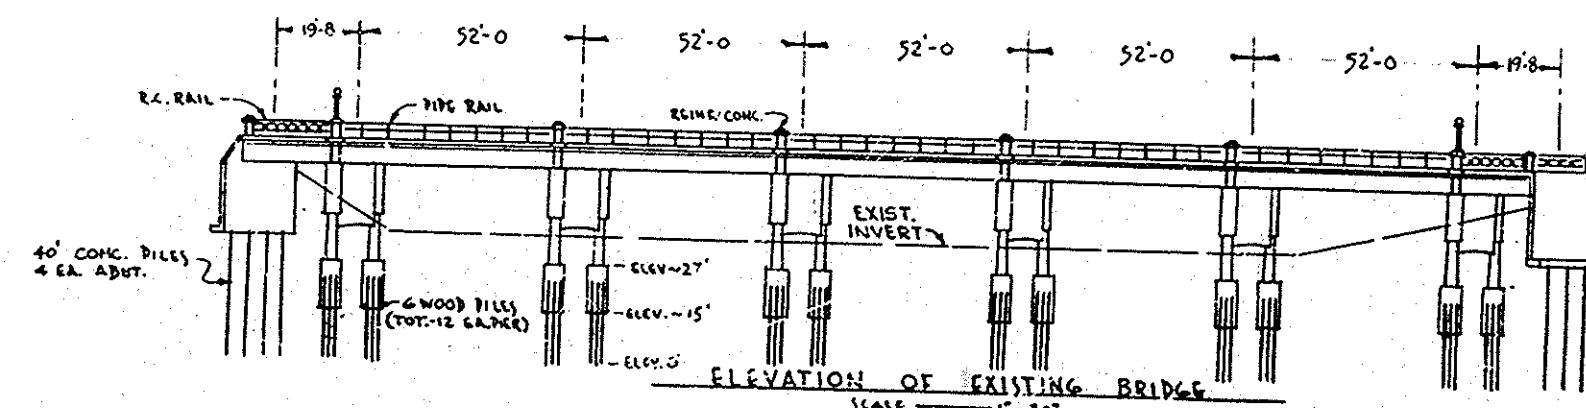

NOTE: CONSTR. TYPE — REINF. CONC.
CONSTR. DATE — 1913
BRIDGE RAISED — 1931
DIMENSIONS AS NOTED TO BE VERIFIED BY CONTRACTOR
PLANS OF EXISTING BRIDGE AVAILABLE IN HIGHWAY DEPT. OFFICE.

ORANGE COUNTY HIGHWAY DEPARTMENT	
TALBERT AVE. BRIDGE ACROSS SANTA ANA RIVER	
PILE PLAN	
SCALE: NOTED	SHEET 3 OF 12

#14695