
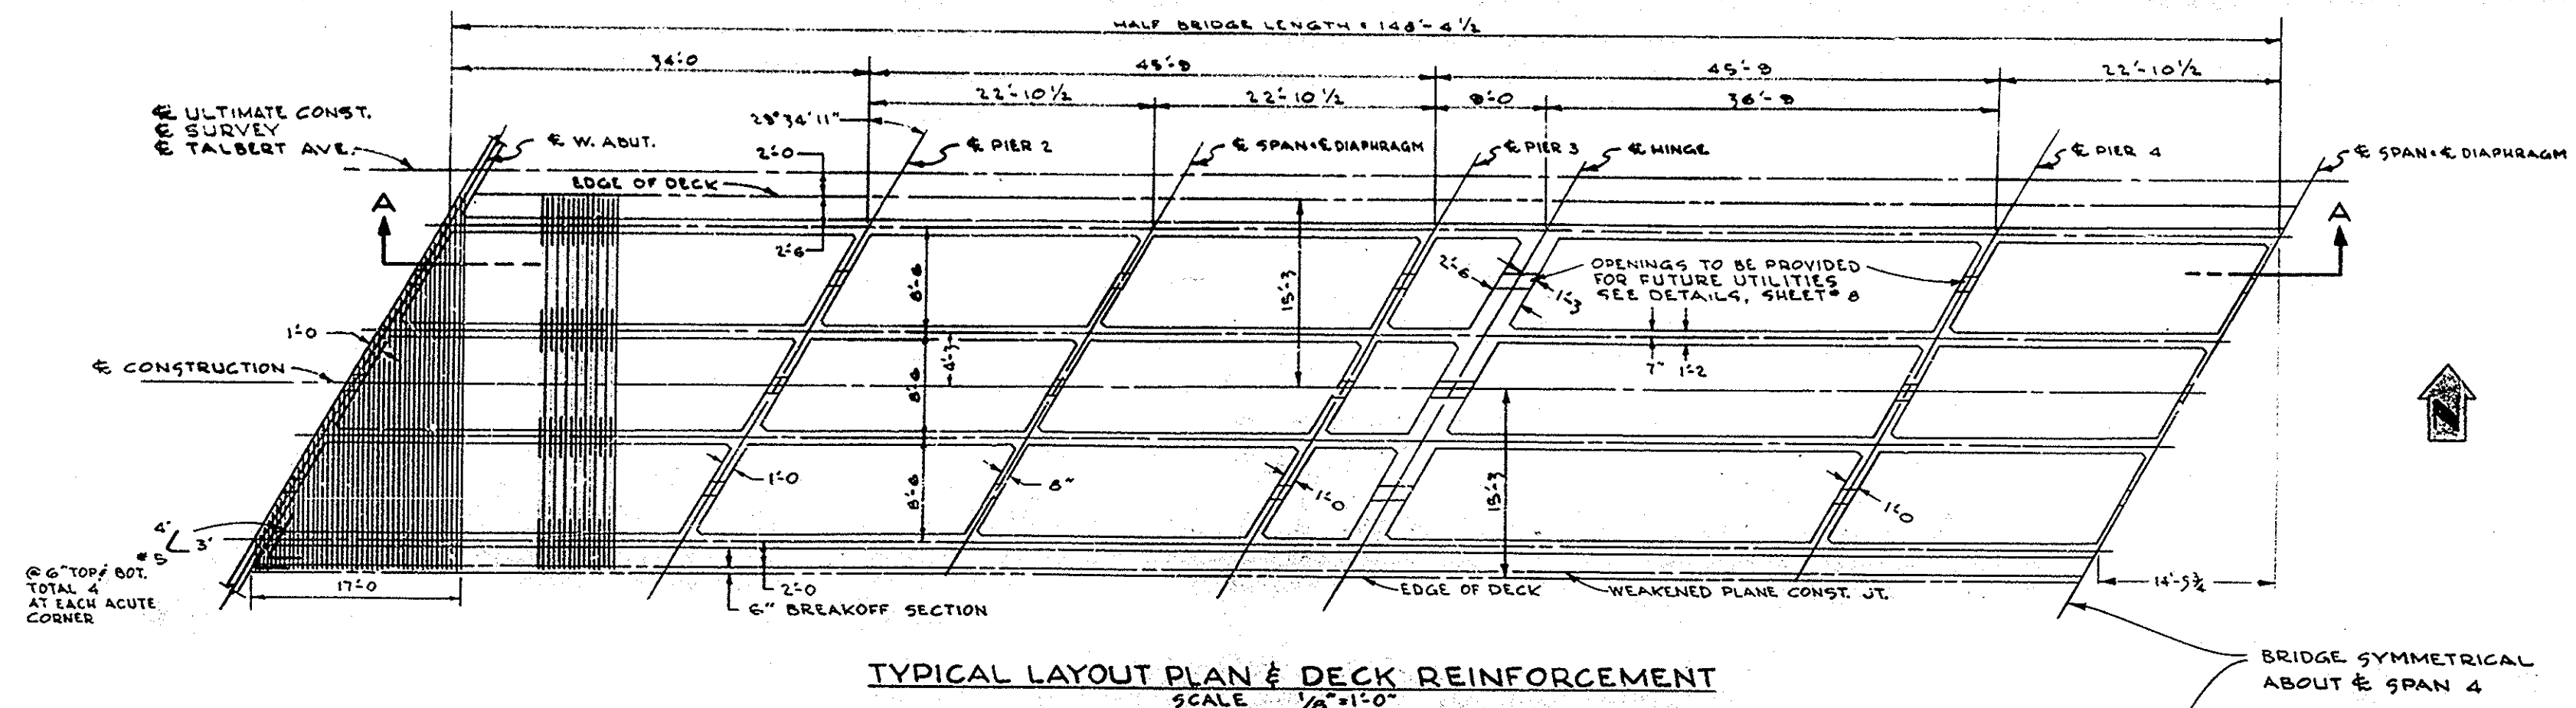
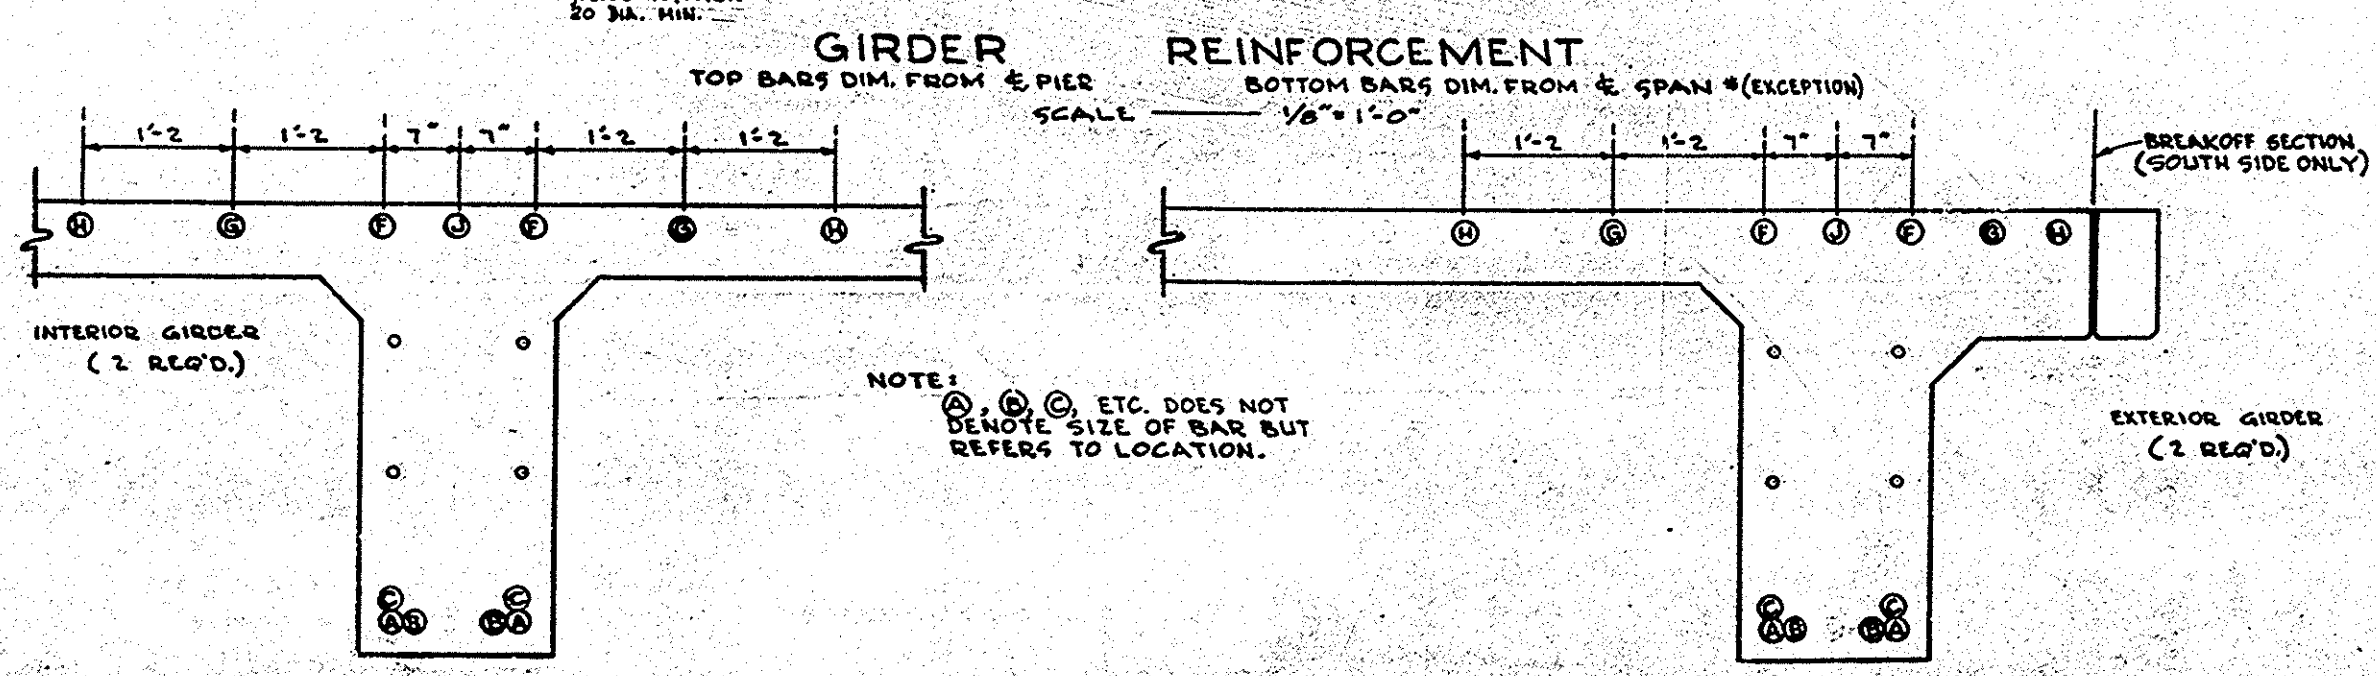


TOP
REINFORCEMENT
BOTTOM

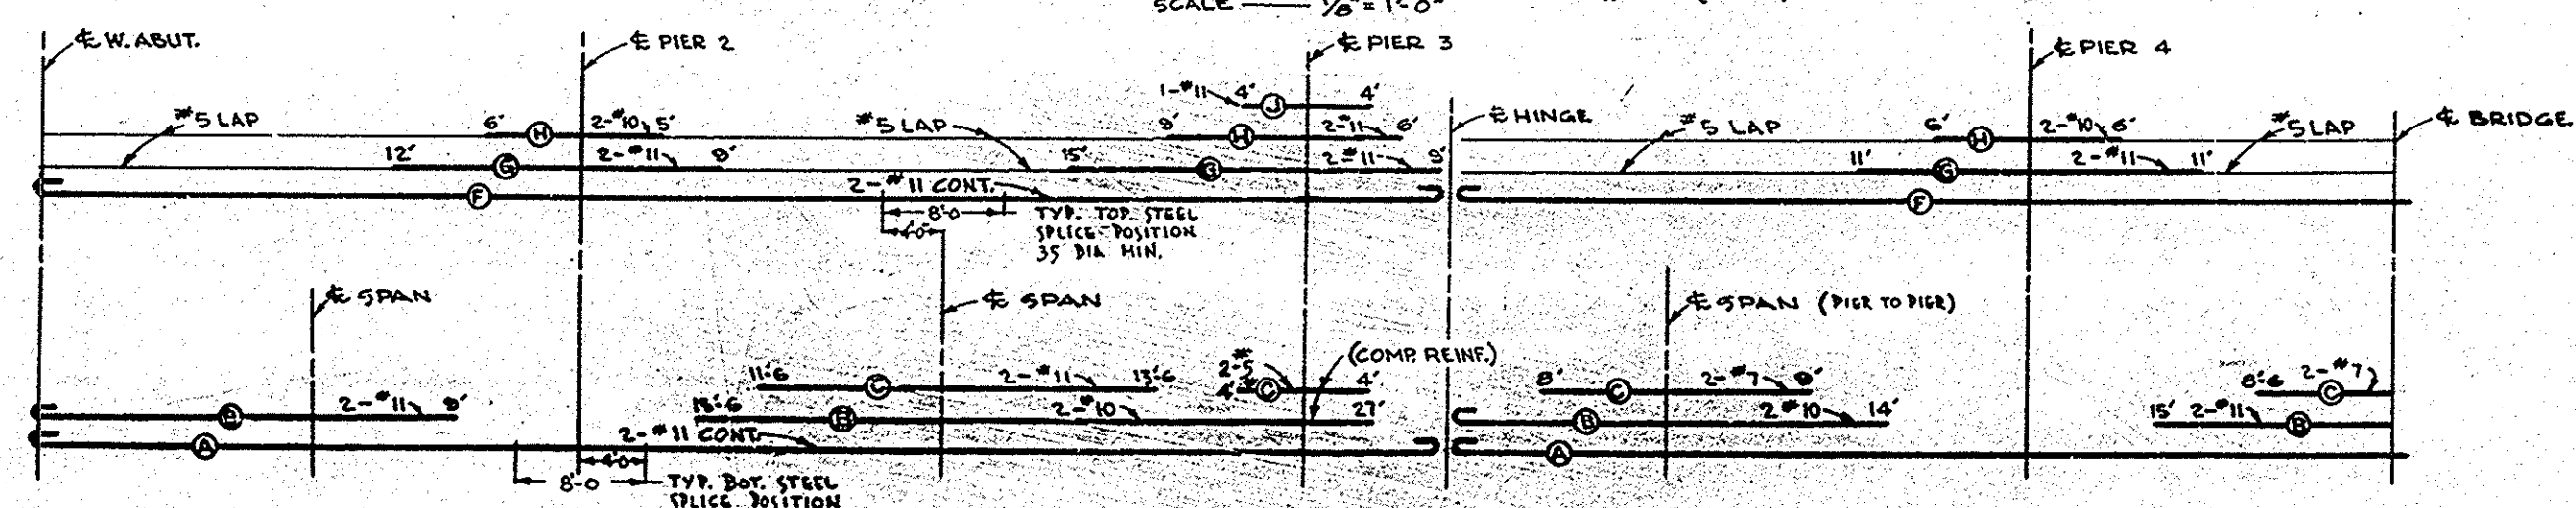

NOTE: ①, ②, ③, ETC. DOES NOT DENOTE SIZE OF BAR BUT REFERS TO LOCATION.

SA 32
P/O Talbert Ave Bridge
Sheet 6 of 12
Red. Ratio 22.5:1
Scale As Noted
Pencil Sketch

ORANGE COUNTY HIGHWAY DEPARTMENT	
TALBERT AVE. BRIDGE ACROSS SANTA ANA RIVER	
SUPERSTRUCTURE REINFORCEMENT	
SCALE NOTED	SHEET 6 OF 12

MICROFILMED
JUN 18 1962

#14695