
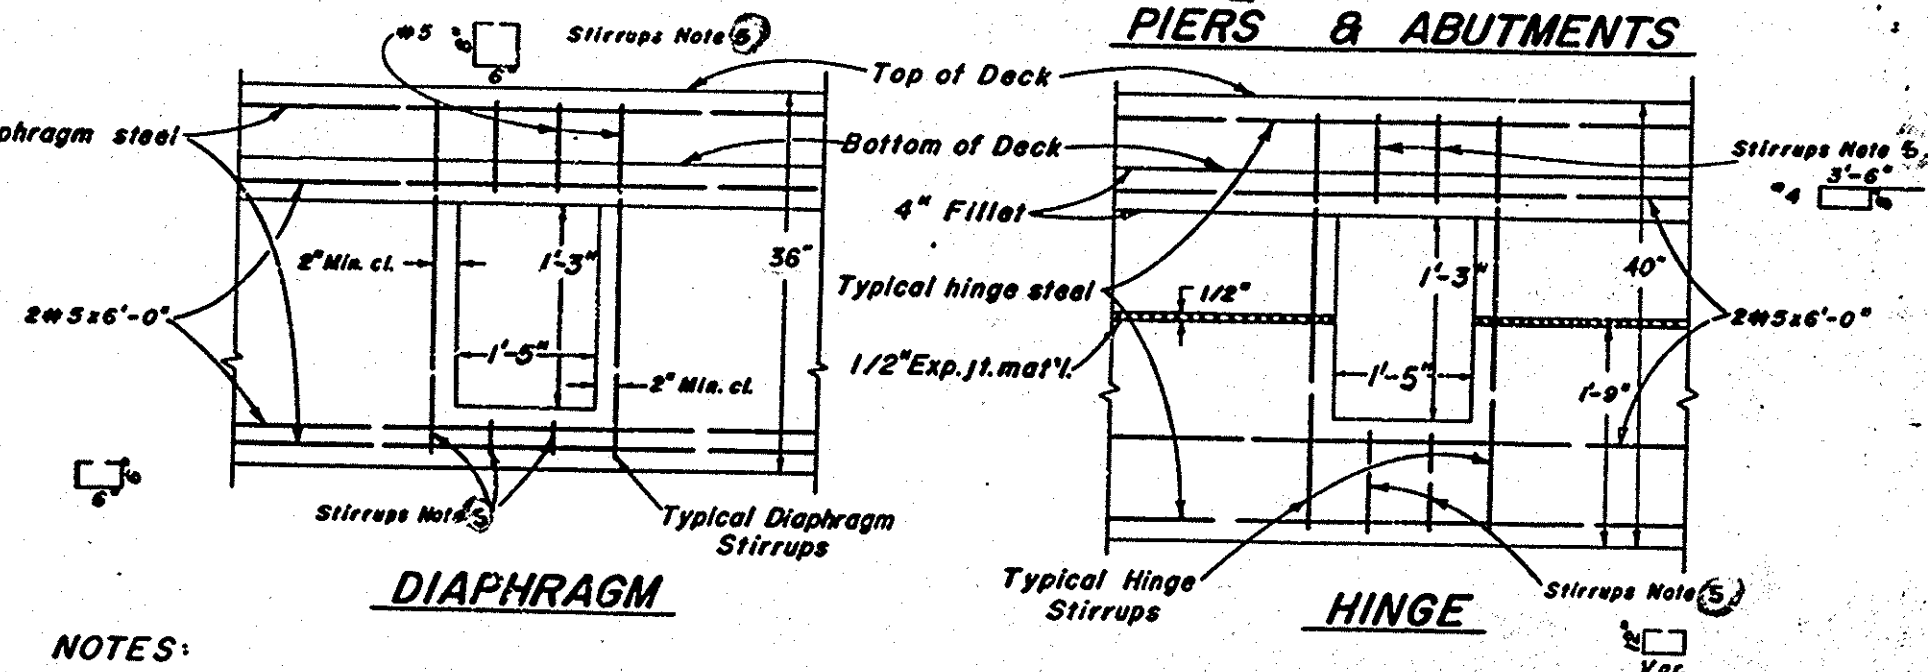
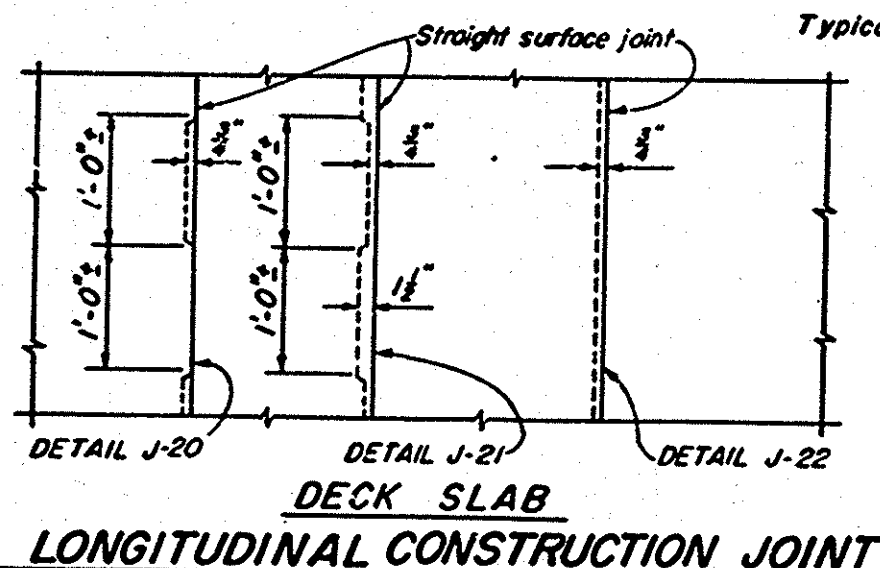
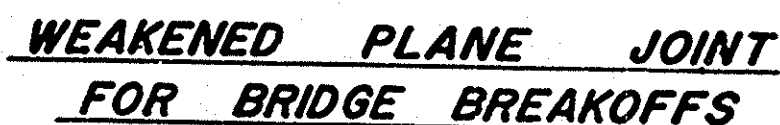
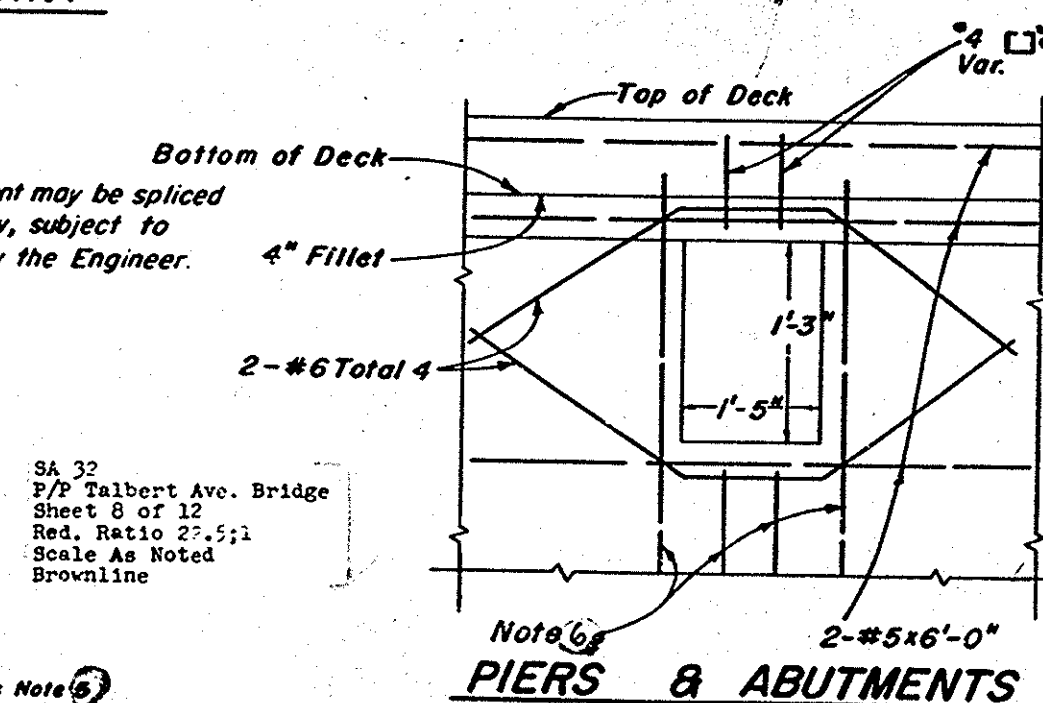
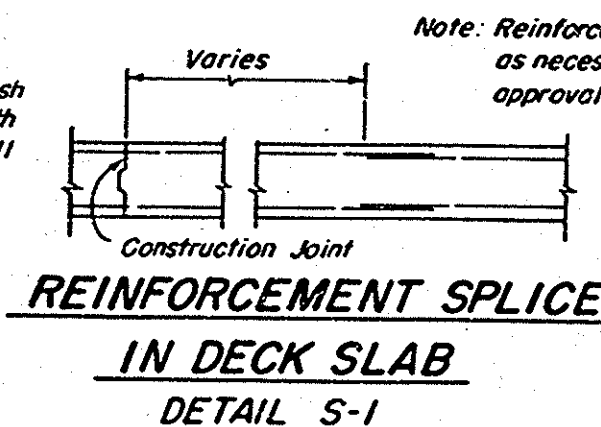
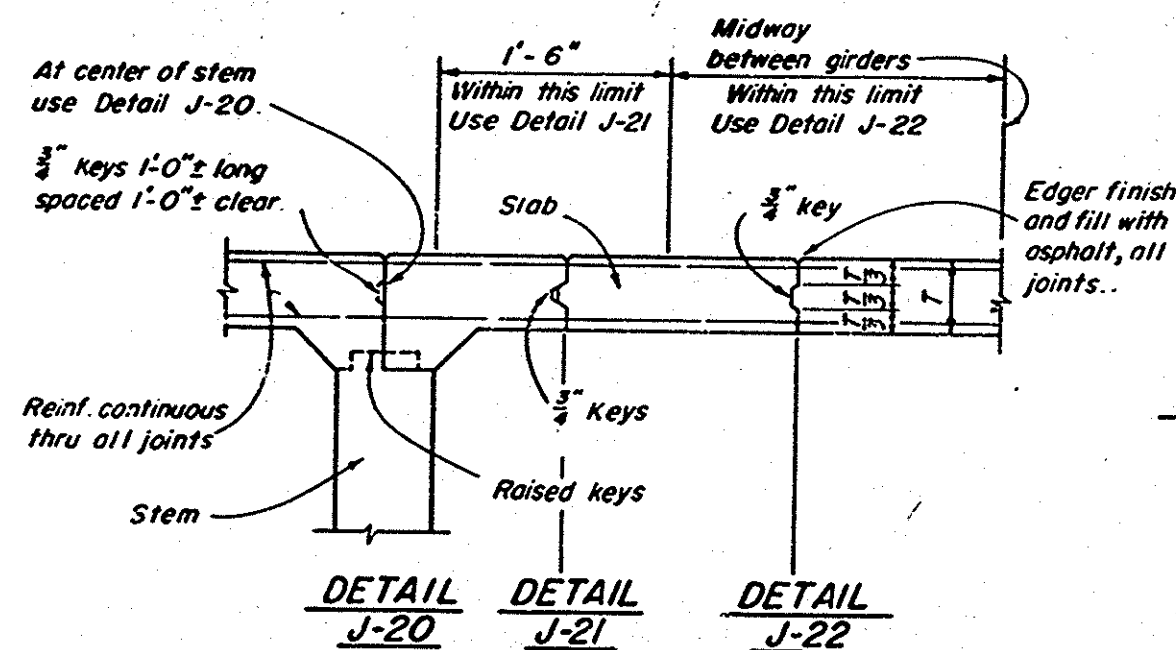


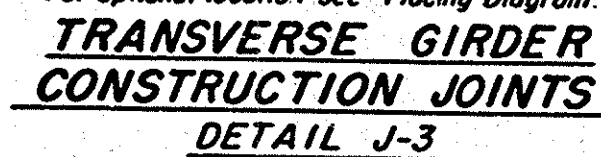

- NOTES:**
- 1 For exact location and direction of openings see other sheets.
 - 2 Girders not shown, see other sheets.
 - 3 Seal around utilities at abutments to be of sufficient strength to withstand earth pressure.
 - 4 All reinforcement detailed to be placed in addition to reinforcement shown on other sheets.
 - 5 Stirrups are same size as adjacent stirrups shown on other sheets.
 - 6 Main reinforcement to clear opening as detailed on other sheets.
- MICROFILM

ORANGE COUNTY HIGHWAY DEPARTMENT

TALBERT AVE. BRIDGE
ACROSS
SANTA ANA RIVER

STANDARD
DETAILS

SCALE: 1" = 40'

#14695