
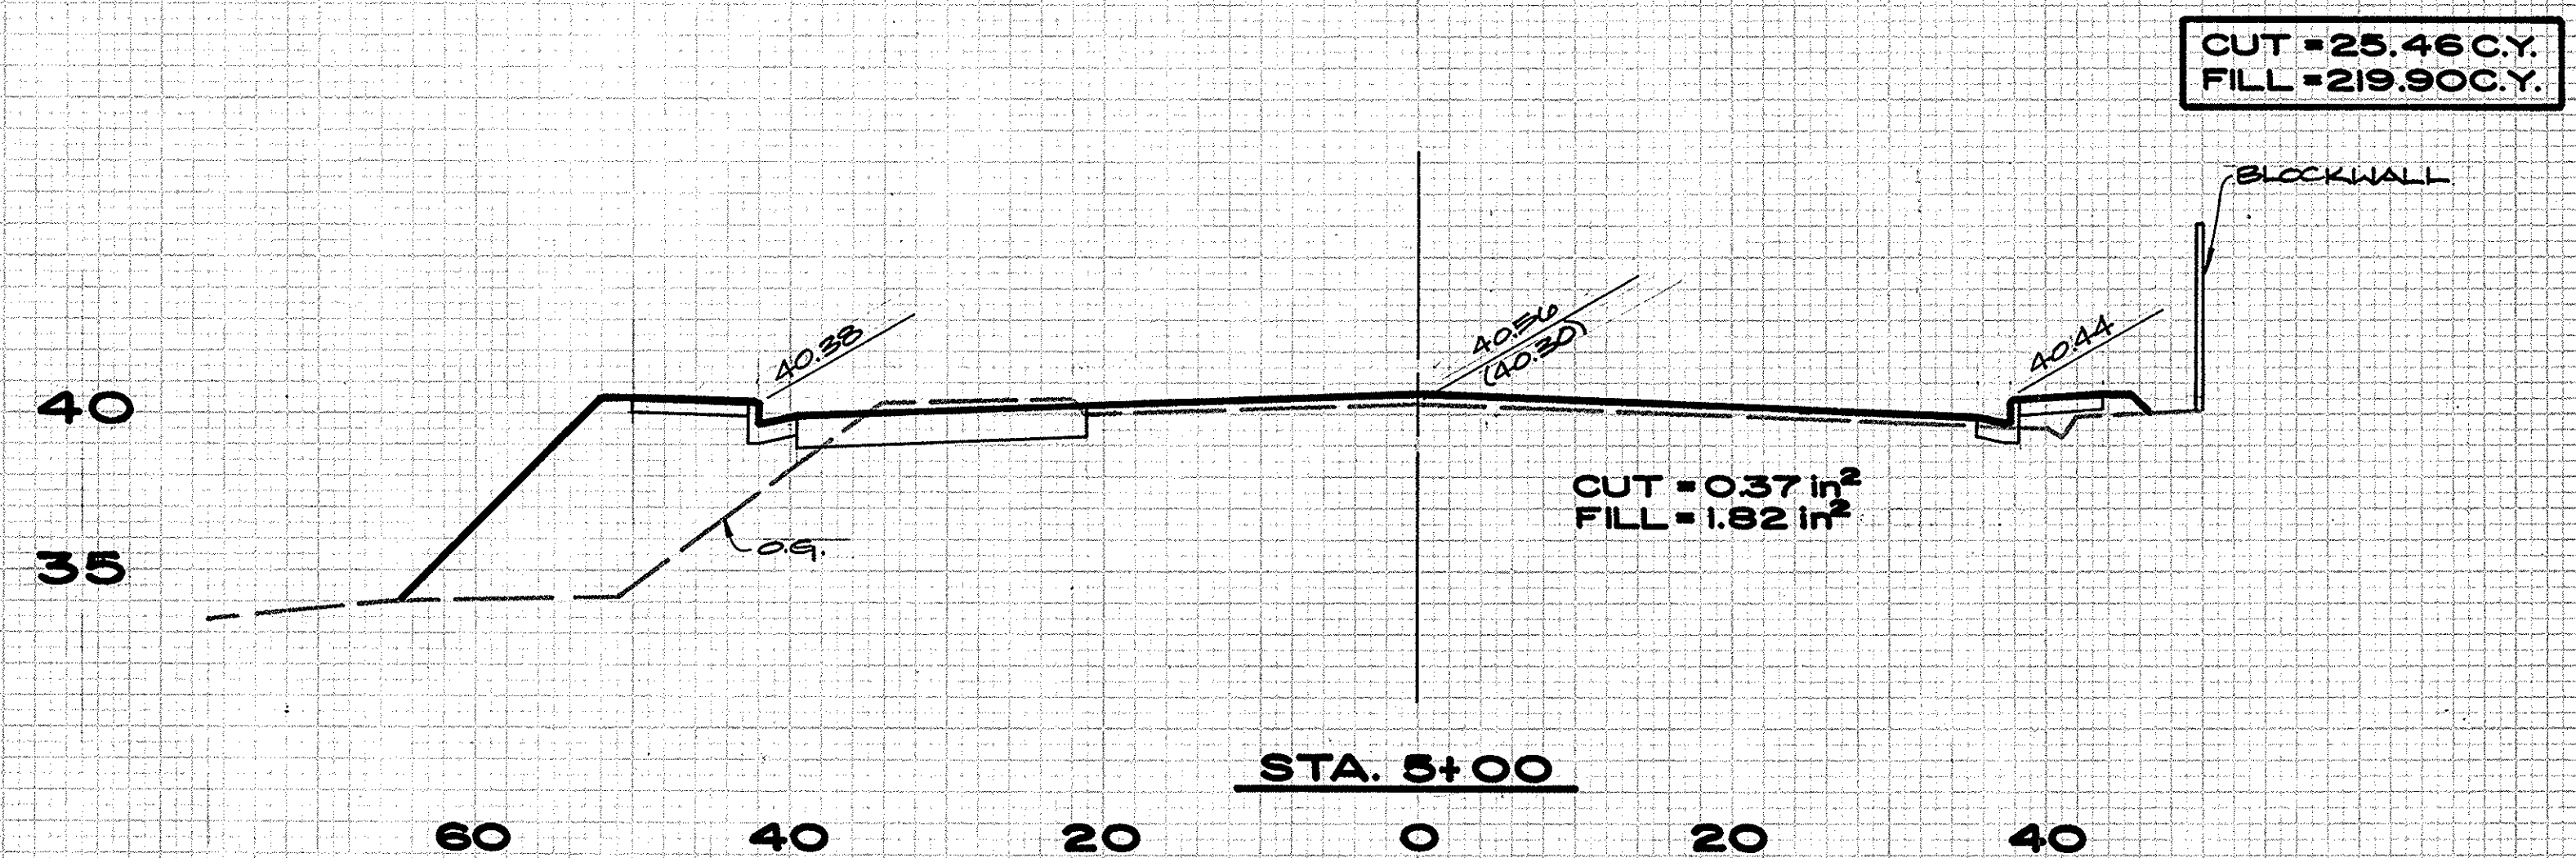
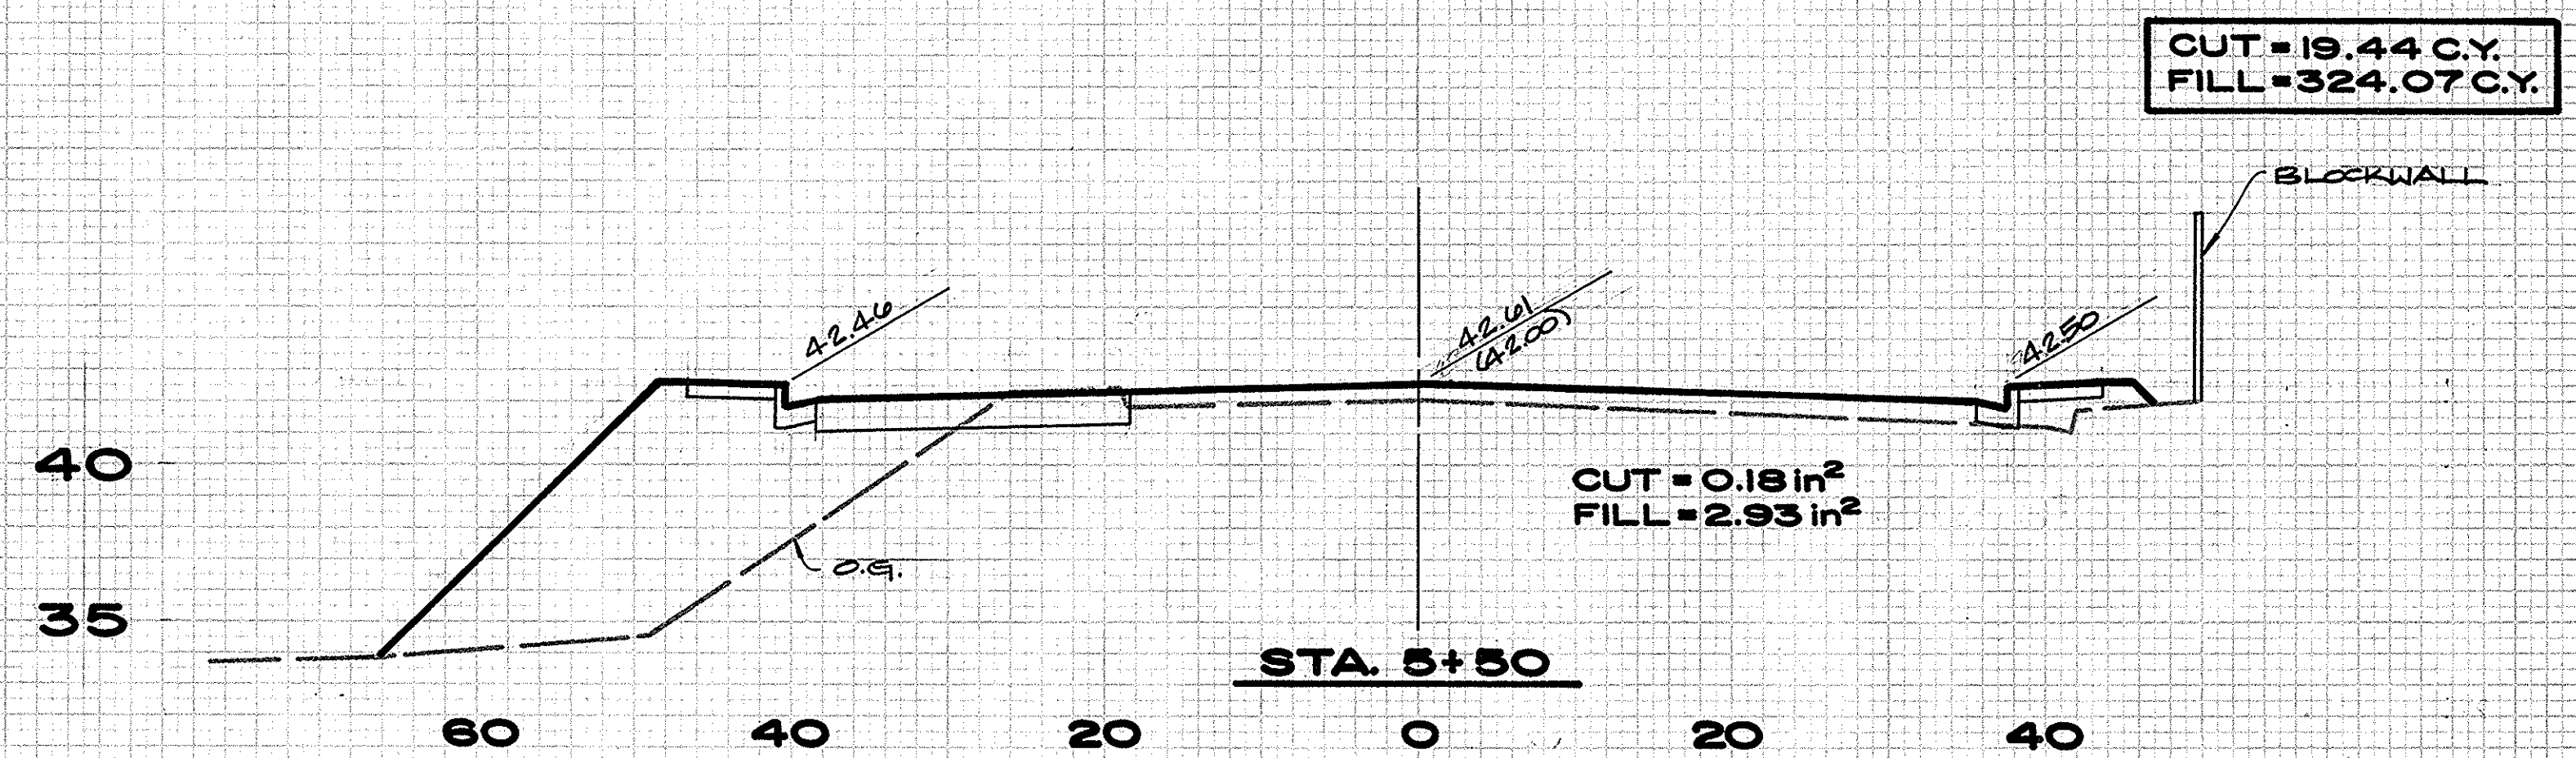
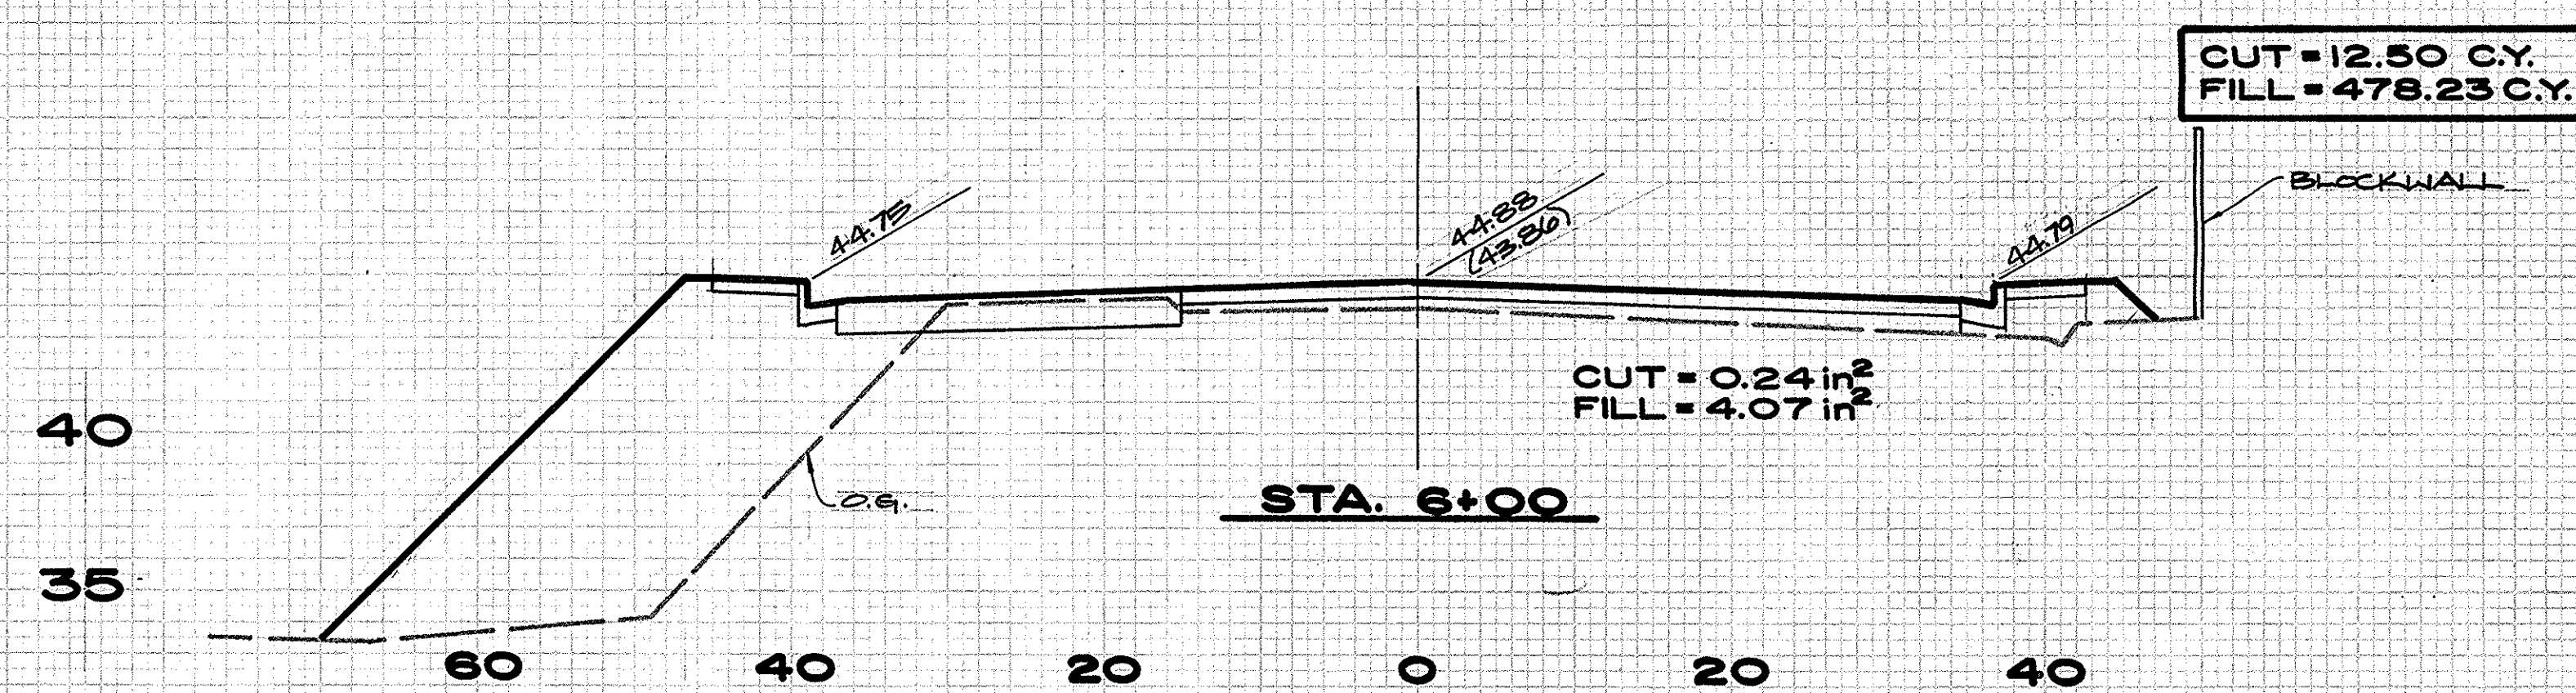
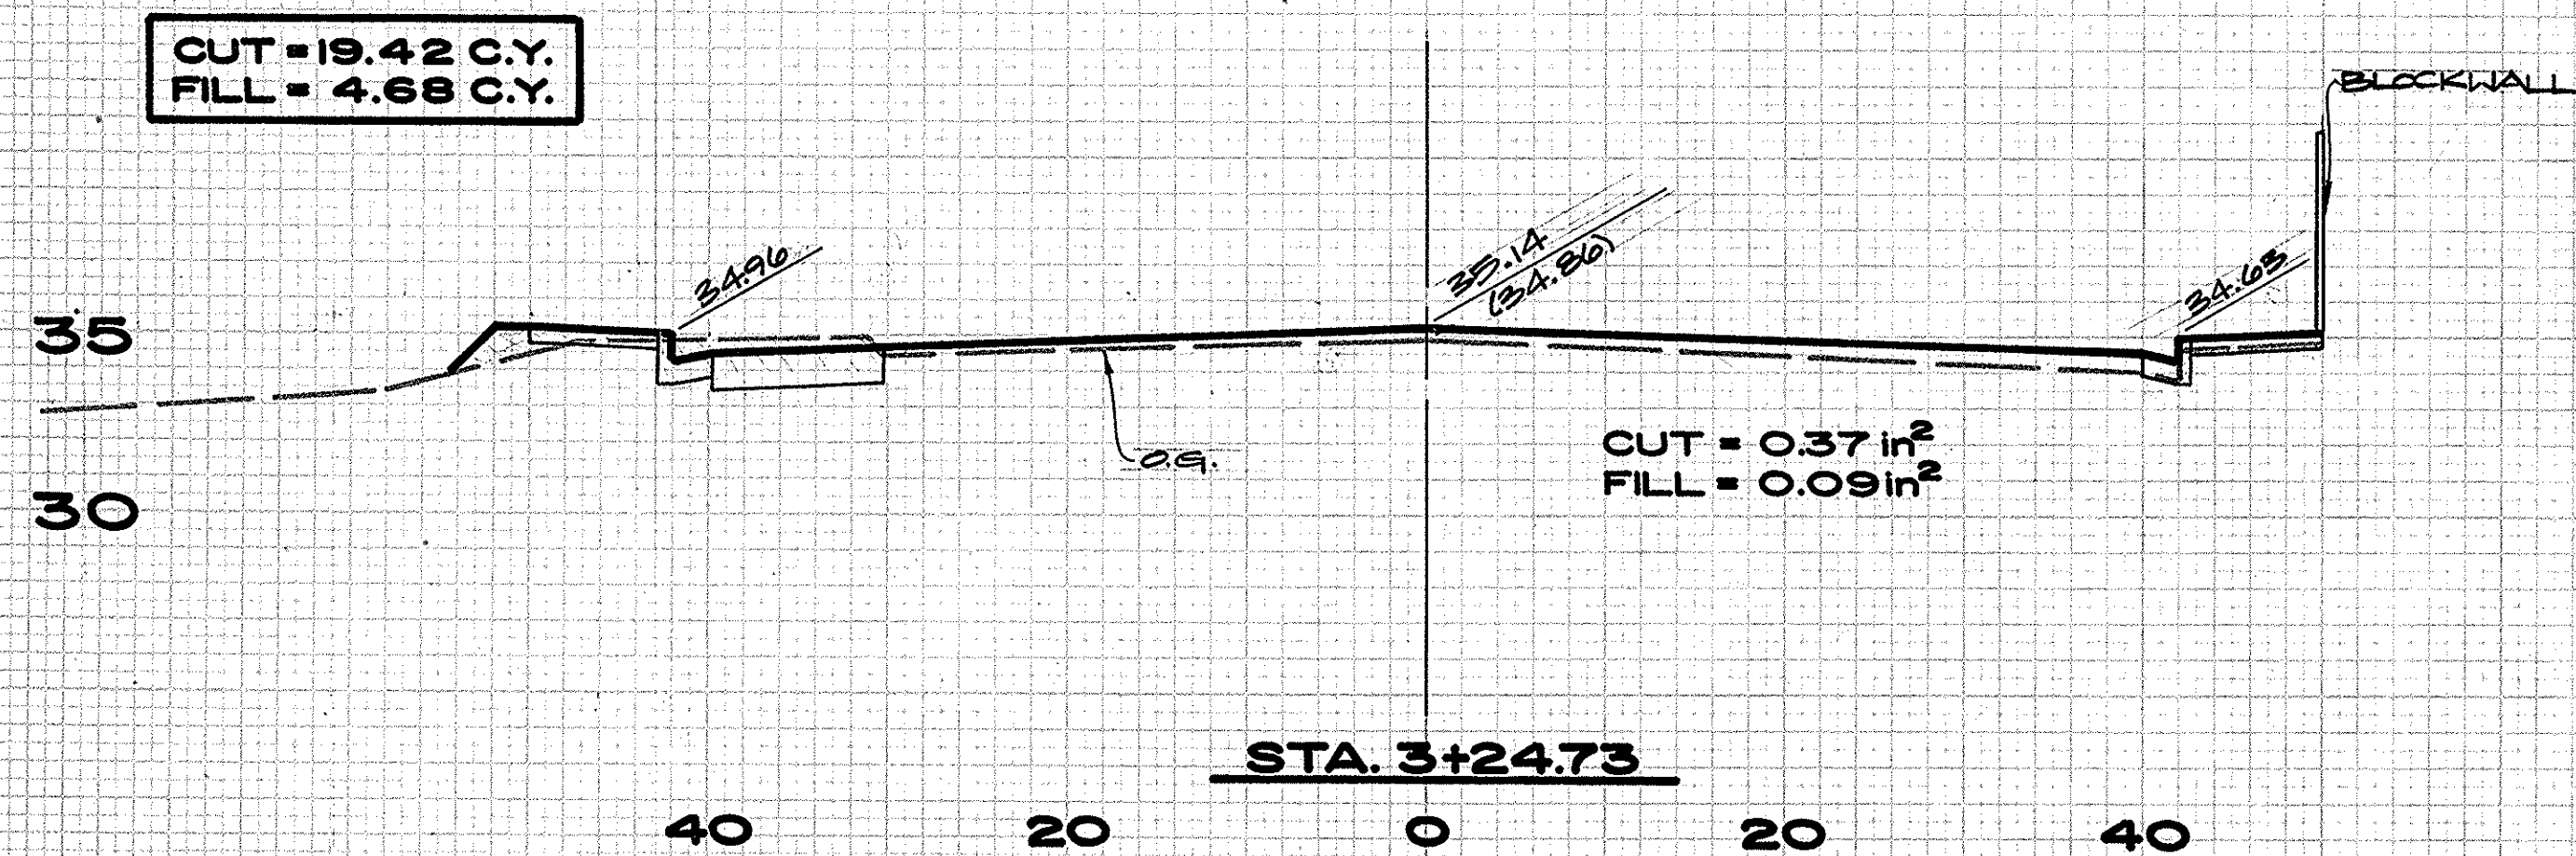
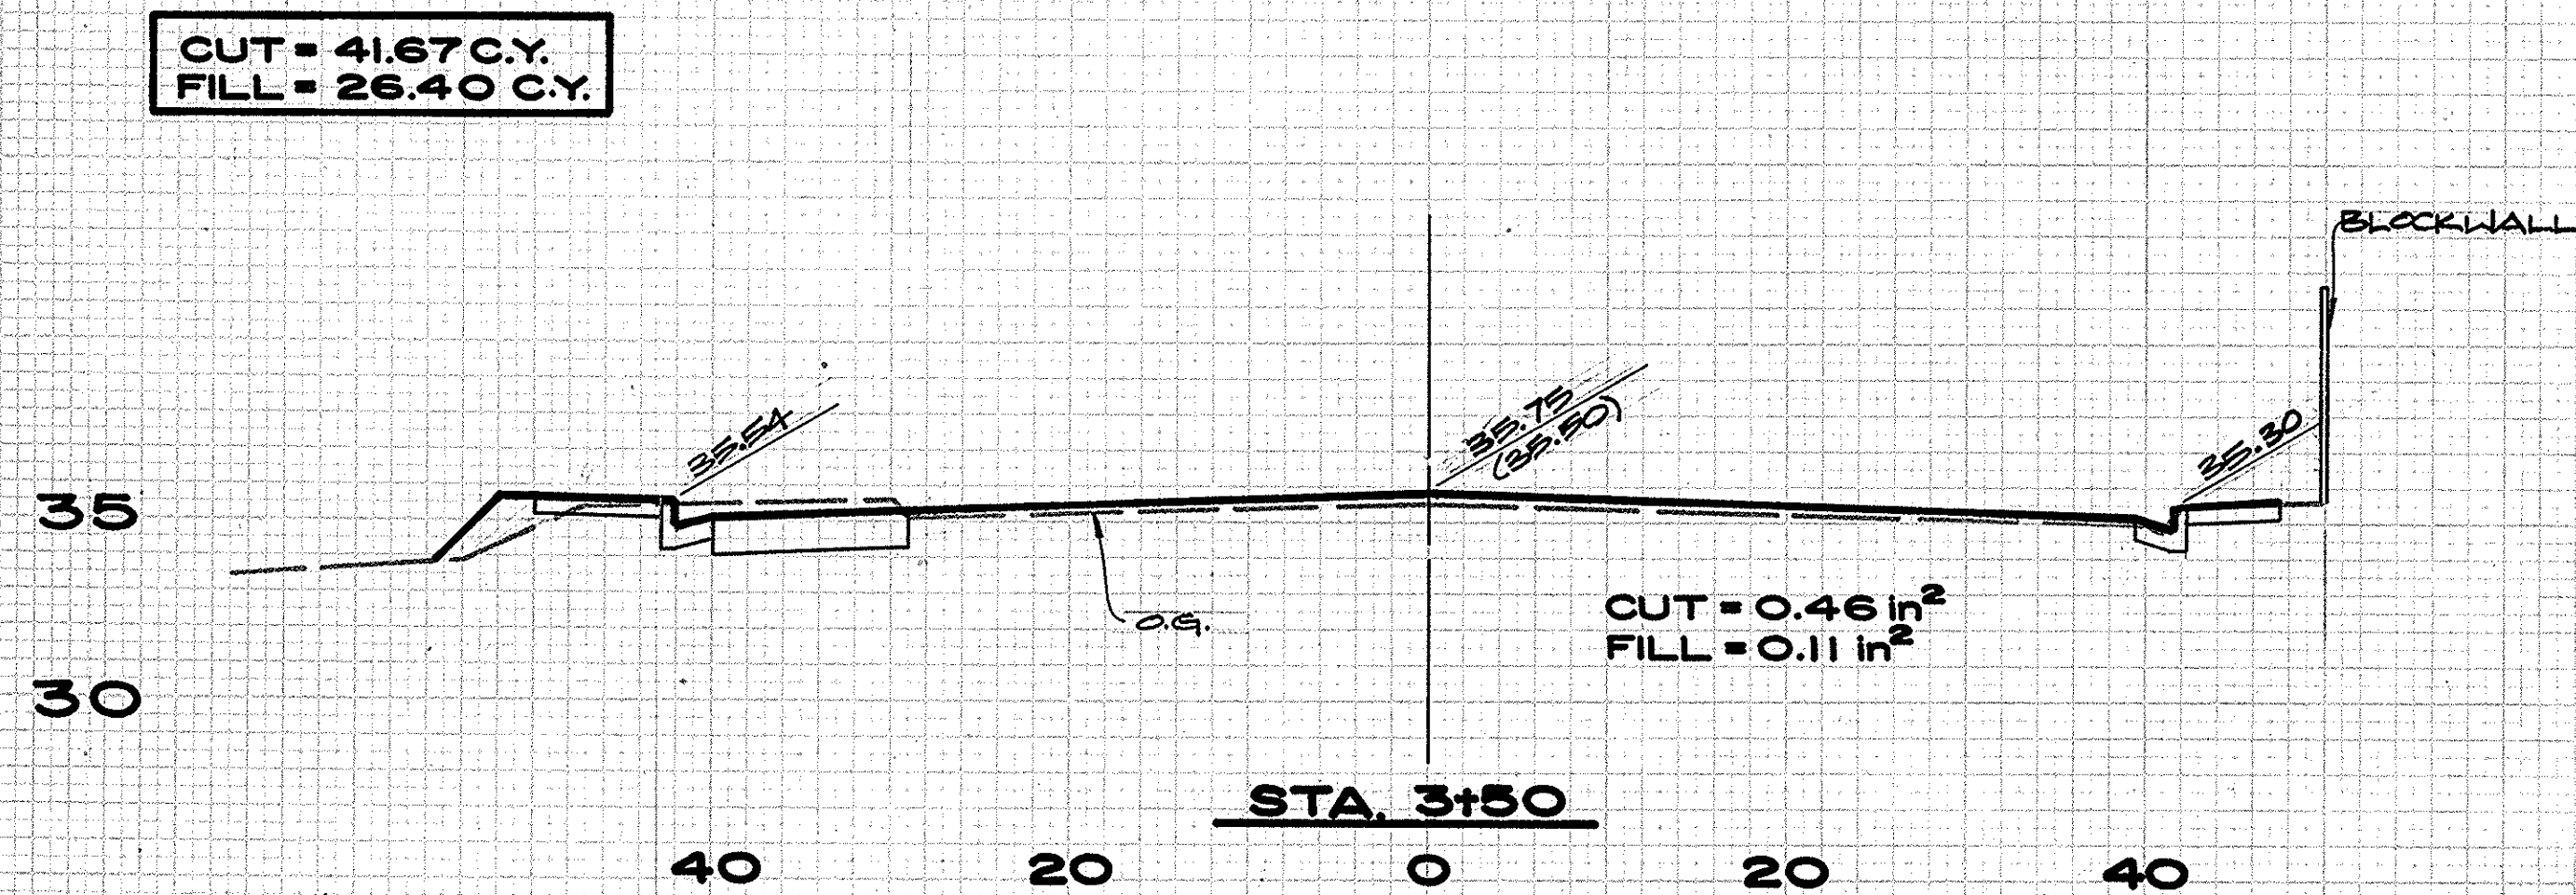
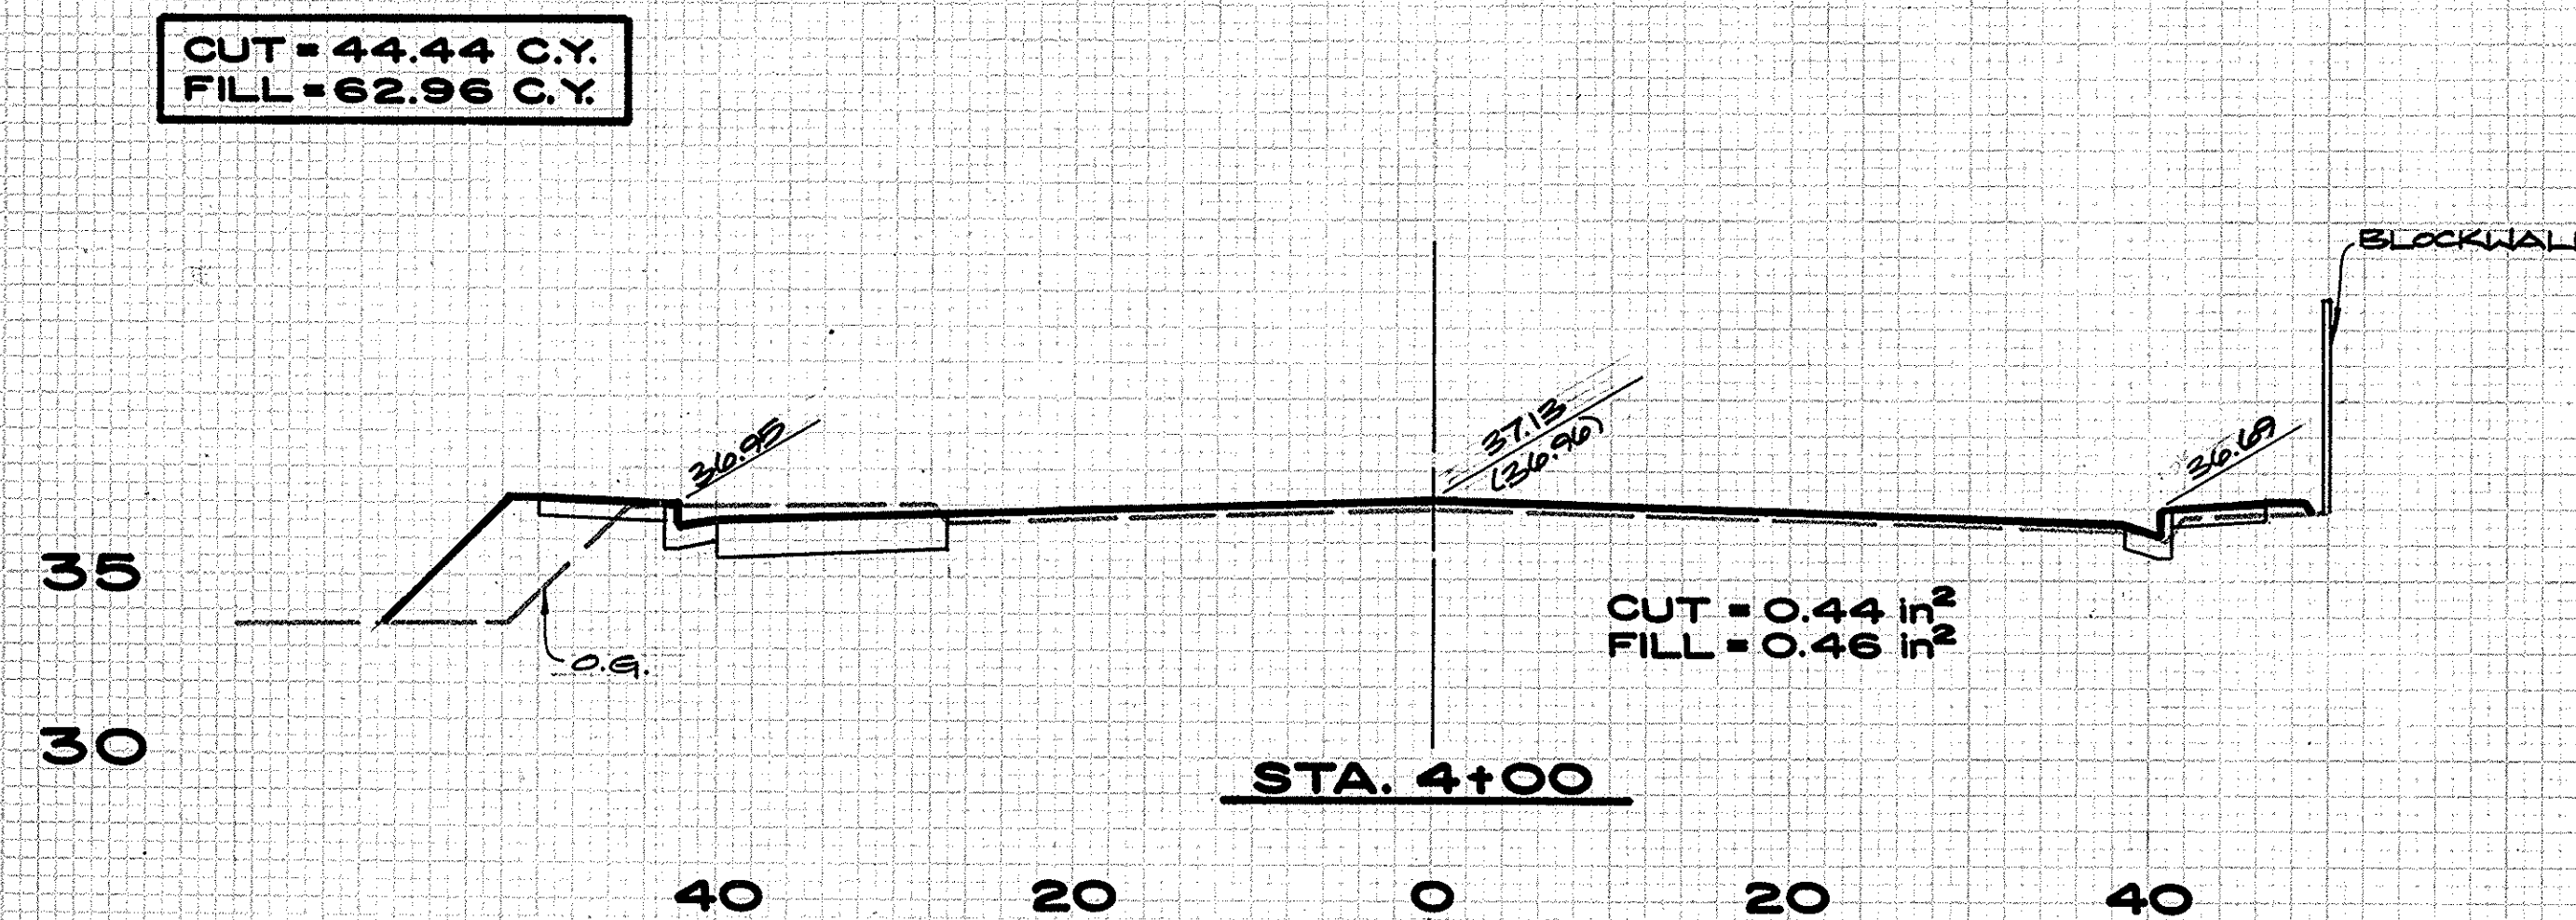


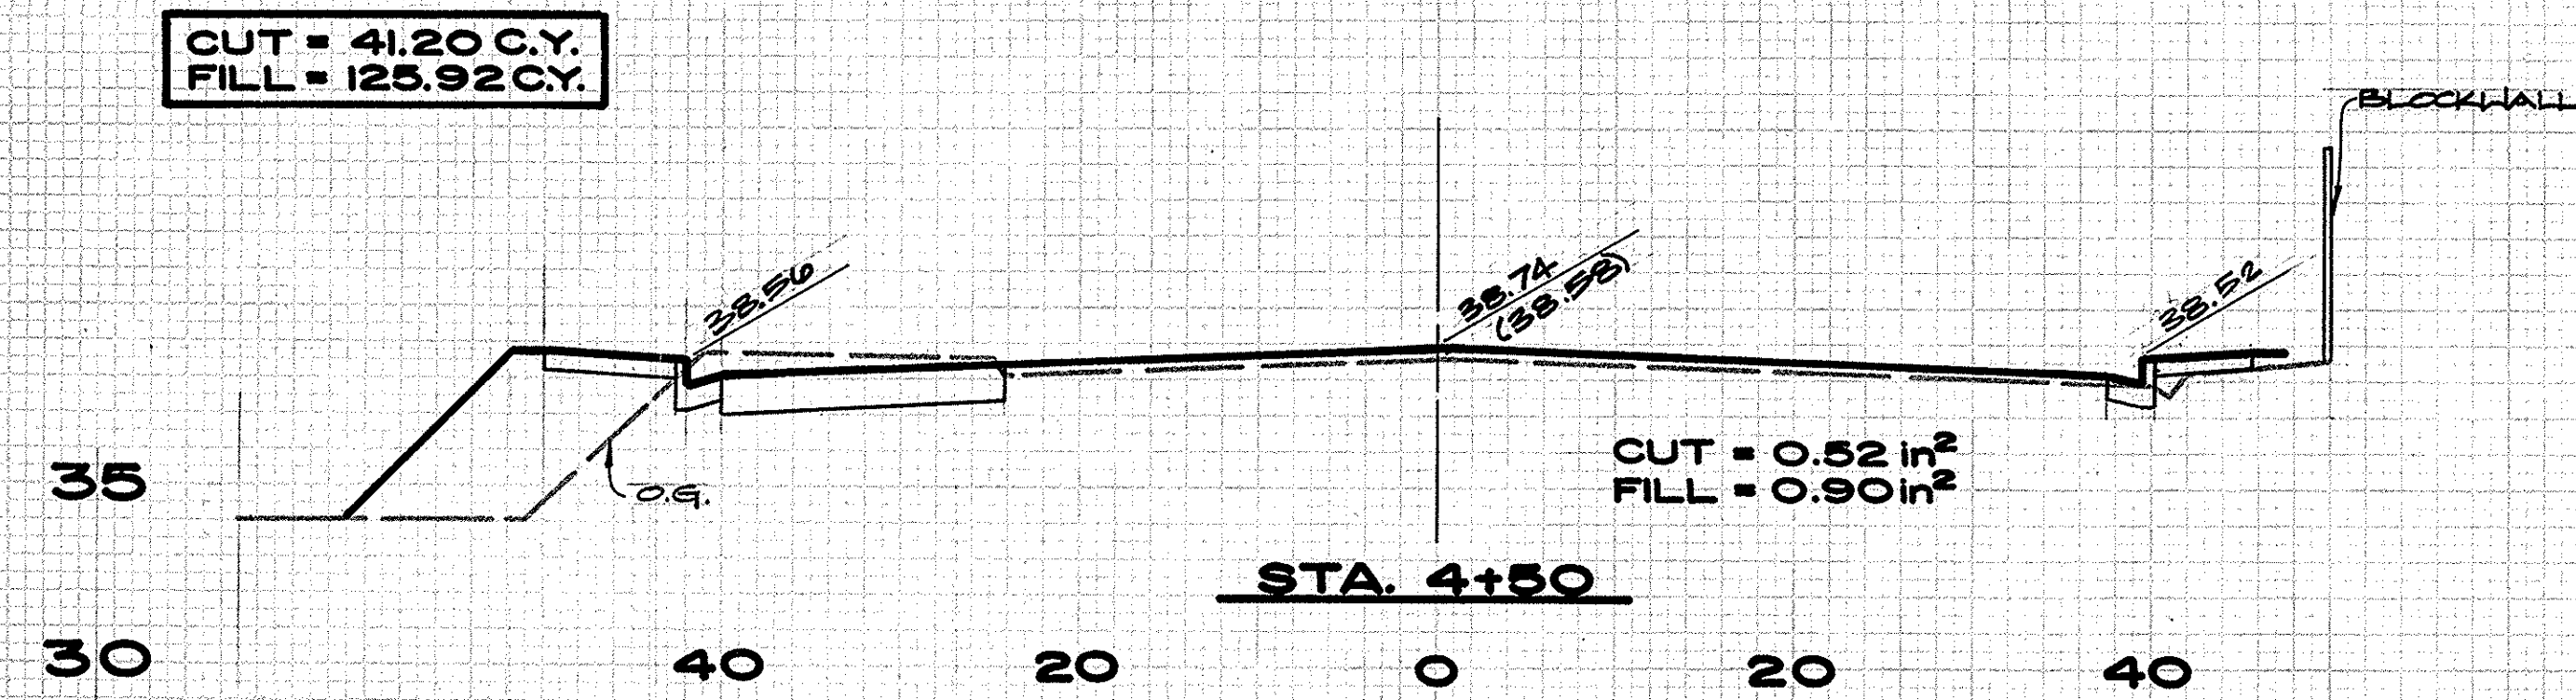

ORANGE COUNTY
ENVIRONMENTAL MANAGEMENT AGENCY

TALBERT - MACARTHUR
ROAD APPROACHES
to
BRIDGE (SA-32)

X-SECTIONS

(STA. 3+24.73 to STA. 6+00)

DESIGNED	DATE	DESCRIPTION	PREPARED UNDER	SHEET
MMHSU			SUPERVISION	8
DRAWN	DATE	SCALE	DATE	DWG. NO.
RBURK	11/82	AS SHOWN	11/82	