



CUT = 0
FILL = 595.12 C.Y.

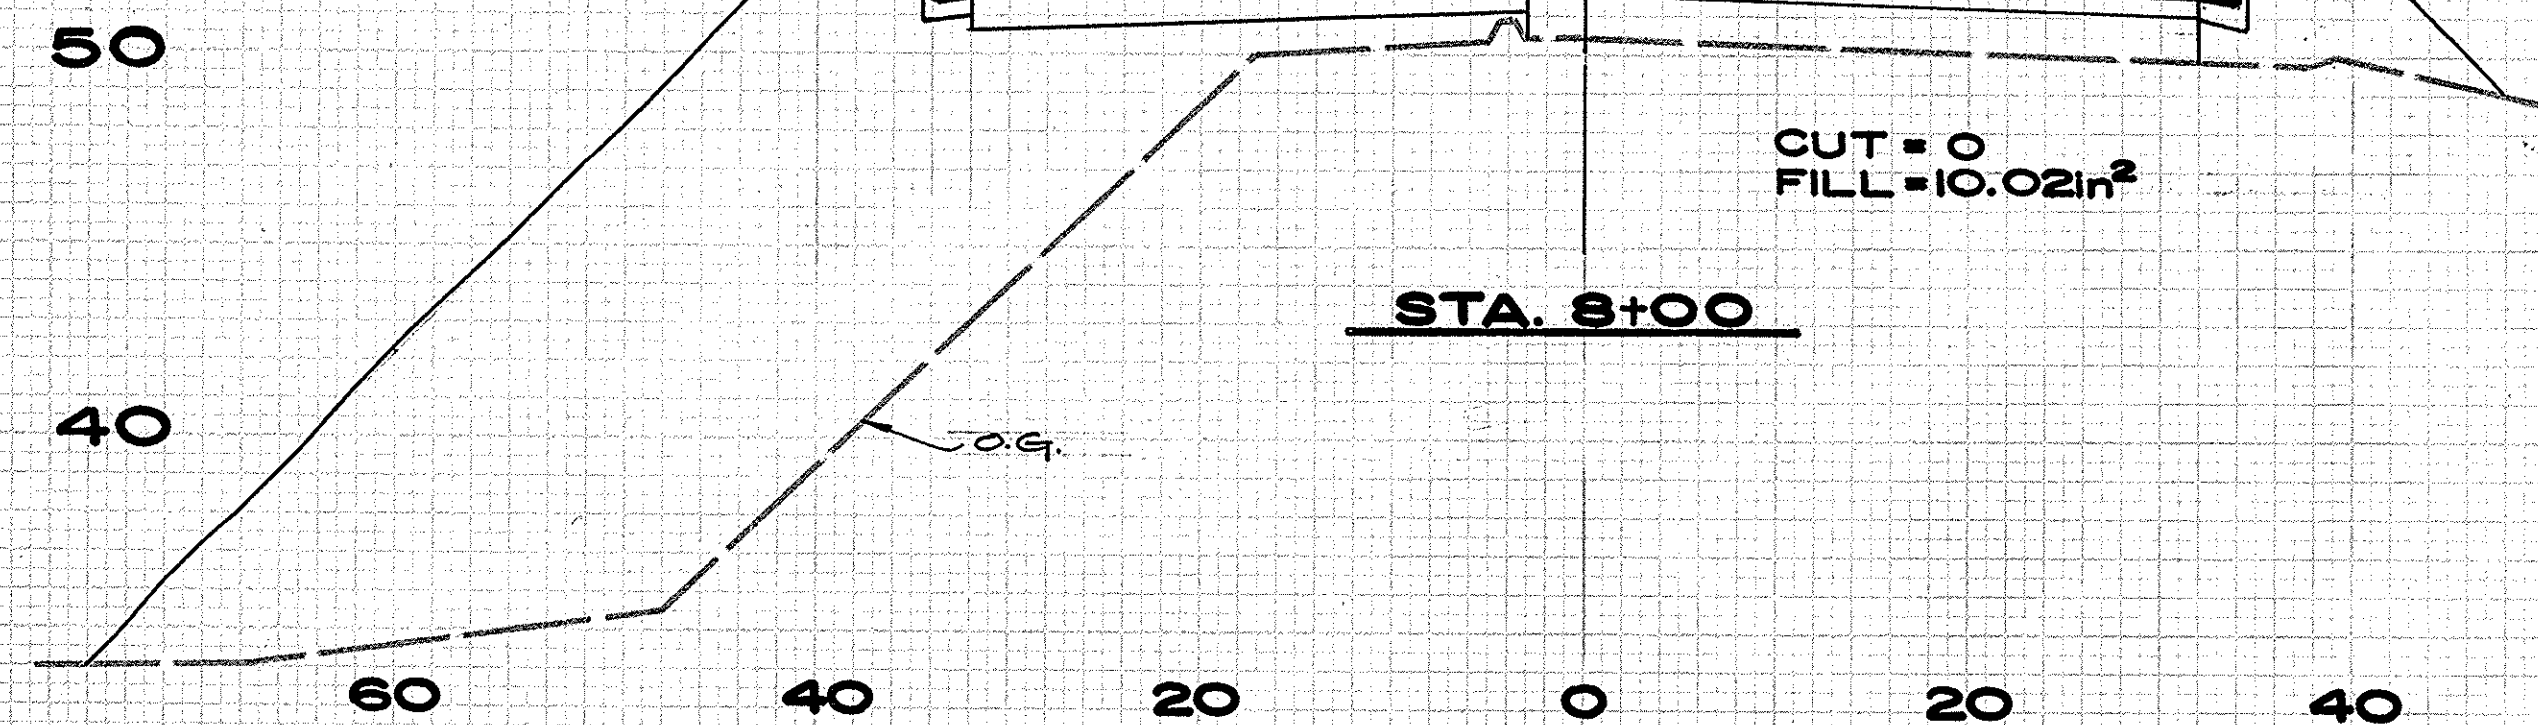

CUT = 0
FILL = 10.02 in²

STA. 8+00


CUT = 0
FILL = 871.27 C.Y.

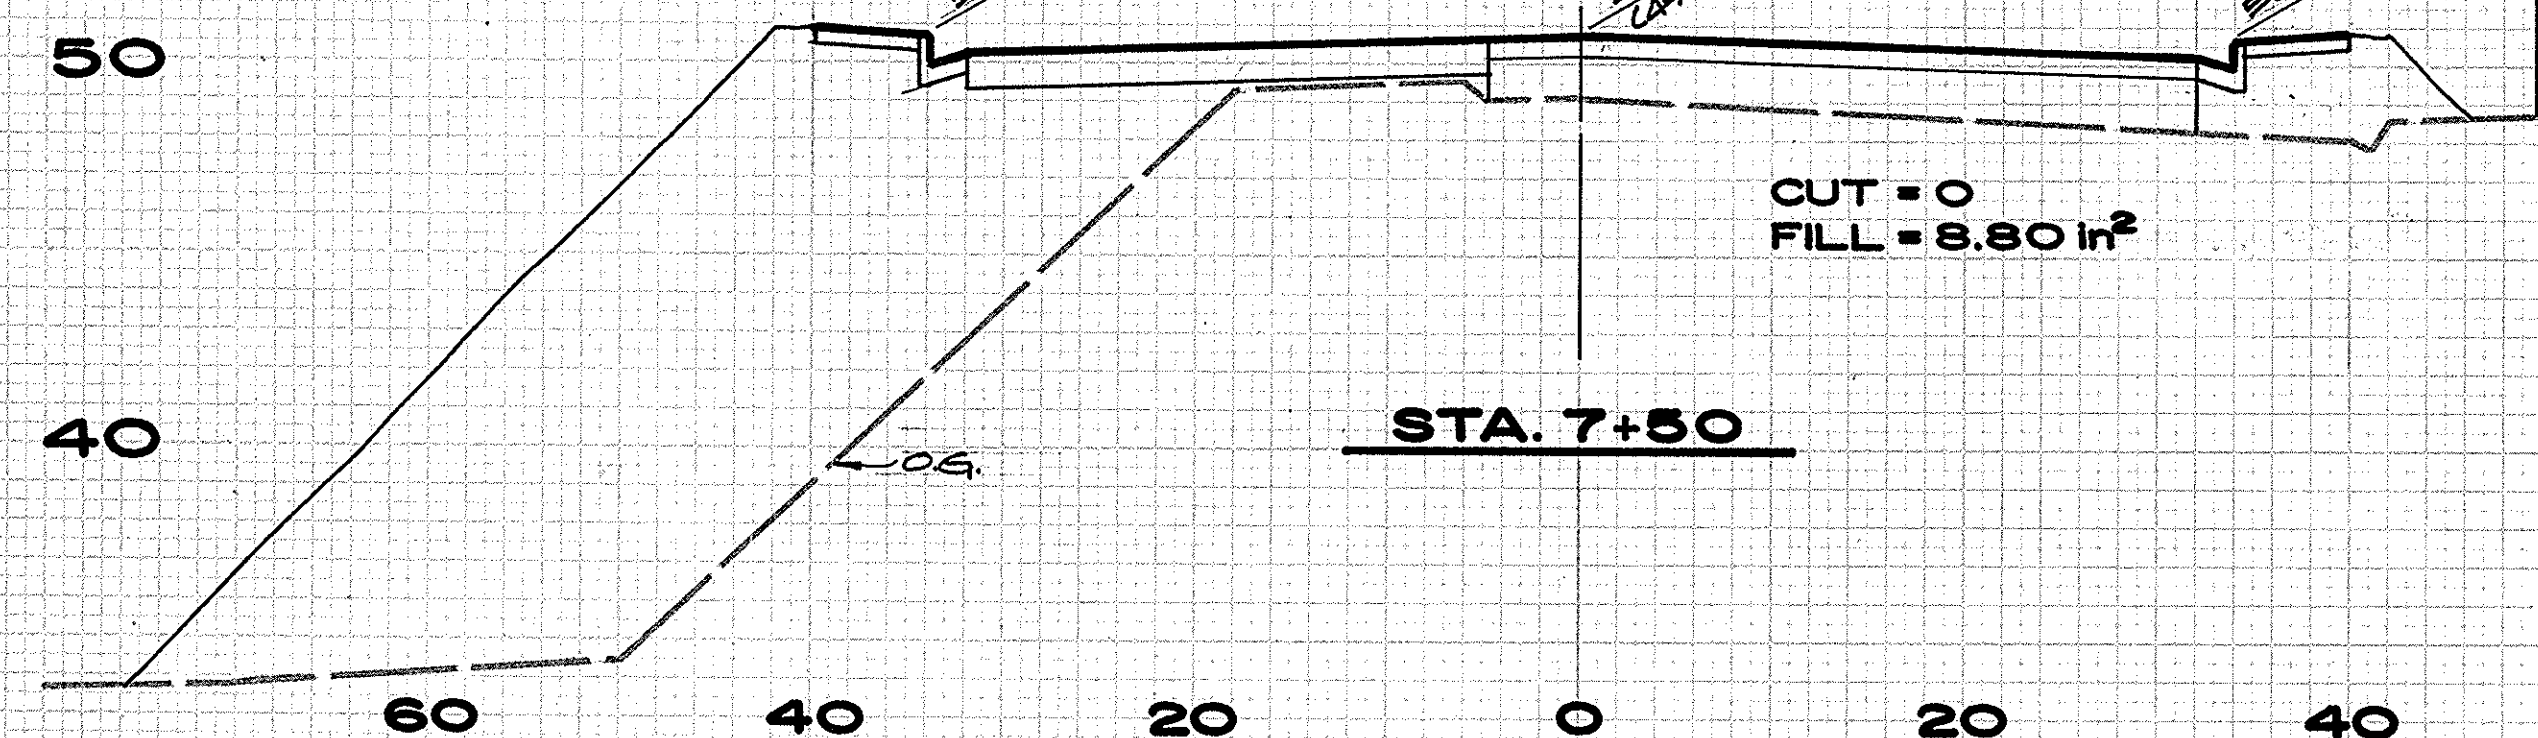

CUT = 0
FILL = 8.80 in²

STA. 7+50


CUT = 0
FILL = 737.02 C.Y.

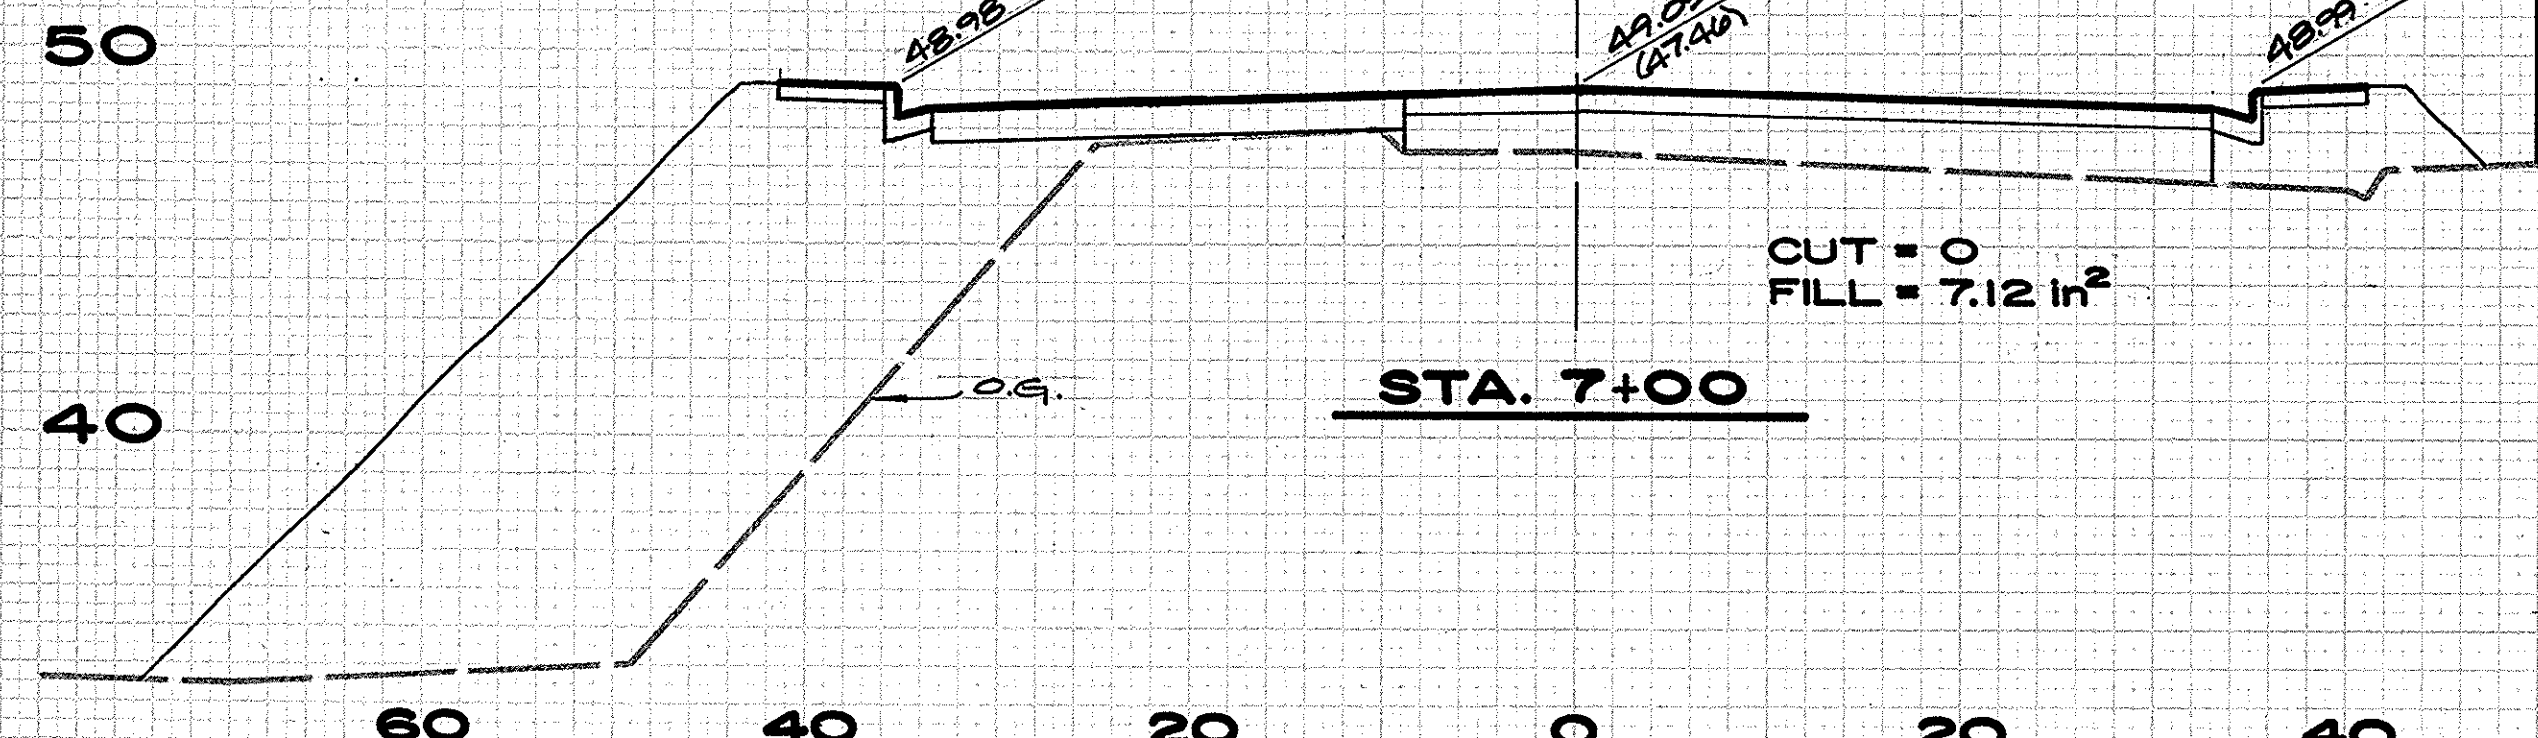

CUT = 0
FILL = 7.12 in²


STA. 7+00

CUT = 1.40 C.Y.
FILL = 619.43 C.Y.

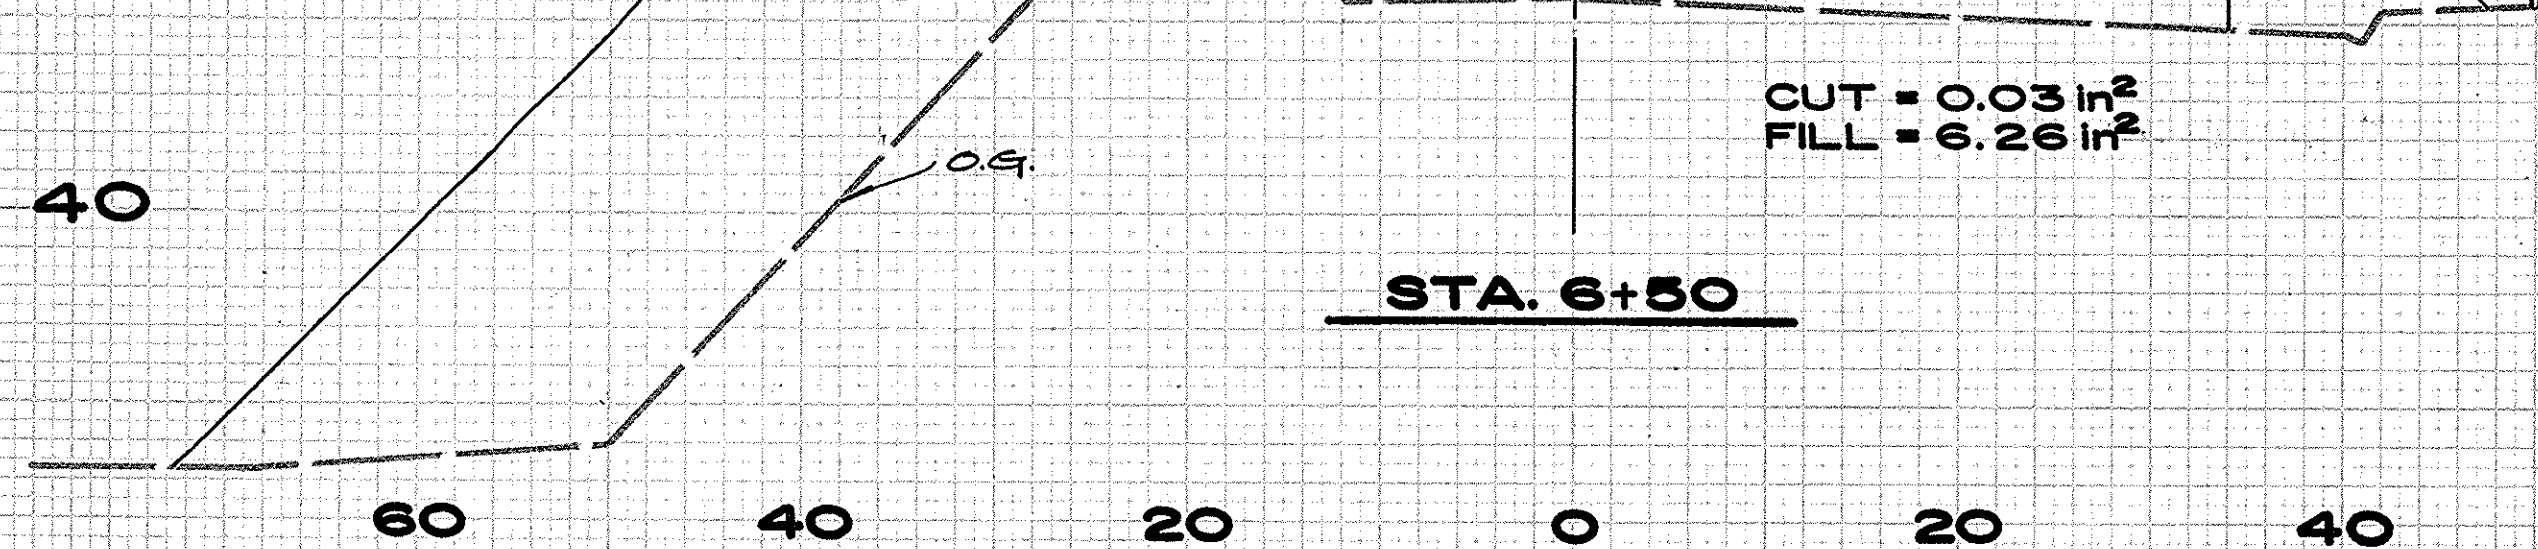


CUT = 0.03 in²
FILL = 6.26 in²

STA. 6+50

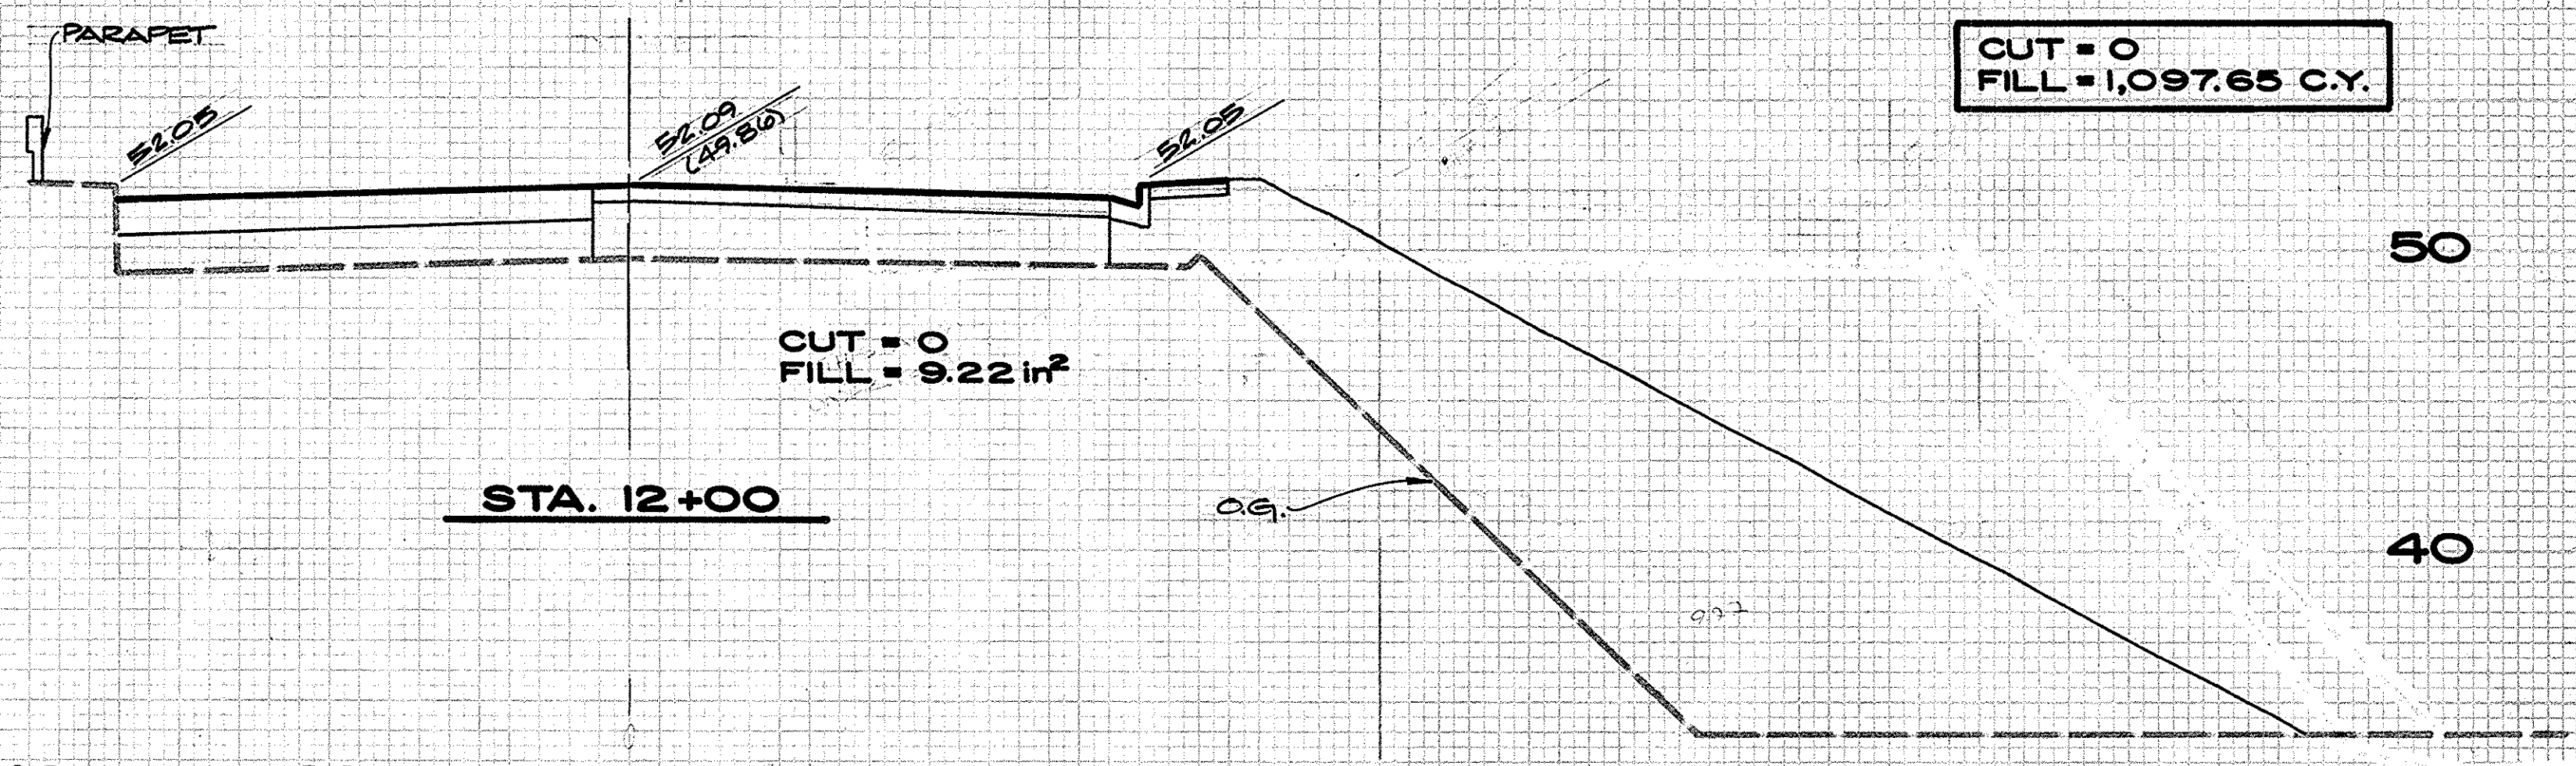


CUT = 0
FILL = 9.22 in²

STA. 12+00

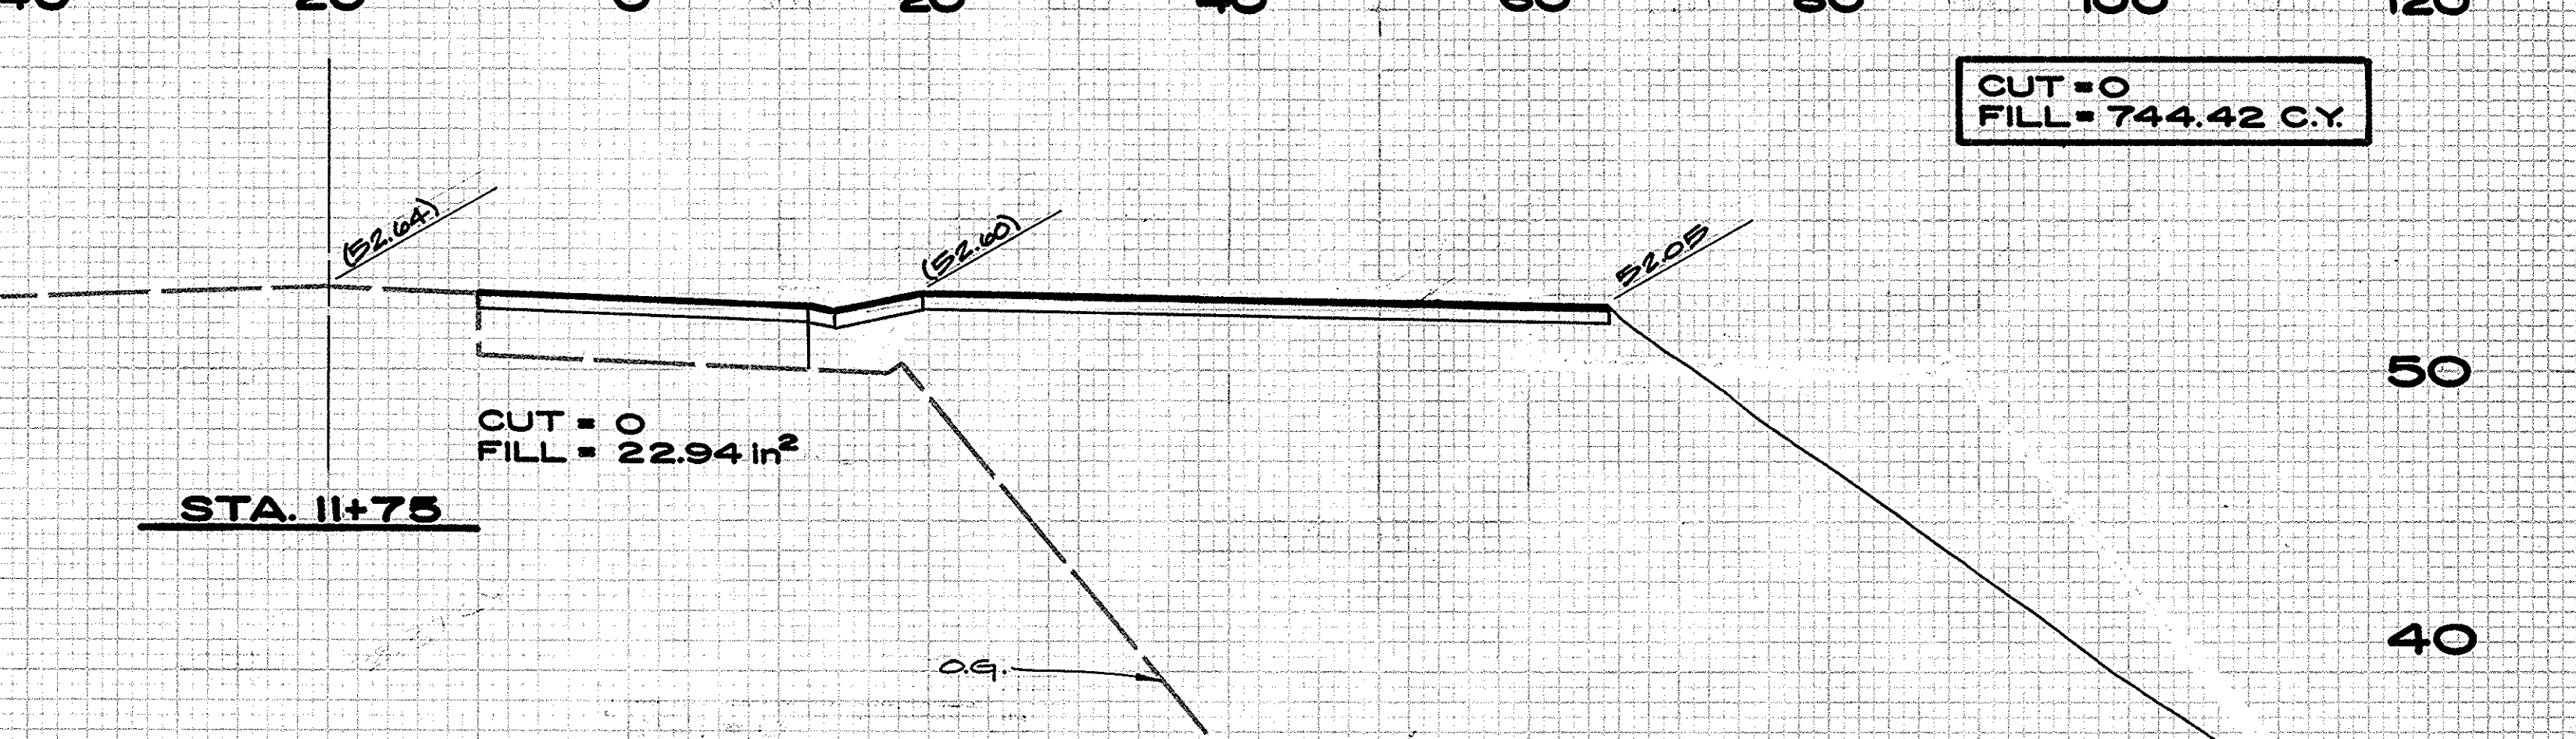

CUT = 0
FILL = 22.94 in²

STA. 11+75

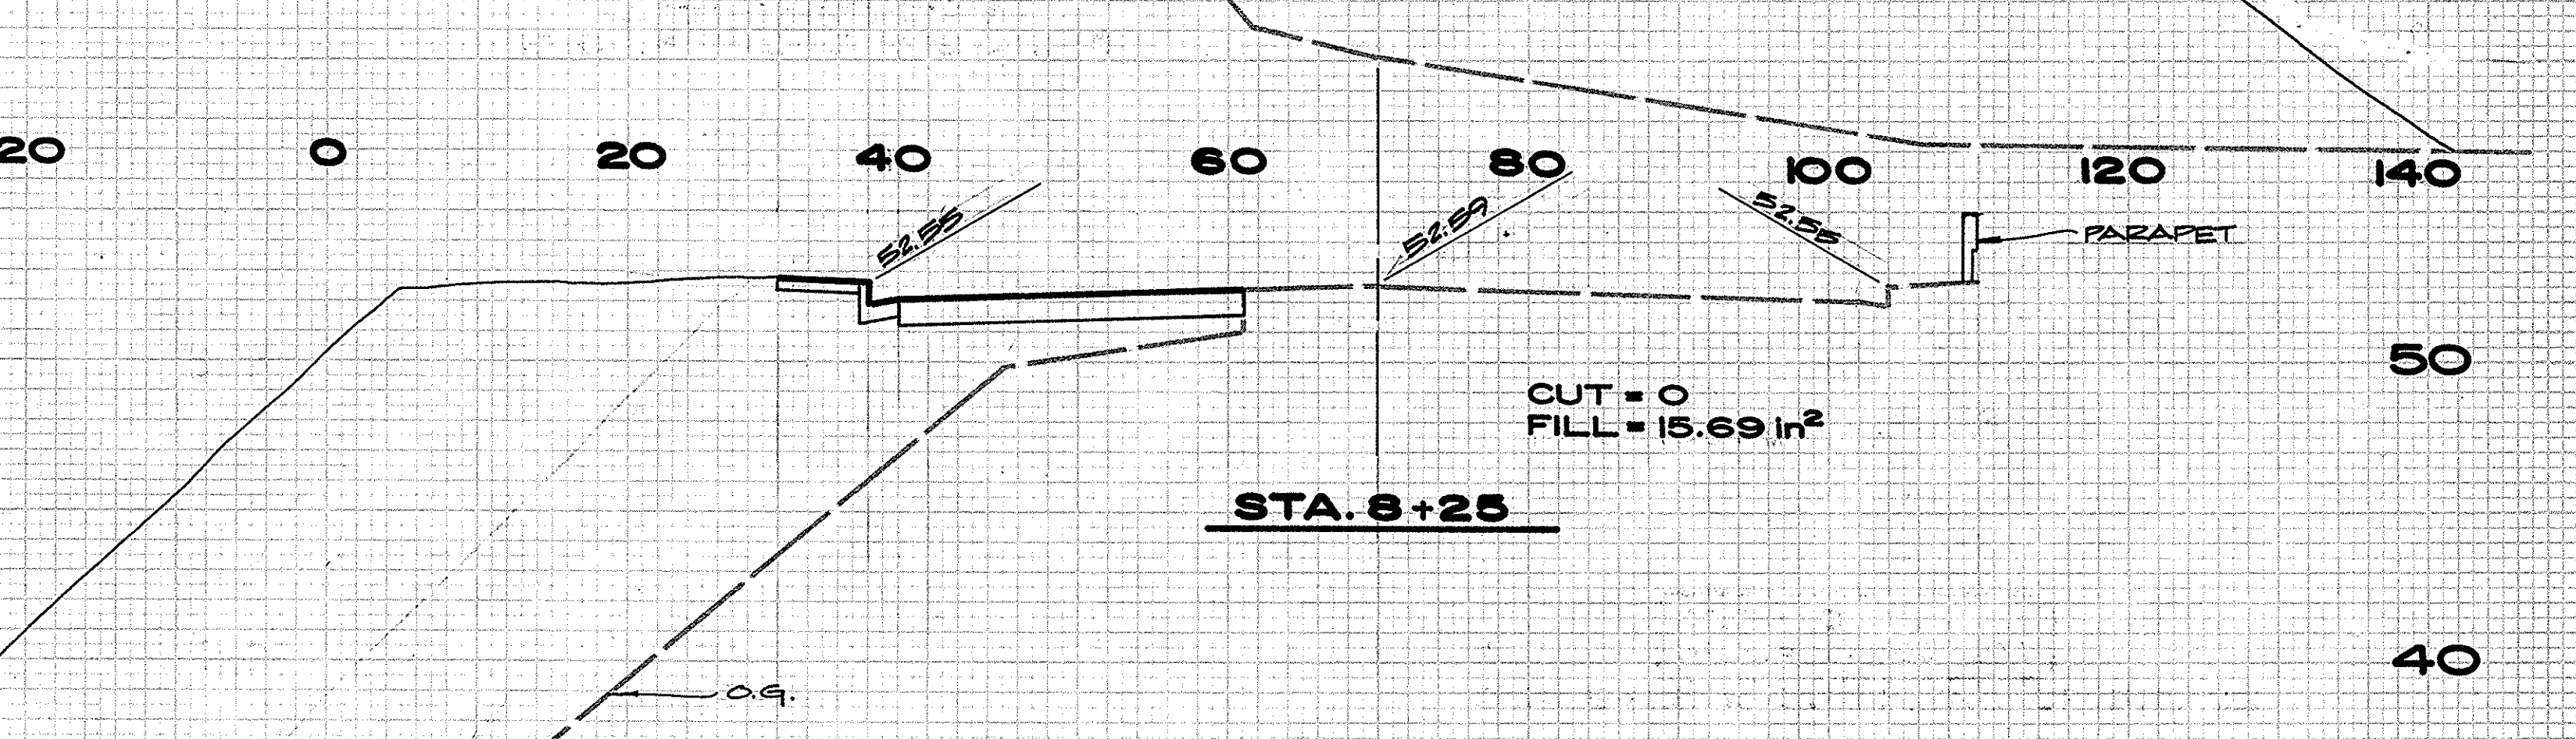

CUT = 0
FILL = 15.69 in²

STA. 8+25

CUT = 0
FILL = 1,097.65 C.Y.

CUT = 0
FILL = 744.42 C.Y.

ORANGE COUNTY
ENVIRONMENTAL MANAGEMENT AGENCY
TALBERT - MACARTHUR
ROAD APPROACHES
to
BRIDGE (SA-32)

X - SECTIONS
(STA. 6+50 to STA. 12+00)

MARK	DATE	DESCRIPTION	PREPARED UNDER	DATE	SHEET
DESIGNED	MM.HSU	SCALE	DATE	DATE	9
DRAWN	RBURK	CHECKED	MM.H.	AS SHOWN	11/82