




CUT = 31.02 C.Y.
FILL = 45.83 C.Y.

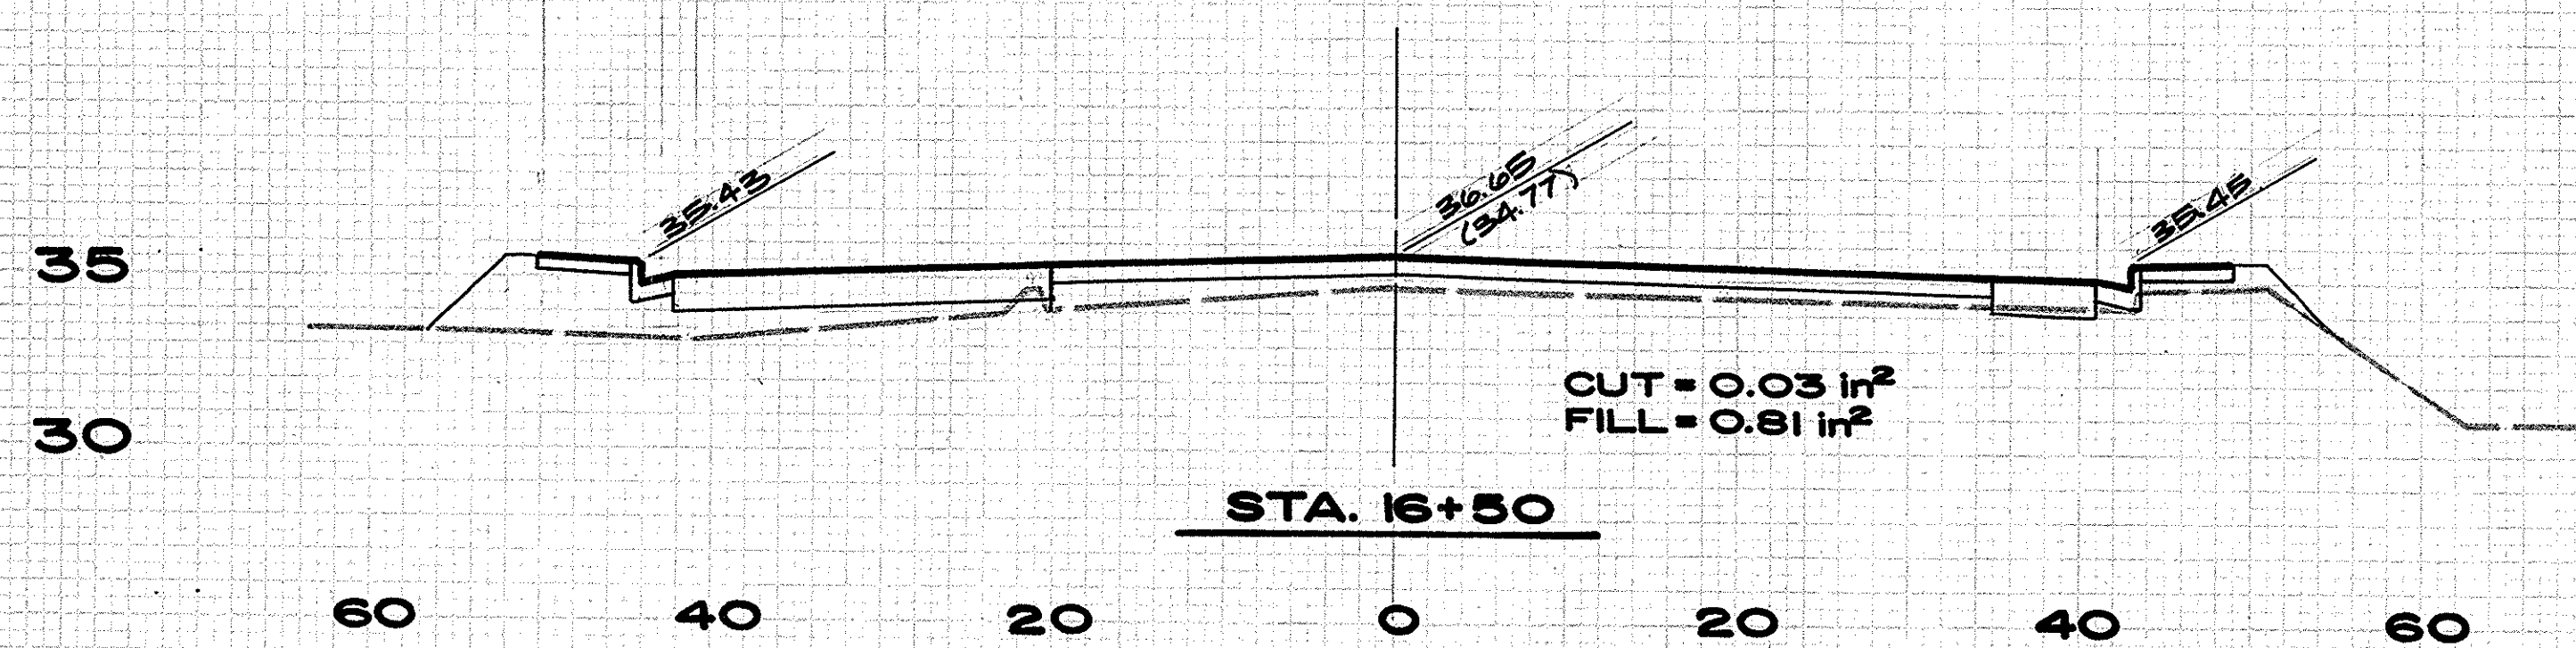

CUT = 1.39 C.Y.
FILL = 137.50 C.Y.

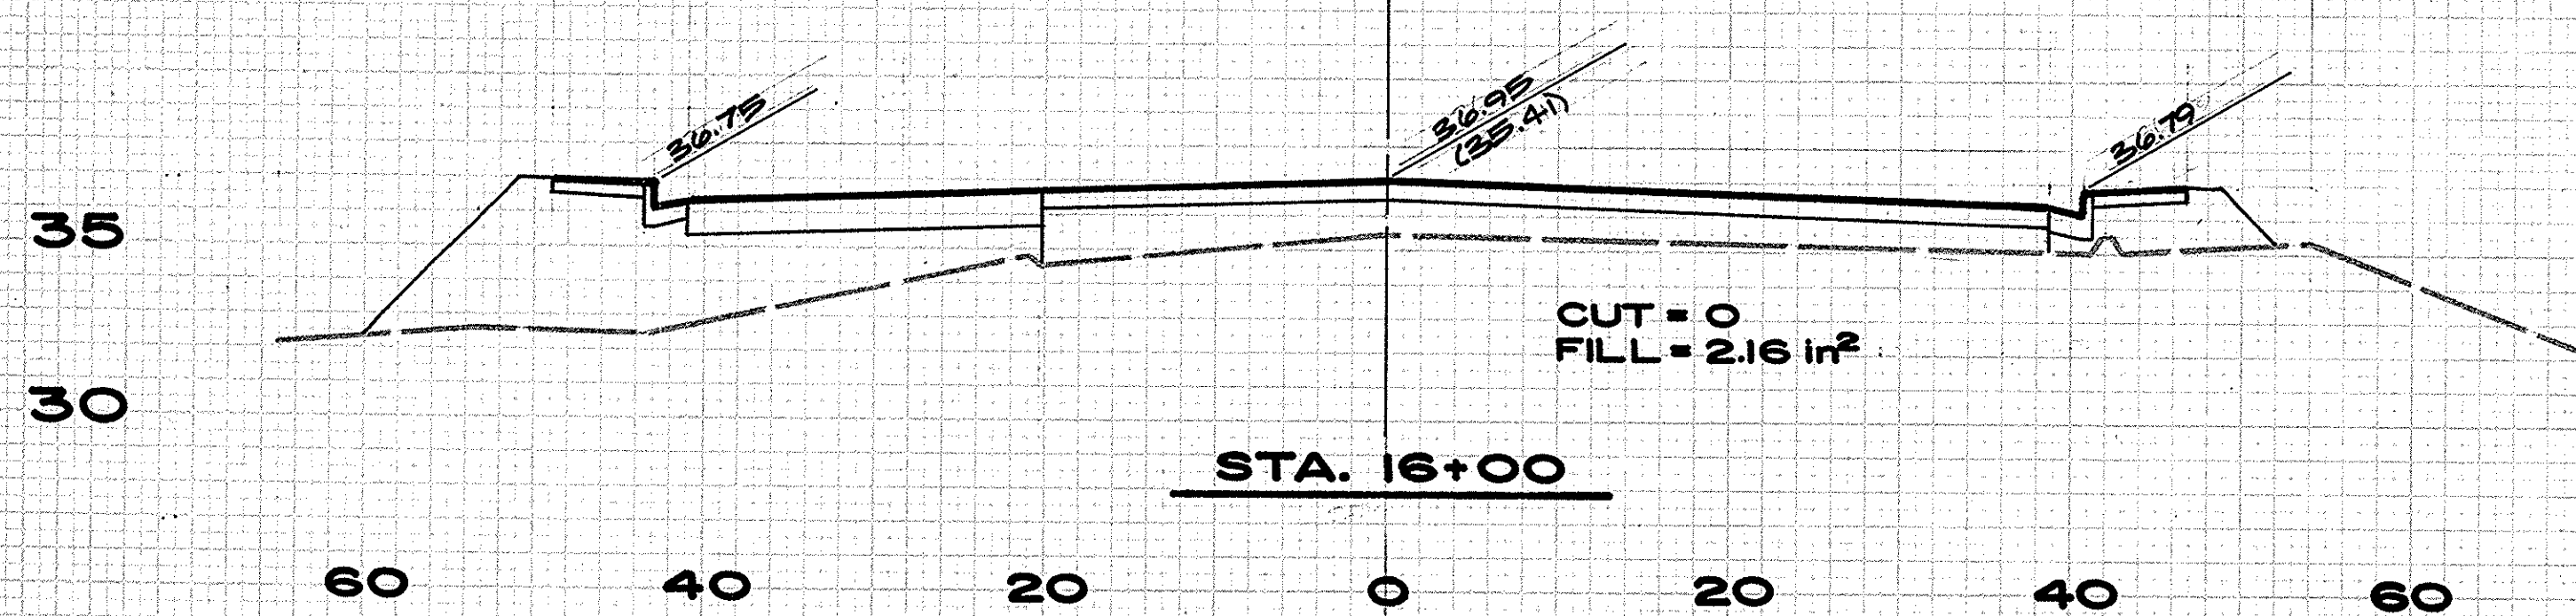


35
30

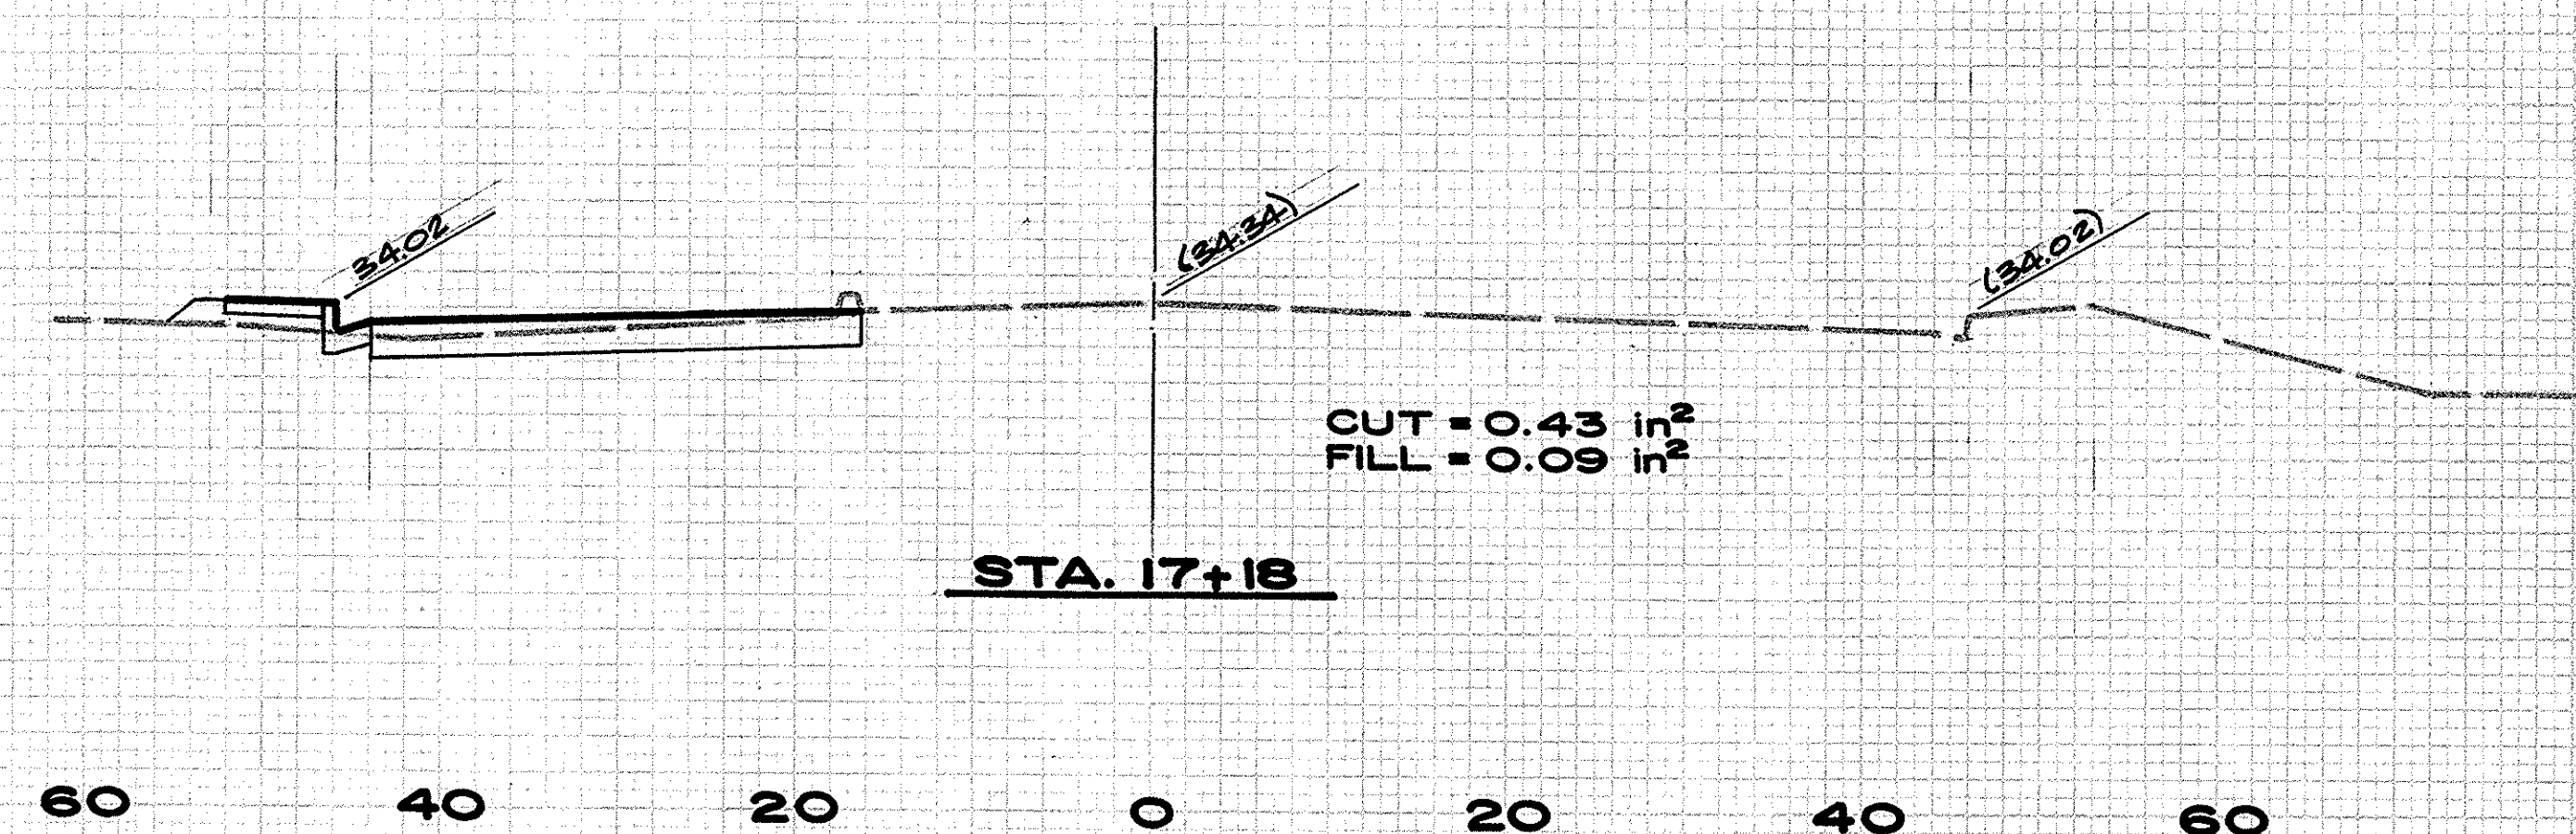

CUT = 17.83 C.Y.
FILL = 4.50 C.Y.

35
30

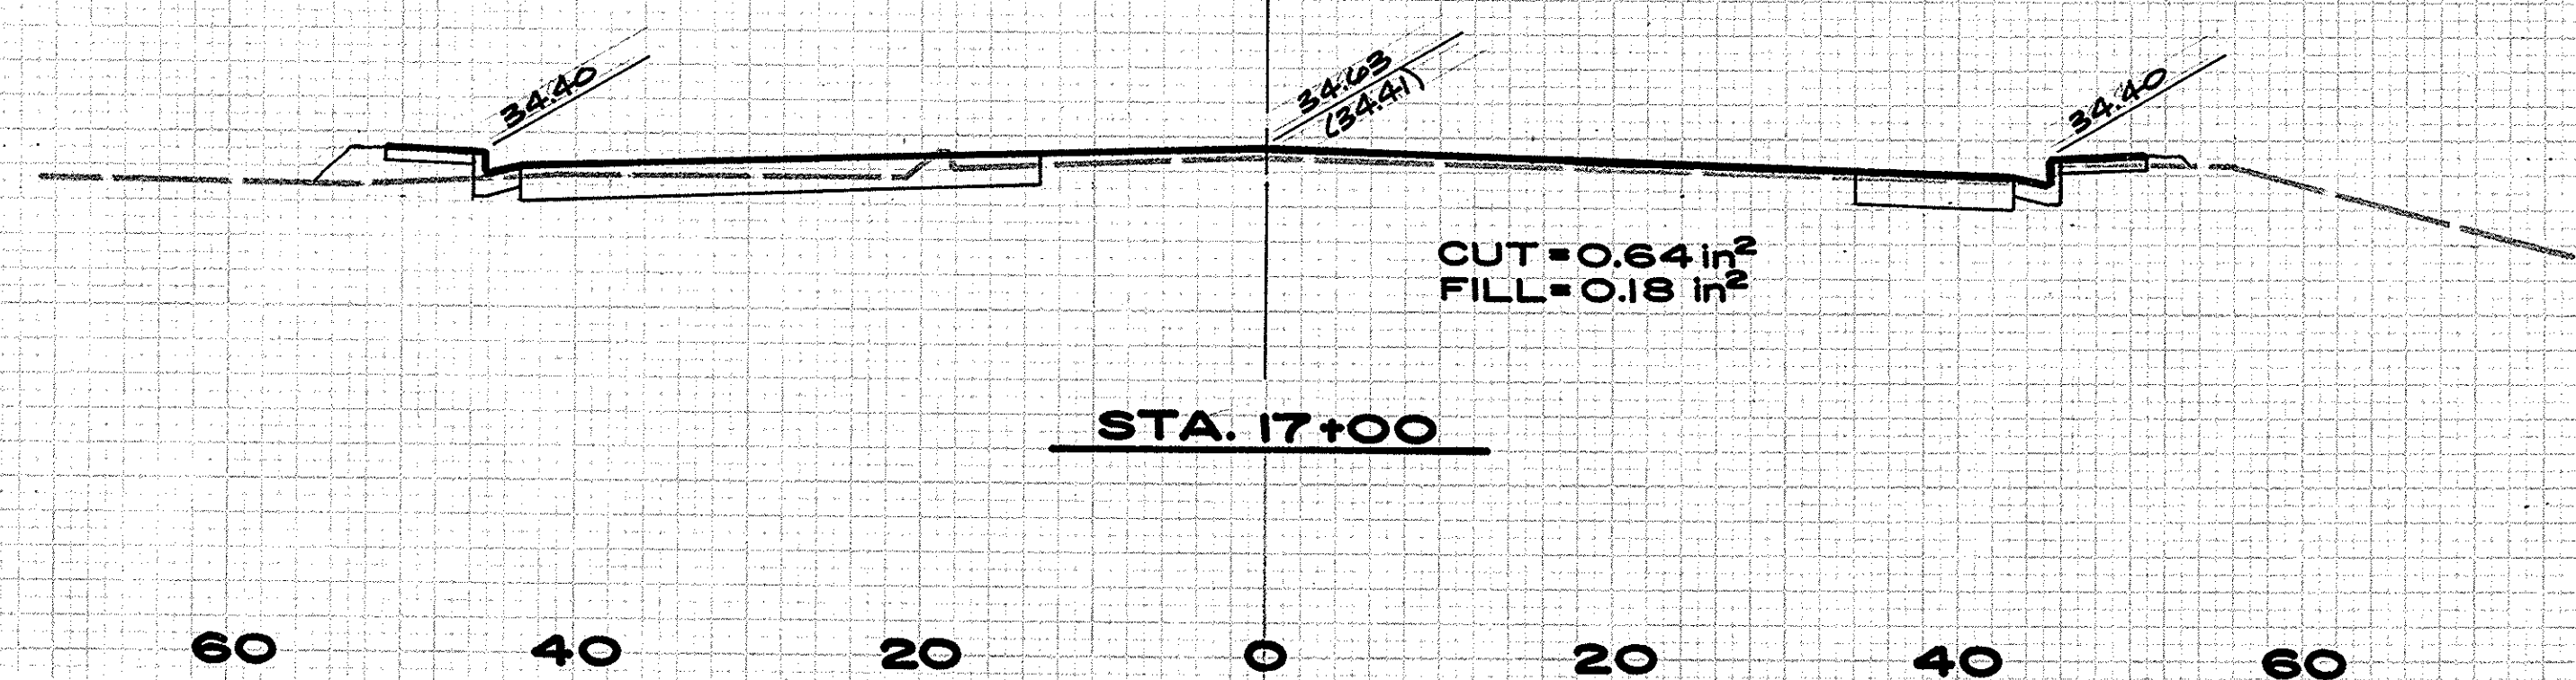

ORANGE COUNTY
ENVIRONMENTAL MANAGEMENT AGENCY
TALBERT - MACARTHUR
ROAD APPROACHES
to
BRIDGE (SA-32)

X - SECTIONS
(STA. 16+00 to STA. 17+18)

DATE	DESCRIPTION	PREPARED UNDER	DATE	SHEET
11/82	REVISIONS	11/82	11	11
DESIGNED	M.M.HSU	SCALE	AS SHOWN	11/82
DRAWN	R.BURK	CHECKED	M.M.H.	