



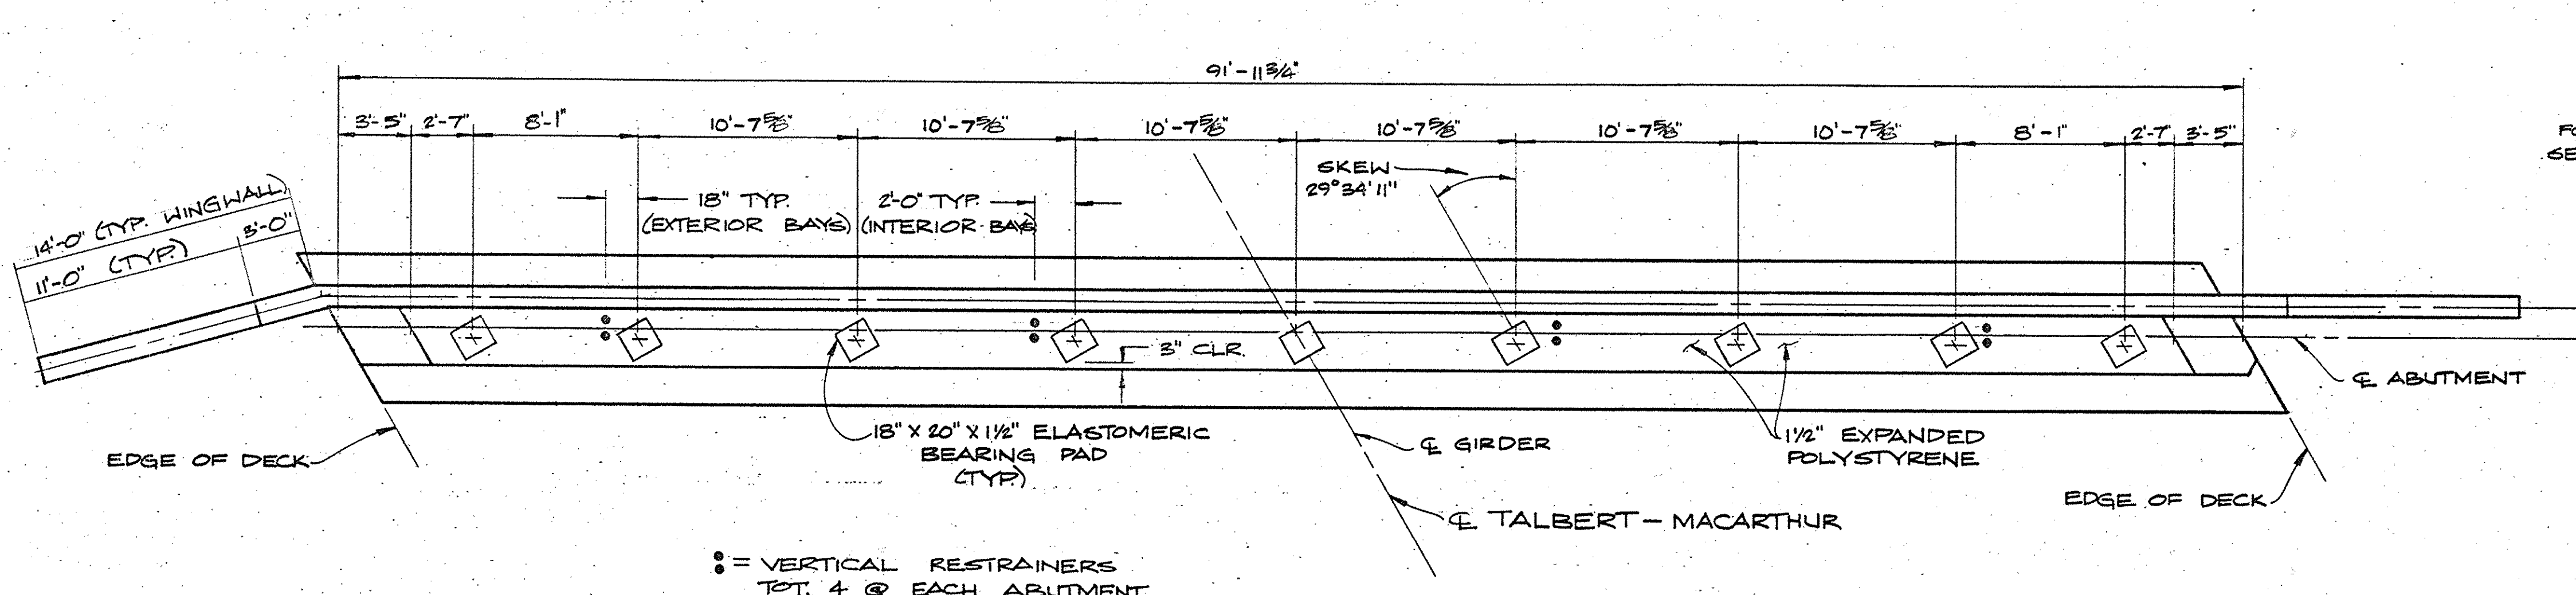


PLAN

SCALE: 3/16" = 1'-0"

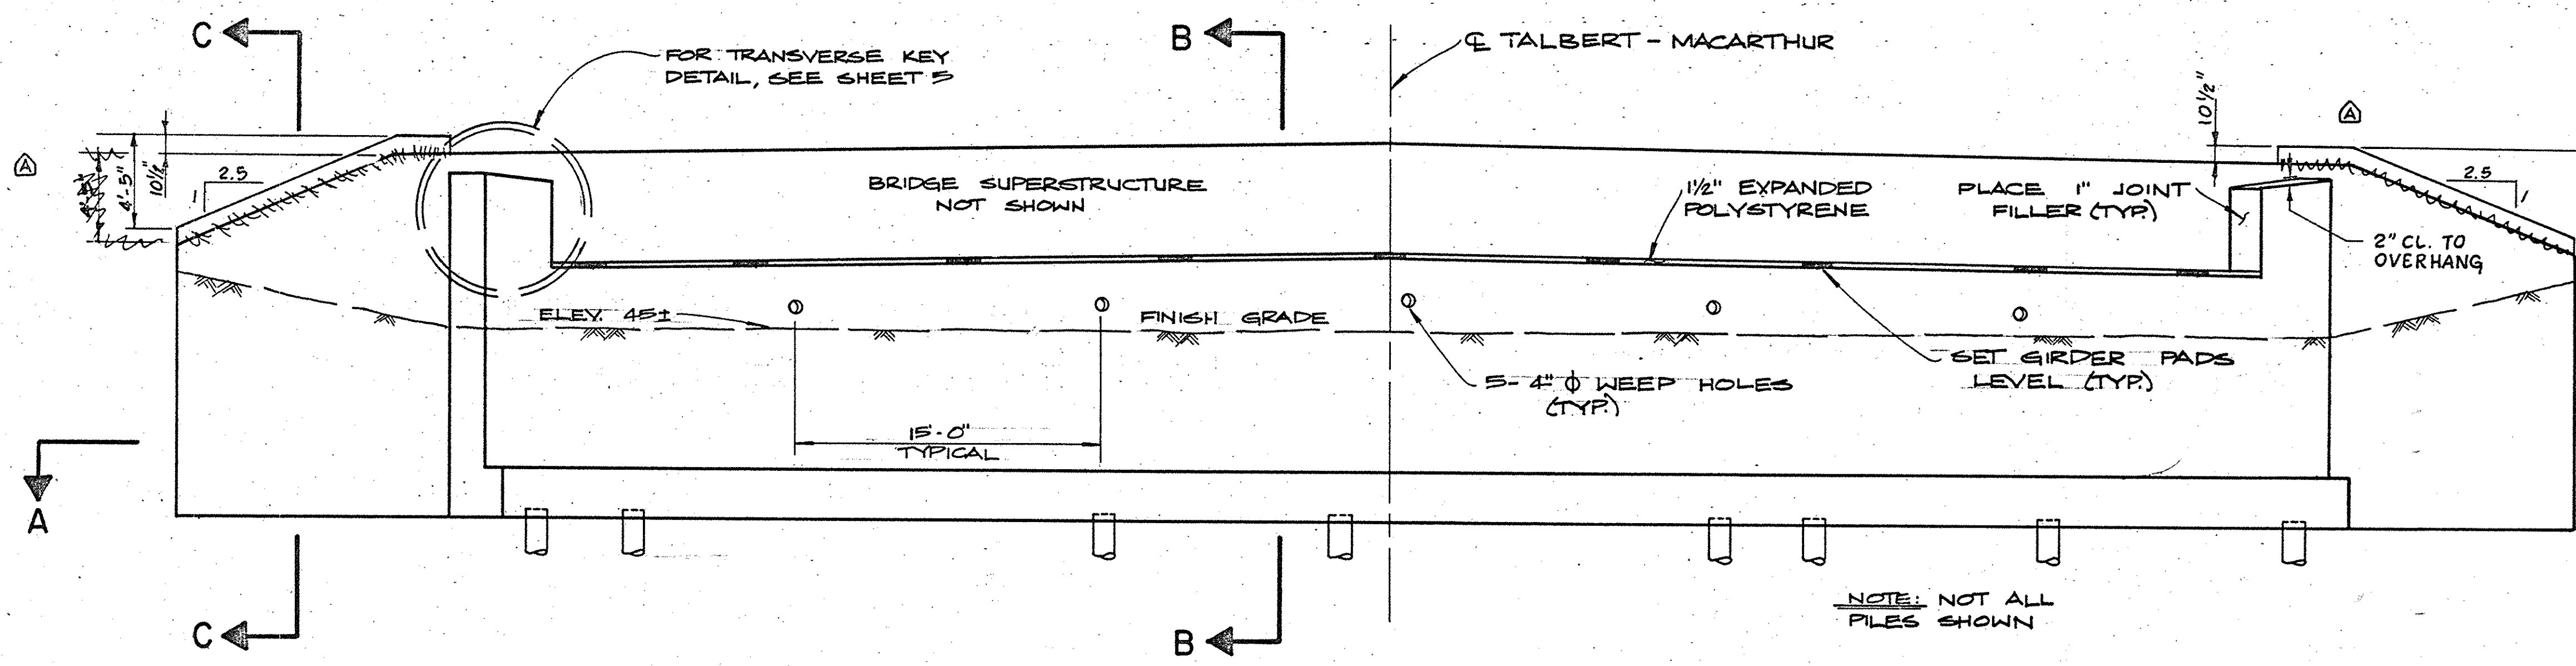

ELEVATION


SCALE: 3/16" = 1'-0"

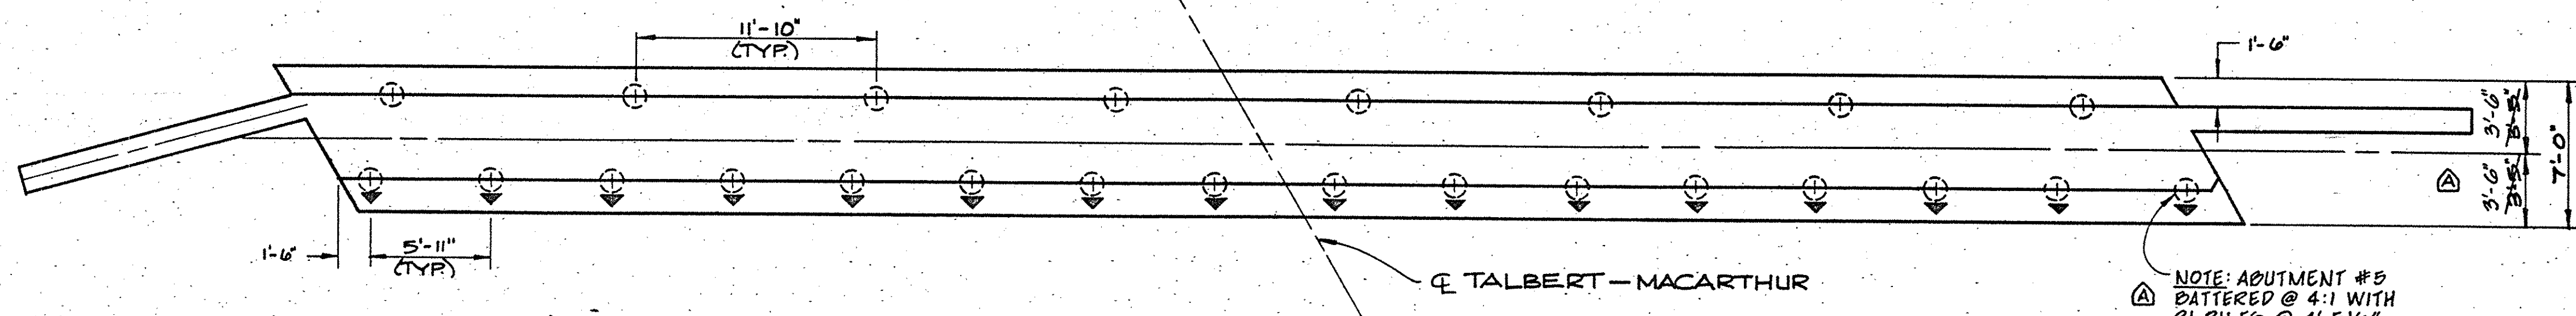

ABUTMENT FOOTING

SECTION A-A

SCALE: 3/16" = 1'-0"

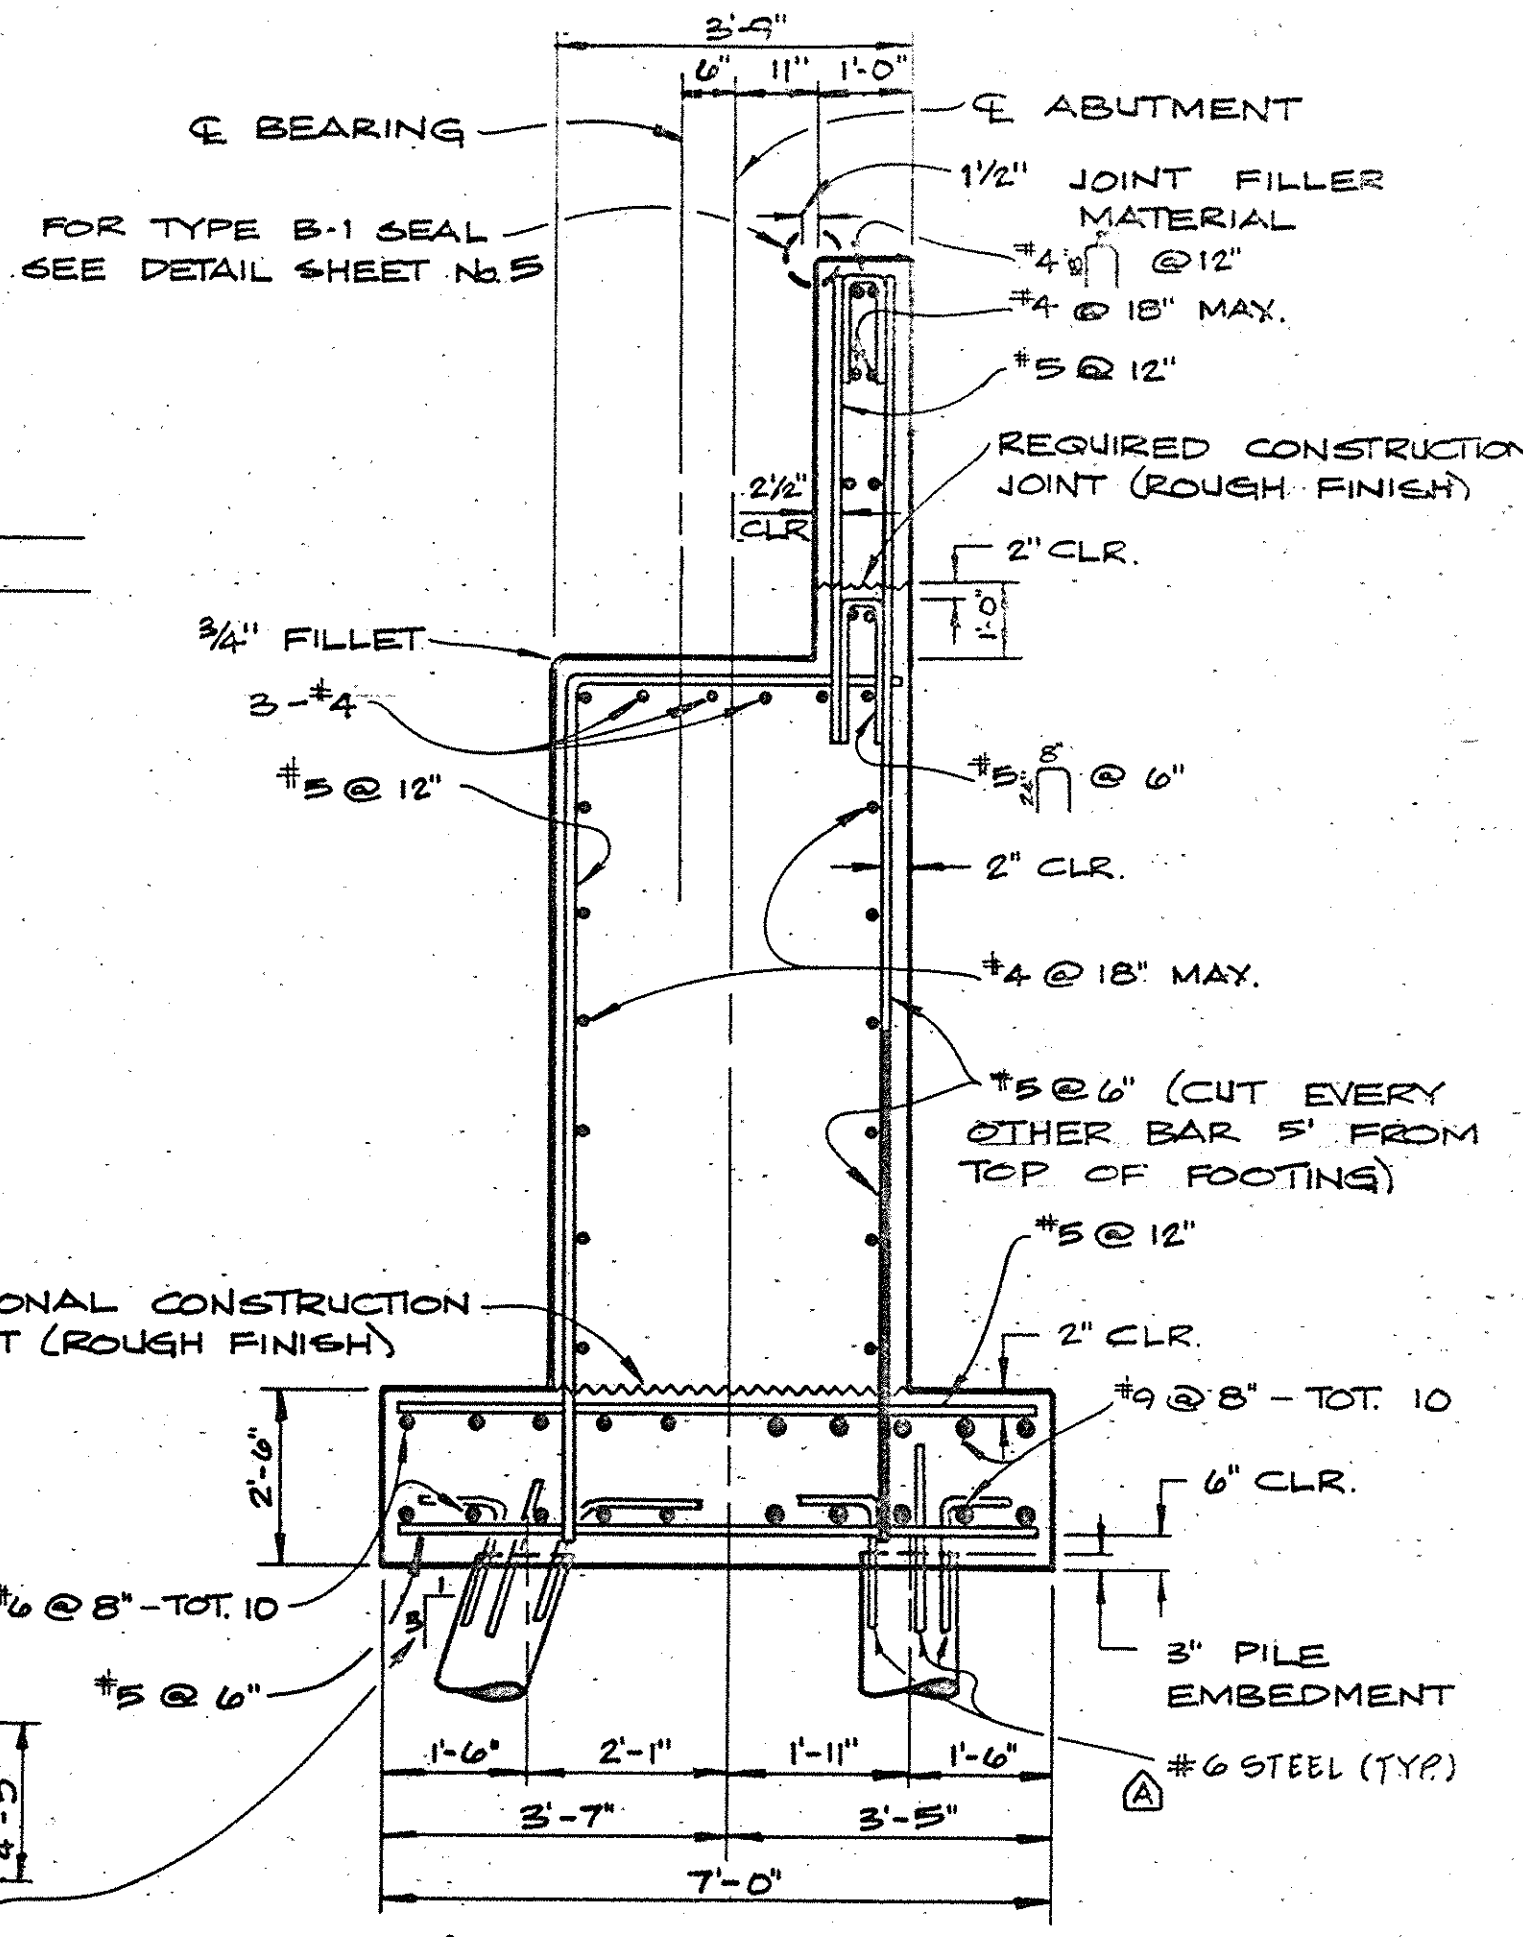

SECTION B-B

SCALE: HORIZ. 1/2" = 1'-0"
VERT. NOT TO SCALE

GENERAL ABUTMENT NOTES

- ① FOR PREVIOUS BACKFILL DETAIL, SEE SHEET #7.
- ② CONCRETE ABOVE BACKWALL CONSTRUCTION JOINT TO BE PLACED AFTER COMPLETION OF SUPERSTRUCTURE.
- ③ ABUTMENT No. 1 SHOWN. ABUTMENT No. 5 SIMILAR, BUT OPPOSITE HAND.
- ④ FOR ABUTMENT DETAILS, SEE SHEET #5.

1 1/2 0 1 2
3 inches on original drawing

AS BUILT

WHILE THE INFORMATION SHOWN IS BELIEVED TO BE ACCURATE, THE ORANGE COUNTY ENVIRONMENTAL MANAGEMENT AGENCY WILL NOT BE RESPONSIBLE FOR OMISSIONS, ERRORS, OR INACCURACIES.

ORANGE COUNTY ENVIRONMENTAL MANAGEMENT AGENCY			
TALBERT - MACARTHUR BRIDGE ACROSS SANTA ANA RIVER			
ABUTMENT			
MARK	DATE	DESCRIPTION	PREPARED UNDER SUPERVISION OF
DESIGNED	MMHSU	SCALE	DATE
DRAWN	PLB	CHECKED	GWFF
SHEET			4