



PLAN
SECTION A-A
SCALE: 1/4" = 1'-0"

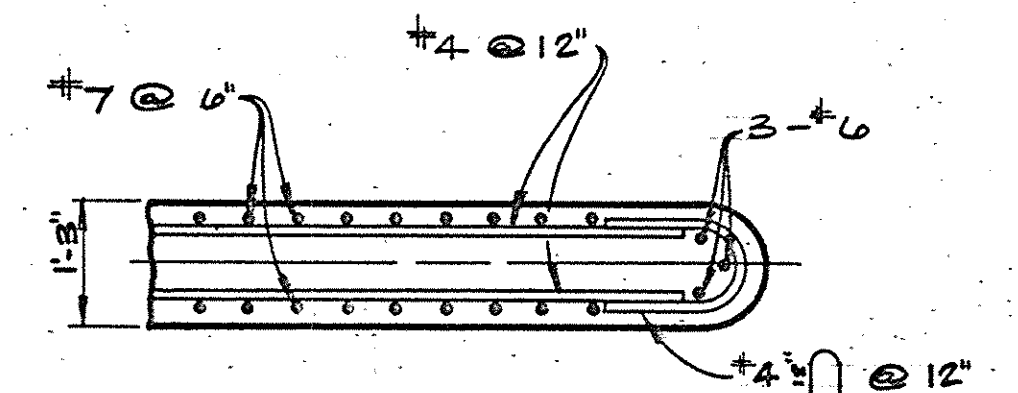


SECTION D-D
SCALE: 1/2" = 1'-0"

NOTE:
DOWNSTREAM EDGE SHOWN.
UPSTREAM EDGE SIMILAR
BUT OPPOSITE HAND.

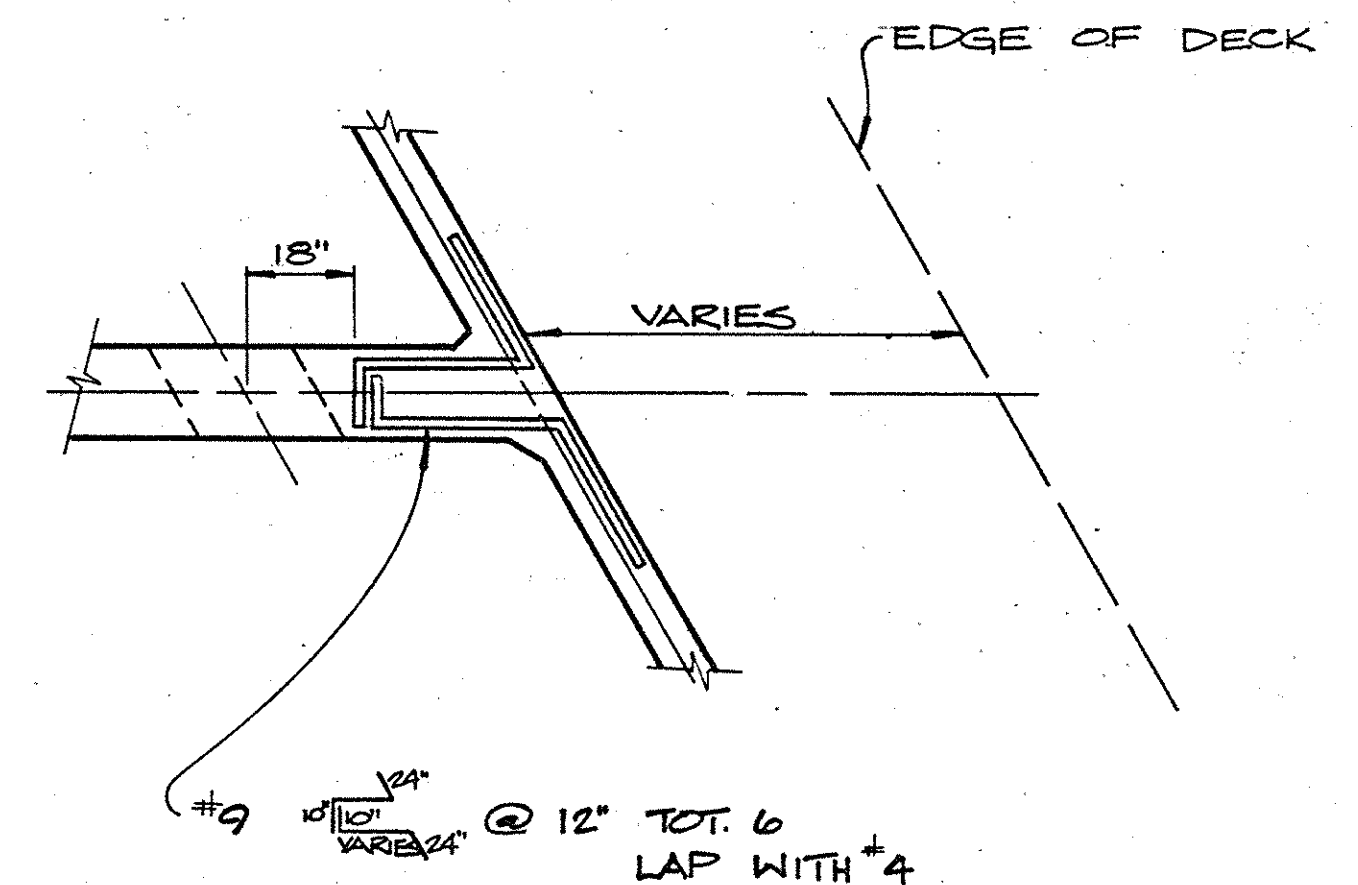


DETAIL "A"
NO SCALE

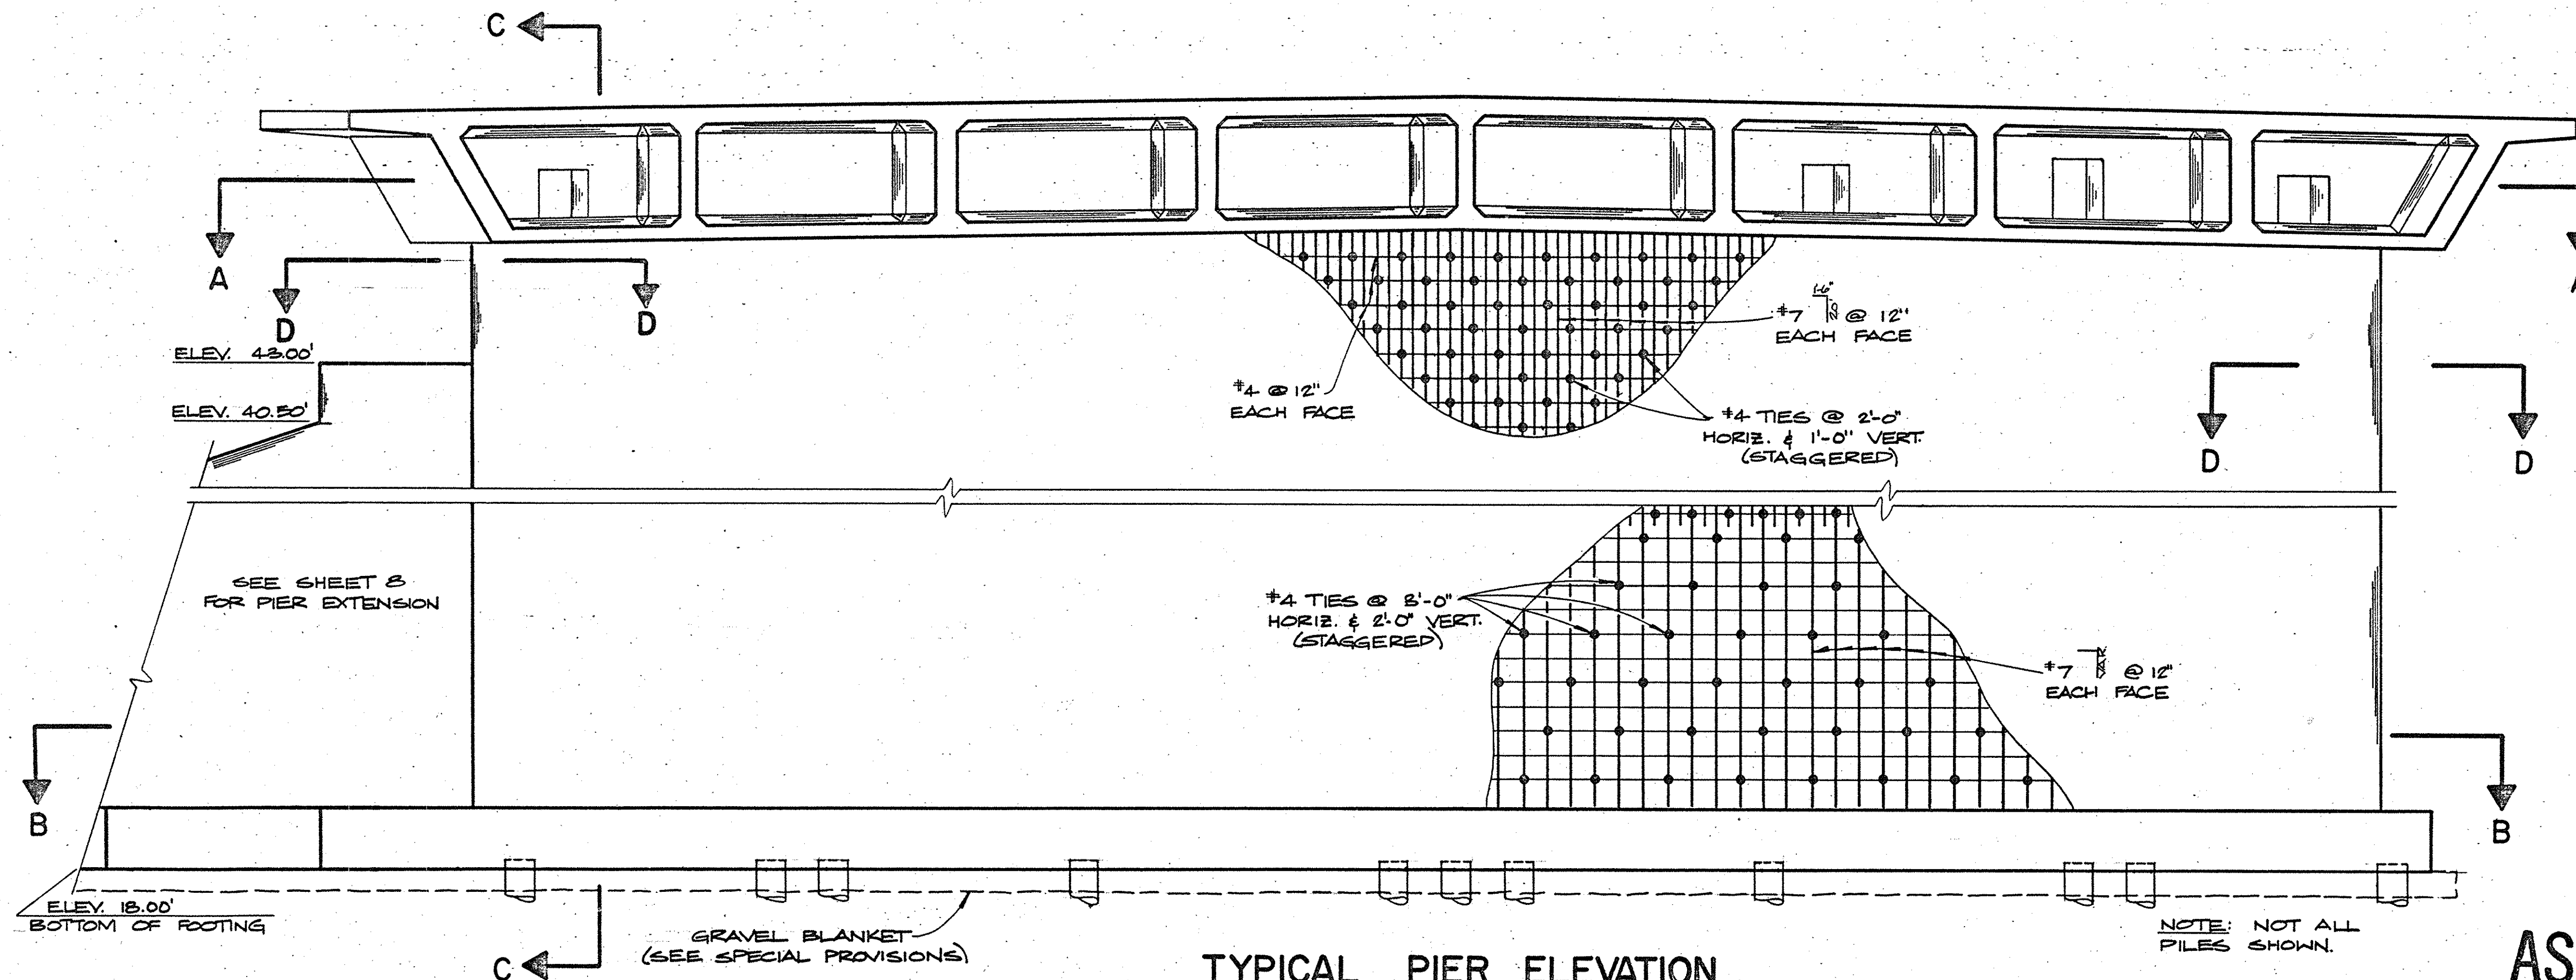

TYPICAL PIER ELEVATION

SCALE: 1/4" = 1'-0"

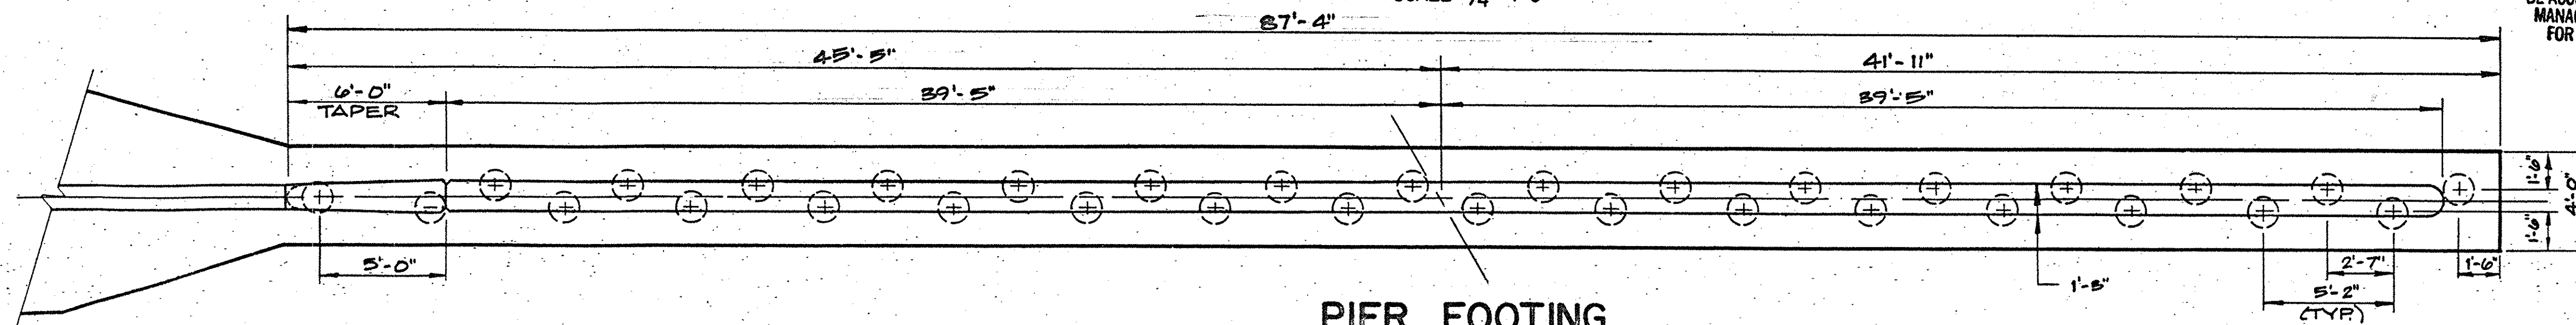

PIER FOOTING

SECTION B-B
SCALE: 1/4" = 1'-0"

AS BUILT

WHILE THE INFORMATION SHOWN IS BELIEVED TO BE ACCURATE, THE ORANGE COUNTY ENVIRONMENTAL MANAGEMENT AGENCY WILL NOT BE RESPONSIBLE FOR OMISSIONS, ERRORS, OR INACCURACIES.

1 1/2 0 1 2
3 inches on original drawing

ORANGE COUNTY ENVIRONMENTAL MANAGEMENT AGENCY			
TALBERT - MACARTHUR BRIDGE ACROSS SANTA ANA RIVER			
TYPICAL PIER			
MARK	DATE	DESCRIPTION	PREPARED UNDER SUPERVISION OF
A	4/82	K	Gene A. Fisher 4/82
DESIGNED		SCALE	DATE
MM.HSU		AS SHOWN	4/82
DRAWN		CHECKED	DATE
PLB		GWF	
SHEET			6