



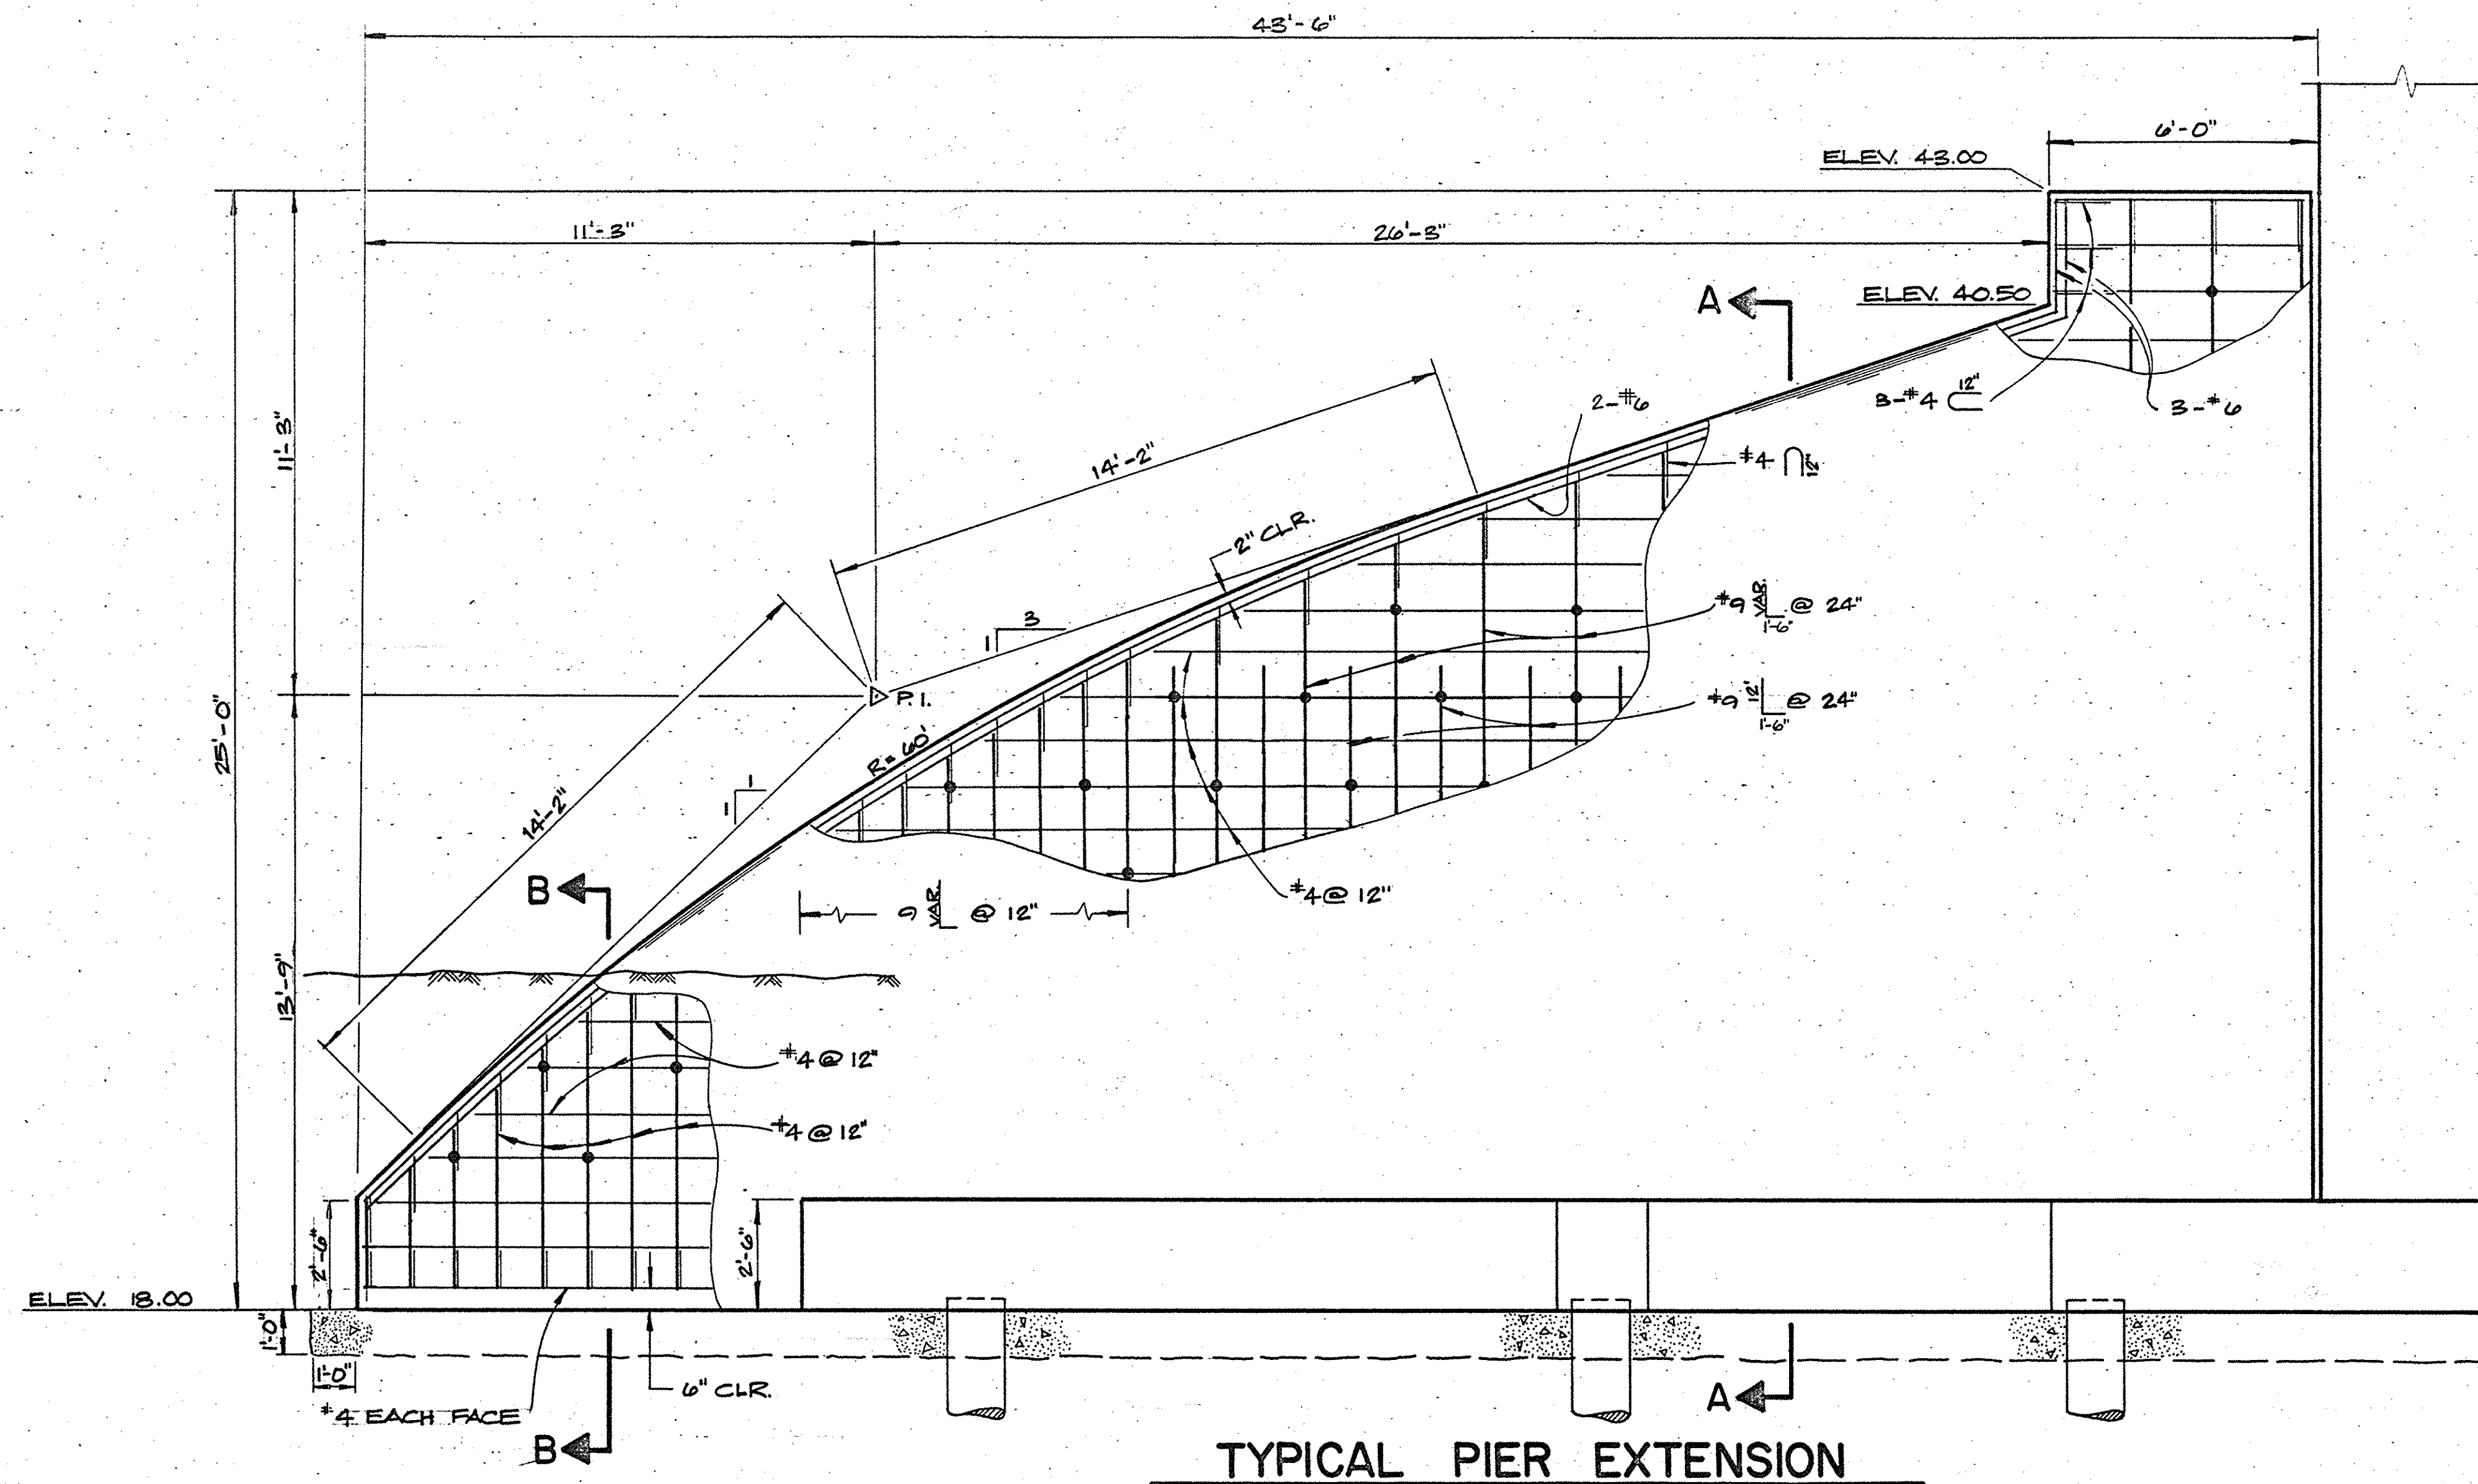


TYPICAL PIER EXTENSION

SCALE: $\frac{3}{8}'' = 1'-0''$

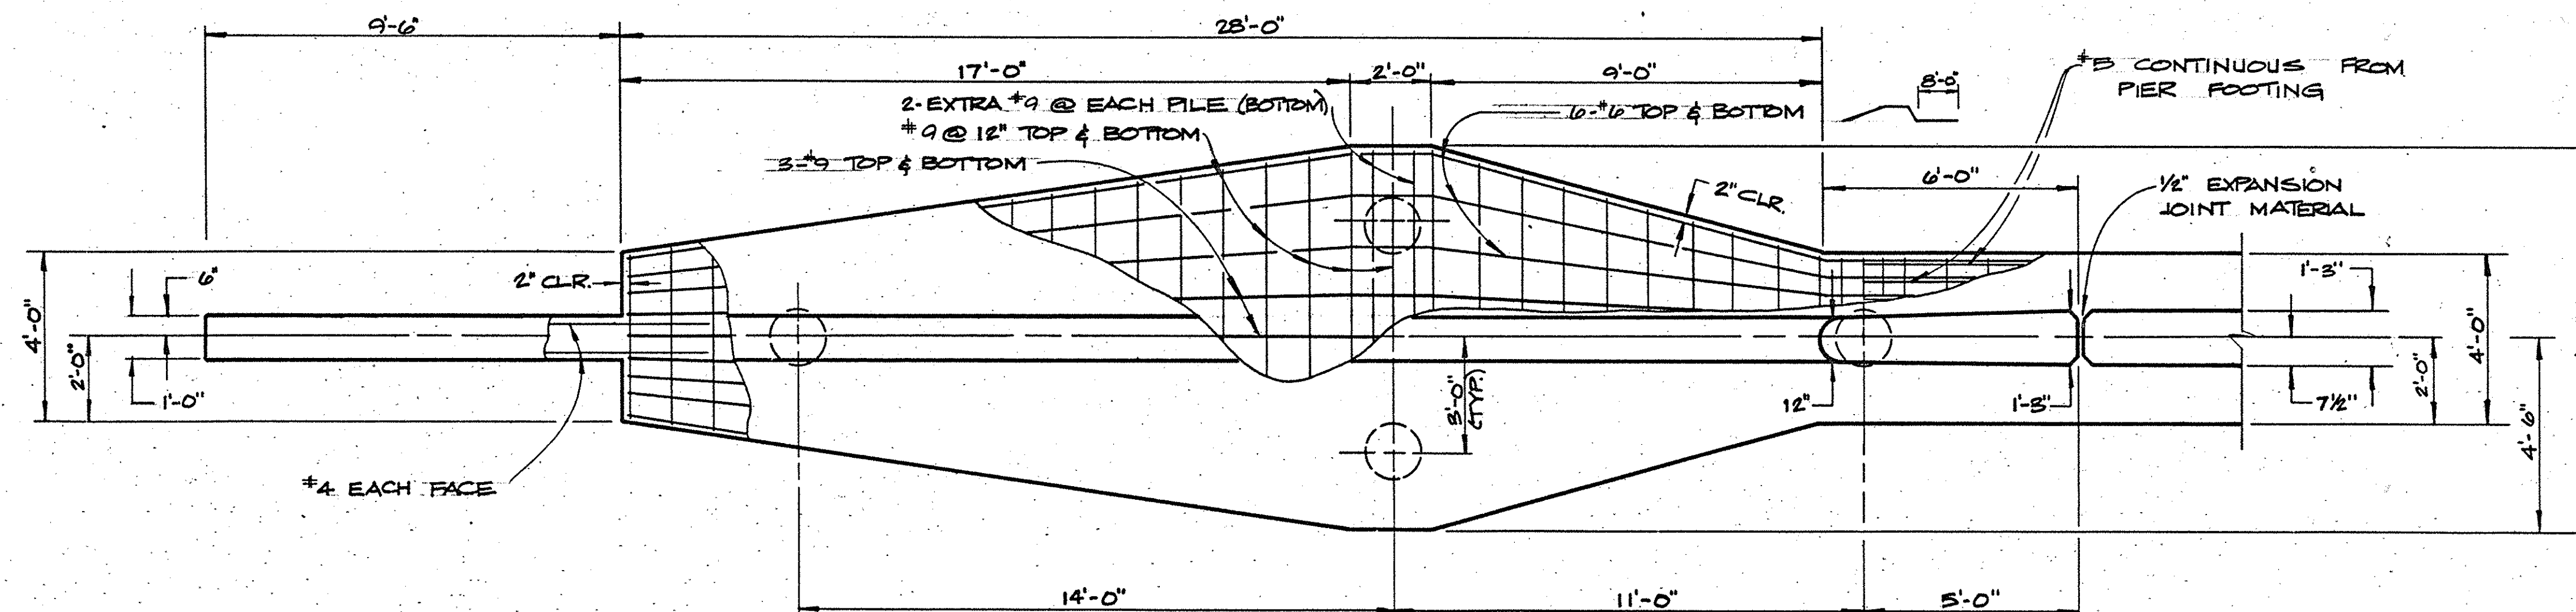


PIER EXTENSION FOOTING

SCALE: $\frac{3}{8}'' = 1'-0''$

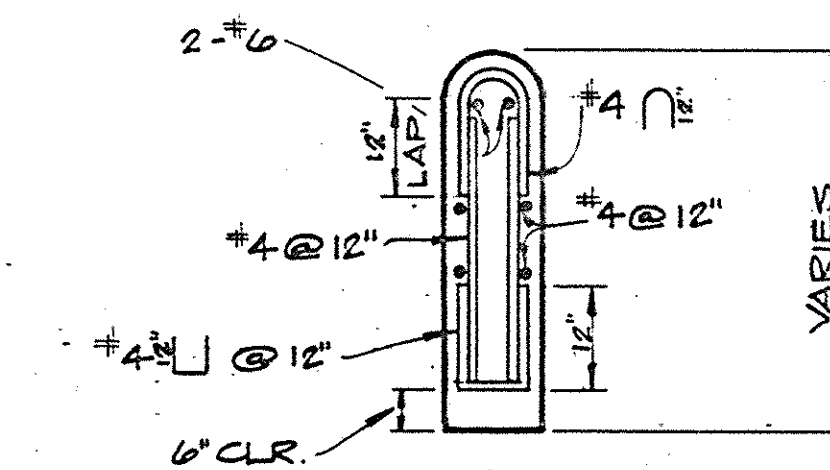

SECTION B-B

SCALE: $\frac{1}{2}'' = 1'-0''$

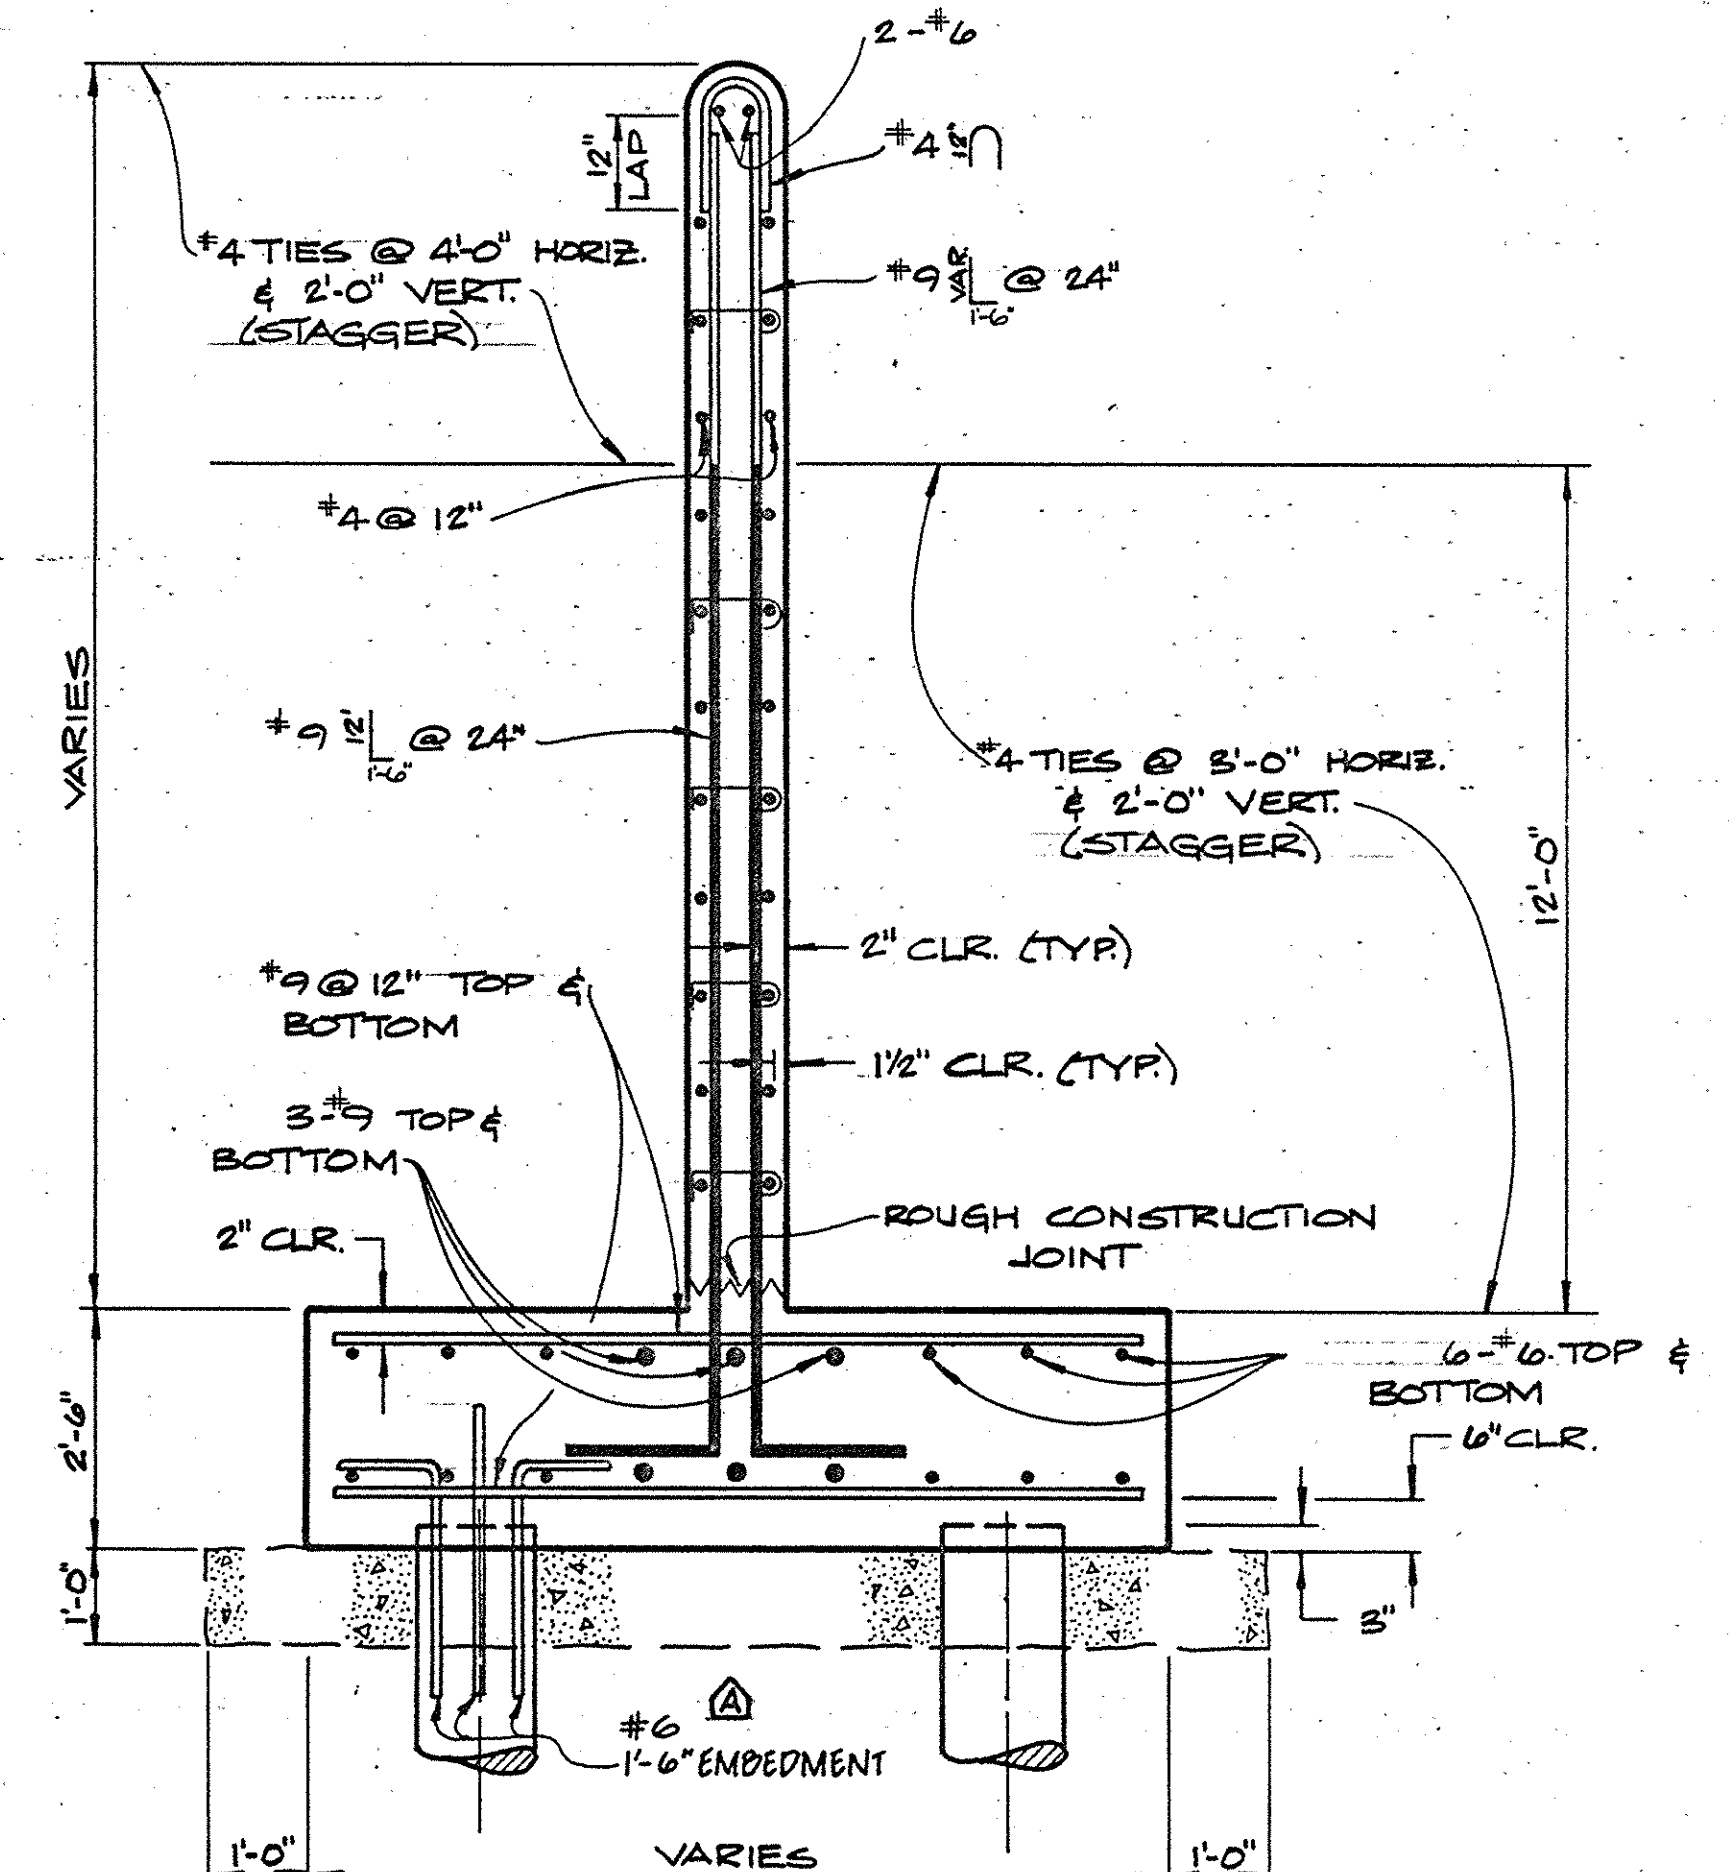

SECTION A-A

SCALE: $\frac{1}{2}'' = 1'-0''$



AS BUILT
WHILE THE INFORMATION SHOWN IS BELIEVED TO BE ACCURATE, THE ORANGE COUNTY ENVIRONMENTAL MANAGEMENT AGENCY WILL NOT BE RESPONSIBLE FOR OMISSIONS, ERRORS, OR INACCURACIES.

ORANGE COUNTY ENVIRONMENTAL MANAGEMENT AGENCY			
TALBERT - MACARTHUR BRIDGE ACROSS SANTA ANA RIVER			
TYPICAL PIER EXTENSION			
MARK	DATE	DESCRIPTION	PREPARED UNDER SUPERVISION OF
DESIGNED	MM.HSU	SCALE	DATE
DRAWN	PLB	CHECKED	GWF
SHEET			8