




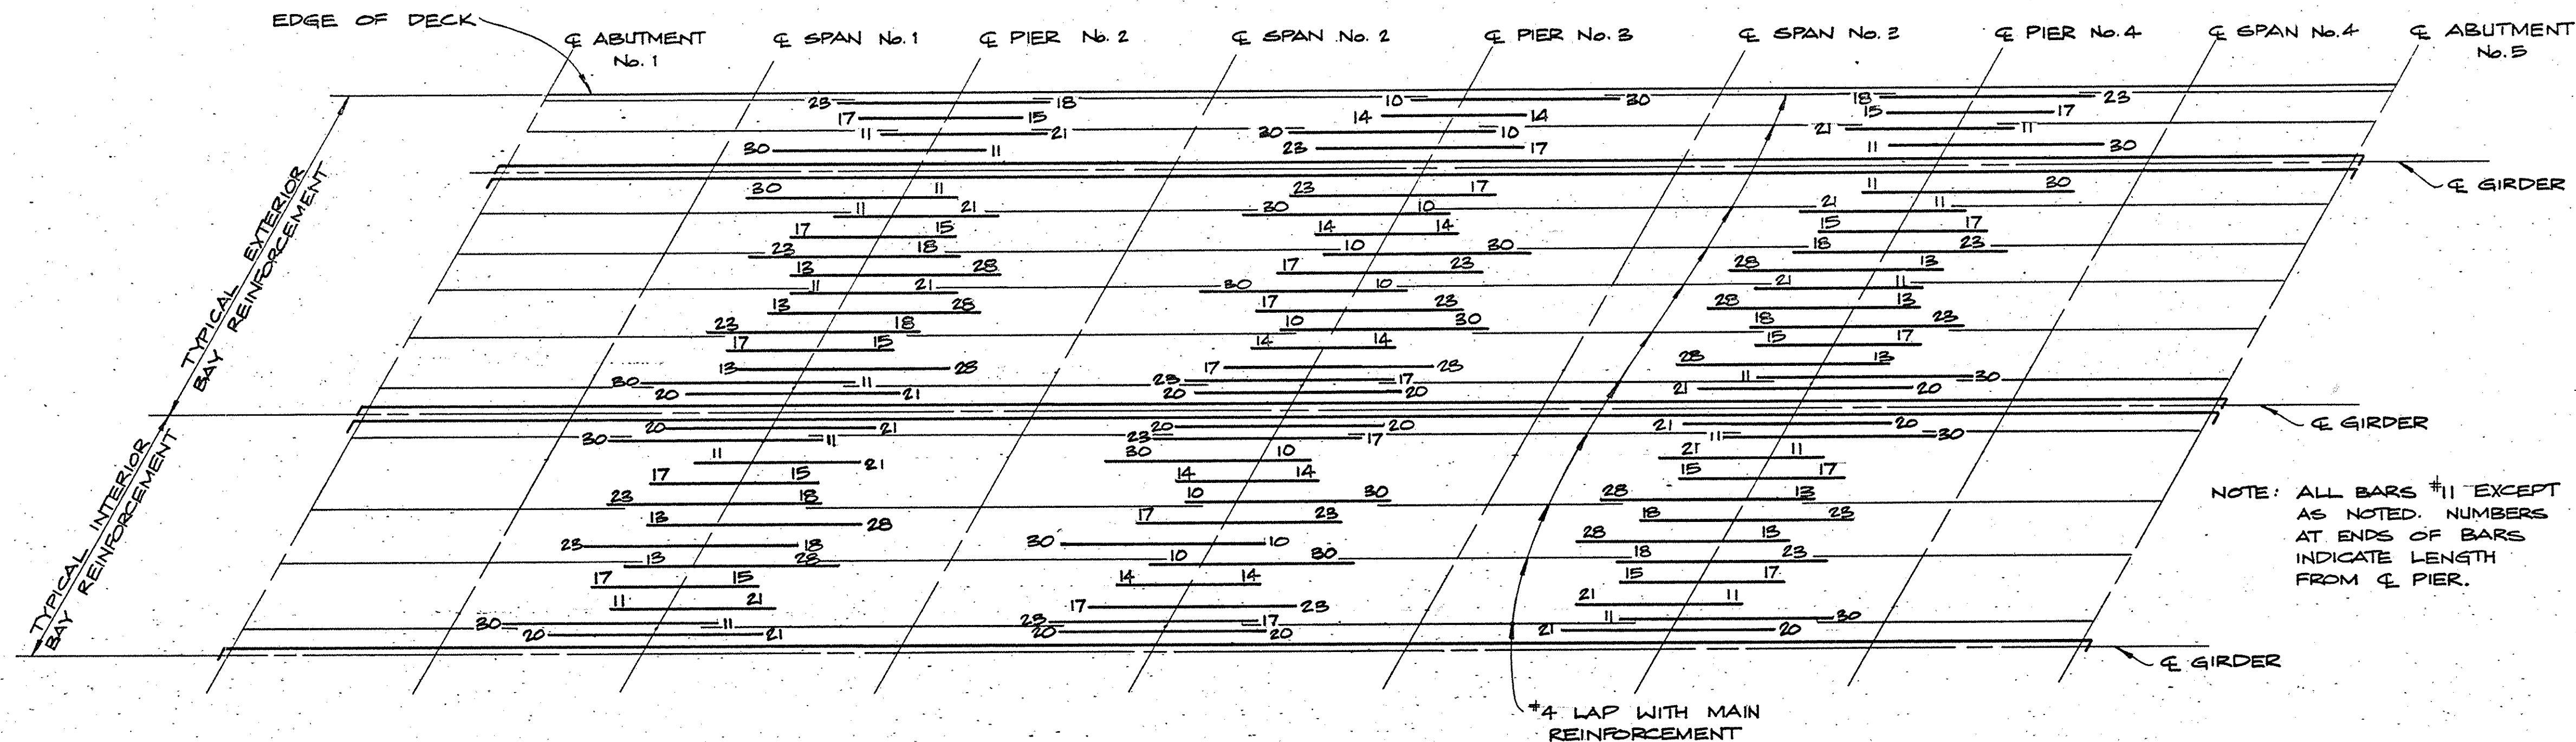

TOP REINFORCEMENT
NO SCALE

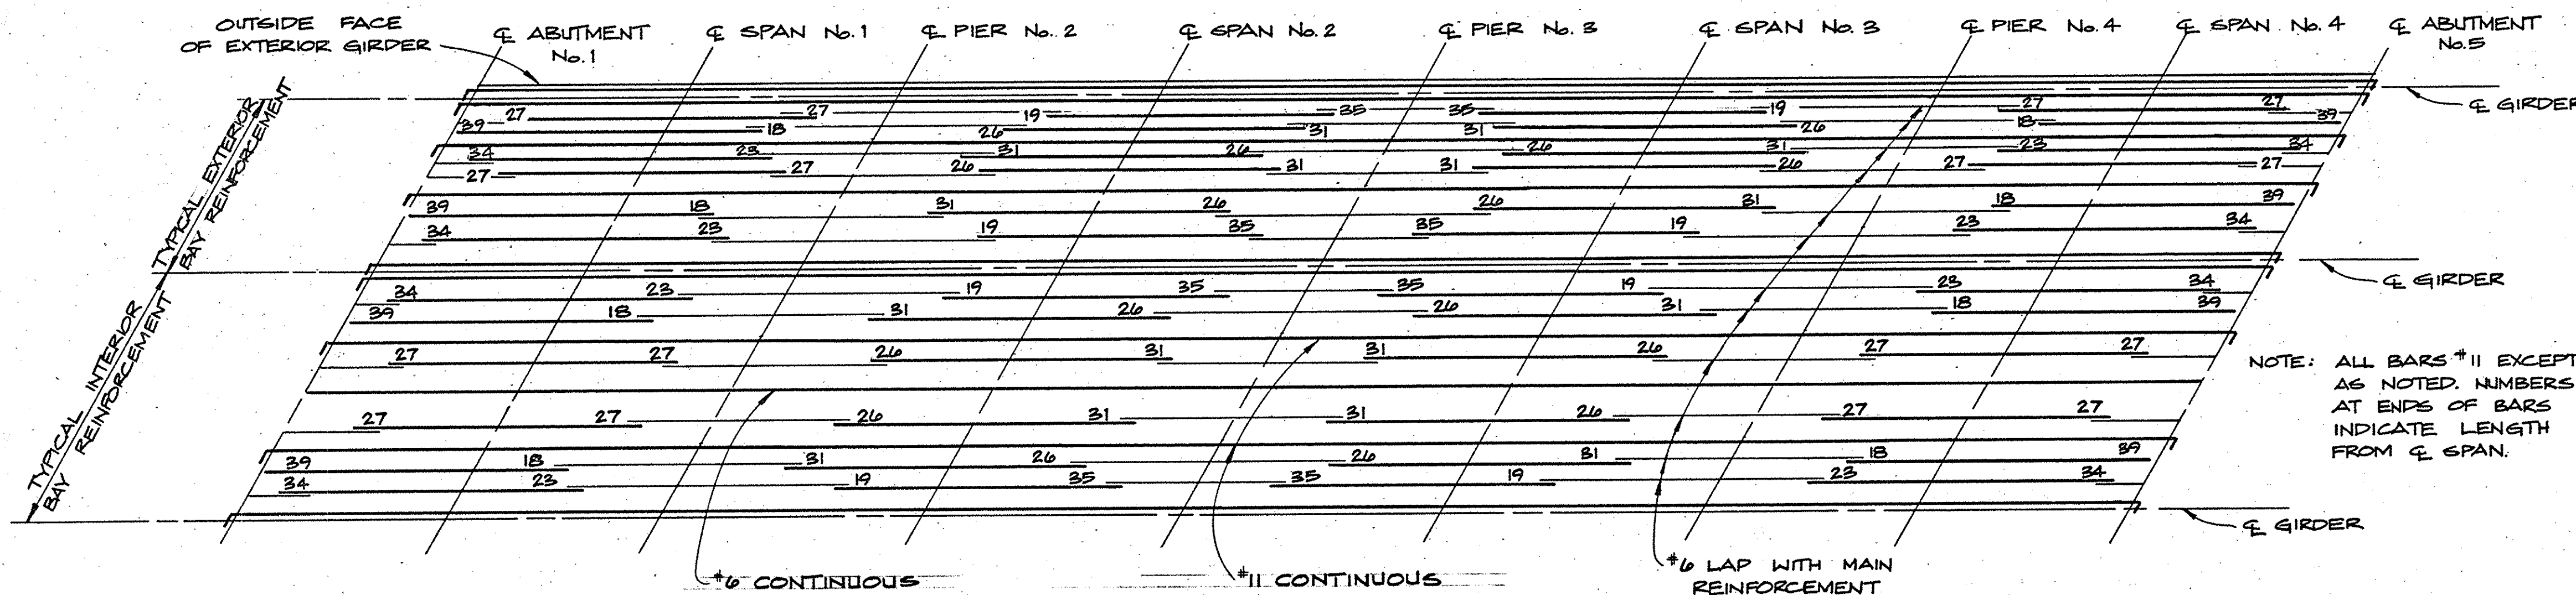

BOTTOM REINFORCEMENT
NO SCALE

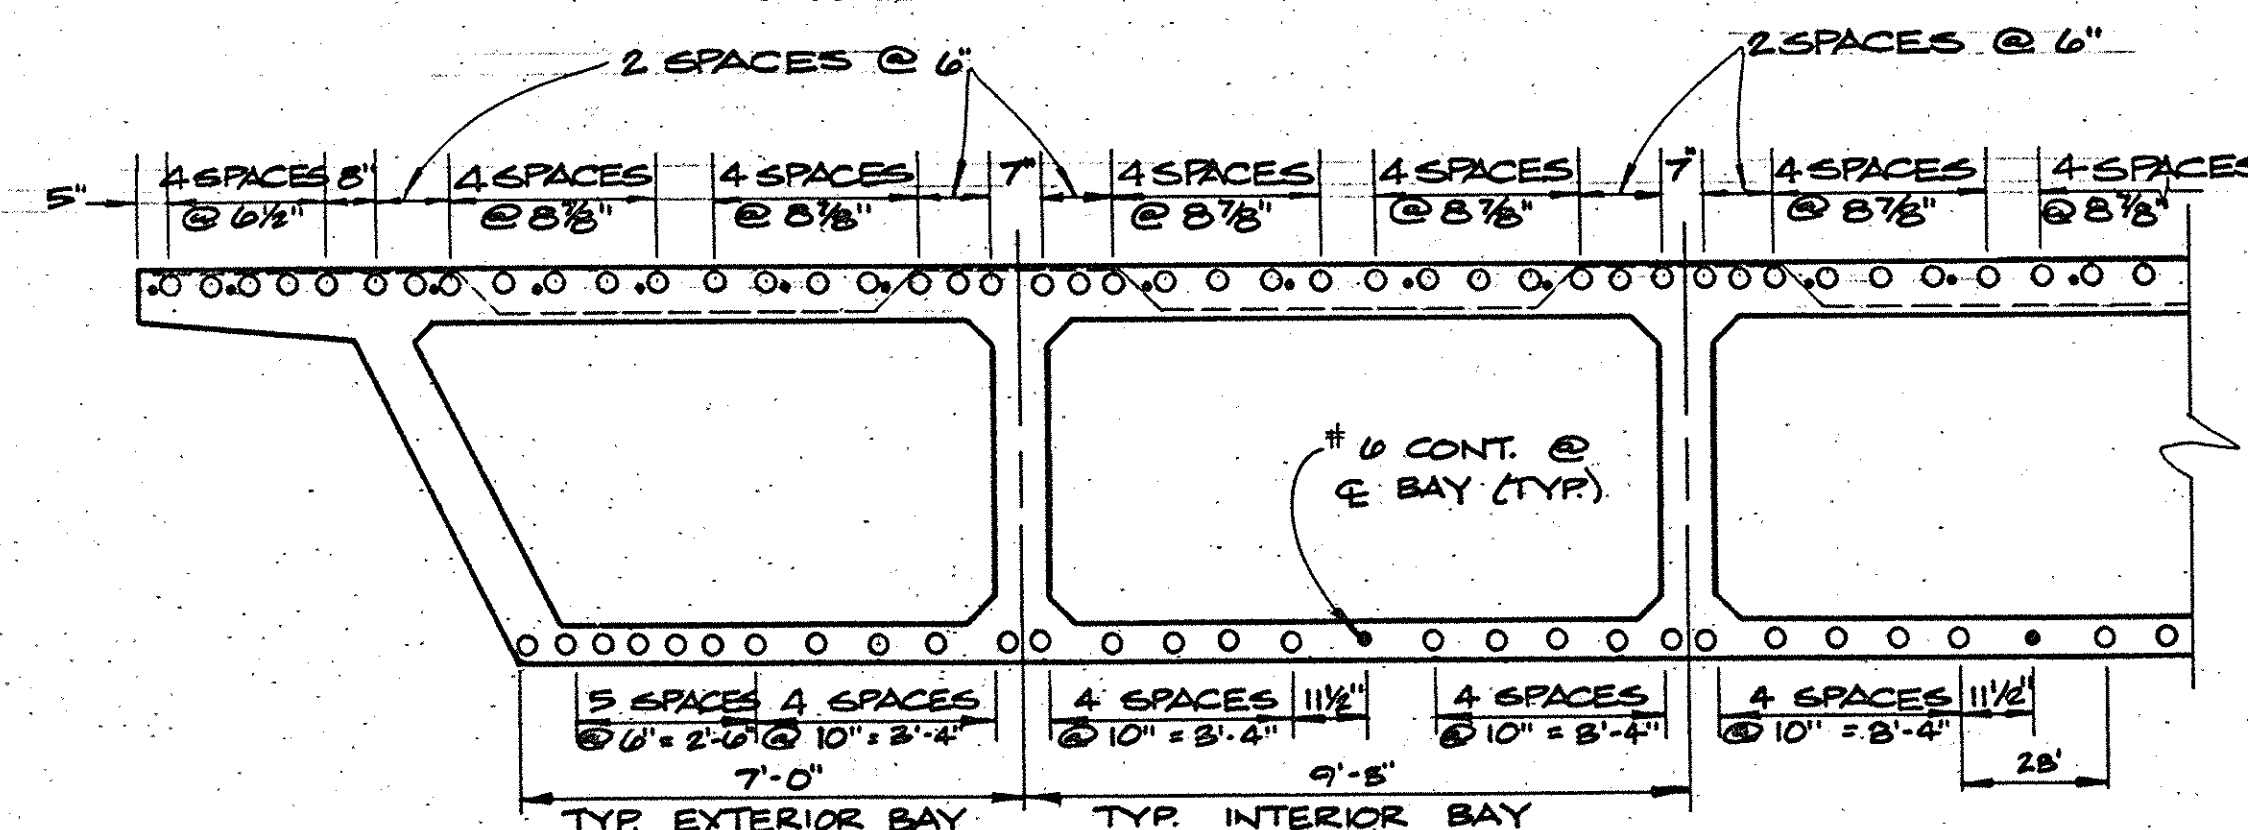

MAIN REINFORCEMENT PLACING DIAGRAM
SCALE: 3/8" = 1'-0"

1 1/2 0 1 2
3 inches on original drawing

AS BUILT
WHILE THE INFORMATION SHOWN IS BELIEVED TO BE ACCURATE, THE ORANGE COUNTY ENVIRONMENTAL MANAGEMENT AGENCY WILL NOT BE RESPONSIBLE FOR OMISSIONS, ERRORS, OR INACCURACIES.

ORANGE COUNTY ENVIRONMENTAL MANAGEMENT AGENCY			
TALBERT - MACARTHUR BRIDGE			
ACROSS SANTA ANA RIVER			
DECK REINFORCEMENT AND PLACING DIAGRAM			
MARK	DATE	DESCRIPTION	SHEET
DESIGNED	DATE	REVISIONS	DATE
DRAWN	DATE	CHECKED	DATE
SCALE	DATE	DWG. NO.	11
AS SHOWN	4/82		