




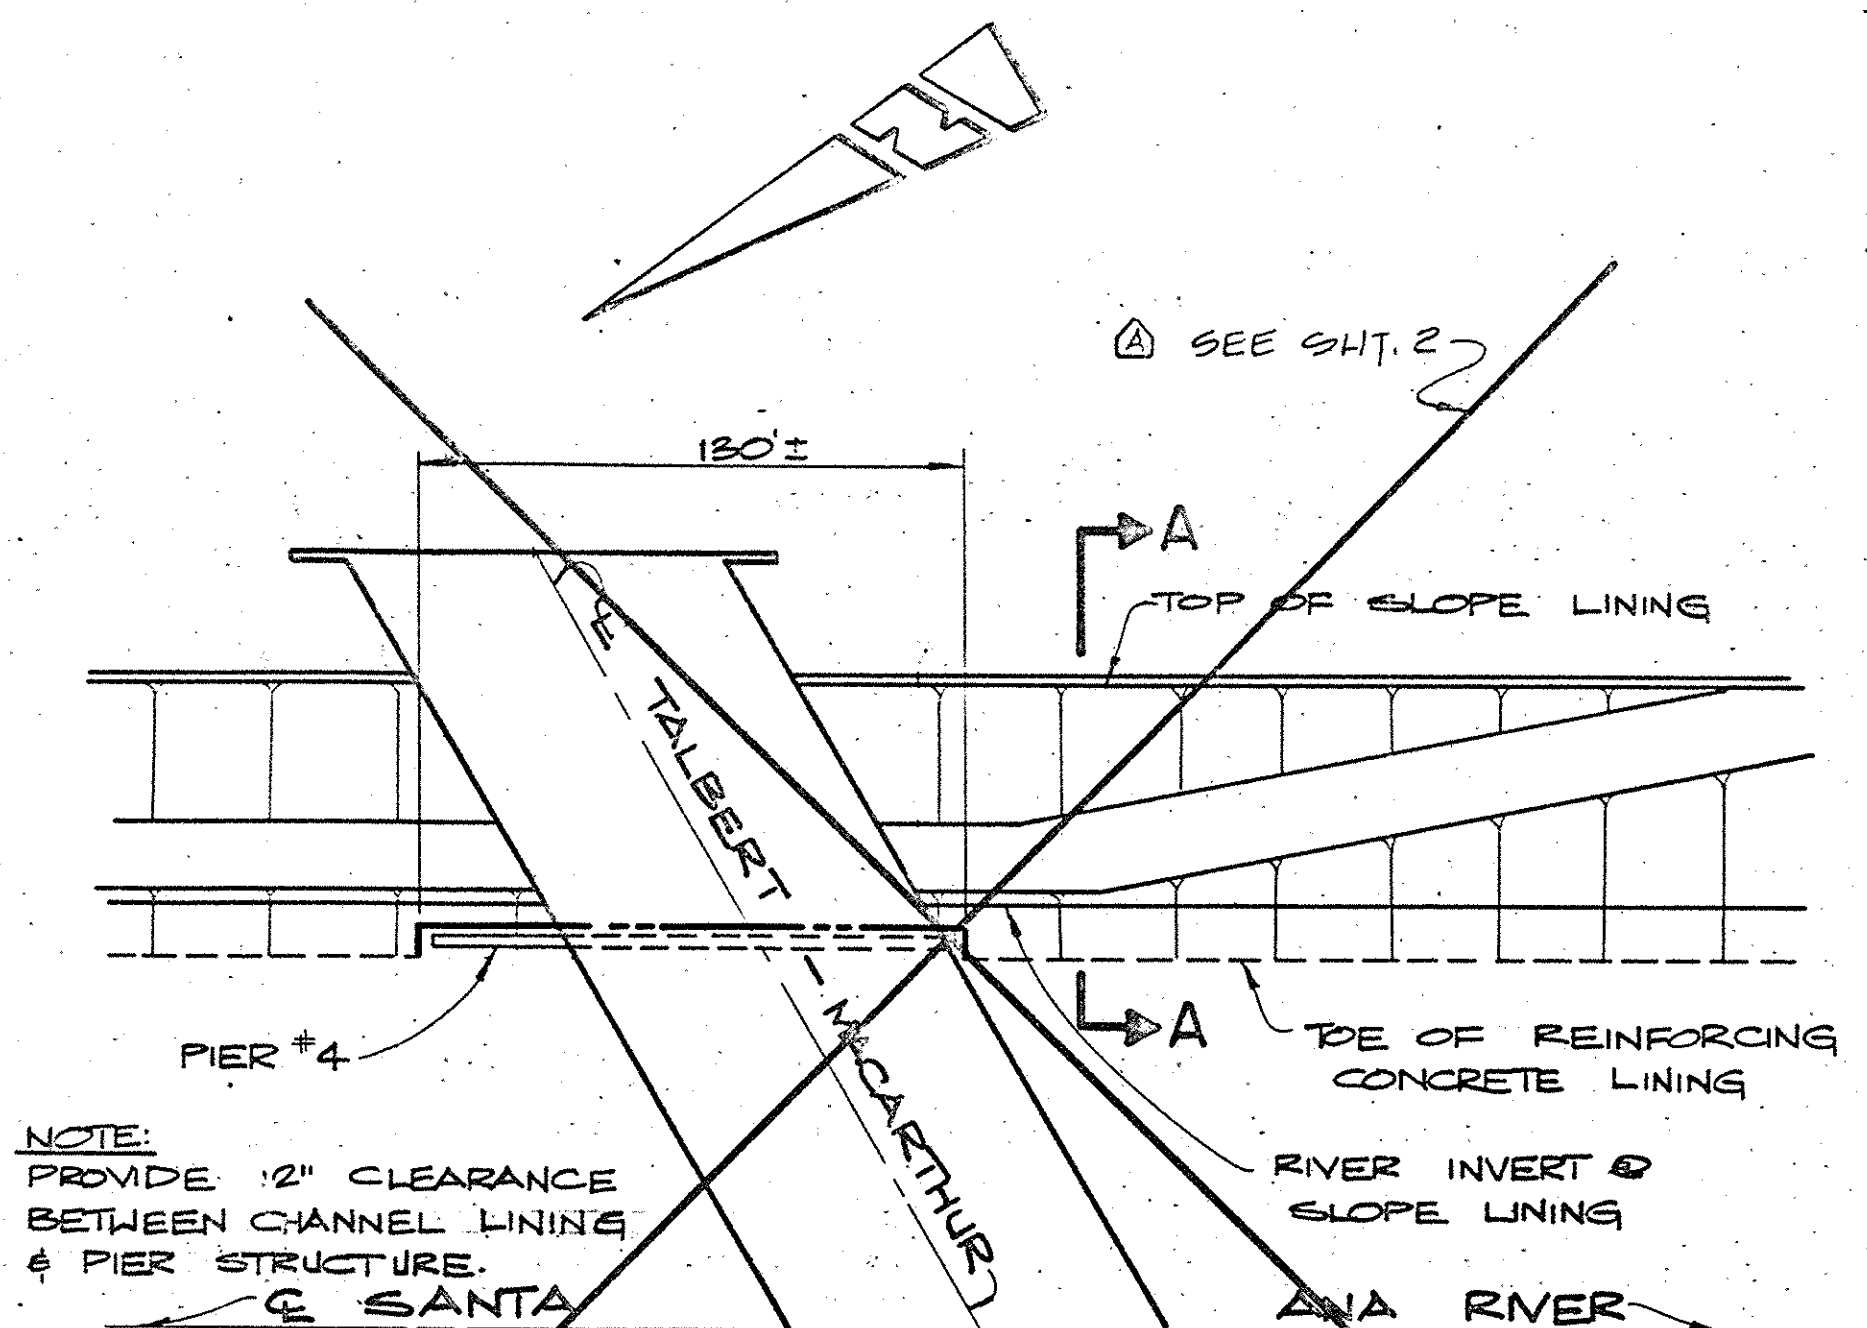

PLAN
OF EAST LEVEE CHANNEL LINING
NO SCALE

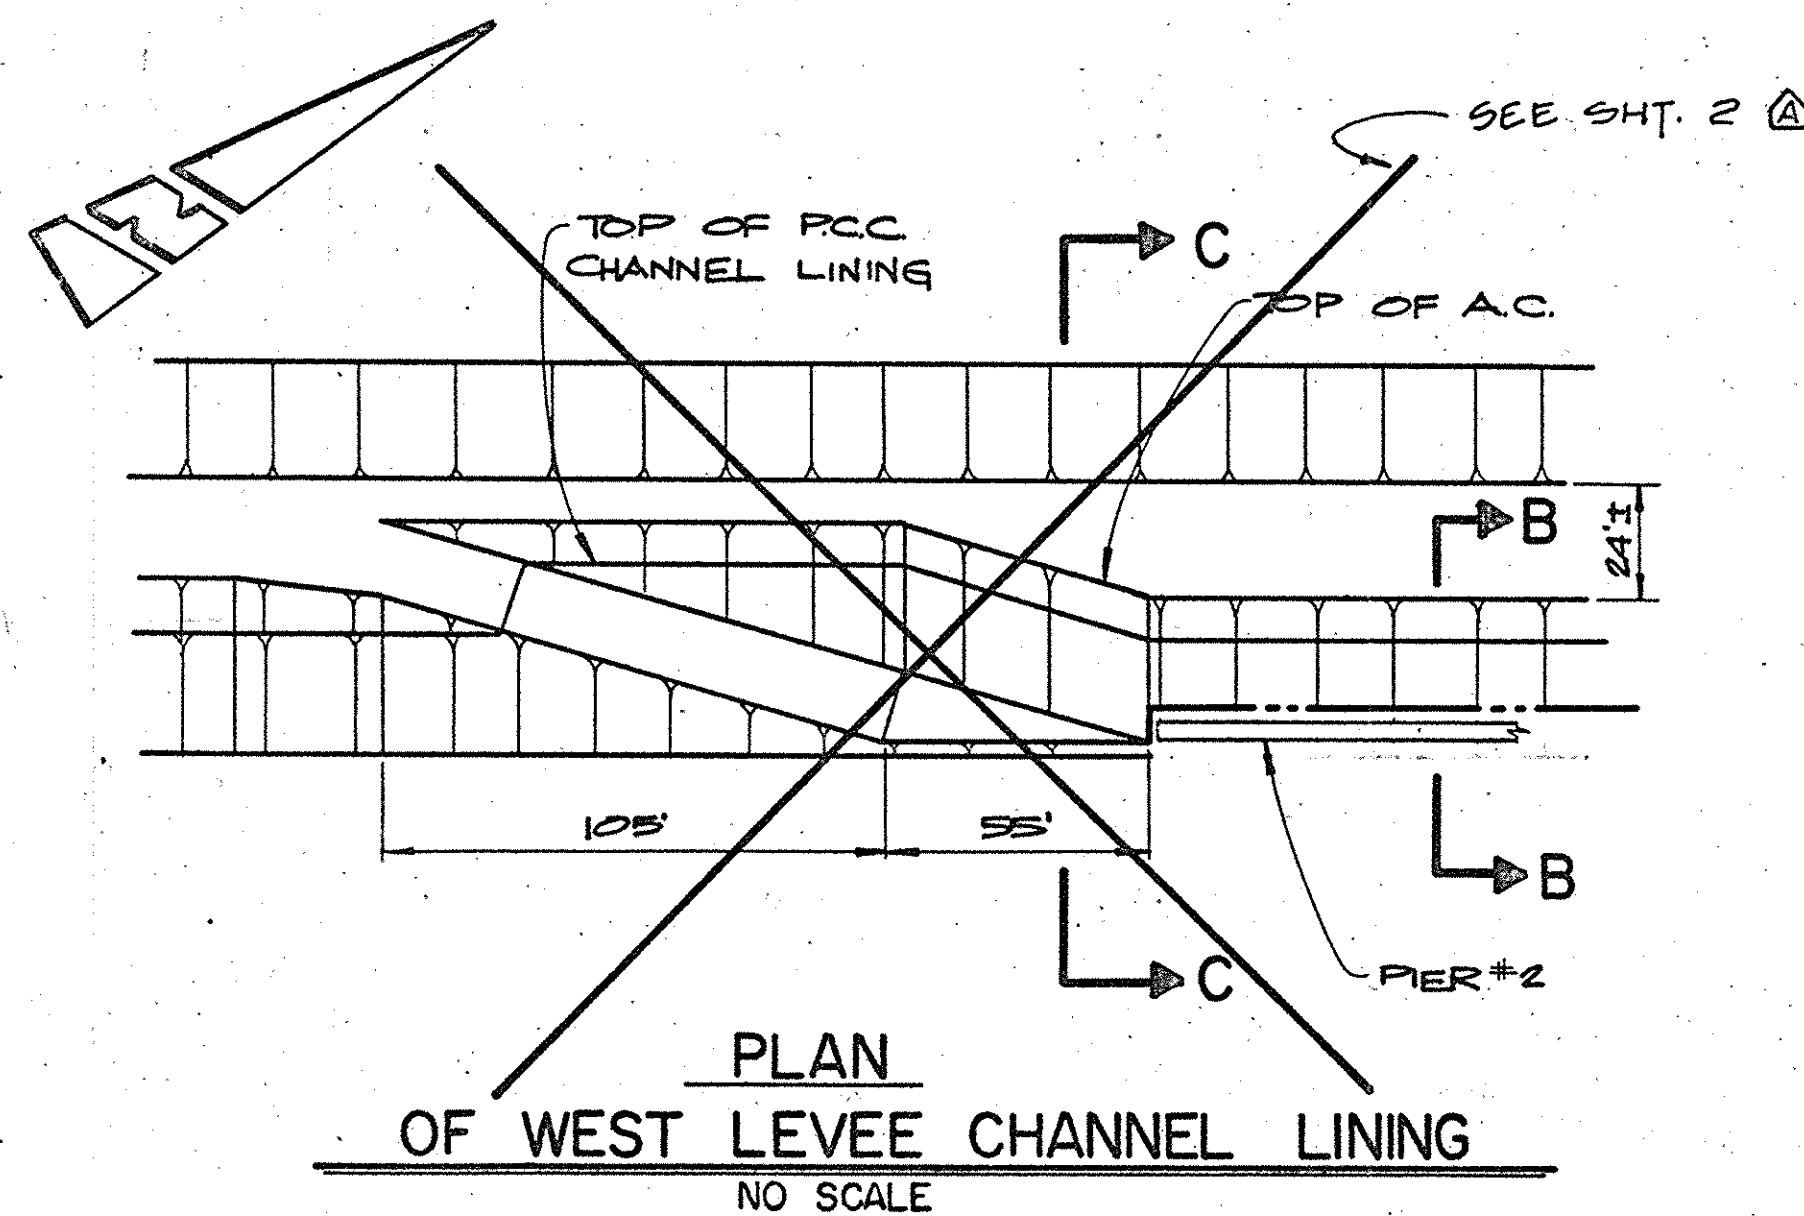


PLAN
OF WEST LEVEE CHANNEL LINING
NO SCALE

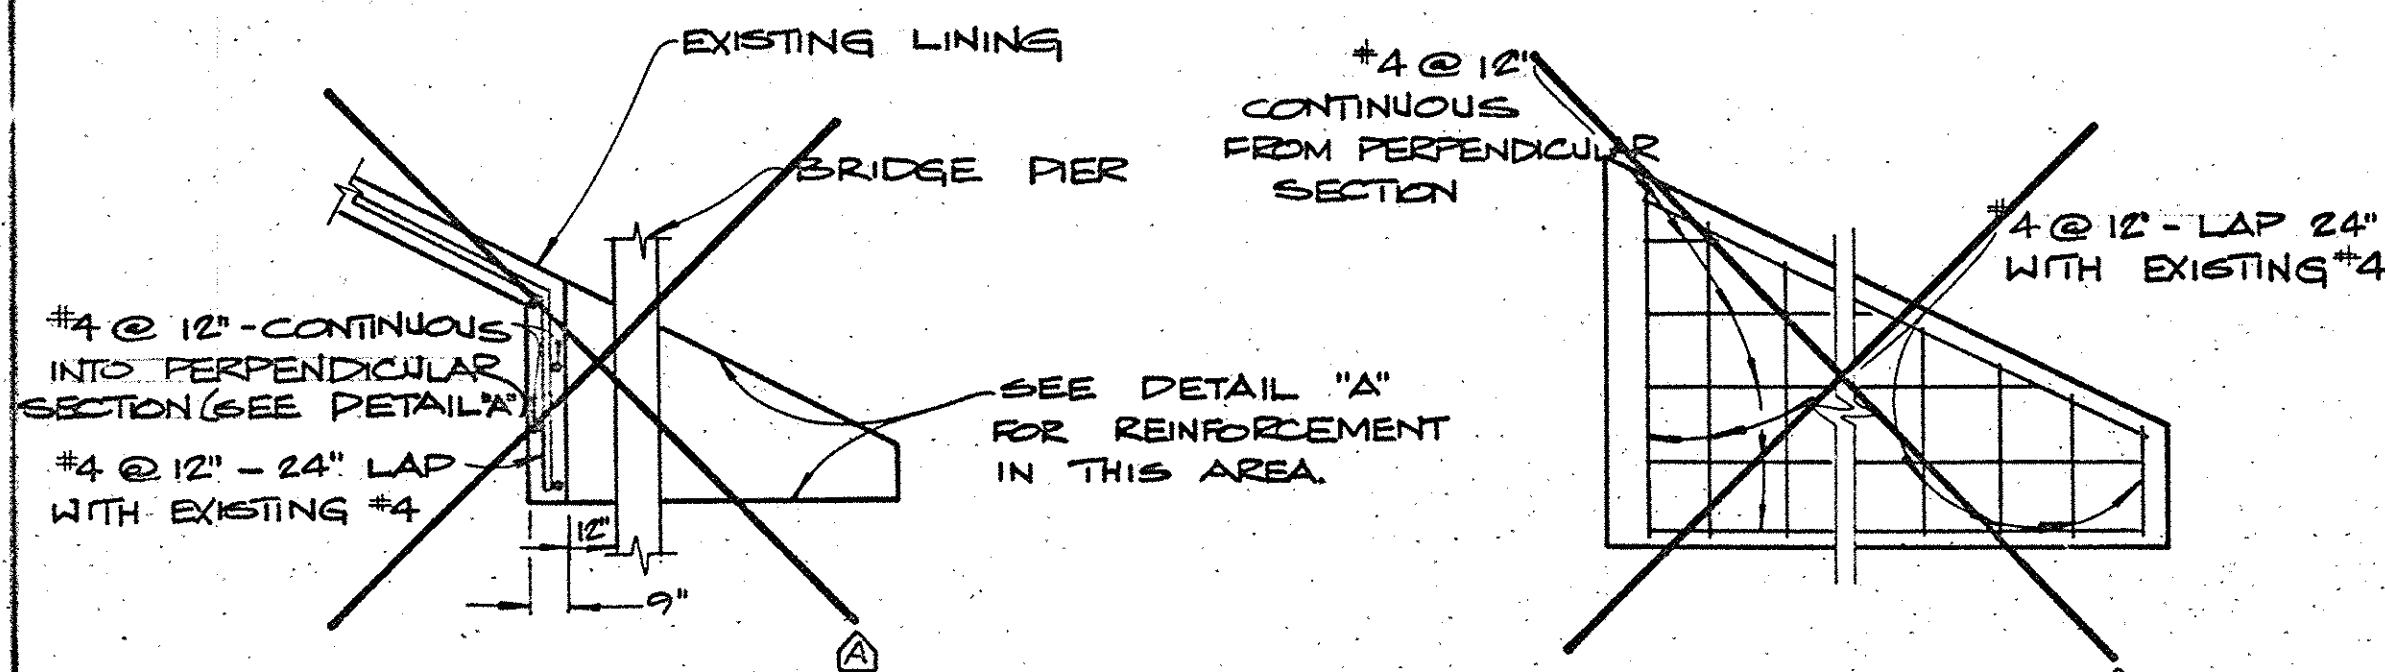


TYPICAL SECTION
OF CHANNEL LINING AT PIERS #2 & #4
NO SCALE


DETAIL "A"
NO SCALE

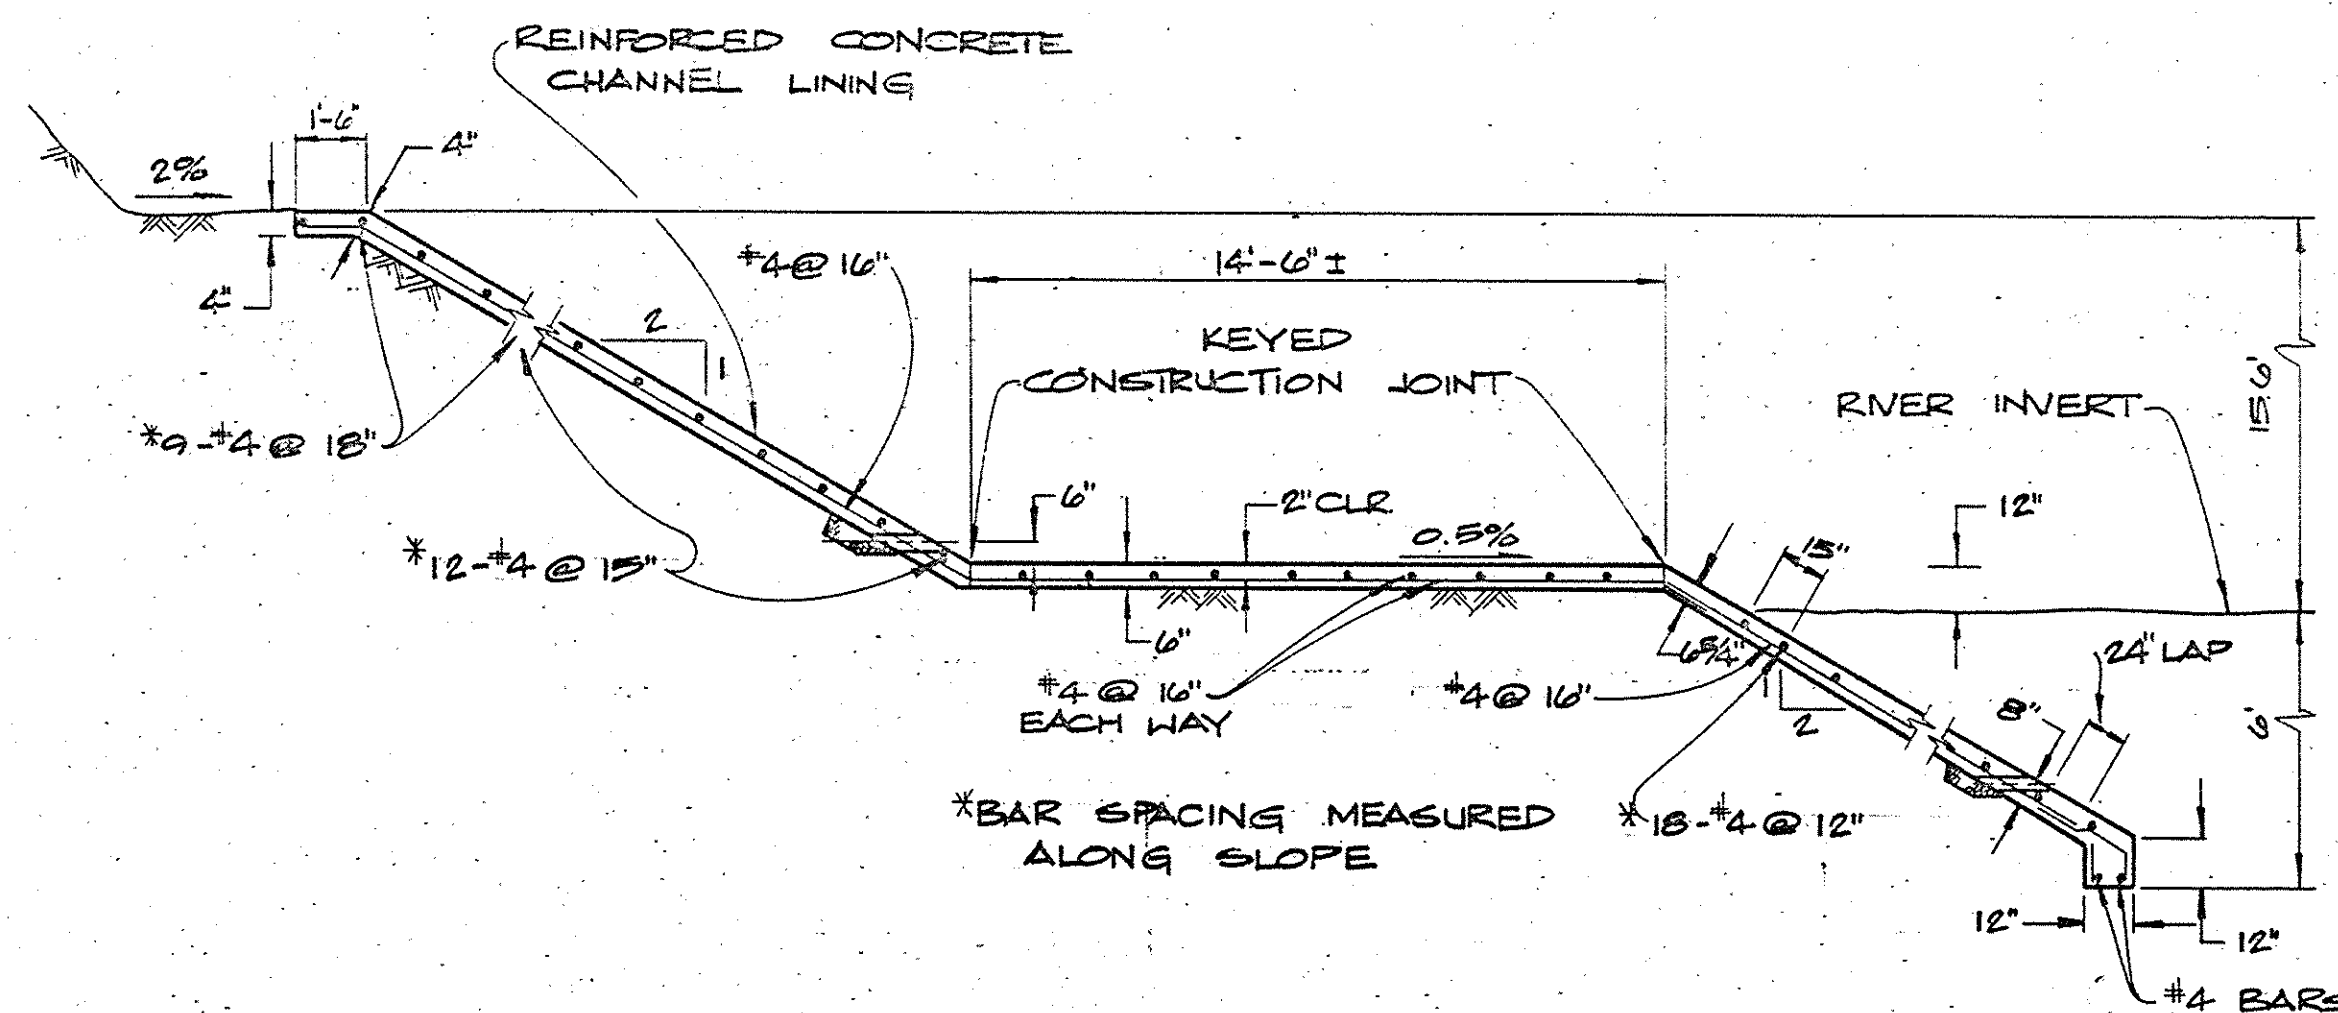


SECTION A-A
NO SCALE

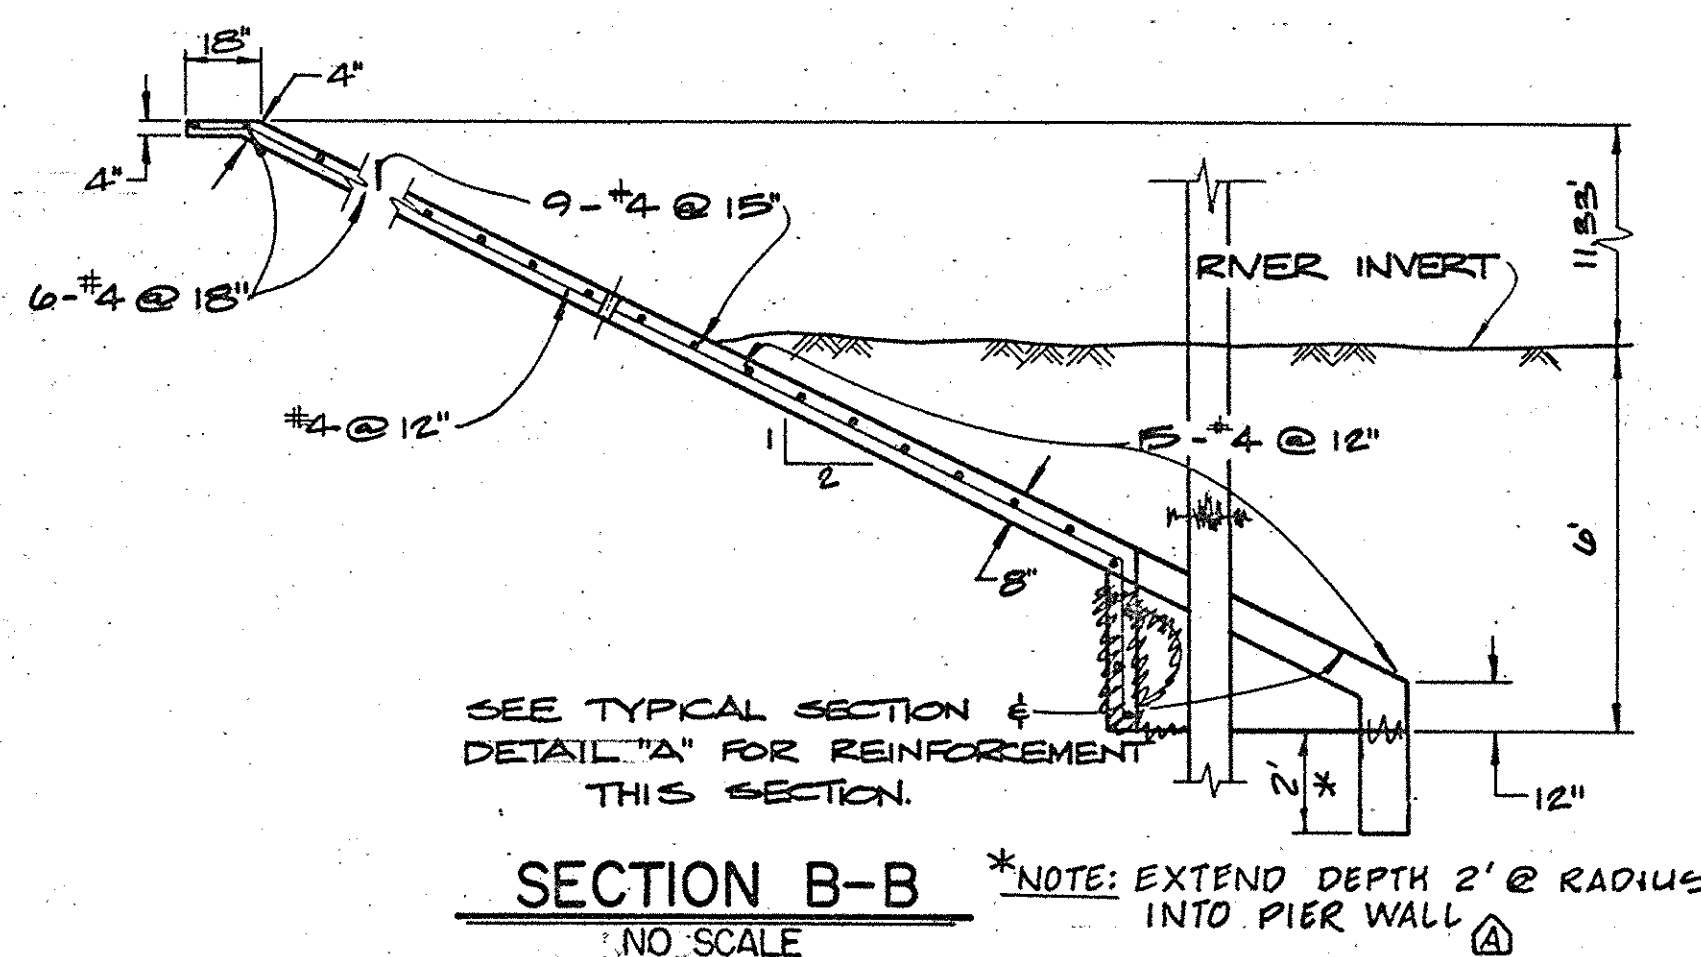


SECTION B-B
NO SCALE

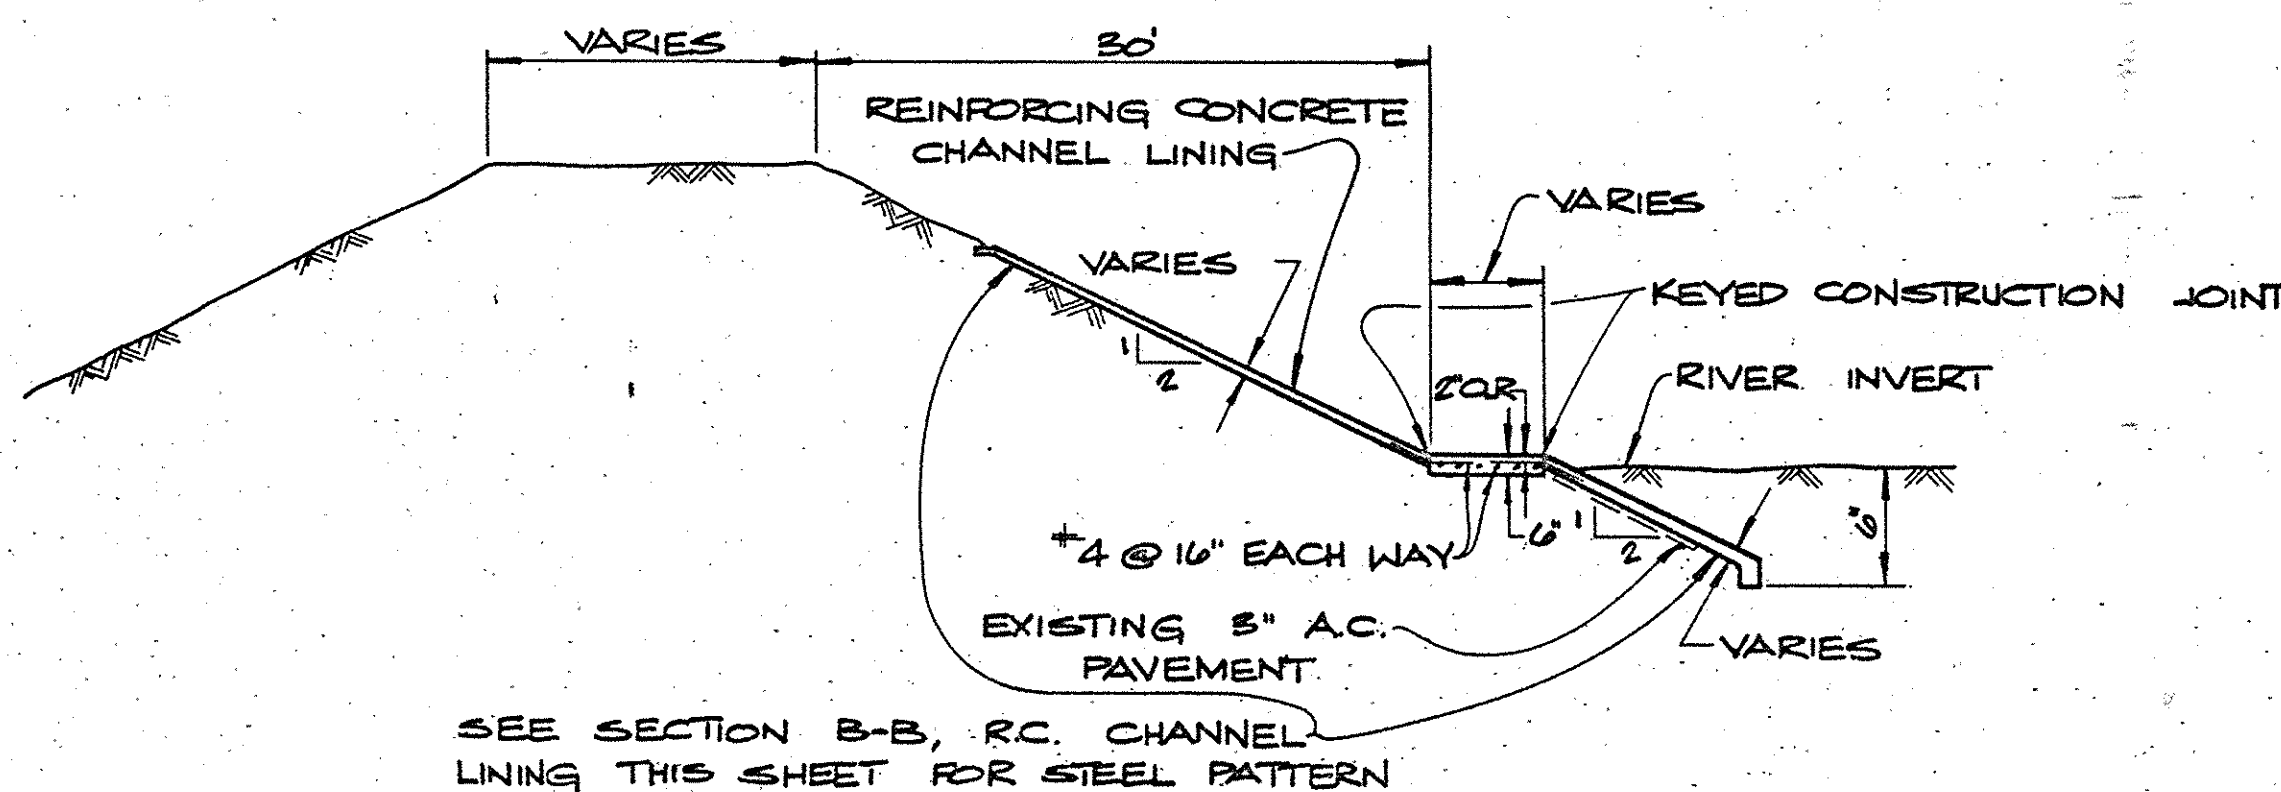

SECTION C-C
NO SCALE

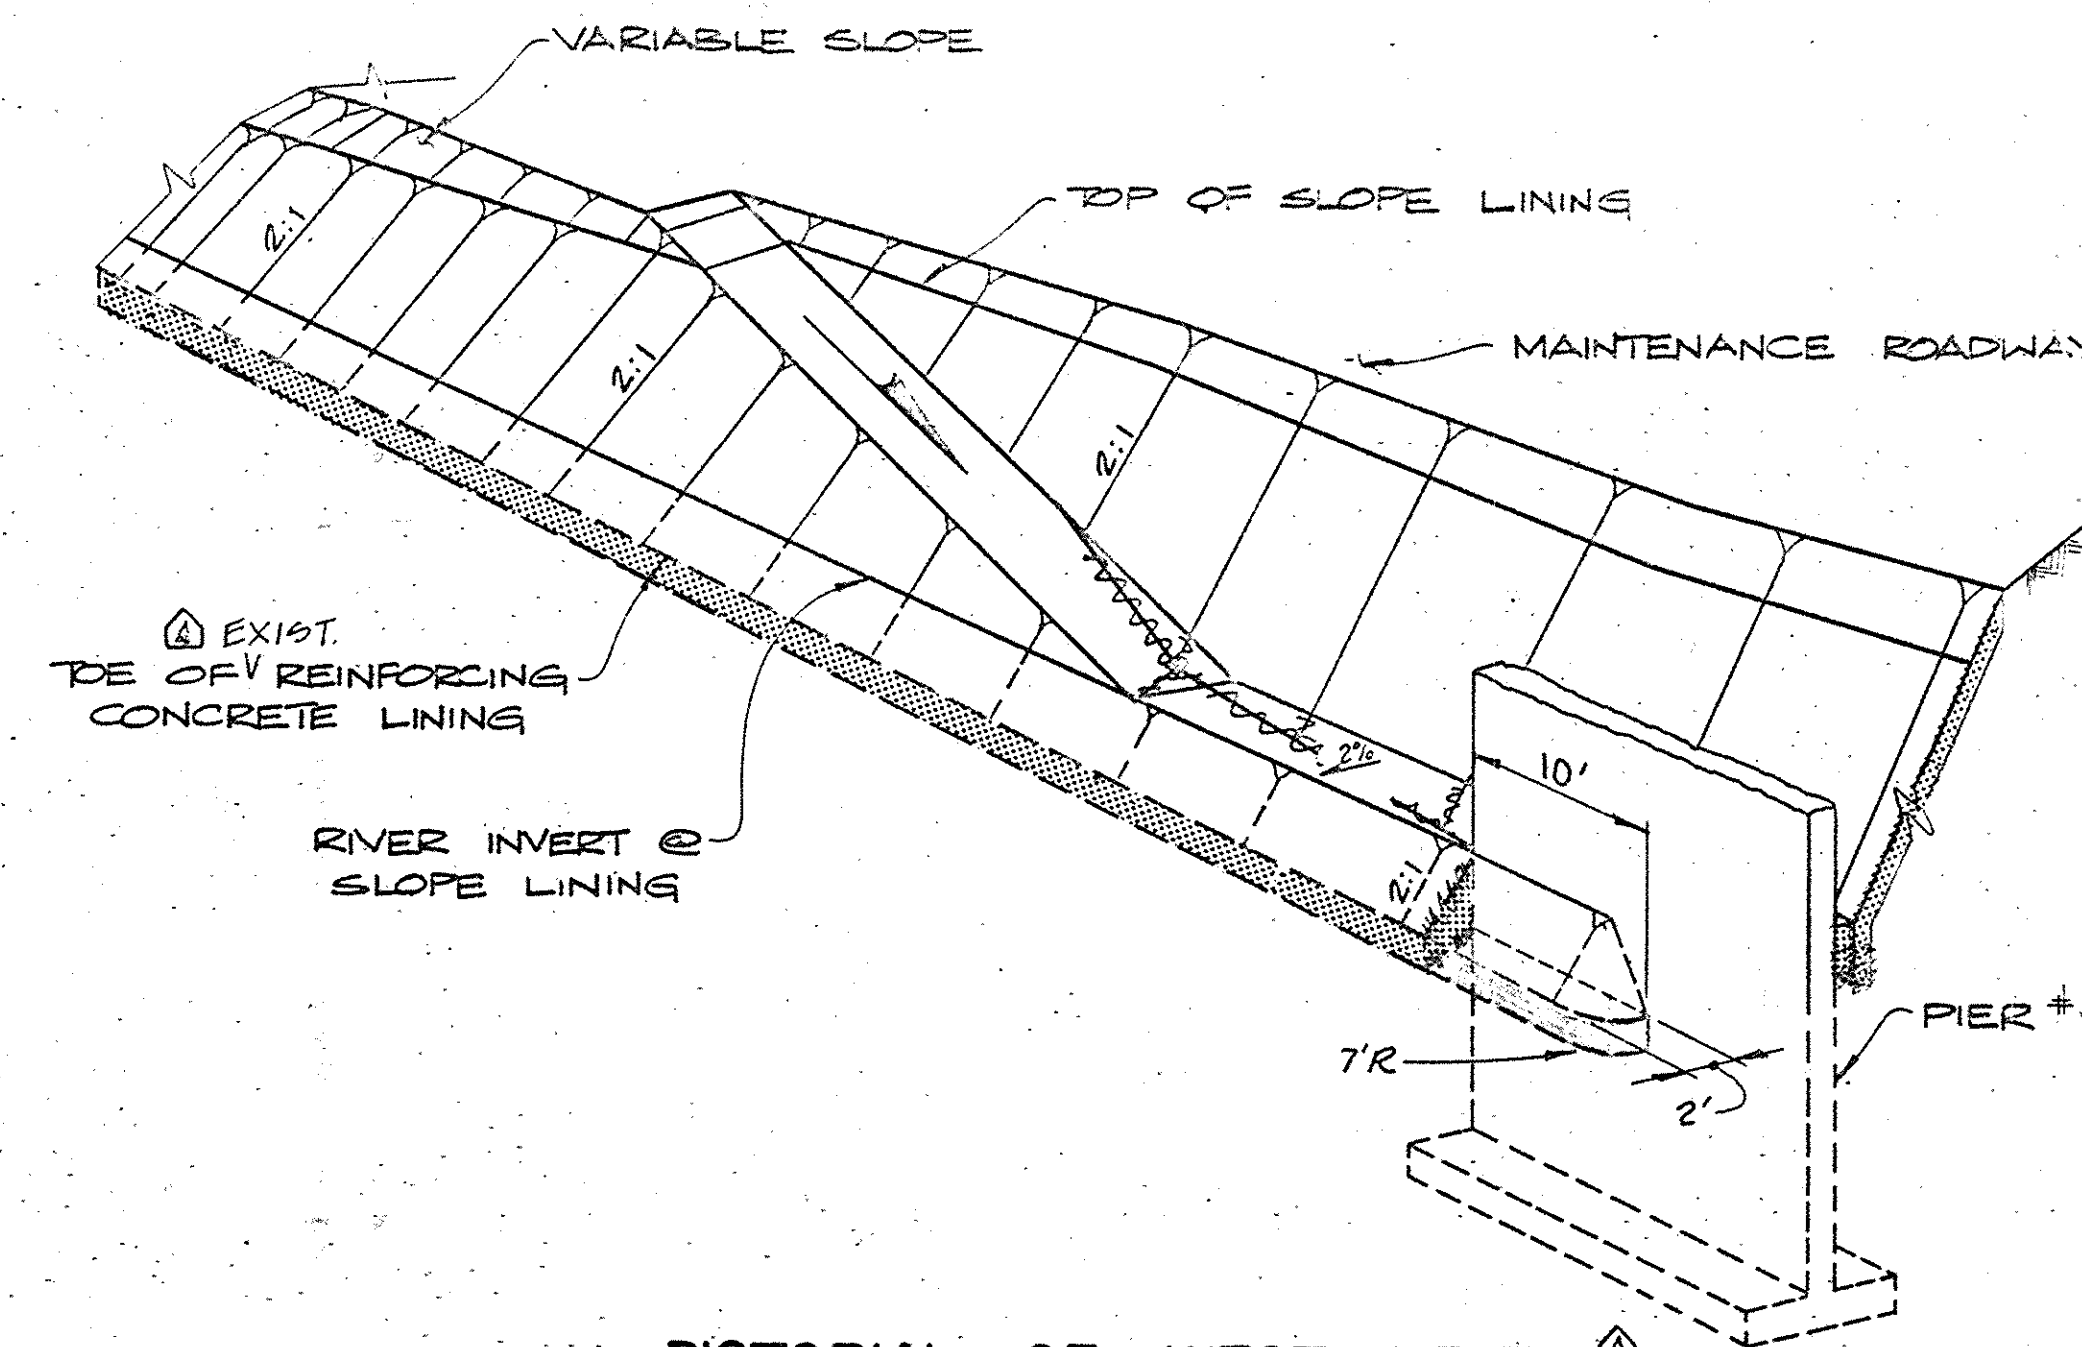

PICTORIAL OF WEST LEVEE
CHANNEL LINING
NO SCALE

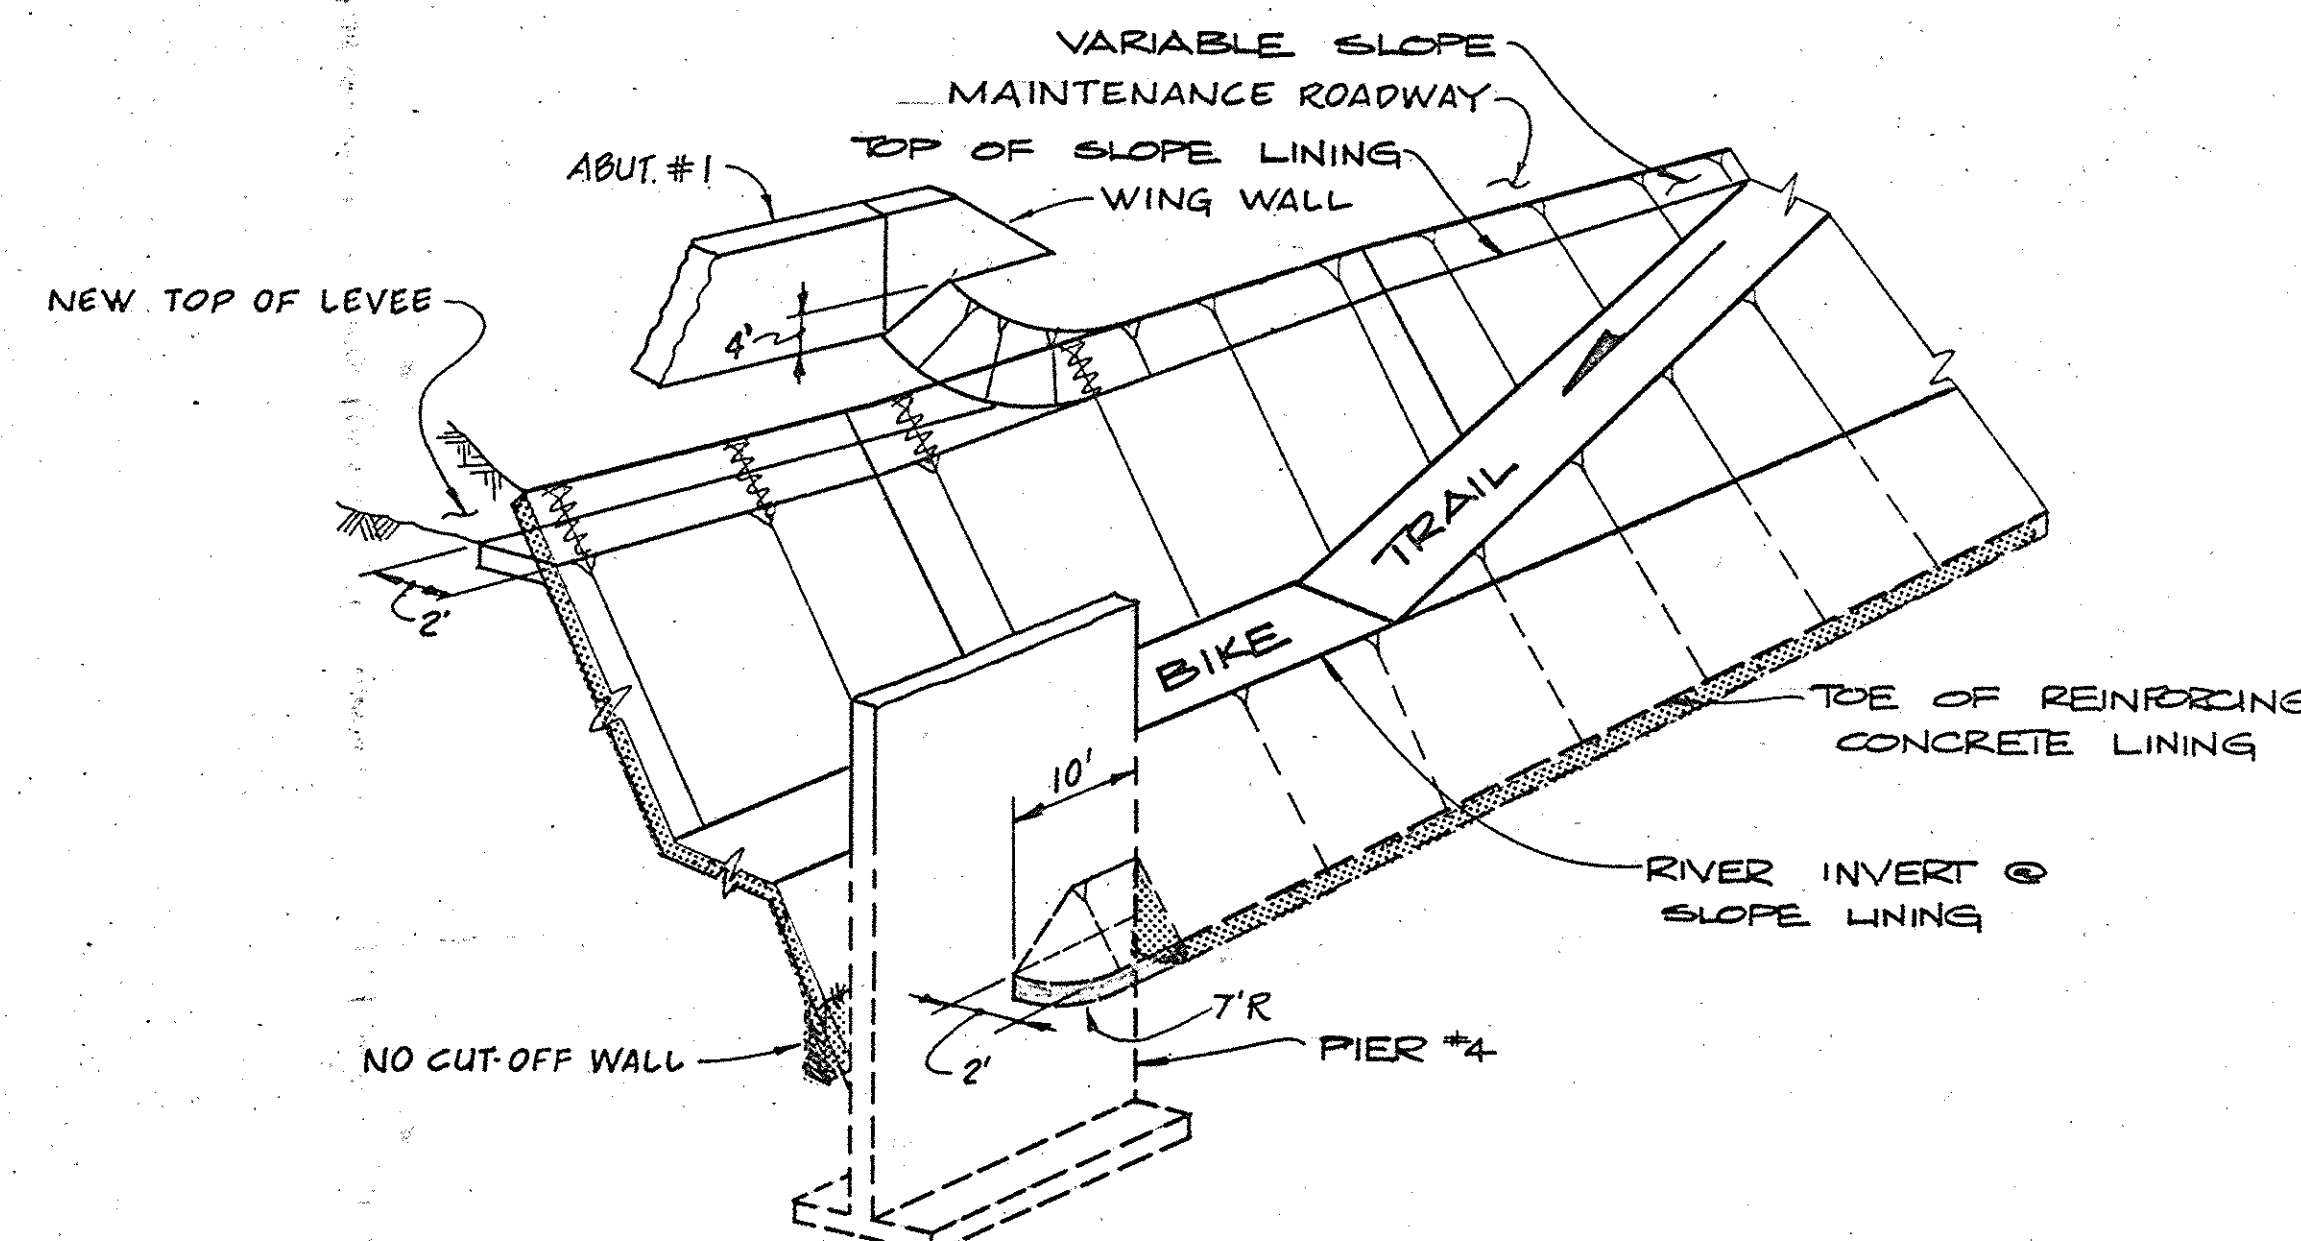

PICTORIAL OF EAST LEVEE
CHANNEL LINING
NO SCALE

1 1/2 0 1 2
3 inches on original drawing

AS BUILT
WHILE THE COUNTY'S STAFF IS OBLIGED TO
BE ACCURATE, THE ORANGE COUNTY ENVIRONMENTAL
MANAGEMENT AGENCY WILL NOT BE RESPONSIBLE
FOR OMISSIONS, ERRORS, OR MISSTATEMENTS.

ORANGE COUNTY ENVIRONMENTAL MANAGEMENT AGENCY			
TALBERT — MACARTHUR BRIDGE			
ACROSS SANTA ANA RIVER			
CHANNEL LINING REMOVAL & REPLACEMENT DETAILS			
DATE 6/83	DESIGNER M.M.H.S.U.	SCALE AS SHOWN	DATE 4/82
DRAWN PLB	CHECKED GWF	DWG. NO.	SHEET 19